

O.D.O.T. DISTRICT 2 SURVEY OFFICE (USE ONLY)

PERSONNEL

REFERENCE NO. 18

SHEET 20 OF 45

NOTES BARRIERE
H.C. MILLER
R.C. BARRIERE

DATE 6/10/24
WEATHER CLOUDY
TEMP. 54

ROUTE SR 295
COUNTY LUCAS
TOWNSHIP SWANTON
SECTION 33

DWG BY BLUBAUGH PID

T 7 N R 5 E

TYPE MONUMENT MAG/WASHER

ON SURFACE - ~~BELOW~~ ON

OFFSET Q PAVEMENT ON LT : RT

11.6' TO RT EDGE PAVEMENT

STATION: 469+99.53

HORZ.DATUM: NAD83 (11)


GEOID: 18

GRID: NORTHING: 680699.543


EASTING: 1605738.594

LDP: NORTHING: 301700.511

EASTING: 116149.066

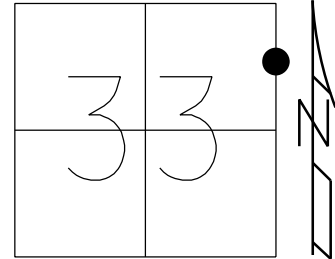

RECORD:
FD SQ.BOLT
5/22/02, DCH
SET MAG/WASHER
12/13/02, DCH
FD MAG/WASHER
REF18
6/20/16, JFO
FD MAG/WASHER
REF 18
6/10/24, JAM

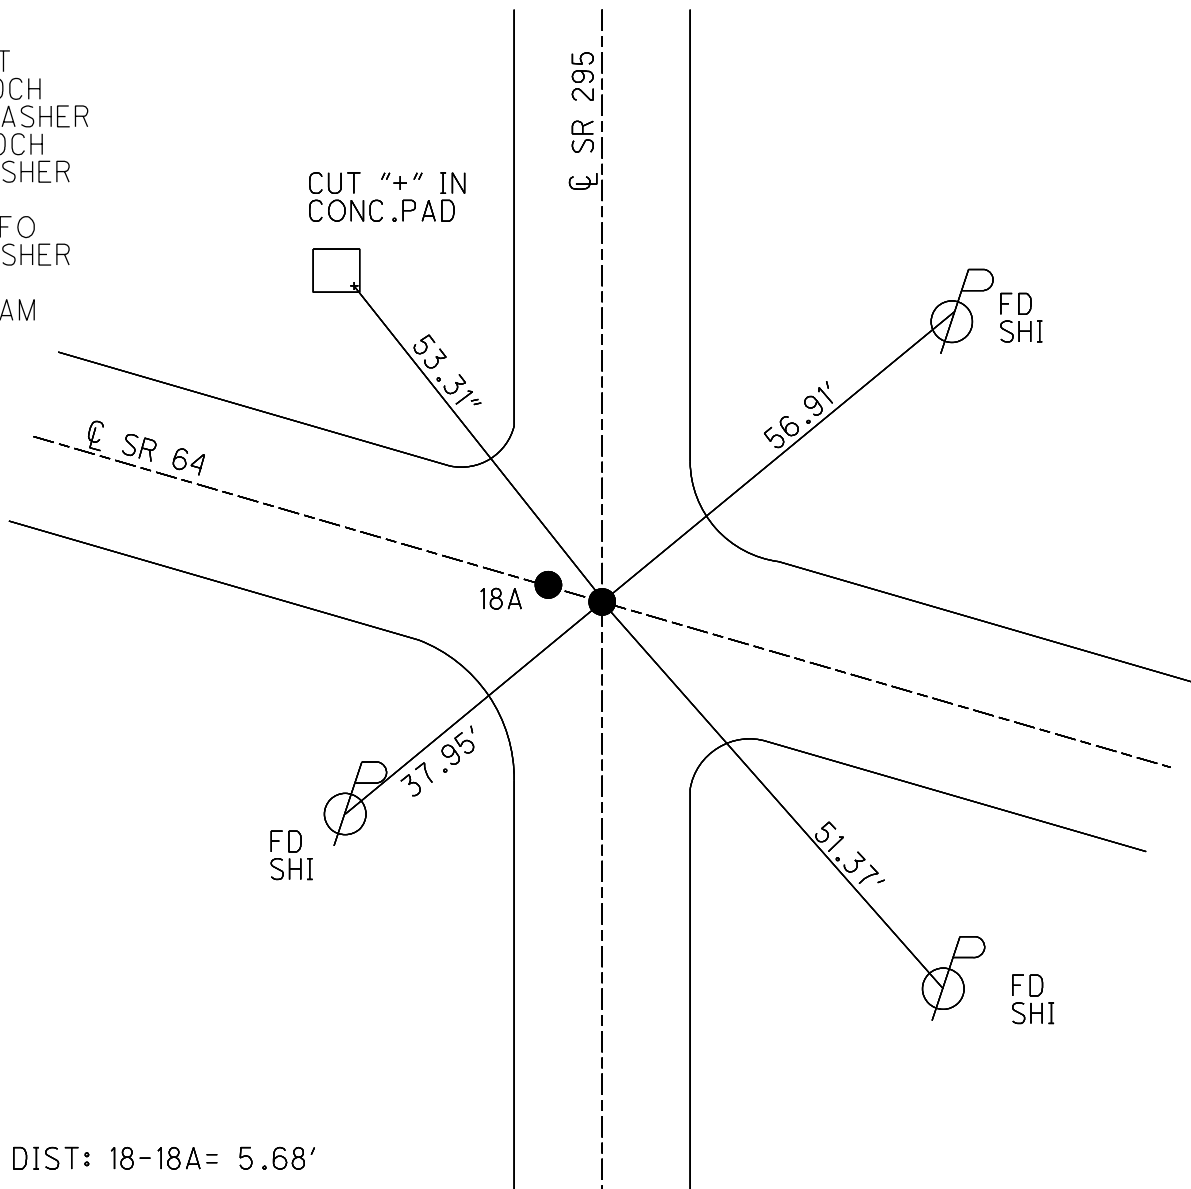

DIST: 18-18A= 5.68'

O.D.O.T. DISTRICT 2 SURVEY OFFICE (USE ONLY)

PERSONNEL

REFERENCE NO. 18

SHEET 20 OF 45

NOTES

HOMAN

DATE

3/22/17

ROUTE

SR 295

H.C.

HOMAN

WEATHER

SUNNY

COUNTY

LUCAS

R.C.

HELDMAN

TEMP.

26°

TOWNSHIP

SWANTON

SECTION

33

T 7 N R 5 E

TYPE MONUMENT MAG/WASHER


ON SURFACE - ~~BELOW~~ ON

LEFT - C PAV'T - RIGHT ON

11.6' TO RT EDGE PAVEMENT

S.L.M. 469+99.53


GRID: NORTHING: 680699.543 EASTING: 1605738.594

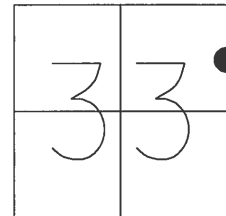

RECORD:

FD SQ.BOLT
5/22/02, DCH
SET MAG/WASHER
12/13/02, DCH
FD MAG/WASHER
REF18
6/20/16, JFO

CUT "+" IN
CONC.PAD

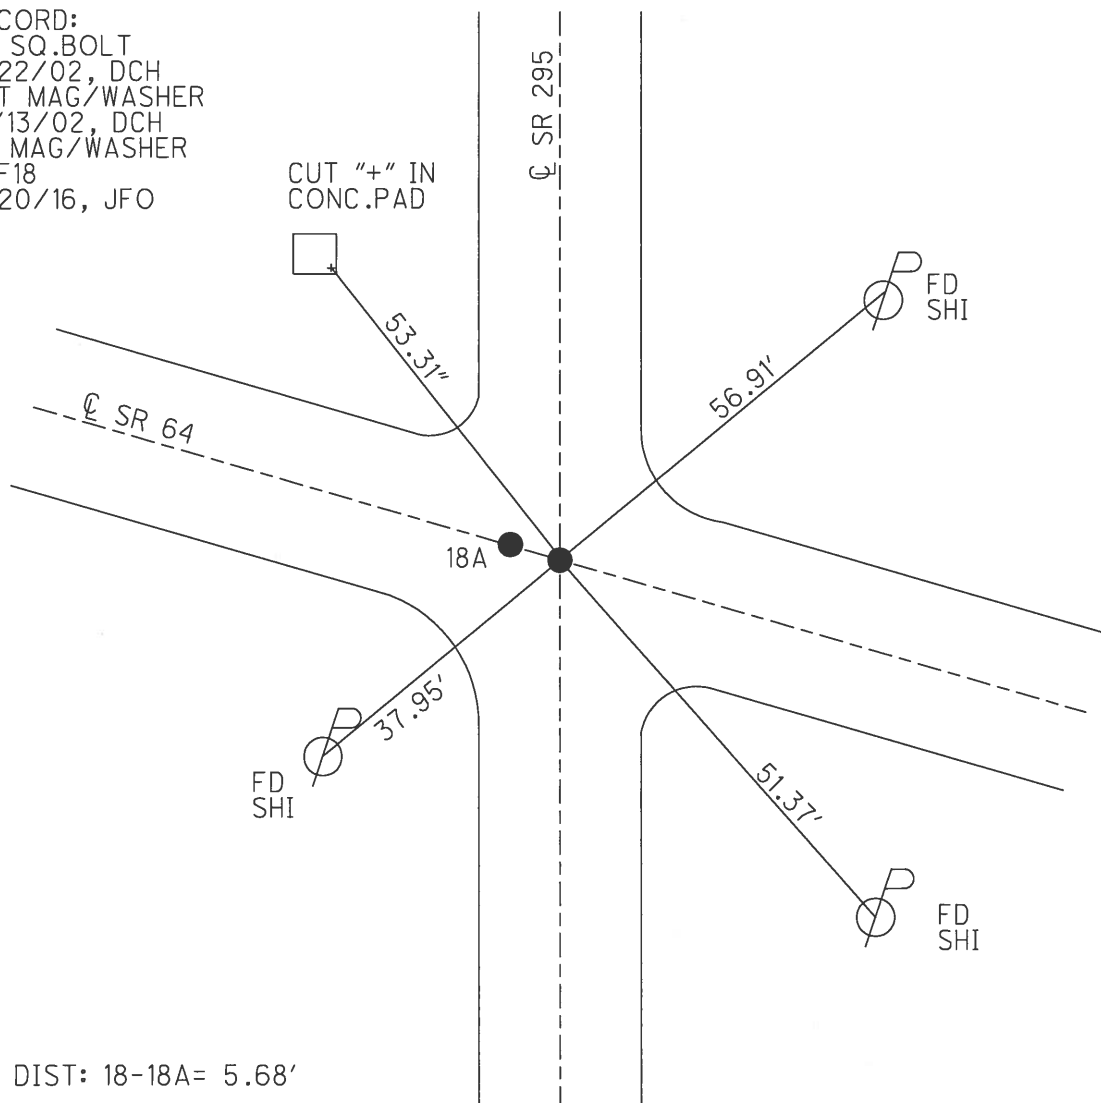

DIST: 18-18A= 5.68'

O.D.O.T. DISTRICT 2 SURVEY OFFICE

PERSONNEL

REFERENCE NO. 41

18 on SR 295

SHEET 18 OF 40

NOTES ROUSOS
H.C. HOMAN
R.C. MICHALAK

DATE 5-22-02
WEATHER SUNNY
TEMP. 52

ROUTE S.R. 64
COUNTY LUCAS
TOWNSHIP SWANTON
SECTION 33
T 7 N R 5 E

TYPE MONUMENT A=SQ BOLT B=RR SPIKE

ON SURFACE - BELOW YES


~~LEFT~~ - Q PAV'T - ~~RIGHT~~ YES

11.6' TO RT. EDGE PAVEMENT


S.L.M. A=336+84 B=336+90

18

18A

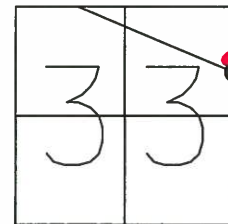

SET MAG NAILS
& WASHERS
12-13-02
D.C.H.

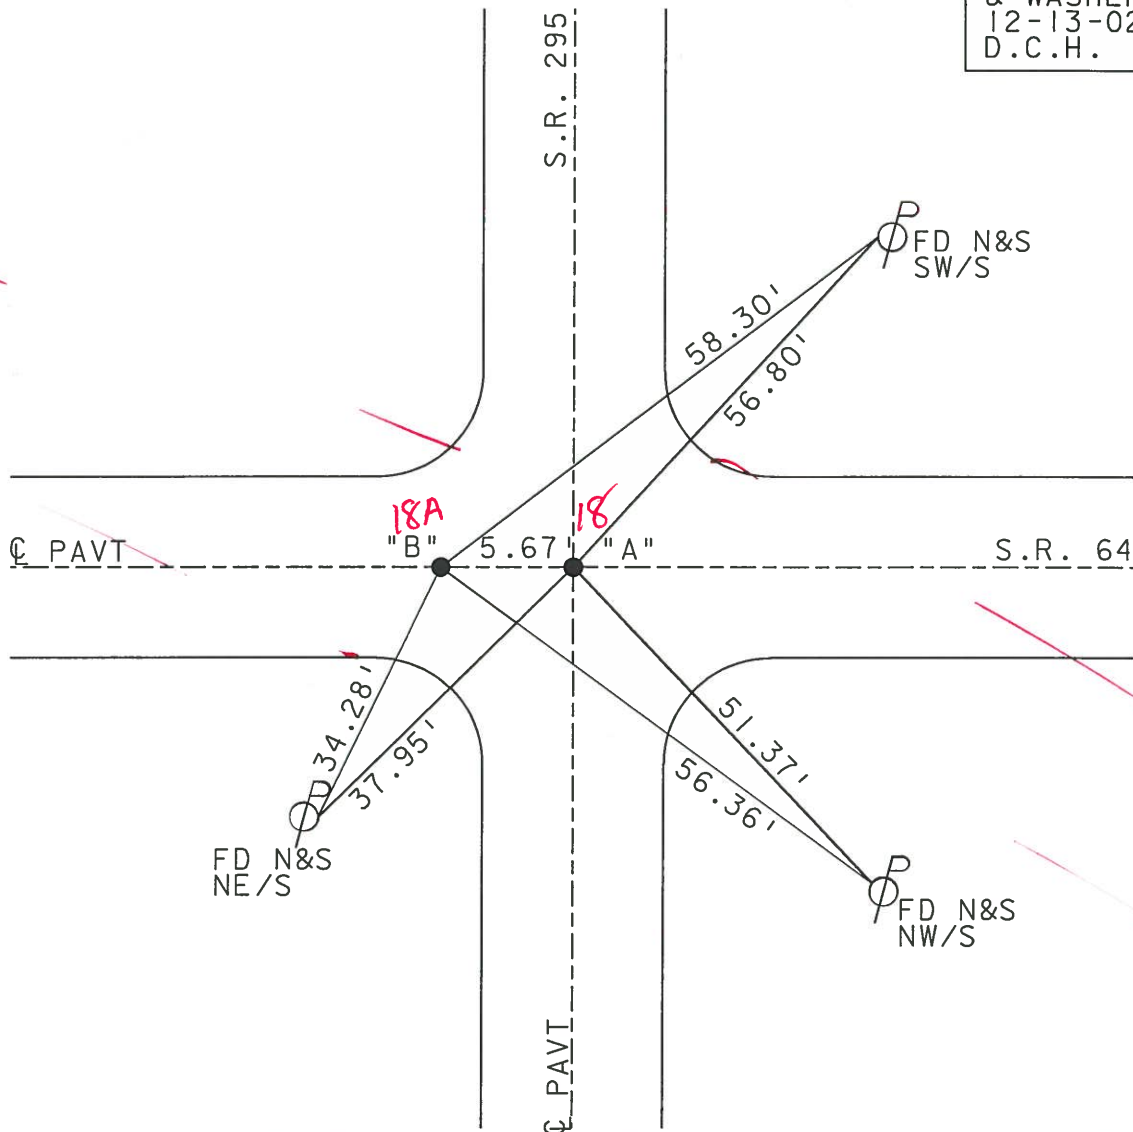

O.D.O.T. DISTRICT 2 SURVEY OFFICE

PERSONNEL

REFERENCE NO. 18

SHEET 15 OF 35

NOTES LOGHRKE

H.C. CURTIS

R.C. Luce

DATE 8-7-91

WEATHER Nice

TEMP. +80

ROUTE S.R. 295

COUNTY LUCAS

TOWNSHIP WATERVILLE

SECTION

T7 N R 9 E

TYPE MONUMENT "A" Bolt "B" Sm. R.R. Spike


ON SURFACE - BELOW Yes

LEFT - & PAVT. - RIGHT Yes


TO EDGE PAVEMENT

S.L.M. 339+64

Set P.K. / WASHER

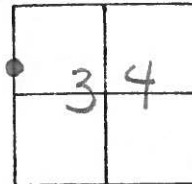

5.66' Between Pts

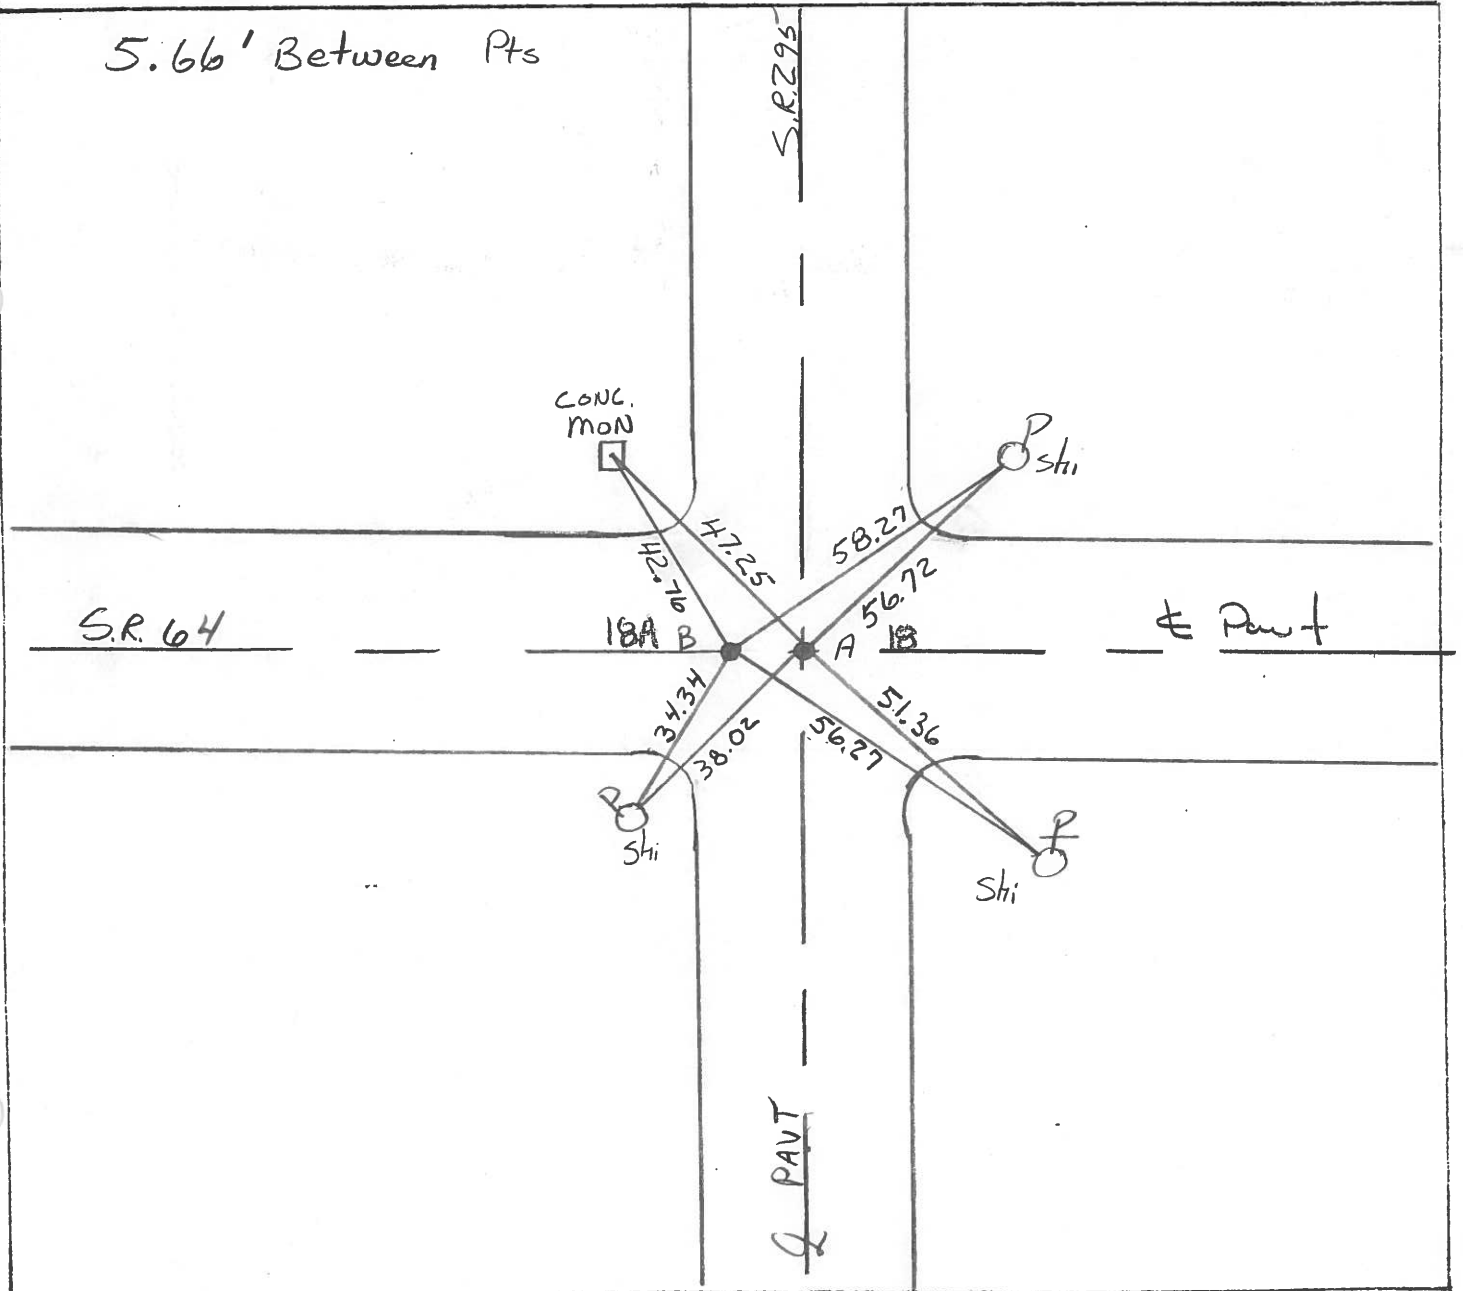

O.D.O.T. DISTRICT 2 SURVEY OFFICE

SHEET

OF

County Lucas S.R. 295

Township Waterville

Section 33-34

T N, R E

Personnel I. Stone


P. Neuser

R. Michalak


Date 26 April 82

Weather Cloudy

Temp. 60°

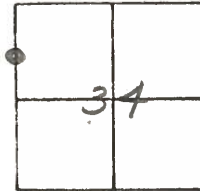

REF. No. 18

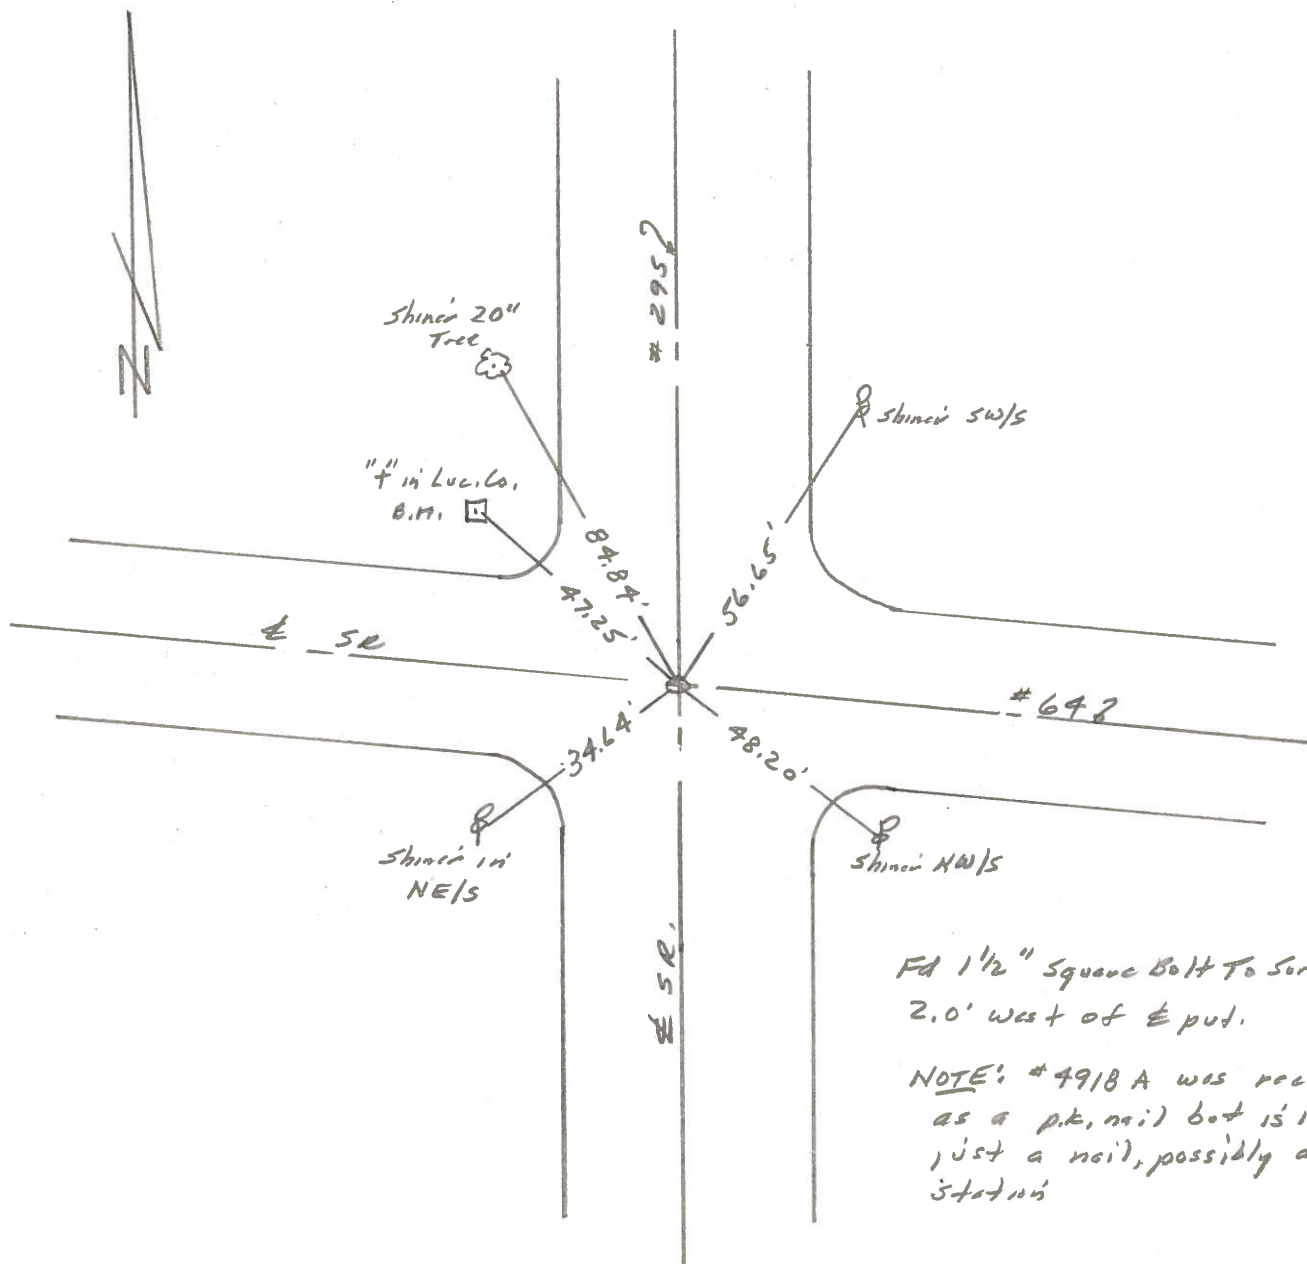

Fd 1 1/2" Square Bolt To Surface
2.0' West of E put.

NOTE: #4918 A was recorded
as a p.k. nail but is in fact
just a nail, possibly a 100'
station

PERSONNEL TITLE PERSONNEL TITLE

COUNTY Lucas DATE 12 June 68S. R. #295 WEATHER FairSEC. _____ TEMP. 73°

DESCRIPTION

LEFT

CENTER LINE

RIGHT

JOB NO. _____

