

O.D.O.T. DISTRICT 2 SURVEY OFFICE (USE ONLY)

PERSONNEL

REFERENCE NO. 25 B

SHEET OF

NOTES ASTON

DATE 10/25/23

ROUTE SR 19

H.C. NIESE

WEATHER BREEZY

COUNTY OTTAWA

R.C. ASTON

TEMP. 60°

TOWNSHIP CARROLL

DWG BY BARRIERE

PID 101239

SECTION 32

T 6 N R 15 E

TYPE MONUMENT MAG NAIL/WASHER

ON SURFACE - BELOW ON

OFFSET Q PAVEMENT 0.5' LT LT : RT

 TO EDGE PAVEMENT

STATION: 226+28.76

HORIZ.DATUM: NAD 83 (2011)


GEOID: 18

GRID: NORTHING: 675563.895

EASTING: 1791855.561


LDP: NORTHING: 335060.778

EASTING: 151703.862

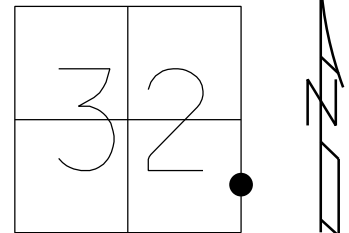

RECORD:
SET MAG/WASHER
REF33
3/20/07, RGN
SET MAG/WASHER
REF33
11/08/07
FD MAG/WASHER
REF25B
10/28/09, HUSS
FD MAG SHANK
REF25A
6/29/23, TDN
SET MAG/WASHER
REF25B
10/25/23, TDN

TOP NEAR COR.
OF SIGN BASE
"ODOT GARAGE"

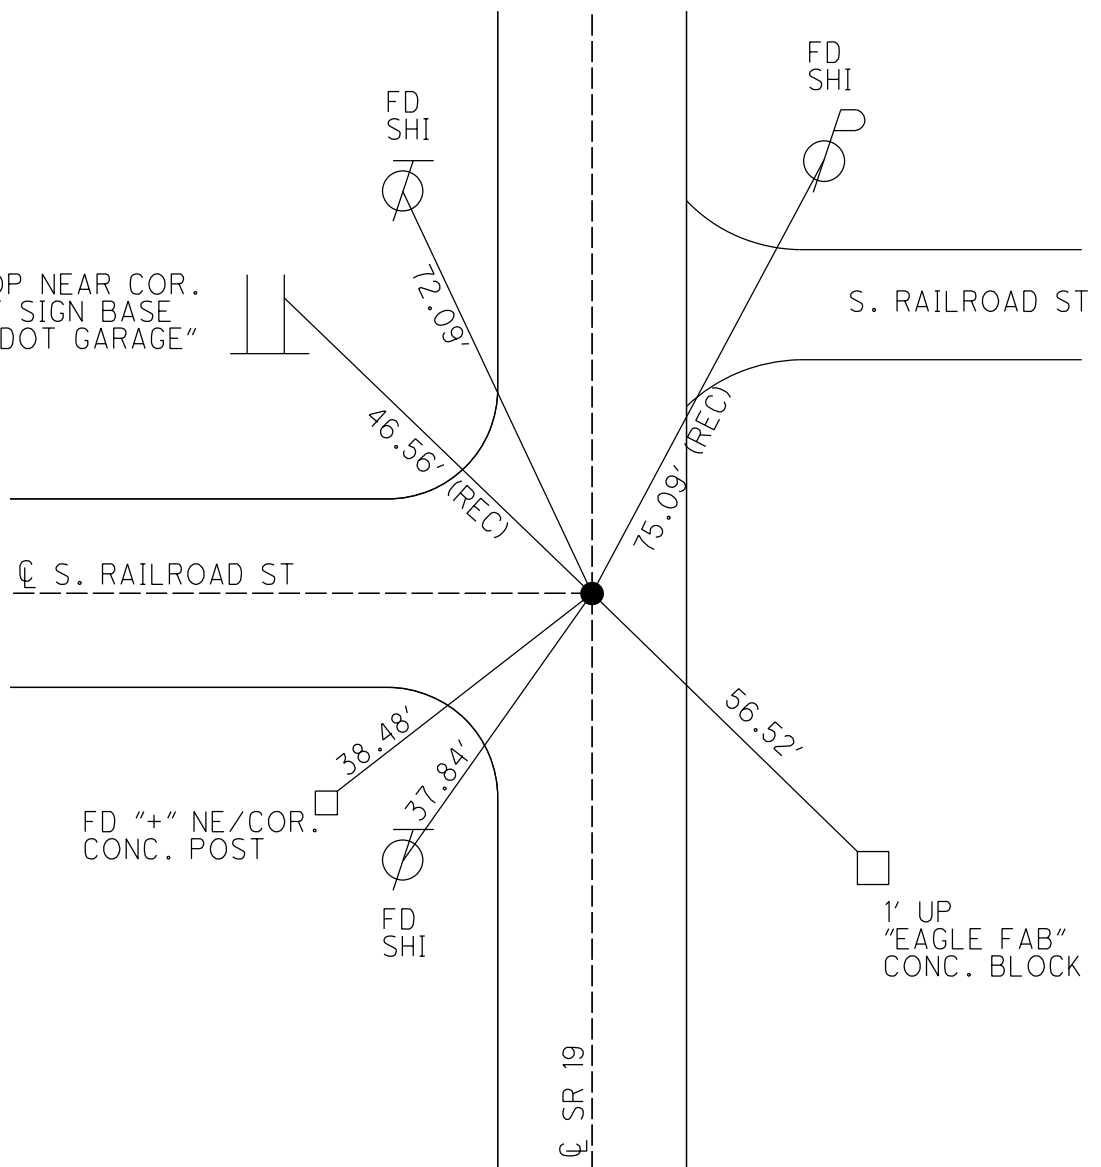

O.D.O.T. DISTRICT 2 SURVEY OFFICE (USE ONLY)

PERSONNEL

REFERENCE NO.

25 B

SHEET

12

OF 29

NOTES

HUSS

DATE

10/28/09

ROUTE

SR 19

H.C.

CANTERBURY

WEATHER

FAIR

COUNTY

OTTAWA

R.C.

GOLDBERG

TEMP.

50°

TOWNSHIP

SALEM

SECTION

32

T 7 N

R 15 E

TYPE MONUMENT MAG/WASHER

ON SURFACE - ~~BELOW~~ ON

LEFT - ℄ PAV'T - RIGHT ON

12' TO RT EDGE PAVEMENT


S.L.M. 226+29.05

GRID: NORTHING:

675788.97

EASTING:

1791855.639

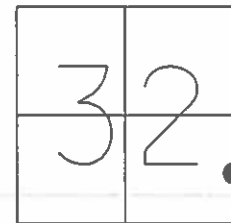

TOP NEAR COR.
OF SIGN BASE
"ODOT GARAGE"

℄ S. RAILROAD ST

SET "+" NE/COR.
CONCRETE POST

FD
SHI

FD
SHI

S. RAILROAD ST

FD
SHI

FD
SHI

℄ SR 19

O.D.O.T. DISTRICT 2 SURVEY OFFICE (USE ONLY)

PERSONNEL

REFERENCE NO.

25 B

SHEET

16

OF 33

NOTES

HUSS

DATE

10/28/09

ROUTE

SR 19

H.C.

CANTERBURY

WEATHER

FAIR

COUNTY

OTTAWA

R.C.

GOLDBERG

TEMP.

50°

TOWNSHIP

SALEM

SECTION

32

T 7 N R 15 E

TYPE MONUMENT MAG/WASHER


ON SURFACE - ~~BELOW~~ ON

LEFT - C PAV'T - RIGHT ON

12' TO RT EDGE PAVEMENT

S.L.M. 226+29.05

Grid: Northing: 675788.97 Easting: 1791855.639

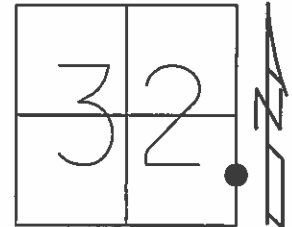

TOP NEAR COR.
OF SIGN BASE
"ODOT GARAGE"

C S. RAILROAD ST

SET "+" NE/COR.
CONCRETE POST

FD
SHI

12.08'

46.56'

FD
SHI

75.09'

S. RAILROAD ST

38.56'

37.82'

FD
SHI

37.41'

FD
SHI

C SR 19