


O.D.O.T. DISTRICT 2 SURVEY OFFICE (USE ONLY)


PERSONNEL _____ REFERENCE NO. 4 SHEET 5 OF 33
 NOTES RHOADES DATE 7/20/21 ROUTE SR 105
 H.C. O'DONNELL WEATHER HAZE COUNTY OTTAWA
 R.C. RHOADES TEMP. 71° TOWNSHIP HARRIS
 DWG BY RHOADES PID CHIP SEAL SECTION 23
 T 6 N R 13 E

TYPE MONUMENT MAG/WASHER
 ON SURFACE - ~~BELOW~~ ON _____
 OFFSET \odot PAVEMENT 1.5' ~~ET~~ : RT
9.7' TO RT EDGE PAVEMENT
 STATION: 9+64

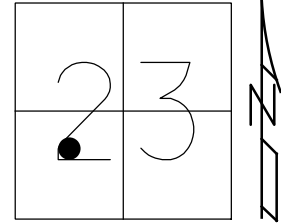

HORIZ.DATUM: NAD83 2011 GEOID: NAVD88 2018
 GRID: NORTHING: 655423.656 EASTING: 1739388.188


RECORD: P.I.
 STA. 9+64.05
 SET P.K./WASHER
 9/14/94, MB
 FD P.K.NAIL
 OTTREF5
 5/2/13, DCH
 SET MAG/WASHER
 FINREFOTT4
 7/11/13, SDC
 FD MAG/WASHER
 REF4
 7/20/21, JFO
 10/20/21, JMR

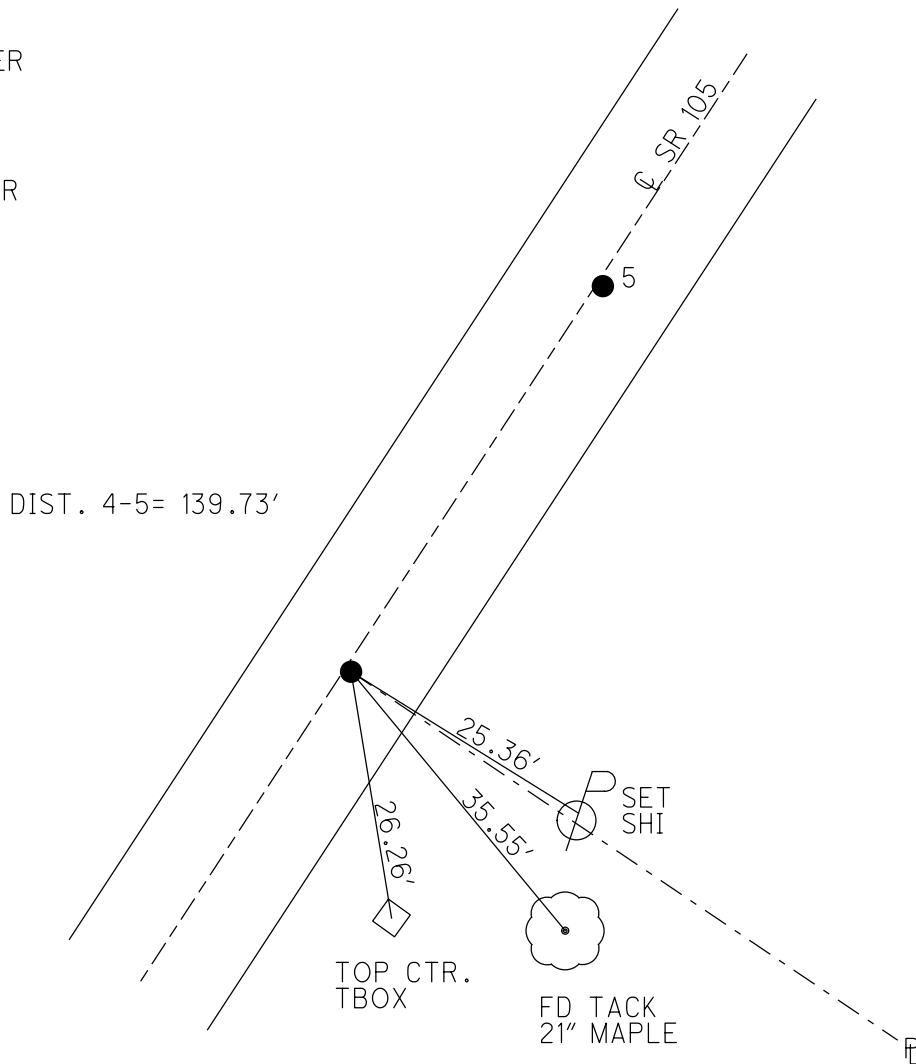

O.D.O.T. DISTRICT 2 SURVEY OFFICE (USE ONLY)

PERSONNEL	REFERENCE NO. <u>4</u>	SHEET <u>5</u> OF <u>33</u>
NOTES <u>HOMAN</u>	DATE <u>5/2/13</u>	ROUTE <u>SR 105</u>
H.C. <u>HOMAN</u>	WEATHER <u>CLEAR</u>	COUNTY <u>OTTAWA</u>
R.C. <u>ROUSOS</u>	TEMP. <u>60°</u>	TOWNSHIP <u>HARRIS</u>
		SECTION <u>23</u>
		T <u>6</u> N R <u>13</u> E

TYPE MONUMENT P.K.NAIL
 ON SURFACE - ~~BELOW~~ ON _____
~~LEFT~~ - Q PAV'T - RIGHT 1.5'
9.7' TO RT EDGE PAVEMENT
 S.L.M. 9+64

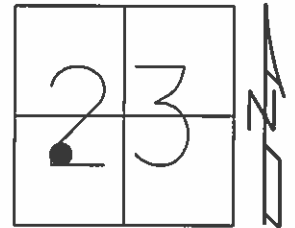


Grid: Northing: 655423.612 Easting: 1739388.08

RECORD: P.I.
 9+64.05
 RESET P.K./WASHER
 9/14/94, MB

 FD P.K.
 GPS, OTTREF5

 SET MAG/WASHER
 7/9/13, SDC
 GPS, FINREFOTT4
 7/11/13, SDC

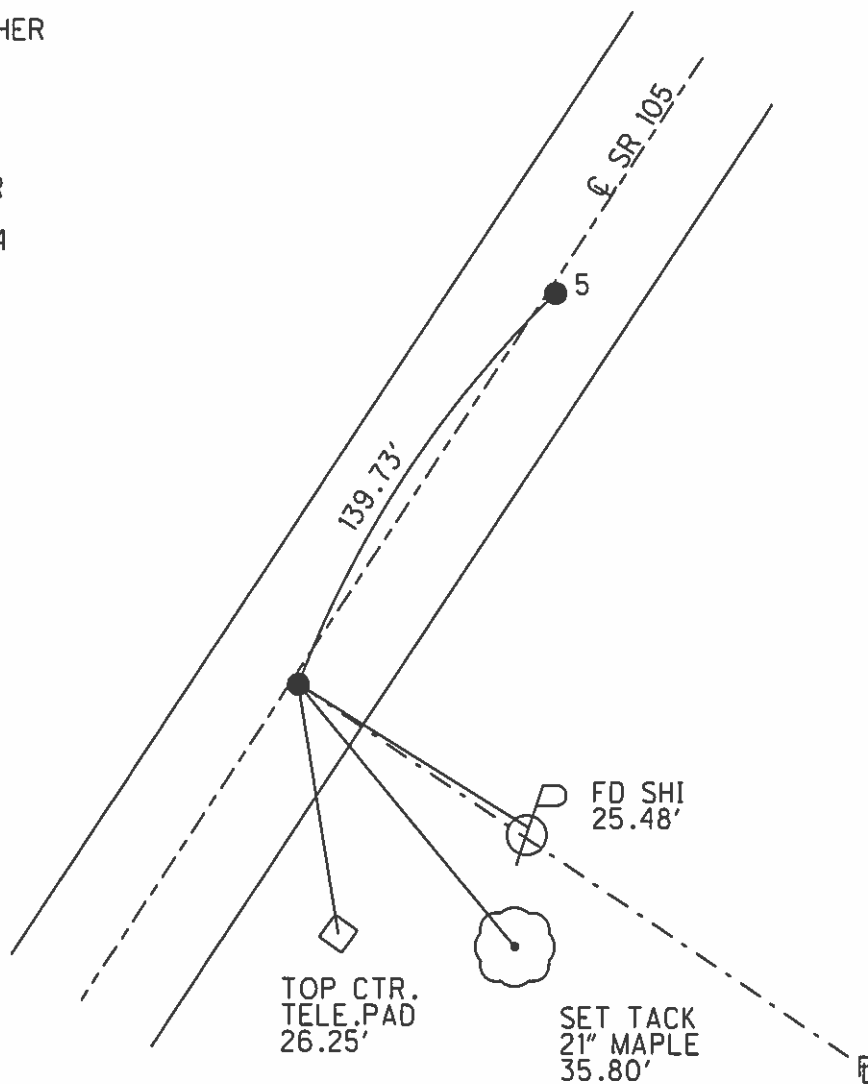

O.D.O.T. DISTRICT 2 SURVEY OFFICE

PERSONNEL _____

REFERENCE NO. 455

SHEET 4 OF 26

NOTES BARNHISEL

H.C. PRUNTY

DATE 9-14-94

ROUTE 105

R.C. SLOVAK

WEATHER CLEAR

COUNTY OTTAWA


TEMP. +85°

TOWNSHIP HARRIS

SECTION 23

T6 N R 13 E


	#4	#5
TYPE MONUMENT	<u>PK NAIL</u>	<u>PK NAIL</u>
ON SURFACE - BELOW	<u>1 1/2"</u>	<u>3"</u>
LEFT - & PAV'T. - RIGHT	<u>1.5'</u>	<u>1.0'</u>
9.7 TO RT EDGE PAVEMENT	<u>"BOTH"</u>	
S.L.M.	<u>9+64</u>	<u>11+04</u>

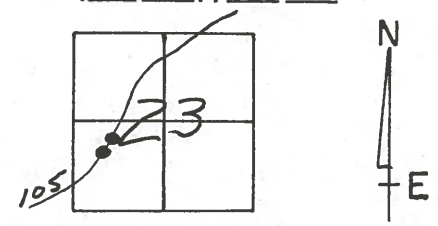

Record: #4
P.I. 9+64.05

Reset PK's & Washer's
9-14-94
MB

Record #5
P.I.

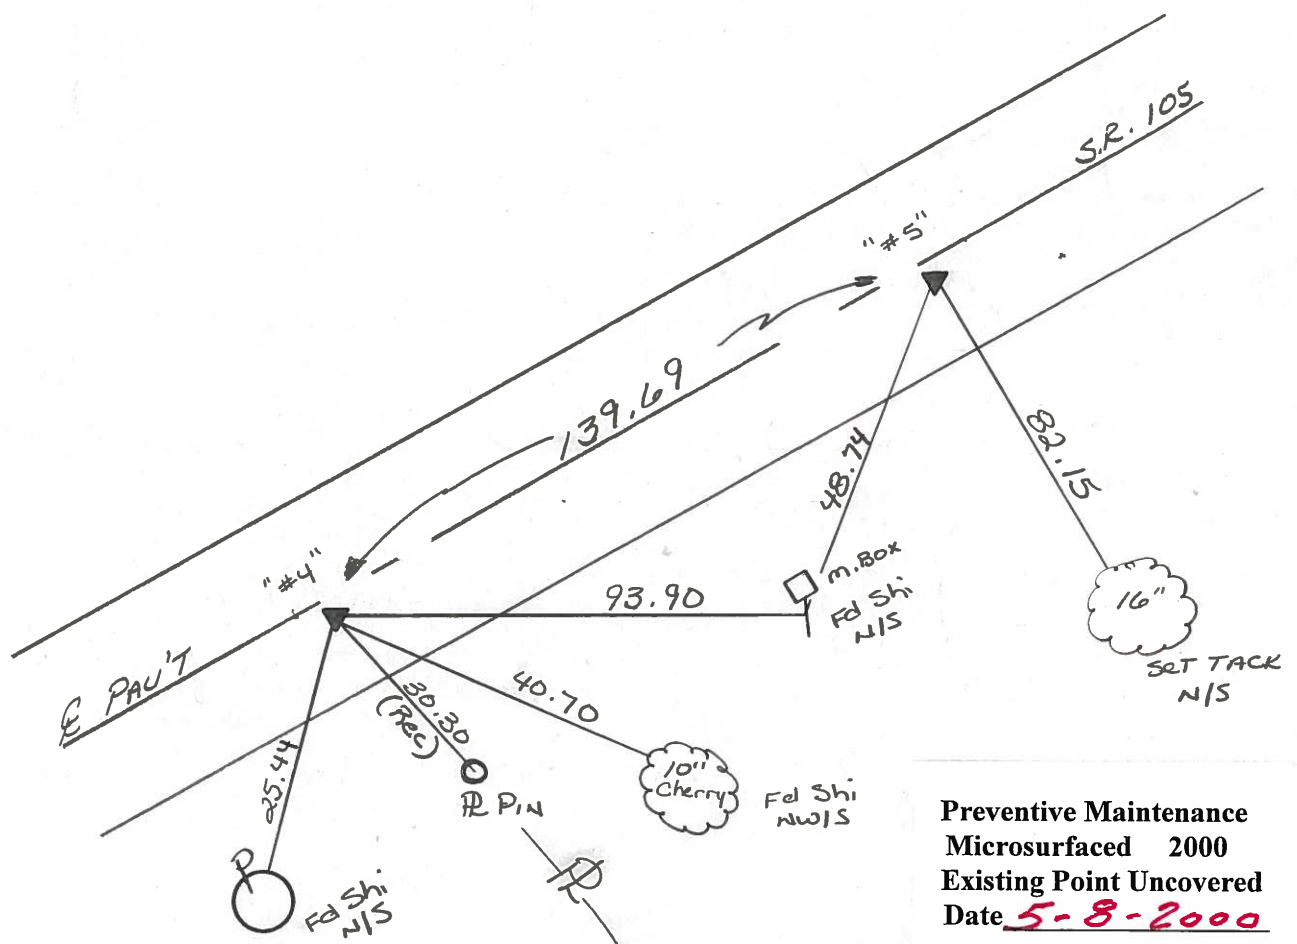

Preventive Maintenance
Microsurfaced 2000
Existing Point Uncovered
Date 5-8-2000

PERSONNEL TITLE PERSONNEL TITLE

COUNTY Ottawa

DATE 8-2-74

S. R. 10.5

WEATHER Sunny

SEC. 23

TEMP. 80°

DESCRIPTION Harris Twp.

JOB NO.

