

O.D.O.T. DISTRICT 2 SURVEY OFFICE (USE ONLY)

PERSONNEL

REFERENCE NO. 19

SHEET 21 OF 33

NOTES HOMAN

DATE 5/3/13

ROUTE SR 105

H.C. HOMAN

WEATHER CLOUDY

COUNTY OTTAWA

R.C. ROUSOS

TEMP. 70°

TOWNSHIP HARRIS

DWG BY RHOADES PID 25524

SECTION 13

T 6 N R 13 E

TYPE MONUMENT IPIPE

ON SURFACE - ~~BELOW~~ ON

OFFSET  $\varnothing$  PAVEMENT 31' ~~LT~~ : RT

- TO - EDGE PAVEMENT


STATION: 97+50.98

HORZ.DATUM: NAD83 2011



GEOID: NAVD88 2012A

GRID: NORTHING: 658942.867

EASTING: 1746418.045

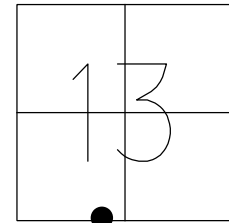


RECORD: P.I.  
 STA. 97+74  
 $\Delta = 33^\circ 48' 00''$   
 8/9/94, CHENEY  
 FD IPIPE  
 OTTREF20  
 5/3/13, DCH

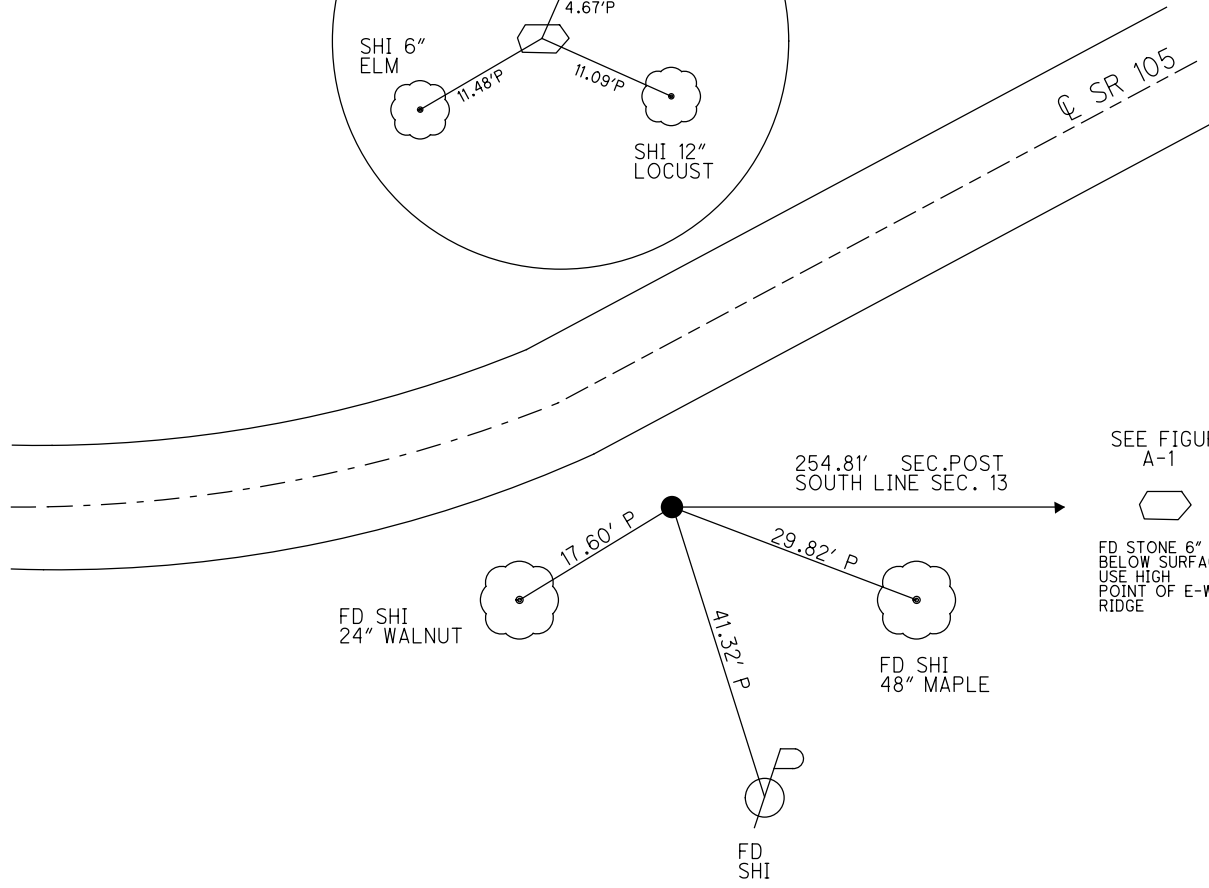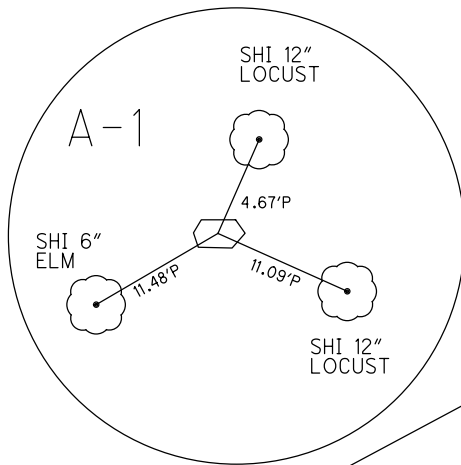

O.D.O.T. DISTRICT 2 SURVEY OFFICE (USE ONLY)



PERSONNEL	REFERENCE NO. <u>19</u>	SHEET <u>21</u> OF <u>33</u>
NOTES <u>HOMAN</u>	DATE <u>5/3/13</u>	ROUTE <u>SR 105</u>
H.C. <u>HOMAN</u>	WEATHER <u>CLOUDY</u>	COUNTY <u>OTTAWA</u>
R.C. <u>ROUSOS</u>	TEMP. <u>70°</u>	TOWNSHIP <u>HARRIS</u>
		SECTION <u>13</u>
		T <u>6</u> N R <u>13</u> E

TYPE MONUMENT IPIPE  
 ON SURFACE - ~~BELOW~~ ON  
~~LEFT~~ - CL PAV'T - RIGHT 31'  
TO - EDGE PAVEMENT  
 S.L.M. 97+50.98  
 Grid: Northing: 658942.867 Easting: 1746418.045

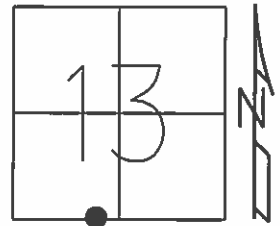

RECORD: P.I.  
 $\Delta = 33^\circ 48' 00''$   
 E = 31.03' TO  $\odot$   
 SLM: 97+74  
 8/9/94, CHENEY

FD IPIPE  
 GPS, OTTREF20

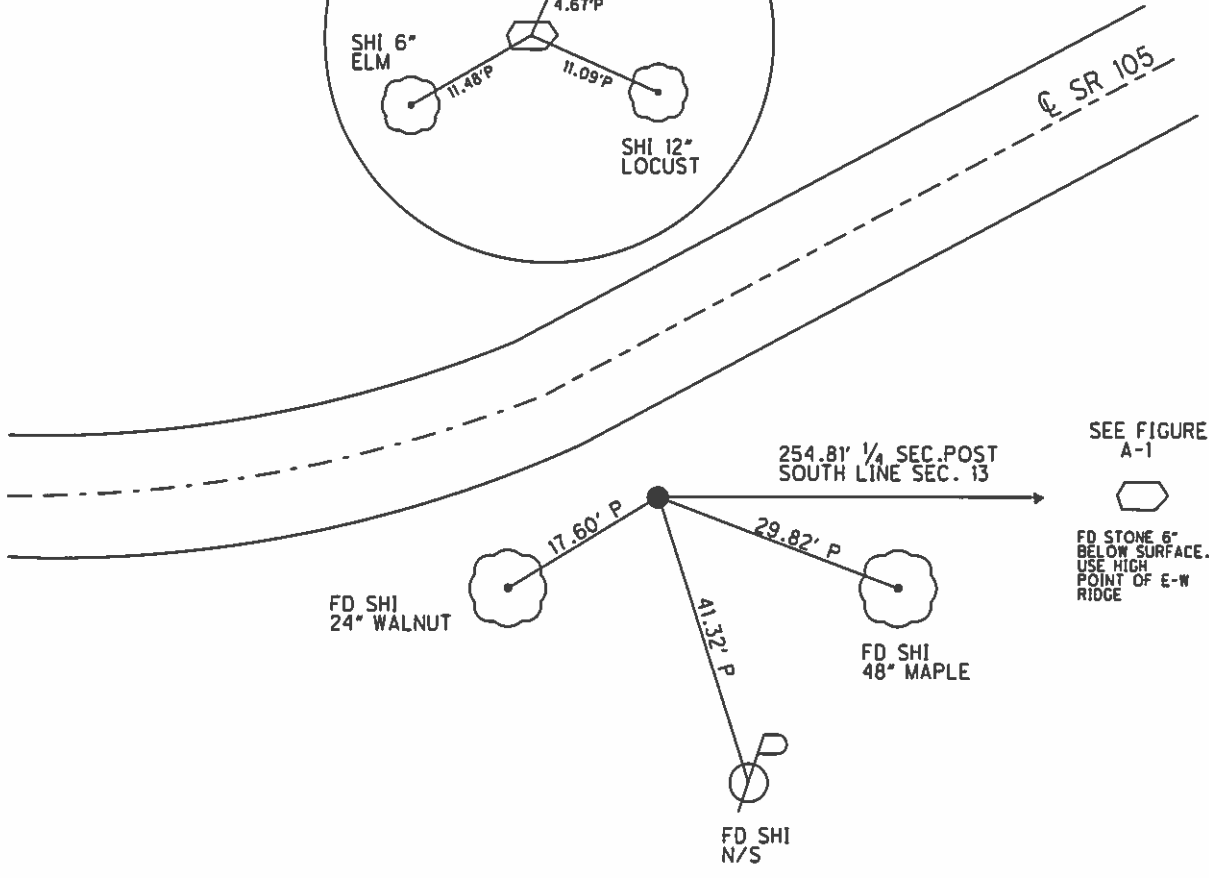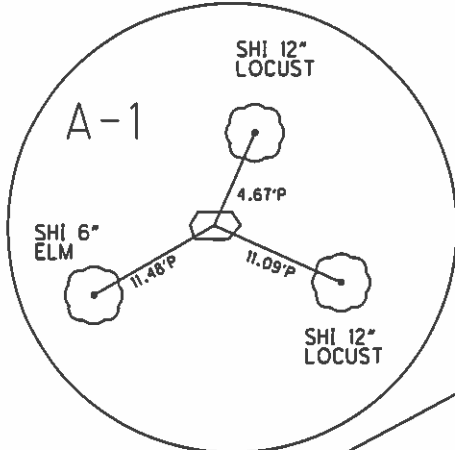

# O.D.O.T. DISTRICT 2 SURVEY OFFICE

PERSONNEL

REFERENCE NO. 19

SHEET ~~4~~<sup>16</sup> OF ~~27~~<sup>26</sup>

NOTES HOFFMAN

H.C. Lucas

R.C. BARNHISEL T

DATE 4-30-85

WEATHER Clear

TEMP. 70°

ROUTE SR 105

COUNTY OTTAWA

TOWNSHIP HARRIS

SECTION 13

T 6 N R B E


TYPE MONUMENT I. Pipe

ON SURFACE - BELOW yes

LEFT- & PAW'T. - RIGHT 31'

TO EDGE PAVEMENT

S.L.M. 97+50.98 along TANGENT line

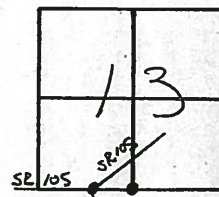


P.I.  $\Delta$  Lt.  $33^{\circ}-48'-00''$

8-9-94

Checked old ties & recorded all distances.

S.L.M. STATIONING 97+74

Cheney & CREW

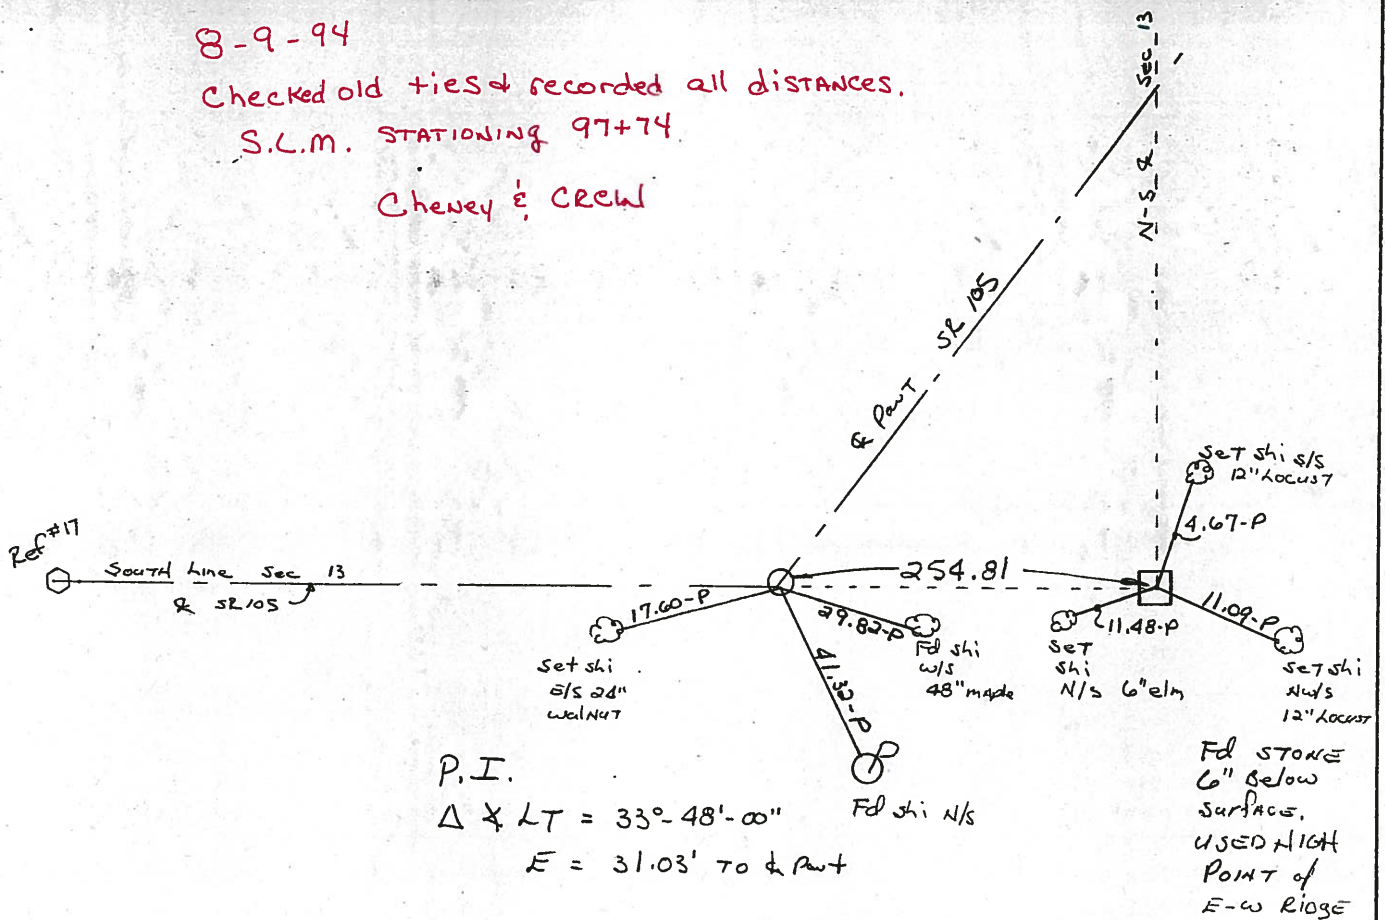

Preventive Maintenance  
 Microsurfaced 2000  
 Existing Point Uncovered  
 Date 5-8-2000

# O.D.O.T. DISTRICT 2 SURVEY OFFICE

PERSONNEL

REFERENCE NO. 19

SHEET 4 OF 27

NOTES HOFFMAN

H.C. LUCE

DATE 4-30-85

ROUTE SR 105

R.C. BARNHISEL T

WEATHER Clear

COUNTY OTTAWA

TEMP. 70°

TOWNSHIP HARRIS

SECTION 13

T6 N R B E


TYPE MONUMENT I. PIPE

ON SURFACE - BELOW Yes


LEFT - CL PAV'T. - RIGHT 31'

TO EDGE PAVEMENT

S.L.M. 97+50.98 Along Tangent Line

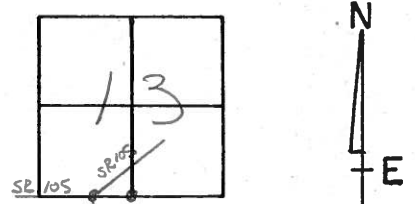

P.I.  $\Delta$  Lt.  $33^{\circ}-48'-00''$

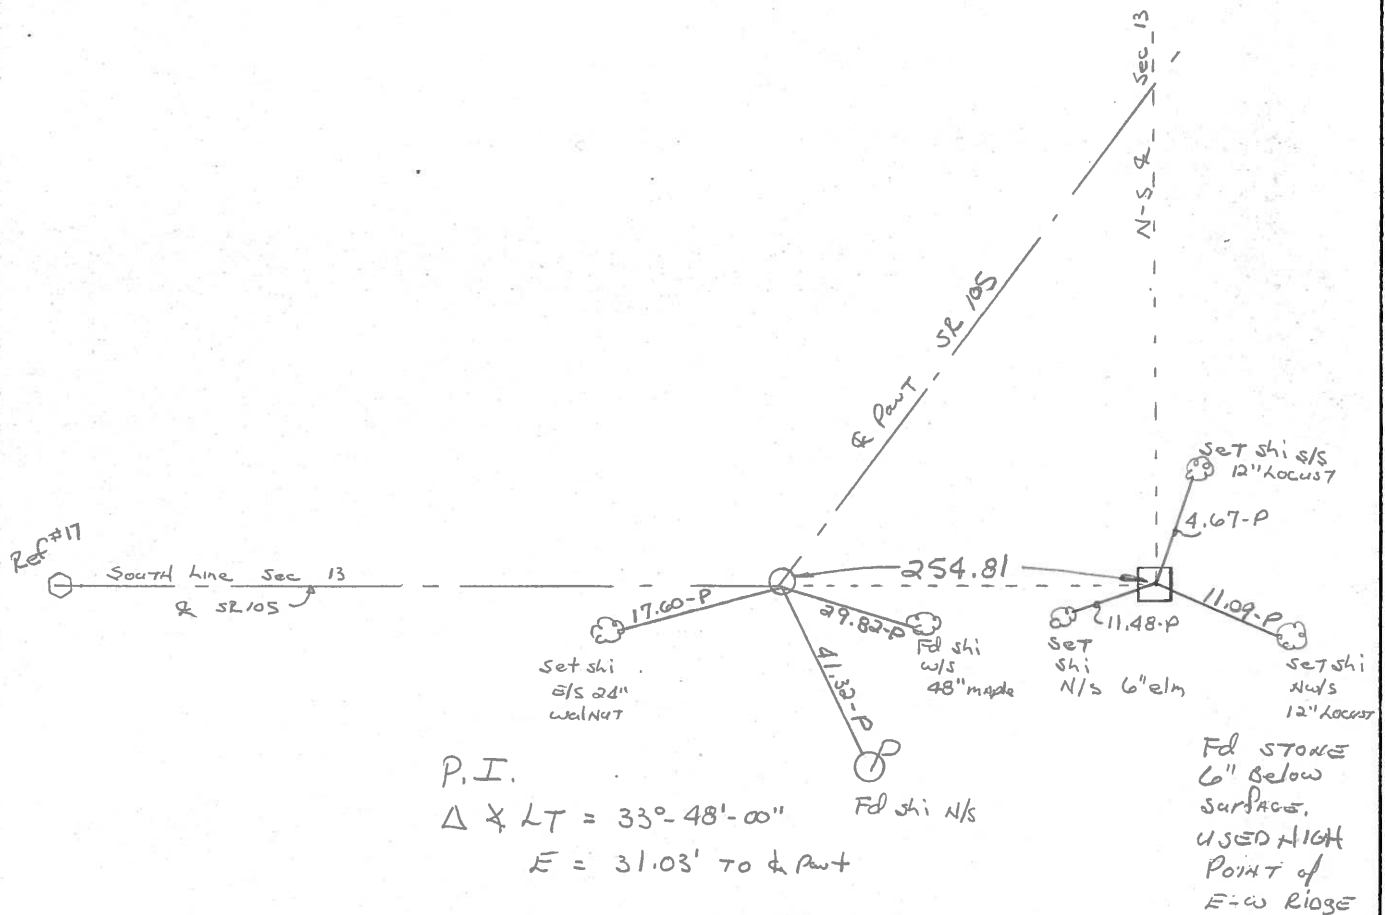

PERSONNEL TITLE PERSONNEL TITLE

COUNTY Ottawa DATE 8-6-74

S. R. 105 WEATHER Fair

SEC. 135 24 TEMP. 70°

DESCRIPTION Harris Twp. JOB NO.

LEFT CENTER LINE RIGHT

