

O.D.O.T. DISTRICT 2 SURVEY OFFICE

PERSONNEL

NOTES Cranin
 H.C. Ripple
 R.C. Barbour
Geyman

REFERENCE NO. 45

Draw 9/25/87

DATE 5/26/87

WEATHER sunny

TEMP. 77°

SHEET _____ OF _____

ROUTE 105

COUNTY Ottawa

TOWNSHIP Harris

SECTION 8

T 6 N R 14 E


TYPE MONUMENT 3/4" I. Rod

ON SURFACE - BELOW on surface


LEFT - CL PAV'T. - RIGHT 52' Lt. & Pavt.

TO EDGE PAVEMENT

S.L.M. 218716

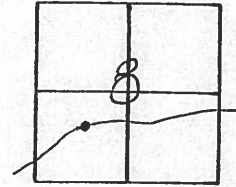

P.I.
 $\Delta = 41^{\circ}42'00''$ Rt.
E = 52'

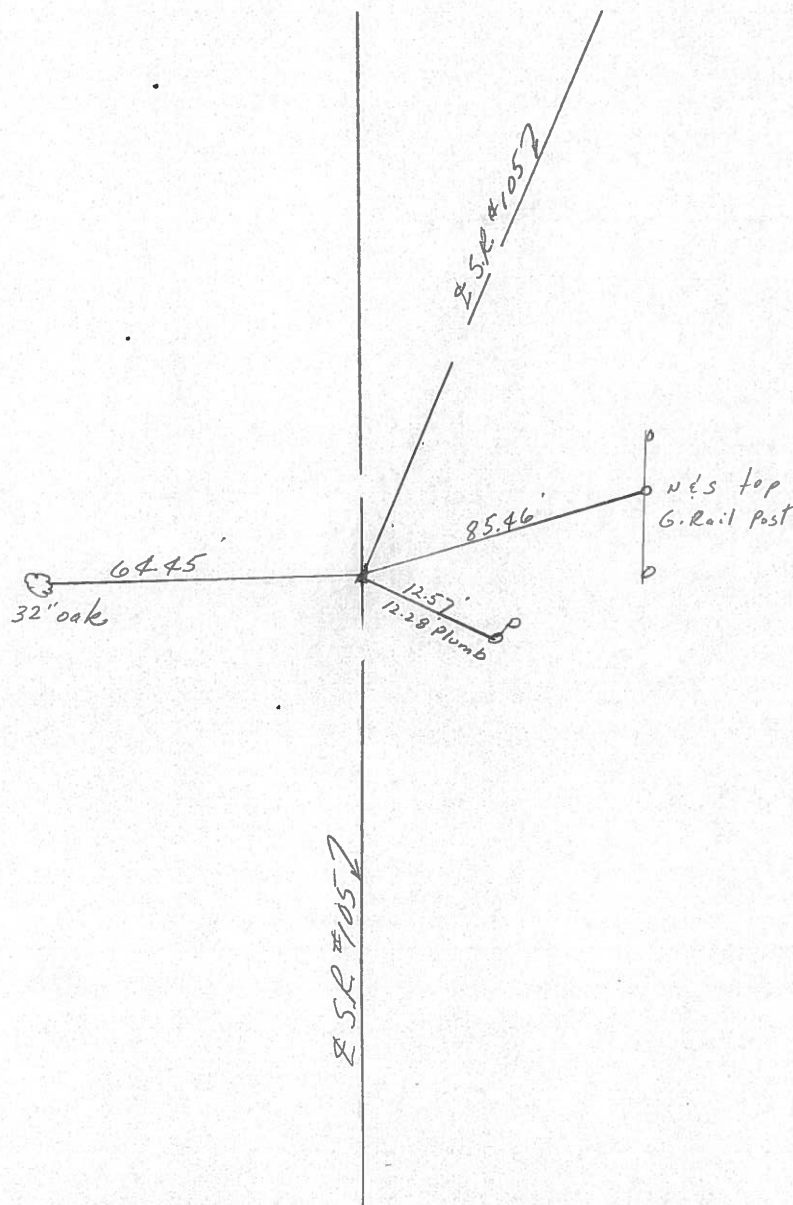

PERSONNEL TITLE PERSONNEL TITLE

COUNTY Ottawa DATE 2-21-74

S. R. 105 WEATHER Fair

SEC. 8 TEMP. 50°

DESCRIPTION Harris Twp.

LEFT CENTER LINE RIGHT JOB NO.

