

O.D.O.T. DISTRICT 2 SURVEY OFFICE (USE ONLY)

PERSONNEL _____ REFERENCE NO. 50 A SHEET 23 OF 63
 NOTES MOSE DATE 4/14/00 ROUTE SR 105
 H.C. CANTERBURY WEATHER SUNNY COUNTY OTTAWA
 R.C. BARNHISER TEMP. +60° TOWNSHIP HARRIS
 DWG BY BALBAUGH PID 92131 SECTION 8
 T 6 N R 14 E

TYPE MONUMENT P.K.NAIL


~~ON SURFACE~~ - BELOW 1.5"

OFFSET C PAVEMENT 2.2' E : RT
9.0' TO RT EDGE PAVEMENT


STATION: 233+35

HORZ.DATUM: _____ GEOID: _____

GRID: NORTHING: _____ EASTING: _____

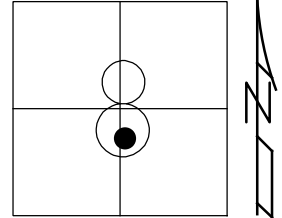

RECORD:
 ORIGIN UNKNOWN
 STA.233+35
 FD P.K.NAIL
 4/14/00, MC
 SET P.K./WASHER
 6/21/00, KPM
 D.N.F.
 7/30/19, JFO

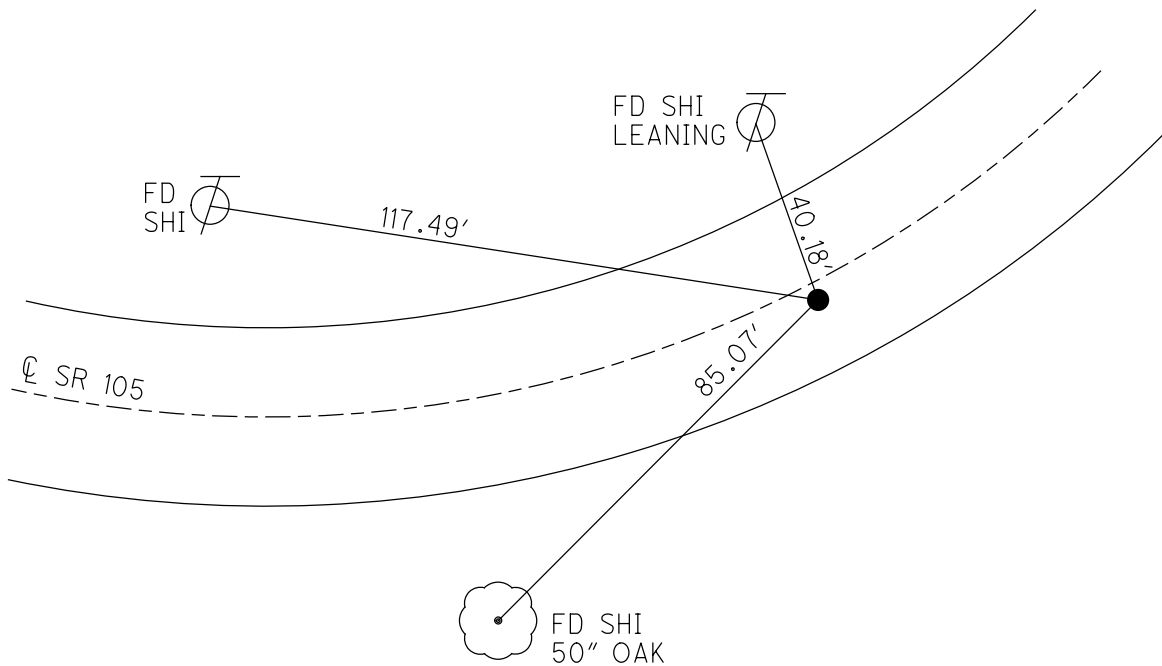

O.D.O.T. DISTRICT 2 SURVEY OFFICE

PERSONNEL

REFERENCE NO. 50-A

SHEET 19 OF 96

NOTES K. MOSER

H.C. M. CANTERBURY

R.C. M. BARNHISEL

DATE 4-14-00

WEATHER SUNNY

TEMP. +60°F

ROUTE S.R. 105

COUNTY OTTAWA

TOWNSHIP HARRIS

SECTION 8

T. 6 N. R. 14 E.


TYPE MONUMENT PK NAIL

~~ON SURFACE~~ - BELOW 1 1/2" Below

~~LEFT - C PAV'T.~~ - RIGHT 2.2' RT.


9.0' TO RT. EDGE PAVEMENT

S.L.M. 233 + 35

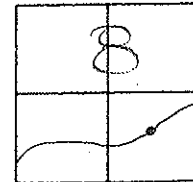

ORIGON unknown

RESET PK/WASHER
6-21-00
K.P.M

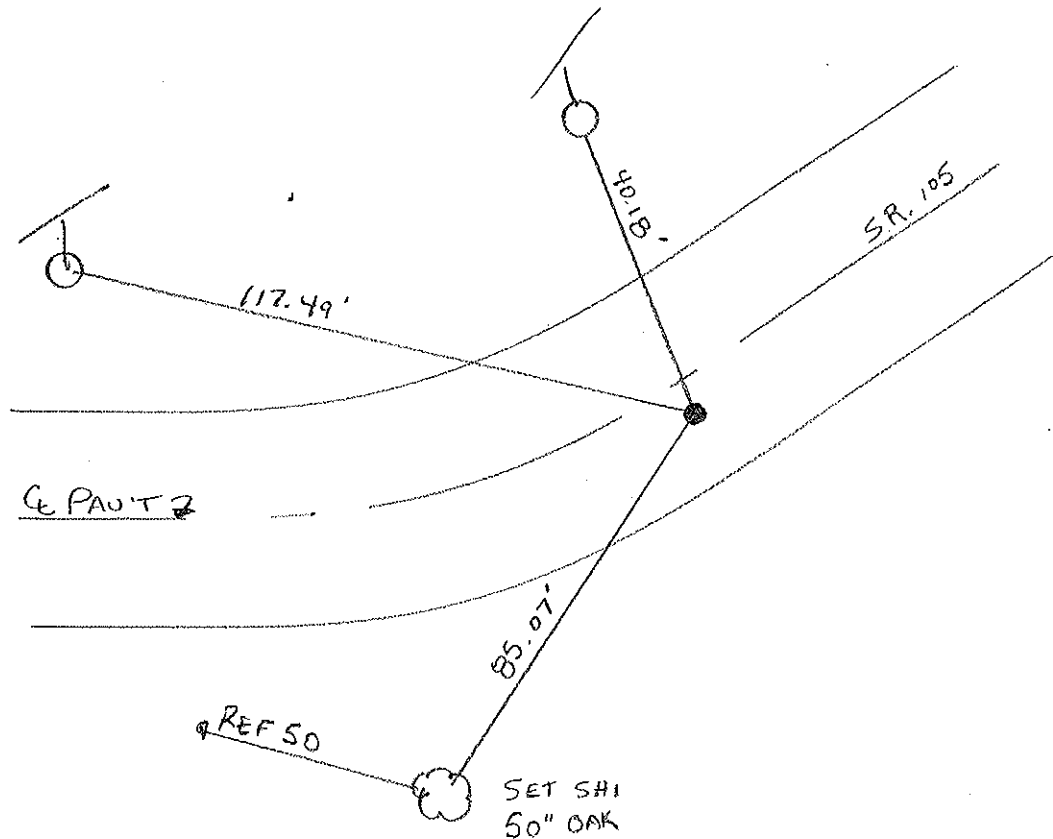

PERSONNEL	TITLE	PERSONNEL	TITLE
_____	_____	_____	_____
_____	_____	_____	_____
_____	_____	_____	_____

COUNTY _____ DATE _____

S.R. _____ WEATHER _____

SEC. _____ TEMP _____

DESCRIPTION _____ JOB NO. _____

LEFT

CENTER LINE

RIGHT

233 + ~~35~~ 35

F.D. PK 1 1/2" down

2.2' RT.

9.0' RT EDGE

Reset PK/WASHER
6-22-00
KRM

