

O.D.O.T. DISTRICT 2 SURVEY OFFICE (USE ONLY)

PERSONNEL

REFERENCE NO. 33

SHEET 19 OF 20

NOTES ASTON

DATE 5-13-24

ROUTE SR 163

H.C. NIESE

WEATHER CLOUDY

COUNTY OTTAWA

R.C. ASTON

TEMP. 78°

TOWNSHIP HARRIS

SECTION 3

DWG BY ASTON

PID 101239

T 6 N R 14 E

TYPE MONUMENT MONBOX

ON SURFACE - BELOW ON

OFFSET Q PAVEMENT 0.5' LT : RT

12' TO RT EDGE PAVEMENT


STATION: 527+68

HORZ.DATUM: NAD83(2011)

GEOID: 18

GRID: NORTHING: 674743.852


EASTING: 1770702.876

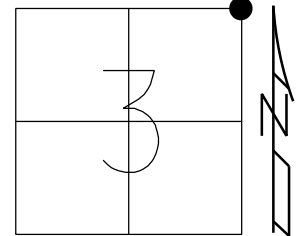

LDP  
N: 334095.3771  
E: 133197.0192

RECORD: P.I.  
STA 526+94.40  
FD STONE  
6" DOWN  
SET 3/4" PIPE  
SET P.K.NAIL  
8-13-76  
SET P.K./WASHER  
9-27-93, RCC  
FD P.K./WASHER  
1-03-12, M.C.  
5/15/13, SDC  
FD MONBOX  
NEWREF33  
5-01-14, TMR  
FD MONBOX W/ 1" IPIN  
REF33  
6-20-23, TDN  
DND  
3-19-24, TDN

NOTE: REF17 SR 590

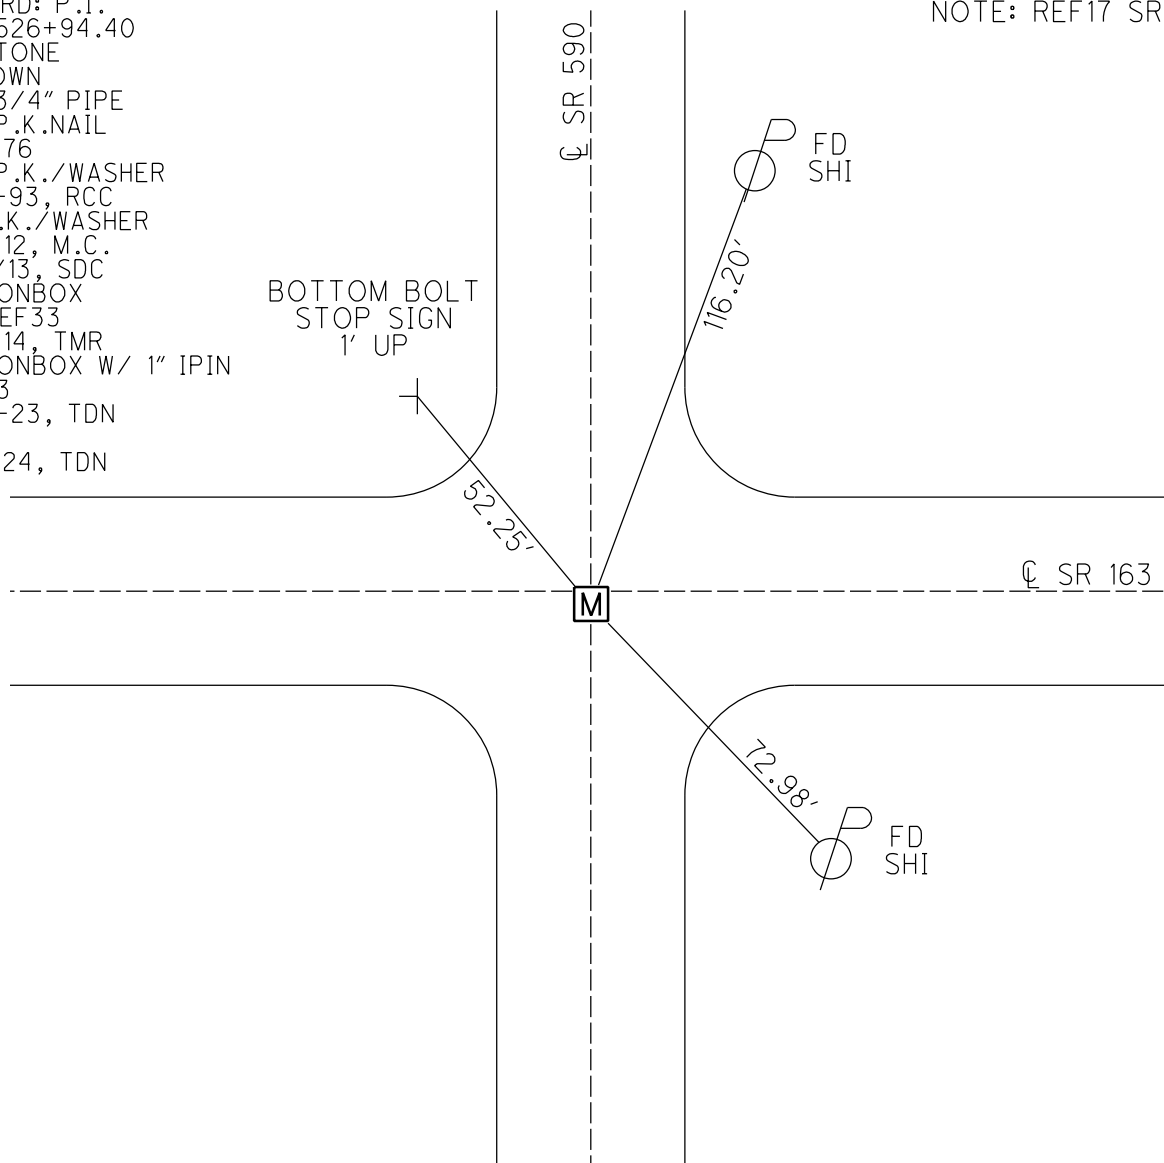

O.D.O.T. DISTRICT 2 SURVEY OFFICE (USE ONLY)

PERSONNEL

REFERENCE NO.

33

SHEET

19

OF 20

NOTES

RHOADES

DATE

5/15/13

ROUTE

SR 163

H.C.

CODER

WEATHER

WINDY

COUNTY

OTTAWA

R.C.

ROUSOS

TEMP.

78° F

TOWNSHIP

HARRIS

SECTION

3

T 6 N

R 14 E

TYPE MONUMENT

MONBOX

ON SURFACE - ~~BELOW~~

ON

~~LEFT~~ - C PAV'T - RIGHT

0.5'

12'

TO

RT

EDGE PAVEMENT

S.L.M.


527+68

Grid: Northing:

674743.840


Easting:

1770702.899

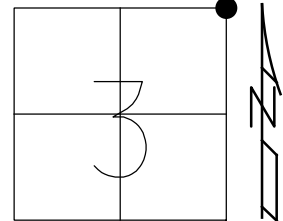

RECORD: P.I.  
STA 526+94.40  
FD STONE  
6" DOWN  
SET 3/4" PIPE  
SET P.K.NAIL  
8-13-76  
SET P.K./WASHER  
9-27-93, RCC  
FD P.K./WASHER  
1-03-12, M.C.  
FD P.K.NAIL  
5/15/13, SDC  
FD MONBOX  
NEWREF33  
5-01-14, TMR

NOTE: REF17 SR 590

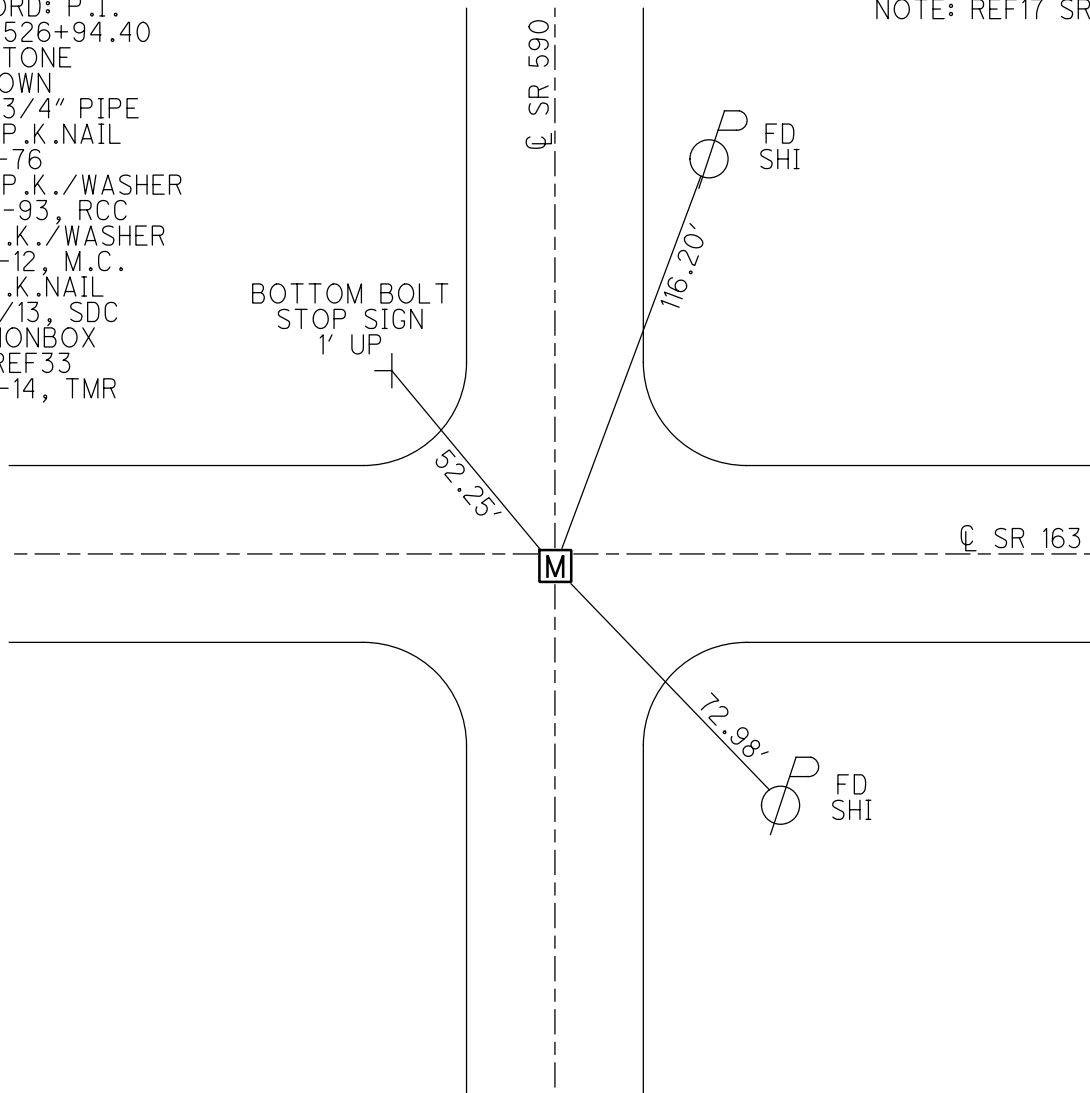

# O.D.O.T. DISTRICT 2 SURVEY OFFICE

PERSONNEL

REFERENCE NO. 33

SHEET 14 OF 24

NOTES CHENEY

H.C. RIPPLE

R.C. SARBOUR

DATE 6-17-1993

WEATHER FAIR

TEMP. 80°

ROUTE #163

COUNTY OTAWA

TOWNSHIP HARRIS

SECTION 3, 2

T. 6 N. R. 14 E

TYPE MONUMENT P.K. NAIL

ON SURFACE - BELOW ONT

~~LEFT~~ - & PAU'T. - RIGHT 0.5'

12' TO RT. EDGE PAVEMENT

S.L.M. 527+68

| SEC. | SEC. |
|------|------|
| 3    | 2    |



RECORD: 8-13-1976


P.I. STA. 526+94.40

FD. STONE 6" BELOW SURFACE

SET 3/4" PIPE

USE P.K. NAIL?

RESET P.K. NAIL

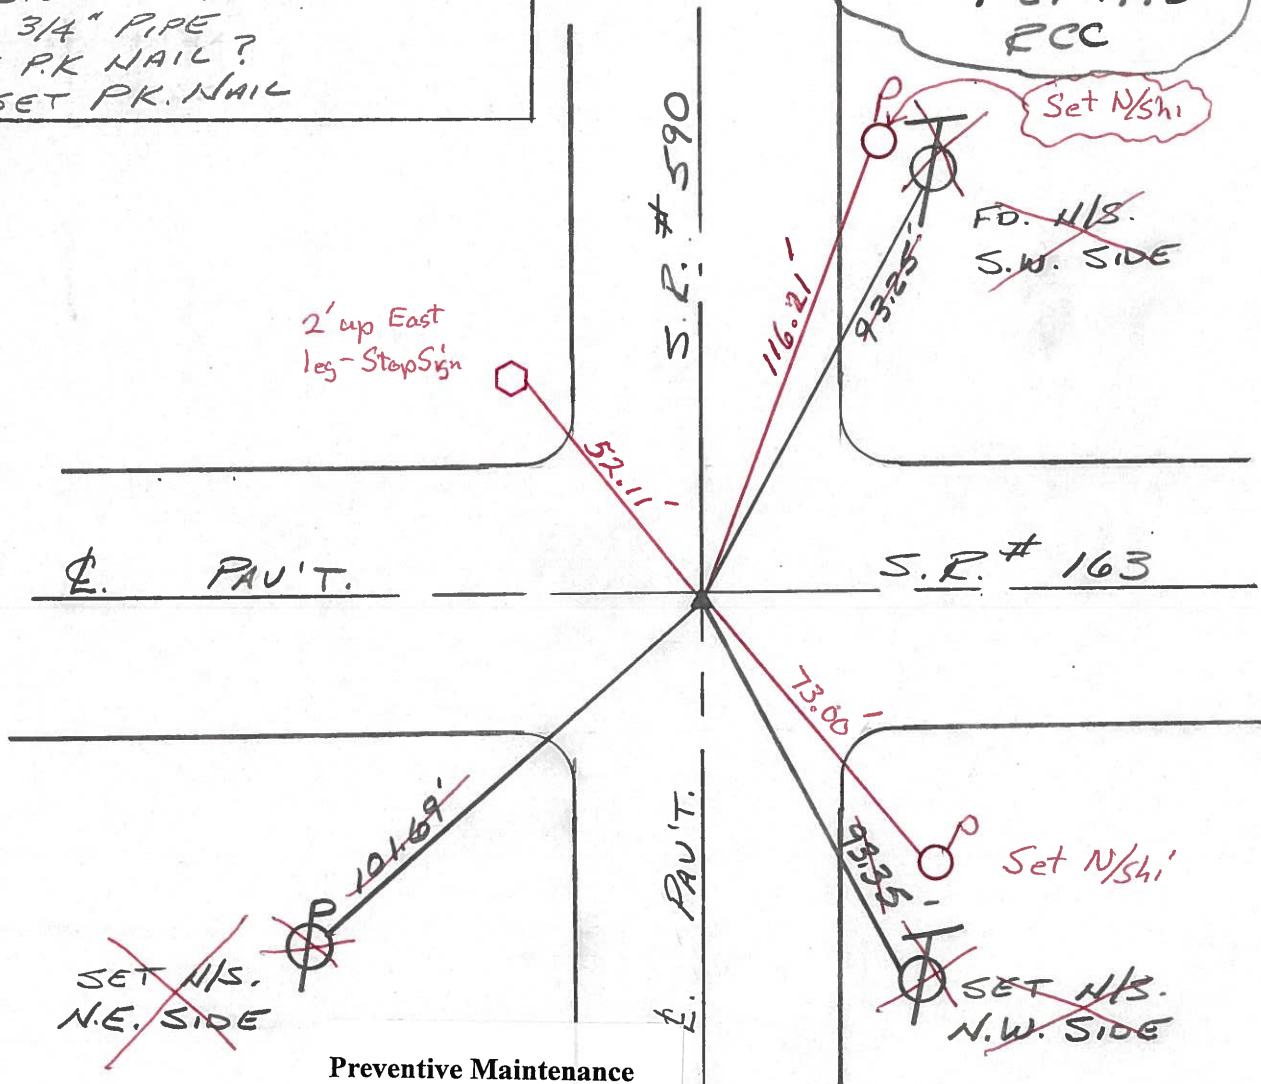

Preventive Maintenance  
Microsurfaced 2000  
Existing Point Uncovered  
Date 5-15-00

PERSONNEL TITLE PERSONNEL TITLE

COUNTY Stawa DATE 8-13-76S. R. 16.3 WEATHER FairSEC. 34-35 & 2-3 TEMP. 80°DESCRIPTION Benton & Harris Twp.

JOB NO. \_\_\_\_\_

LEFT

CENTER LINE

RIGHT

P.I.

526+94.40

Fd. stone

6" below surface

set 3/4" pipe

use P.K. Nail

Reset P.K. Nail

•33

P.I.

500+39.45

Fd. large stone

17" below surface

P.K. Nail 1" down

Reset P.K. Nail

32




P.I.

474+00.65

Fd. P.K. Nail

Lt. edge of Pavmt.

31

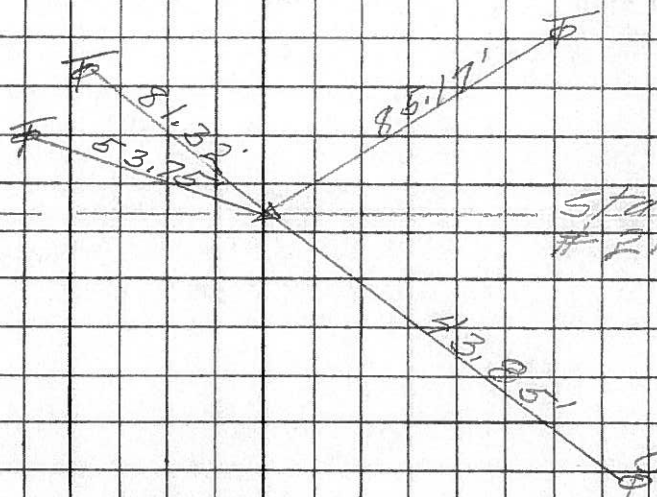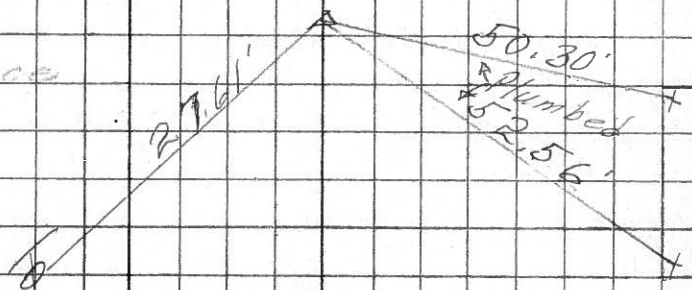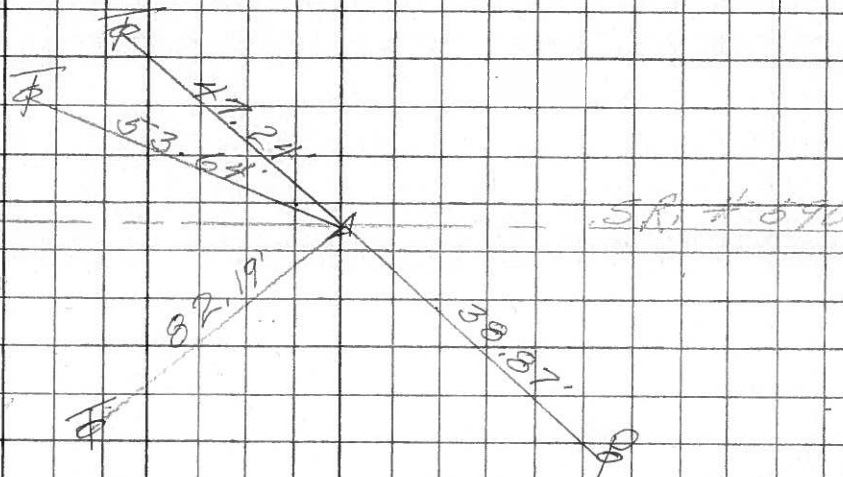

PERSONNEL TITLE PERSONNEL TITLE

COUNTY Ottawa DATE 6-28-66S. R. 163 WEATHER HotSEC. 34-35 & 2-3 TEMP. 90°DESCRIPTION Benton & Harris Twp. JOB NO.

LEFT

CENTER LINE

RIGHT

P.I.

526+94.40


Fd. Stone

6" below surface


set 3/4" Pipe

Use P.K. Nail

(33)

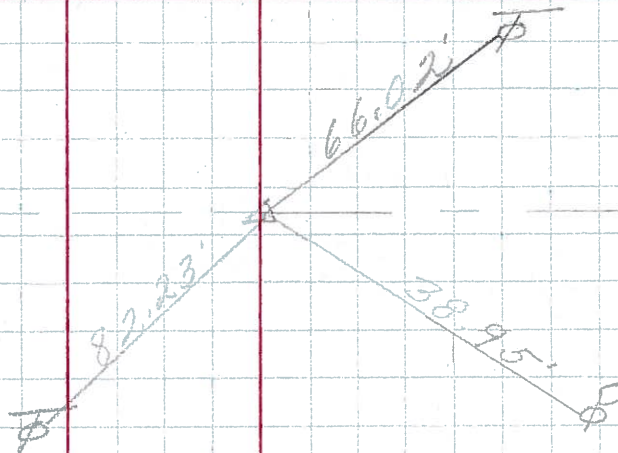

S.R. # 590

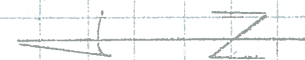

P.I.


500+39.45

Fd. Large stone

17" below surface

P.K. Nail on Top

(32)

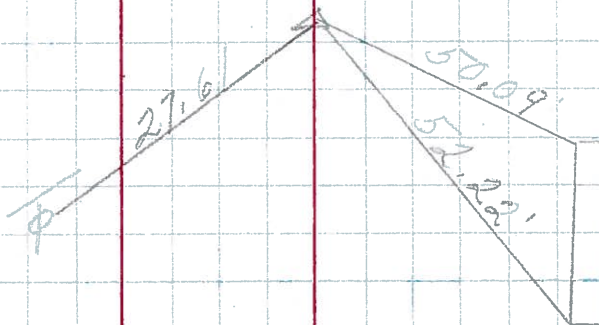

8" Conc-Block Abut.


P.I.

474+00.65

Fd. P.K. Nail

Lt. edge Perm't.

(31)

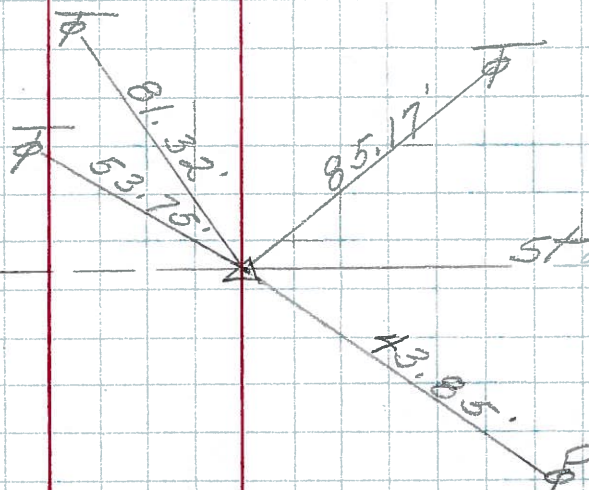Stange Rd.  
# 21

PERSONNEL TITLE PERSONNEL TITLE

COUNTY Stawa DATE 6-28-66S. R. 163 WEATHER HOTSEC. 9.98 TEMP. 90°

DESCRIPTION

LEFT

CENTER LINE

RIGHT

JOB NO.

Control Points

P.I.

553+33.17

P.K. Nail on surface

Co. Found stone

5275

(34)

Co. Rd. #75

90.79  
75

31.80

23.48

P.I.

526+94.40 (33)

Fd. stone

6" below surface

set 3/4" Pipe to surface

5274

66.02

82.23

38.95

SR #590

P.I.

500+39.45

Fd. large stone

17" below surface

5273

(32)

27.61

50.09

52.22

8" conc. block  
H&W.