

O.D.O.T. DISTRICT 2 SURVEY OFFICE (USE ONLY)

PERSONNEL

REFERENCE NO. 34

SHEET 20 OF 20

NOTES ASTON

DATE 5-13-24

ROUTE SR 163

H.C. NIESE

WEATHER BREEZY

COUNTY OTTAWA

R.C. PRESTON-COLVIN

TEMP. 70°

TOWNSHIP HARRIS

DWG BY ASTON PID 101239

SECTION 2

T 6 N R 14 E

TYPE MONUMENT MAG/WASHER

ON SURFACE - BELOW ON

OFFSET $\perp$ PAVEMENT ON LT : RT

11.5' TO RT EDGE PAVEMENT


STATION: 554+14

HORIZ.DATUM: NAD83(2011)

GEOID: 18


GRID: NORTHING: 674746.437

EASTING: 1773343.645

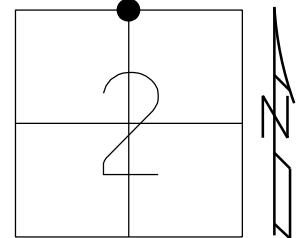

LDP
N:334116.0994
E:133197.0192


RECORD: P.I.
STA 553+33.17
COUNTY FOUND STONE
PK NAIL ON SURFACE
SET PK NAIL
11-13-76
SET PK/WASHER
9-27-93, RCC
FD PK/WASHER
REF34
1-03-12, M.C.
FD RSPK
9" DOWN
REF34
6-20-23, TDN
SET MAG/WASHER
5-13-24

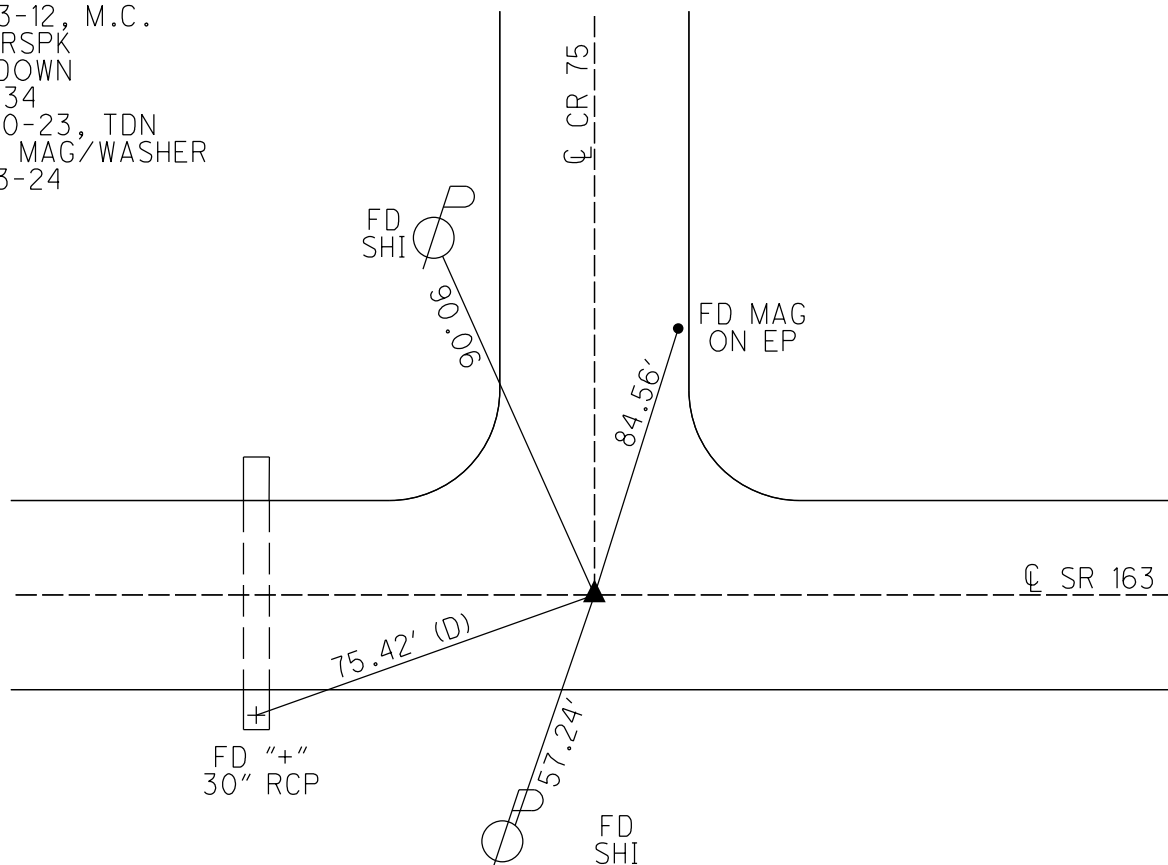

O.D.O.T. DISTRICT 2 SURVEY OFFICE (USE ONLY)


PERSONNEL	REFERENCE NO. <u>34</u>	SHEET <u>20</u> OF <u>20</u>
NOTES	DATE <u>5/15/13</u>	ROUTE <u>SR 163</u>
H.C. <u>RHOADES</u>	WEATHER <u>WINDY</u>	COUNTY <u>OTTAWA</u>
R.C. <u>ROUSOS</u>	TEMP. <u>78° F</u>	TOWNSHIP <u>HARRIS</u>
		SECTION <u>2</u>
		T <u>6</u> N R <u>14</u> E

TYPE MONUMENT P.K./WASHER
 ON SURFACE - ~~BELOW~~ ON
~~LEFT~~ - Q PAV'T - ~~RIGHT~~ ON
11.5' TO RT EDGE PAVEMENT
 S.L.M. 554+14

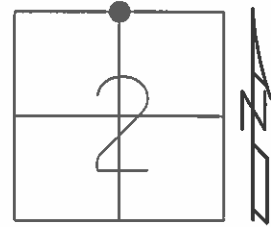

Grid: Northing: 674746.3502 Easting: 1773343.4152

RECORD: P.I.
 STA 553+33.17
 COUNTY FOUND STONE
 PK NAIL ON SURFACE
 SET PK NAIL
 11-13-76
 SET PK/WASHER
 9-27-93, RCC
 FD PK/WASHER
 REF34
 1-03-12, M.C.

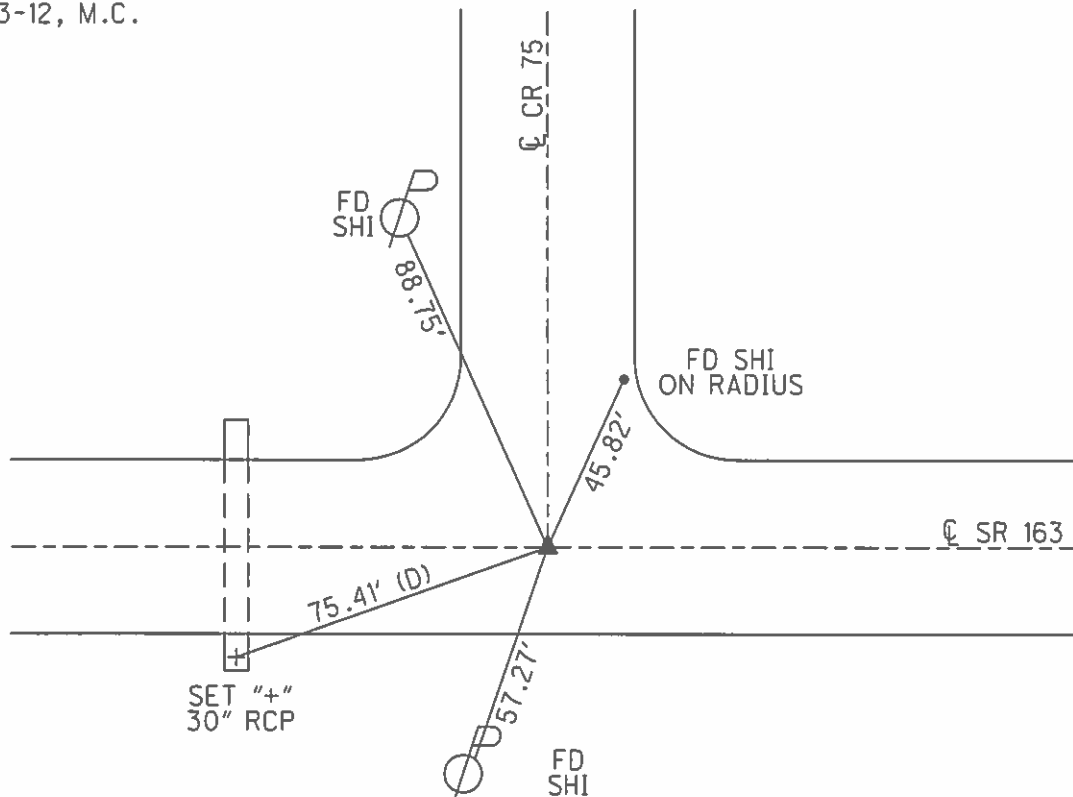

O.D.O.T. DISTRICT 2 SURVEY OFFICE

PERSONNEL

REFERENCE NO. 34

SHEET 15 OF 24

NOTES CHENEY

H.C. RIPPLE

R.C. BARBOUR

DATE 6-17-1993

WEATHER FAIR

TEMP. 80°

ROUTE #163

COUNTY OTTAWA

TOWNSHIP HAERIS

SECTION 2

T. 6 N. R. 14E


TYPE MONUMENT 1" ROD IN CONC.

~~ON~~ SURFACE - BELOW 7"

~~LEFT~~ - C PAV'T. - ~~RIGHT~~ ON

11.5' TO RT. EDGE PAVEMENT

S.L.M. 554+14

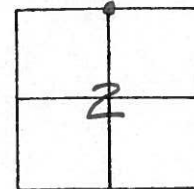

RECORD: 11-13-1976

P.I. STA. 553+33.17

COUNTY FOUND STONE

RK. NAIL ON SURFACE


RESET RK. NAIL

SET. PK/WASHER

9-27-1993

RCC

SET N/S.
S.E. SIDE

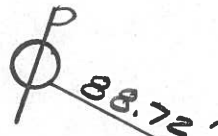

C.R. #75

SET N/S.
ON RADIUS

45.82'

C. PAV'T.

S.R. #163

57.34'

FO. N/S.
N. SIDE

Preventive Maintenance
Microsurfaced 2000
Existing Point Uncovered
Date 5-15-00

PERSONNEL TITLE PERSONNEL TITLE

COUNTY OKMAY DATE 11-13-76S. R. 13 WEATHER FairSEC. 35-36 E 1 R TEMP. 80°DESCRIPTION Benton of Vicksburg 70101 JOB NO.

LEFT

CENTER LINE

RIGHT

P.I. 36

600+23.00

Fd. Nigger Head

with iron pin

N.E. of stone

2' Rt. of L 1.35' down

Reset PK. Nails

see sheet 12A

P.I.

579+70.82

Fd. 1/2" iron pin

0.85' down

did not find stone

around or below pin

Reset PK. Nails

35

P.I.

553+33.17




P.K. Nail on

surface:

County found stone

Reset PK. Nail

34

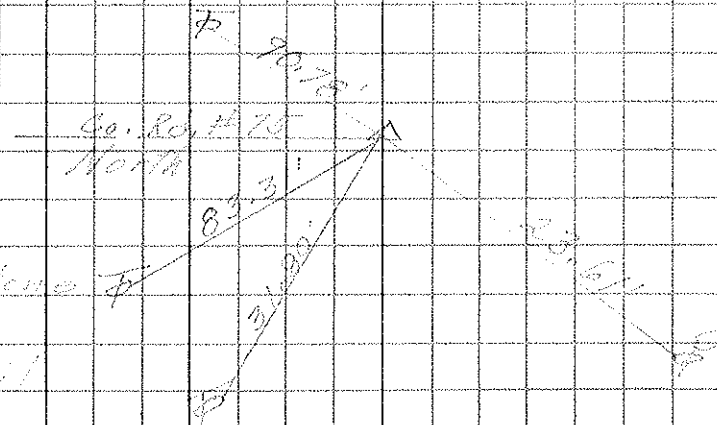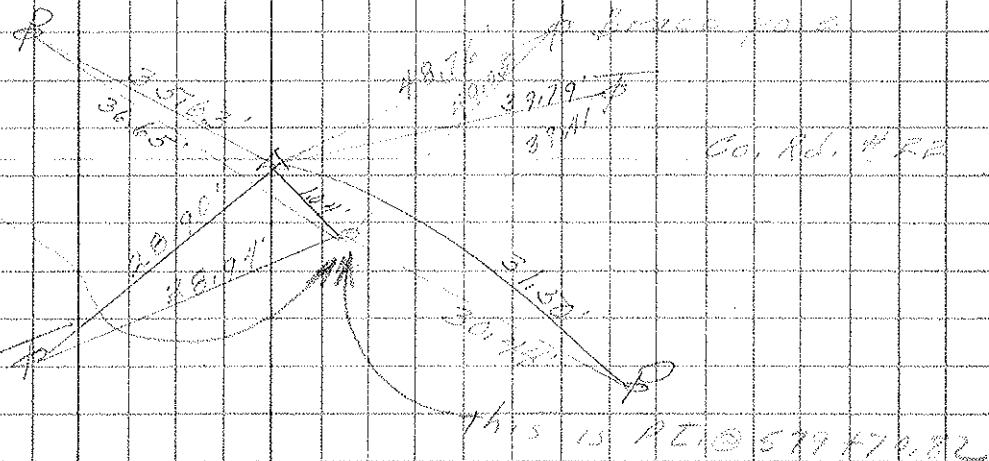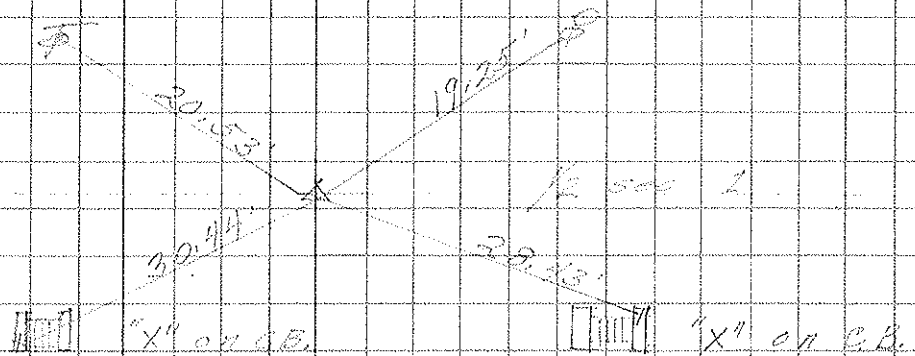

PERSONNEL TITLE PERSONNEL TITLE

COUNTY OttawaDATE 6-28-66S. R. 163WEATHER HotSEC. 9.98TEMP. 90°

DESCRIPTION

Control Points

LEFT

CENTER LINE

RIGHT

JOB NO.

P.I.

553+33.17


P.K. Nail on surface

Co. Found stone

5275

(34)

Co. Rd. #75

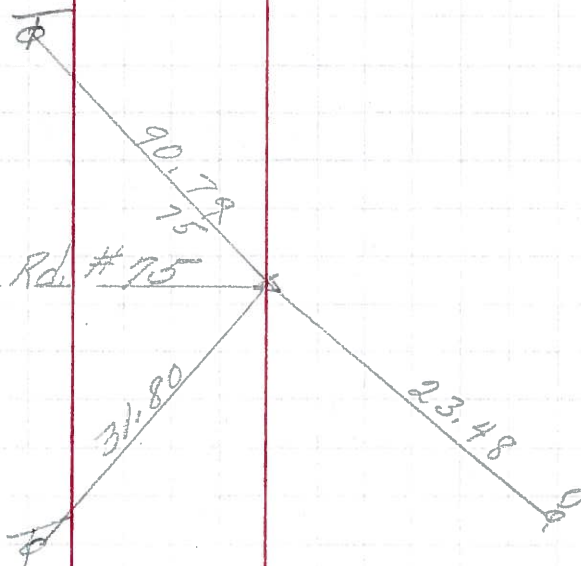

P.I.

526+94.40


Fd. stone

6" below surface

set 3/4" Pipe to surface

5274

(33)

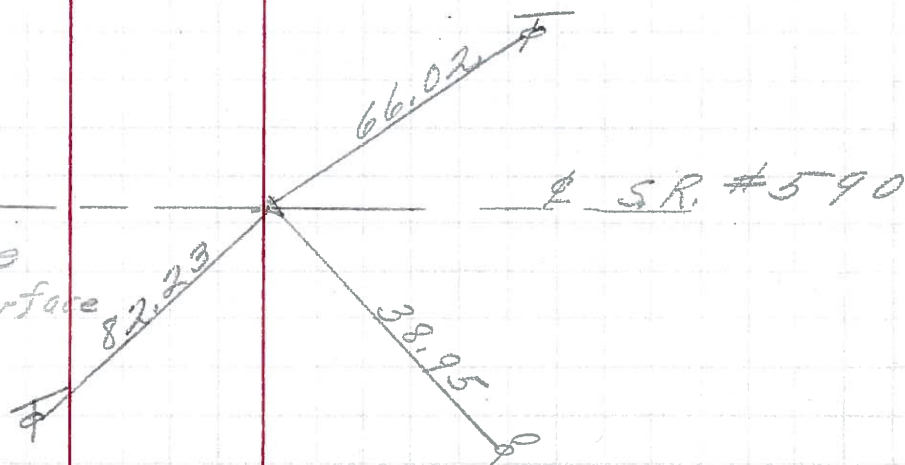

E SR. #590

P.I.


500+39.45

Fd. large stone

17" below surface

5273

(32)

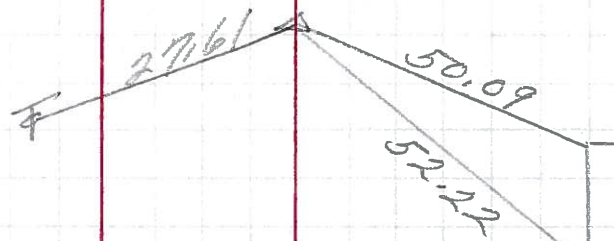8" conc. block
H&W.

