

O.D.O.T. DISTRICT 2 SURVEY OFFICE (USE ONLY)

PERSONNEL

REFERENCE NO. 35

SHEET 2 OF 17

NOTES ASTON

DATE 5-13-24

ROUTE SR 163

H.C. NIESE

WEATHER BREEZY

COUNTY OTTAWA

R.C. PRESTON-COLVIN

TEMP. 70°

TOWNSHIP HARRIS

MILLER & BLUBAUGH

SECTION 1

DWG BY ASTON PID 101239

T 6 N R 14 E

TYPE MONUMENT MAG/WASHER

ON SURFACE - ~~BELOW~~ ON

OFFSET Q PAVEMENT ON LT : RT

11.0' TO RT EDGE PAVEMENT


STATION: 580+58

HORZ.DATUM: NAD83(2011)


GEOID: 18

GRID: NORTHING: 674707.476

EASTING: 1777305.869

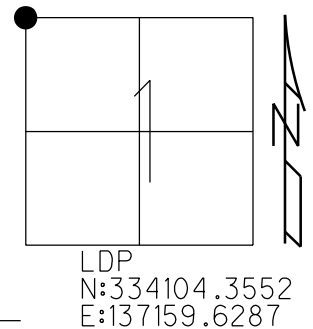

RECORD: P.I.
STA 579+70.82
FD 1/2" IPIN
0.85' DOWN
SET P.K. NAIL
11/13/76
SET P.K./WASHER
9/27/93, RCC
FD P.K./WASHER
5/15/00
FD PK WASH
REF 35
6-20-23, TDN
SET MAG/W
5-13-24, TDN

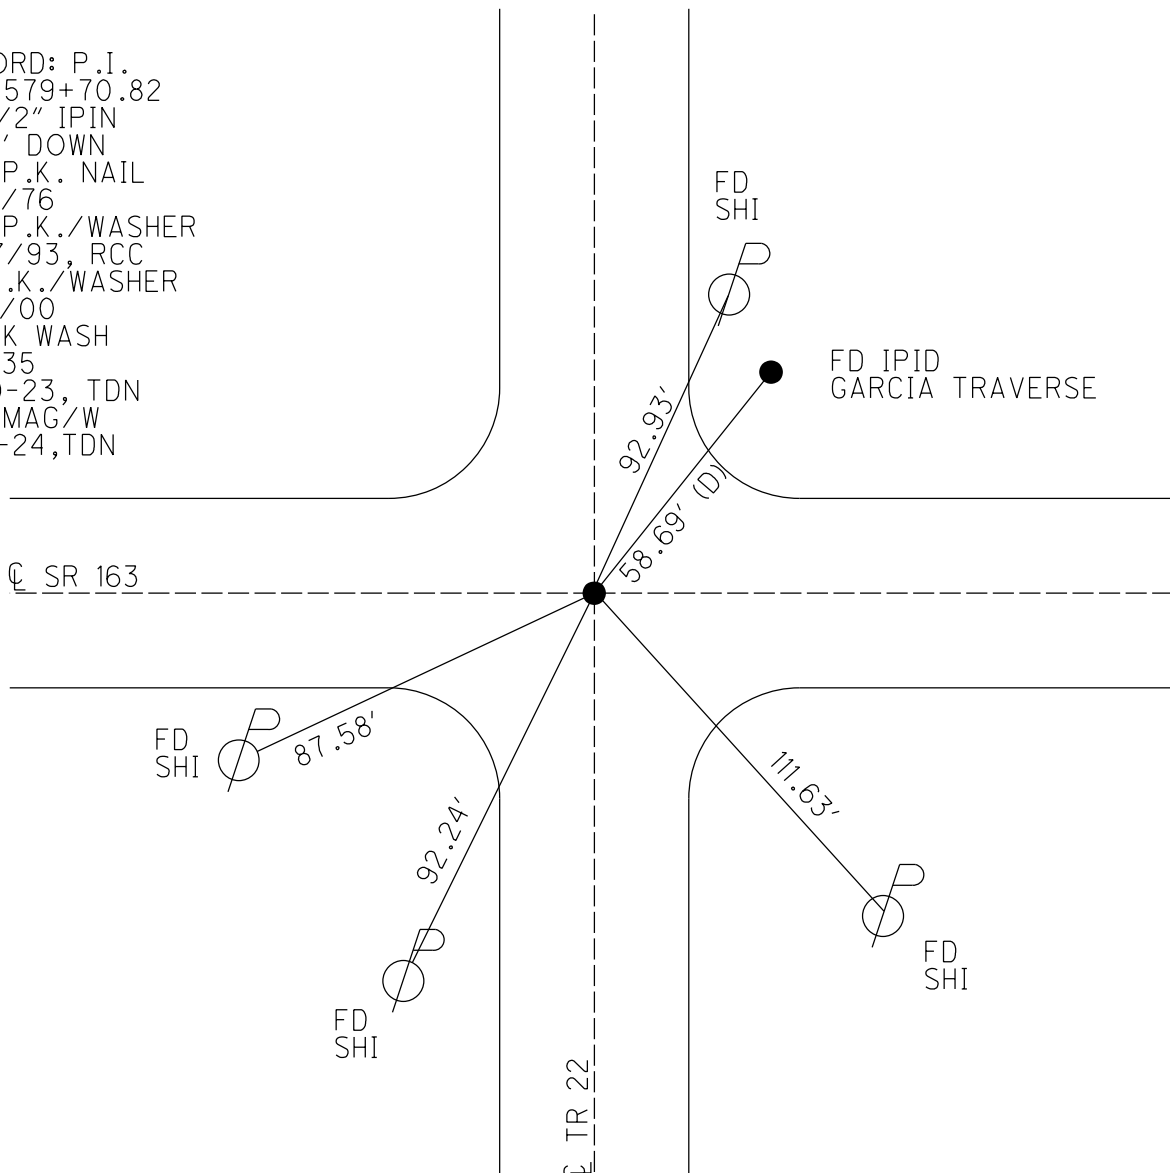

O.D.O.T. DISTRICT 2 SURVEY OFFICE (USE ONLY)

PERSONNEL

REFERENCE NO. 35

SHEET 2 OF 17

NOTES CHENEY DATE 6/17/93

H.C. RIPPLE WEATHER FAIR

R.C. BARBOUR TEMP. 80°

ROUTE SR 163

COUNTY OTTAWA

TOWNSHIP HARRIS

SECTION 1

DWG BY NIESE PID

T 6 N R 14 E

TYPE MONUMENT P.K. NAIL

ON SURFACE - ~~BELOW~~ ON


OFFSET Q PAVEMENT ON LT : RT

11.0' TO RT EDGE PAVEMENT


STATION: 580+58

HORZ.DATUM: GEOID:

GRID: NORTHING: EASTING:

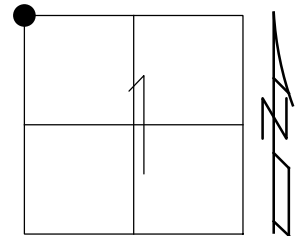

RECORD: P.I.
STA 579+70.82
FD 1/2" IPIN
0.85' DOWN
SET P.K. NAIL
11/13/76
SET P.K./WASHER
9/27/93, RCC
FD P.K./WASHER
5/15/00

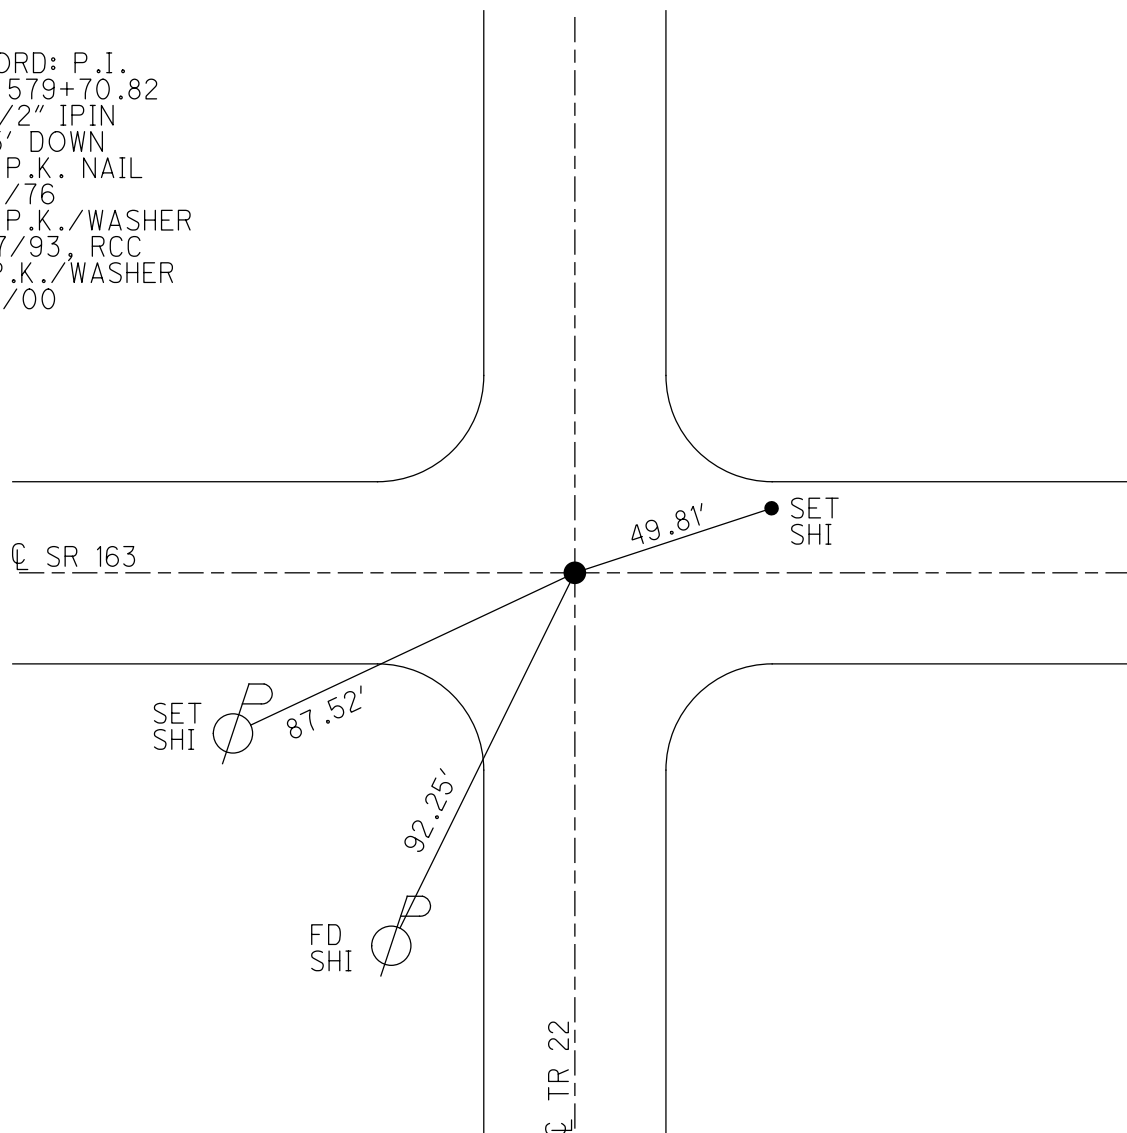

O.D.O.T. DISTRICT 2 SURVEY OFFICE

PERSONNEL

REFERENCE NO. 35

SHEET 16 OF 24

NOTES CHENEY

H.C. RIPPLE

R.C. BARBOUR

DATE 6-17-1993

WEATHER FAIR

TEMP. 80°

ROUTE #163

COUNTY OTAWA

TOWNSHIP HARRIS

SECTION 2, 1

T 6 N R 14 E


TYPE MONUMENT P.K. NAIL

ON SURFACE - BELOW ON

LEFT - C. PAV'T. - RIGHT ON

11' TO RT. EDGE PAVEMENT

S.L.M. 580+58

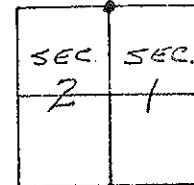

RECORDED: 11-13-1976


P.I. STA. 579+70.82

FD. 1/2" IRON PIN

0.85' DOWN - DID

NOT FIND STONE

RESET P.K. NAILS

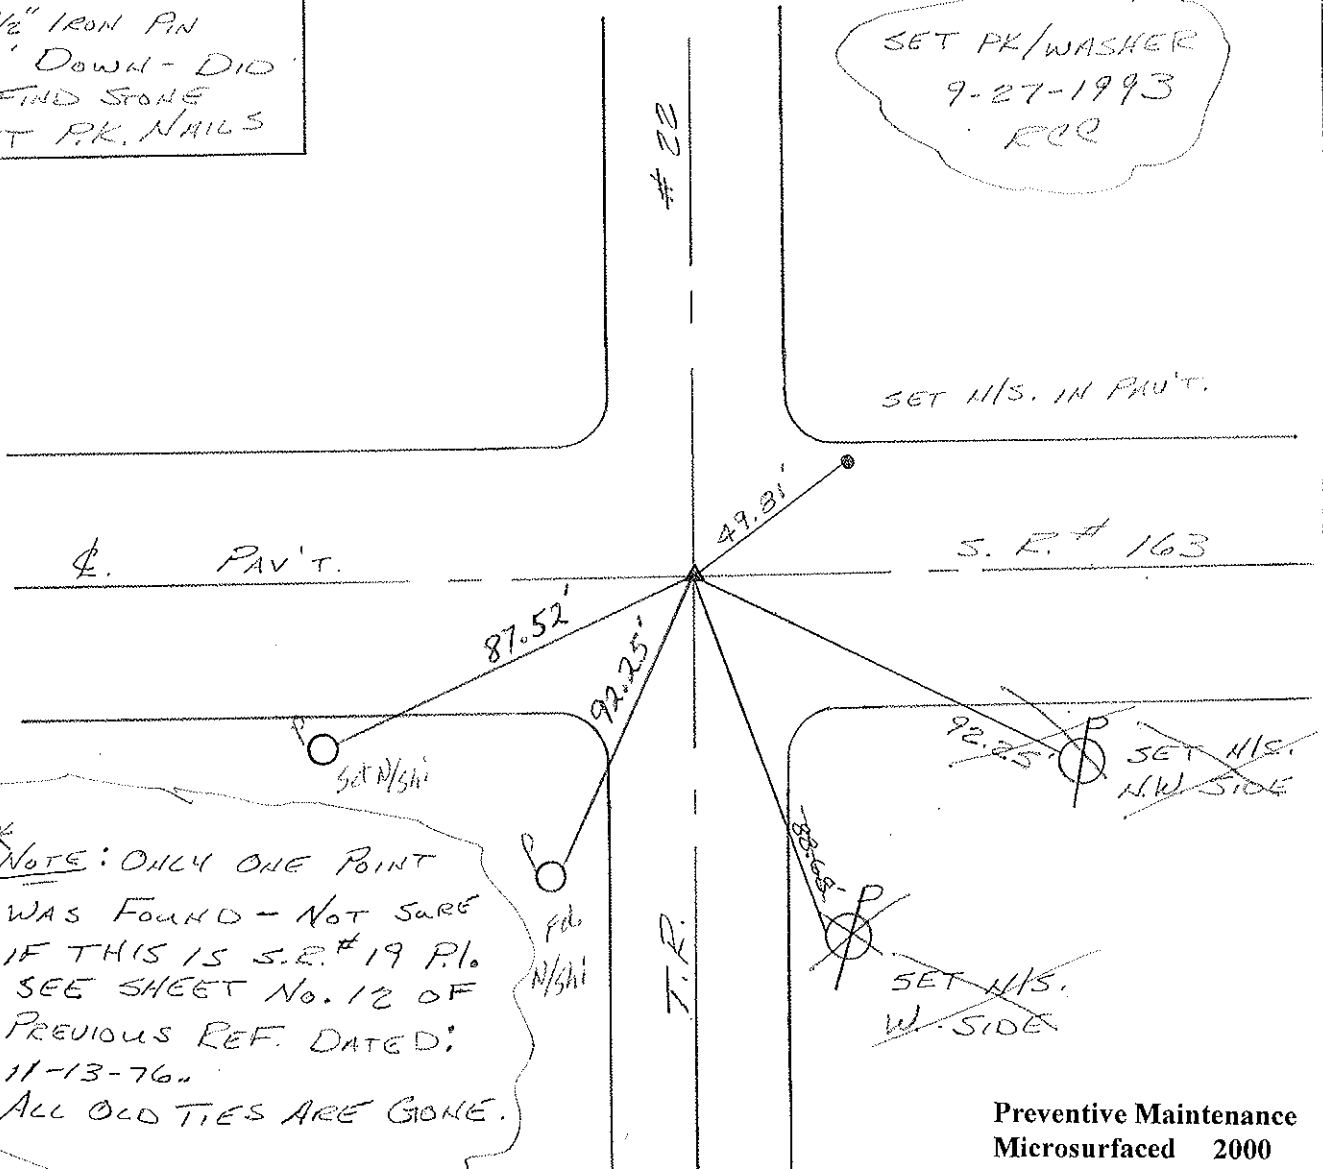

Preventive Maintenance
Microsurfaced 2000
Existing Point Uncovered
Date 5-15-00

PERSONNEL TITLE PERSONNEL TITLE

COUNTY OKMAY DATE 11-13-76S. R. 13 WEATHER FairSEC. 35-36 E 1 R TEMP. 80°DESCRIPTION Benton of Vicksburg 70101 JOB NO.

LEFT

CENTER LINE

RIGHT

P.I. 36

600+23.00

Fd. Nigger Head

with iron pin

N.E. of stone

2' Rt. of L 1.35' down

Reset PK. Nails

see sheet 12A

P.I.

579+70.82

Fd. 1/2" iron pin

0.85' down

did not find stone

around or below pin

Reset PK. Nails

35

P.I.

553+33.17




P.K. Nail on

surface:

County found stone

Reset PK. Nail

34

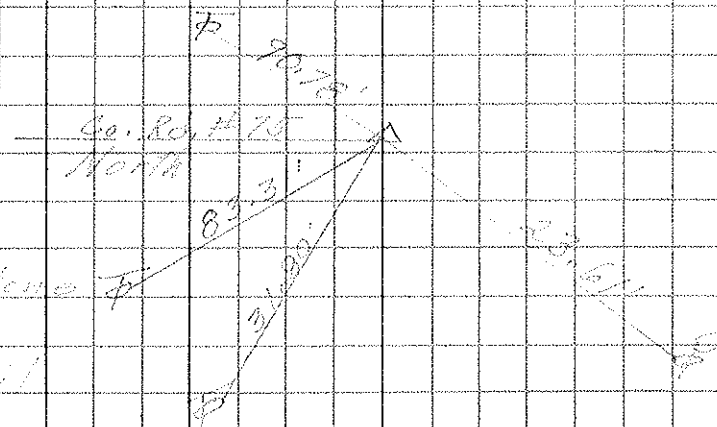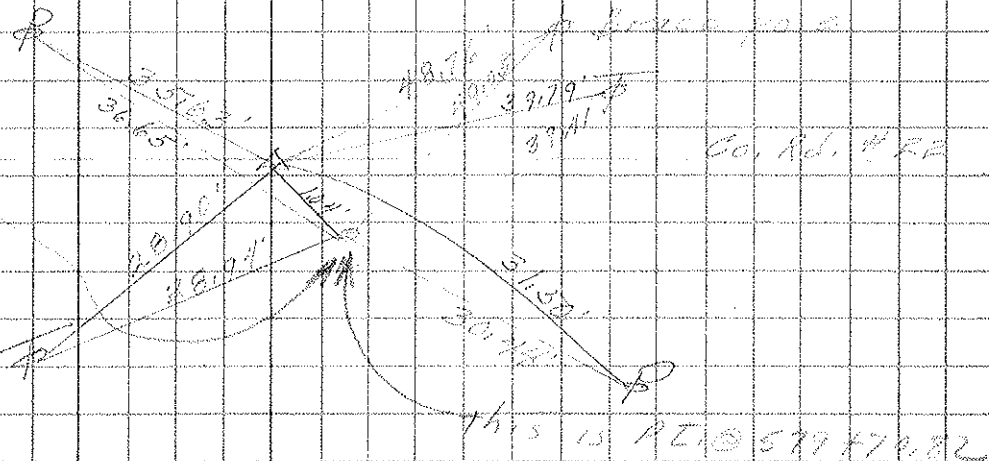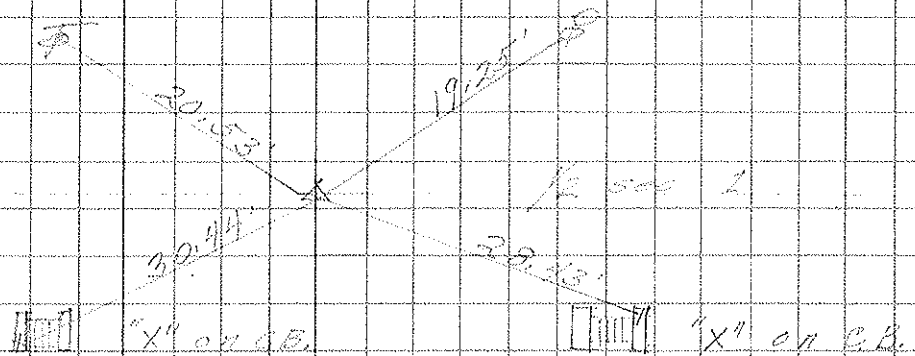

PERSONNEL TITLE PERSONNEL TITLE

COUNTY Ottawa DATE 3-3-66S. R. 163

WEATHER

SEC. 9.98TEMP. 60°

DESCRIPTION


Control Points

JOB NO.

LEFT

CENTER LINE

RIGHT

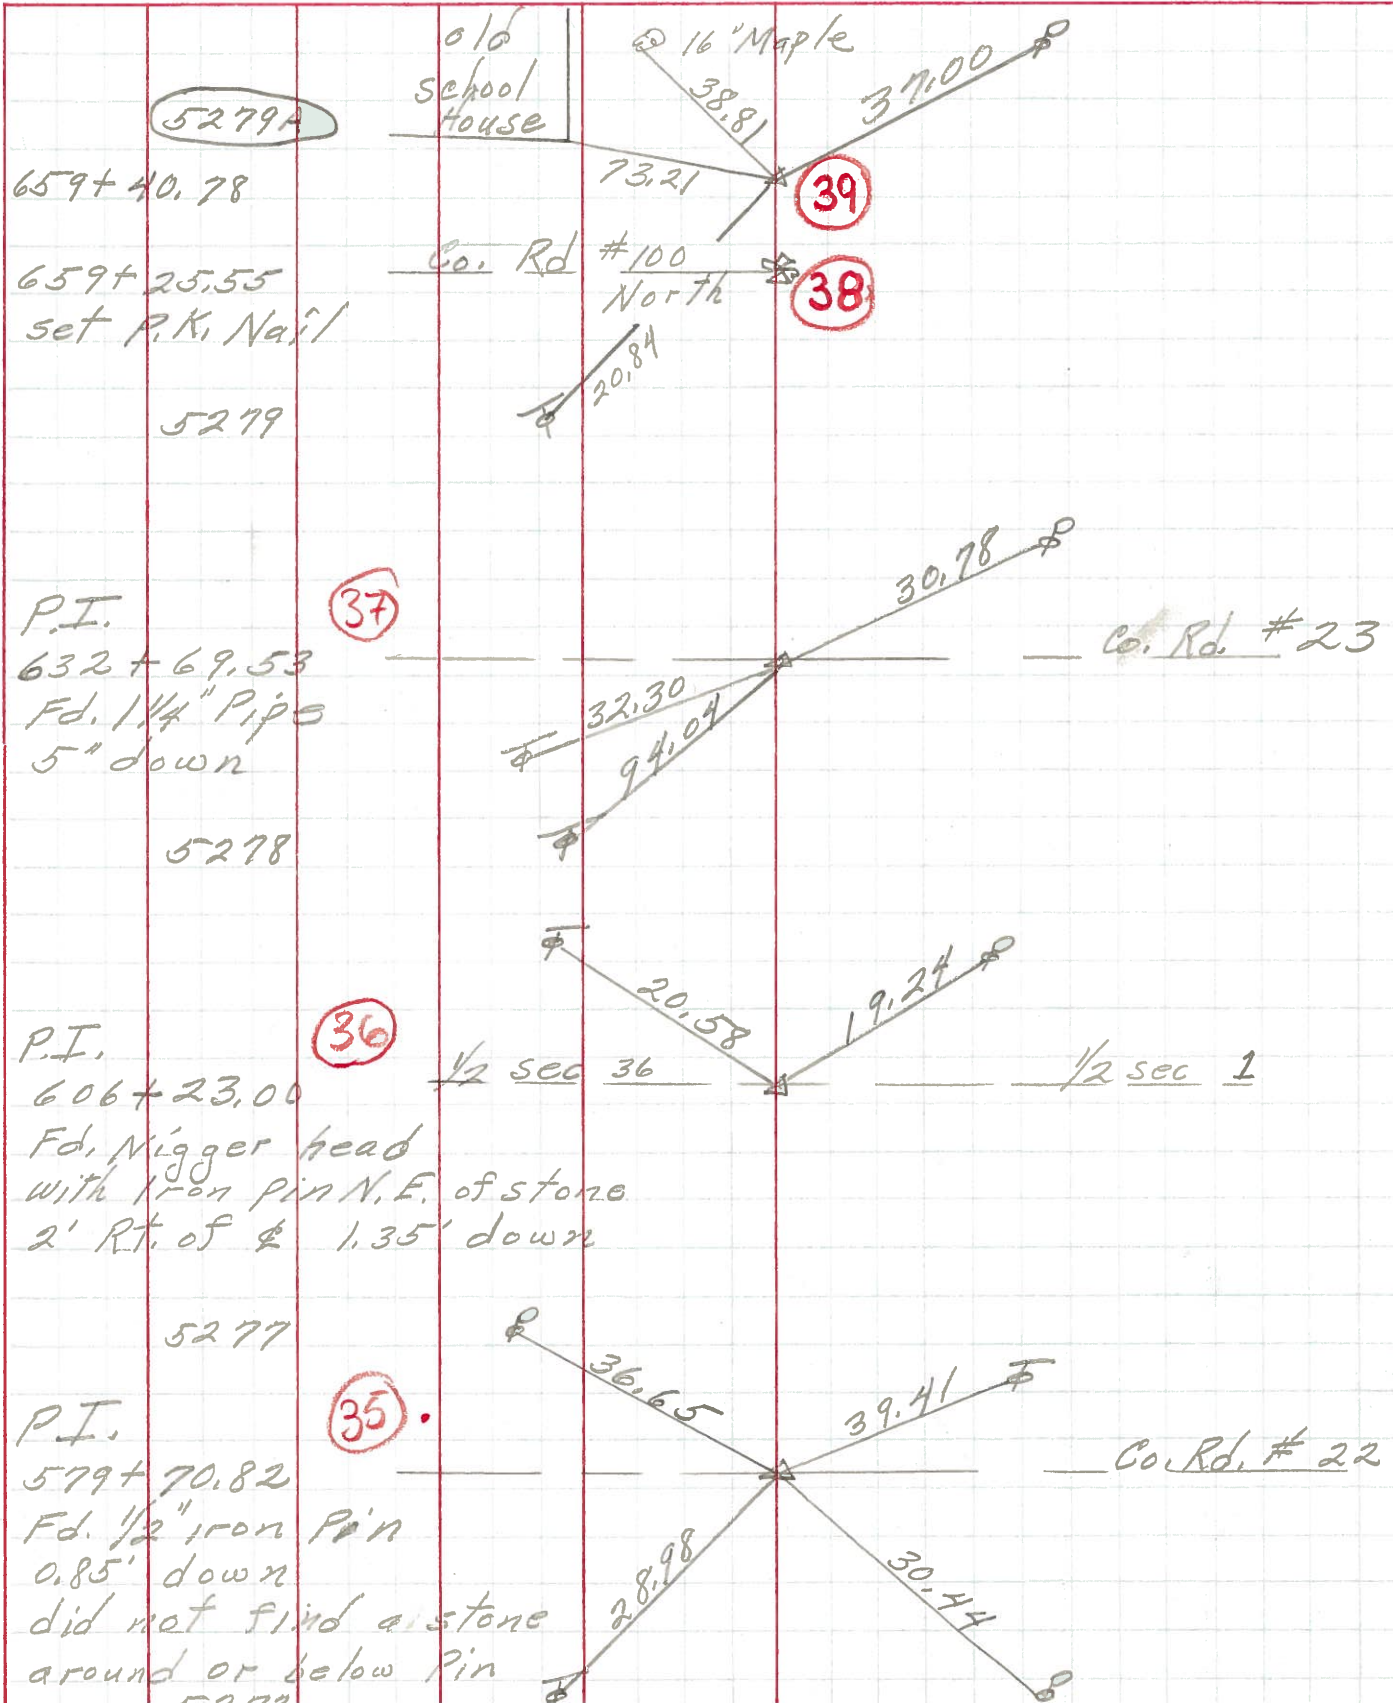

PERSONNEL TITLE PERSONNEL TITLE

COUNTY Ottawa DATE 3-3-66S. R. 163 WEATHER FairSEC. 35-36 & 1-2 TEMP. 60°DESCRIPTION Benton & Harris Twp. JOB NO. _____

LEFT

CENTER LINE


RIGHT

P.T.

606+23.00

Fd. Nigger Head
with iron Pin N.E.
of stone 2' rt.
of & 135' down

(36)

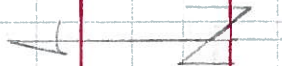

P.T.

579+70.82

Fd. 1/2" iron Pin
0.85' down
did not find stone
around or below Pin

(35)

P.T.

553+33.17

P.K. Nail on
surface County
found stone

(24)

