

PERSONNEL

REFERENCE NO. 35 B

SHEET 4 OF 17

NOTES ASTON

DATE 5-13-24

ROUTE SR 163

H.C.	NIESE
------	-------

WEATHER BREEZY

COUNTY OTTAWA

R.C. PRESTON-COLVIN

TEMP. 7

TOWNSHIP HARRIS

MILLER & BLUBAUGH

DWG BY ASTON

PID 101239

T_6_N R_14_E

TYPE MONUMENT MAG/WASHER

ON SURFACE - ~~BELOW~~ ON

OFFSET C PAVEMENT ON LT : RT

_____TO_____ EDGE PAVEMENT

STATION: 600+78.03


HORZ.DATUM: NAD83(2011)

GEOID:_____18

GRID: NORTHING: 674702.456

EASTING: 1778086.986

LDP
N:334104.7024
E:137940.8029

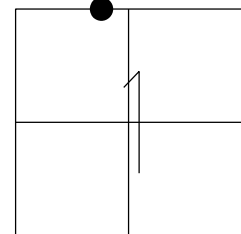

RECORD:

STA 600+78.03

FD R.R. SPIKE

6/12/74

FD RSPK


6" DOWN

REF 35B

6-20-23, TDN

SET MAG/WASHER

5-13-24, TDN

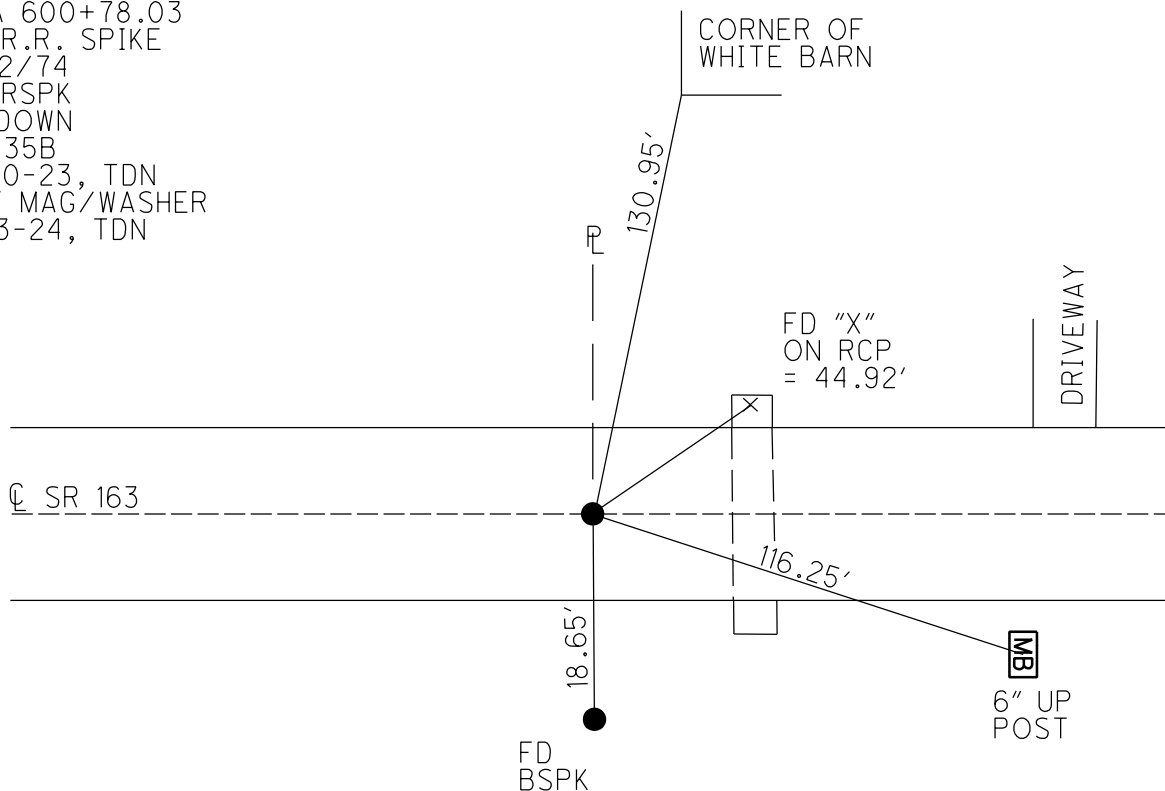

O.D.O.T. DISTRICT 2 SURVEY OFFICE (USE ONLY)

PERSONNEL

REFERENCE NO. 35 B

SHEET 4 OF 17

NOTES N/A

DATE 6/12/74

ROUTE SR 163

H.C. WEATHER FAIR

COUNTY OTTAWA

R.C. TEMP. 65°

TOWNSHIP HARRIS

SECTION 1

DWG BY NIESE PID

T 6 N R 14 E

TYPE MONUMENT R.R. SPIKE

ON SURFACE - ~~BELOW~~ ON

OFFSET $\varnothing$ PAVEMENT LT : RT

 TO EDGE PAVEMENT


STATION: 600+78.03

HORIZ.DATUM:


GEOID:

GRID: NORTHING:

EASTING:

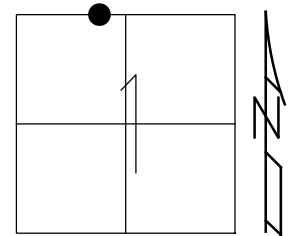

RECORD:
STA 600+78.03
FD R.R. SPIKE
6/12/74

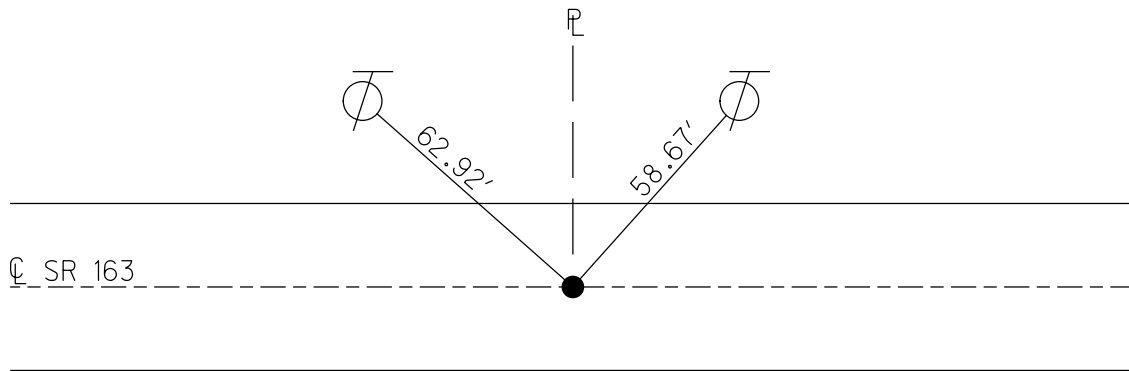

PERSONNEL TITLE PERSONNEL TITLE

COUNTY OKMAY DATE 11-13-76S. R. 13 WEATHER FairSEC. 35-36 F1 R TEMP. 80°DESCRIPTION Benton of Vicksburg 70101 JOB NO.

LEFT

CENTER LINE

RIGHT

P.I. 36

600+23.00

Fd. Nigger Head


with iron pin

N.E. of stone

2' Rt. of L 1.35' down

Reset PK. Nails

see sheet 12A

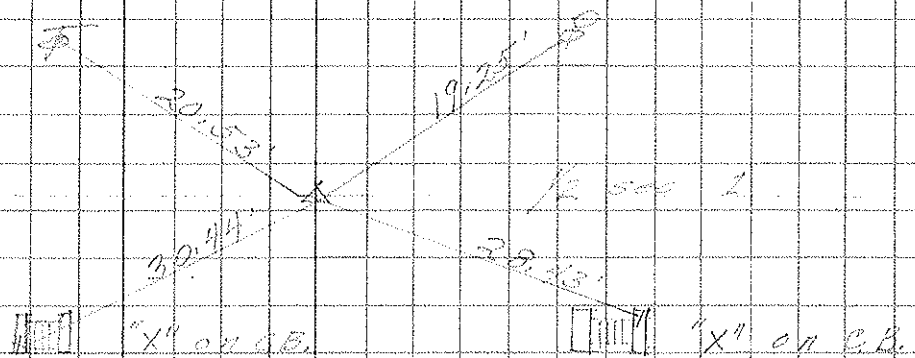

P.I.

579+70.82


Fd. 1/2" iron pin

0.85' down

did not find stone

around or below pin

Reset PK. Nails

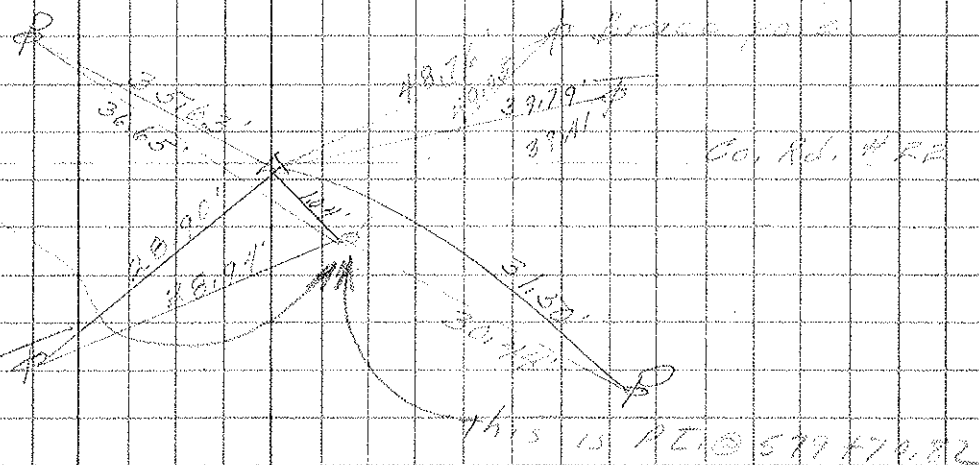

35

P.I.


553+33.17

P.K. Nail on

surface:

County found stone

Reset PK. Nail

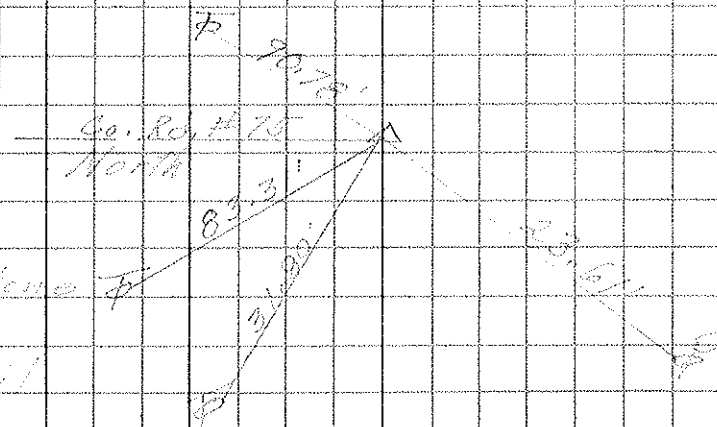

34

PERSONNEL	TITLE	PERSONNEL	TITLE
_____	_____	_____	_____
_____	_____	_____	_____
_____	_____	_____	_____

COUNTY Ottawa DATE 6-12-74

S. R. 163 WEATHER Fair

SEC. 8.28 TEMP. 65

DESCRIPTION Salmon Twp. Sec. 5 JOB NO. _____

LEFT

CENTER LINE

RIGHT

