

O.D.O.T. DISTRICT 2 SURVEY OFFICE (USE ONLY)

PERSONNEL

REFERENCE NO. 36

SHEET 5 OF 17

NOTES ASTON

DATE 5-13-24

ROUTE SR 163

H.C. NIESE

WEATHER BREEZY

COUNTY OTTAWA

R.C. PRESTON-COLVIN

TEMP. 75°

TOWNSHIP HARRIS

MILLER & BLUBAUGH

DWG BY ASTON

PID 101239

SECTION 1

T 6 N R 14 E

TYPE MONUMENT MAG/WASHER

ON SURFACE - BELOW ON

OFFSET Q PAVEMENT ON LT : RT

11.5' TO LT EDGE PAVEMENT


STATION: 601+70

HORZ.DATUM: NAD83(2011)


GEOID: 18

GRID: NORTHING: 674698.942

EASTING: 1778631.869

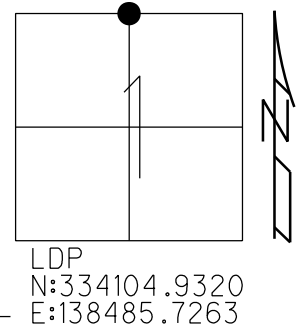

RECORD: P.I.
STA.600+23
FD R.R. SPIKE
4.5" DOWN
6/17/73, CHENEY
FD IPIN
NE OF STONE
2.0' RT OF Q
1.35' DOWN
SET P.K. NAIL
11/13/76
SET P.K./WASHER
9/27/93, RCC
D.N.F.
5/15/00
FD PK NAIL
6" DOWN
REF36
6-22-23, TDN
PULLED TIES
6-30-23, TDN
SET MAG/W
5-13-24, TDN

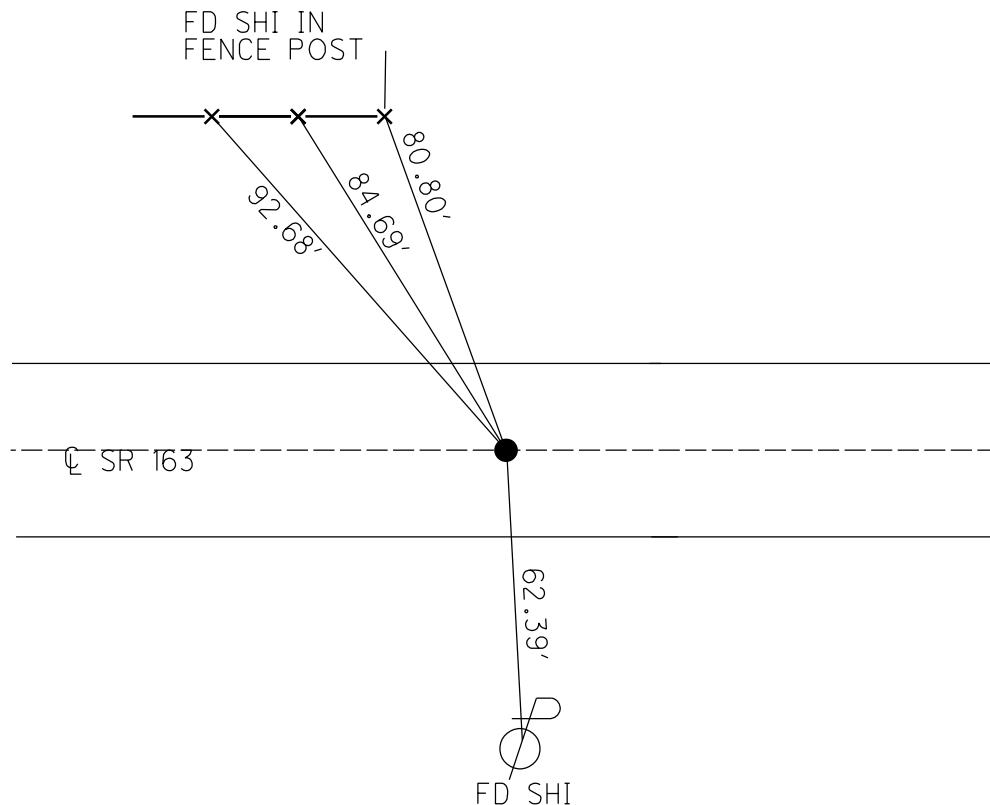

O.D.O.T. DISTRICT 2 SURVEY OFFICE (USE ONLY)

PERSONNEL

REFERENCE NO. 36

SHEET 5 OF 17

NOTES CHENEY

DATE 6/17/73

ROUTE SR 163

H.C. RIPPLE

WEATHER FAIR

COUNTY OTTAWA

R.C. BARBOUR

TEMP. 80°

TOWNSHIP HARRIS

DWG BY NIESE PID

SECTION 1

T 6 N R 14 E

TYPE MONUMENT R.R. SPIKE

~~ON SURFACE~~ - BELOW 4.5"

OFFSET CL PAVEMENT ON LT : RT

11.5' TO LT EDGE PAVEMENT


STATION: 601+70

HORIZ.DATUM:


GEOID:

GRID: NORTHING:

EASTING:

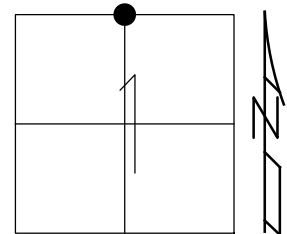

RECORD: P.I.
STA. 600+23
FD R.R. SPIKE
4.5" DOWN
6/17/73, CHENEY
FD IPIN
NE OF STONE
2.0' RT OF CL
1.35' DOWN
SET P.K. NAIL
11/13/76
SET P.K./WASHER
9/27/93, RCC
D.N.F.
5/15/00

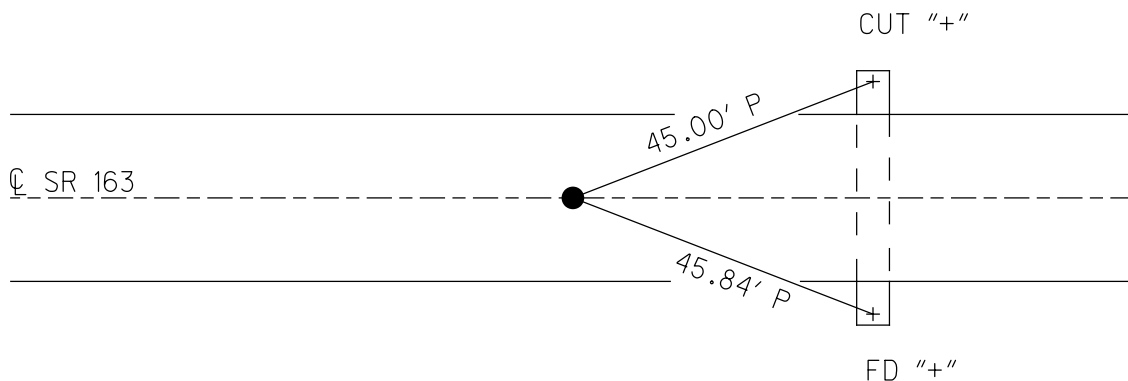

O.D.O.T. DISTRICT 2 SURVEY OFFICE

PERSONNEL

REFERENCE NO. 36 (?)

SHEET 17 OF 24

NOTES CHENEY

H.C. ZIPPLE

R.C. BARBOUR

DATE 6-17-1973

WEATHER FAIR

TEMP. 80°

ROUTE #163

COUNTY OTAWA

TOWNSHIP HARCIS

SECTION 1

T. 6 N R. 14 E


TYPE MONUMENT R.R. SPK.

~~ON~~ SURFACE - BELOW 4.5"

~~LEFT - C~~ PAV'T. - ~~RIGHT~~ ON

11.5' TO LT. EDGE PAVEMENT

S.L.M. 601+70

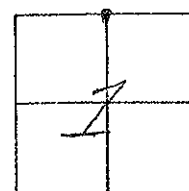

RECORDED: 11-13-1976

P.I. STA 600+23

FD. NIGGER HEAD WITH

IRON PIN N.E. OF STONE

2' RT. OF ϕ , 1.35' DOWN


RESET P.K. NAIL

* NOTE: MAY NOT BE REF. NO. 36
SEE REF. DATED: 11-13-76
SET P.K./WASHER

9-27-1993

RCC

5-15-00
D10 x 10" F 12/10

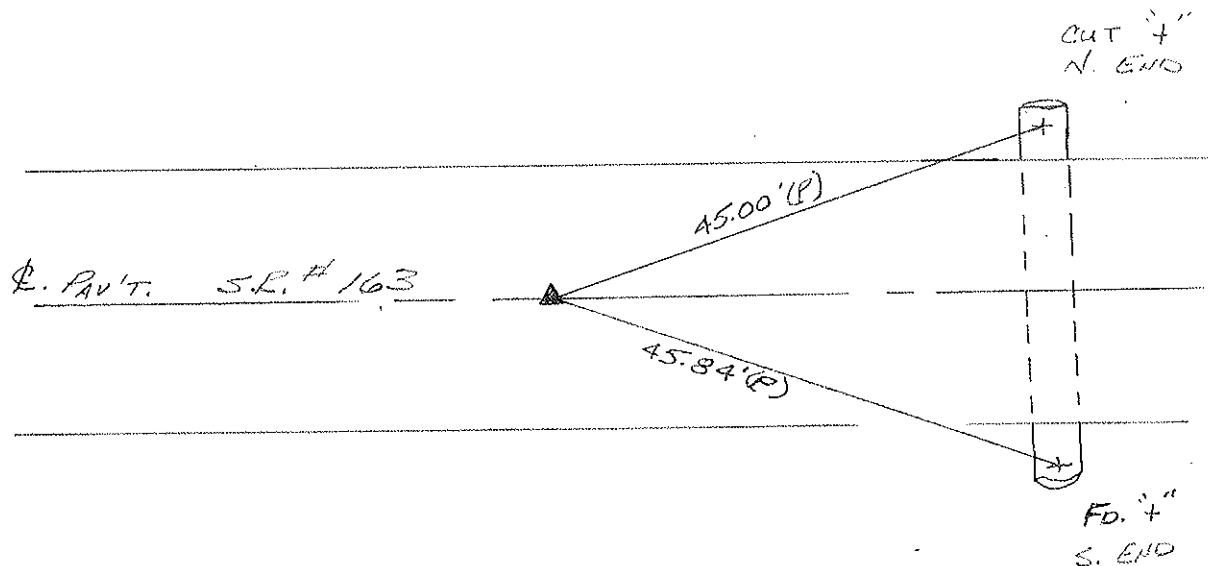

PERSONNEL TITLE PERSONNEL TITLE

COUNTY OKMAY DATE 11-13-76S. R. 13 WEATHER FairSEC. 35-36 F1 R TEMP. 80°DESCRIPTION Benton of Vicksburg 70101 JOB NO.

LEFT

CENTER LINE

RIGHT

P.I. 36

600+23.00

Fd. Nigger Head


with iron pin

N.E. of stone

2' Rt. of L 1.35' down

Reset PK. Nails

see sheet 12A

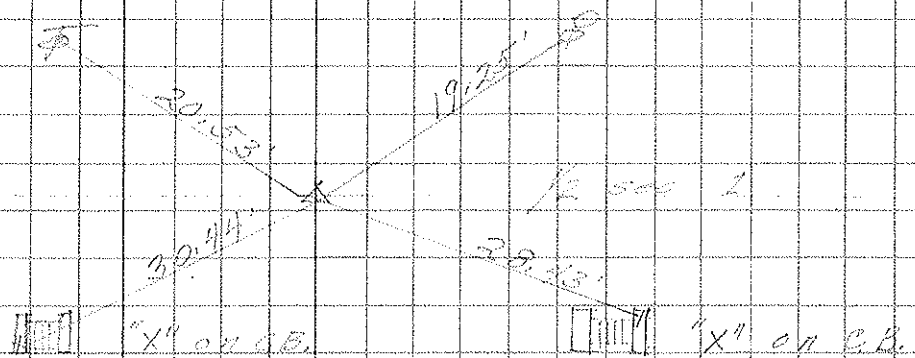

P.I.

579+70.82


Fd. 1/2" iron pin

0.85' down

did not find stone

around or below pin

Reset PK. Nails

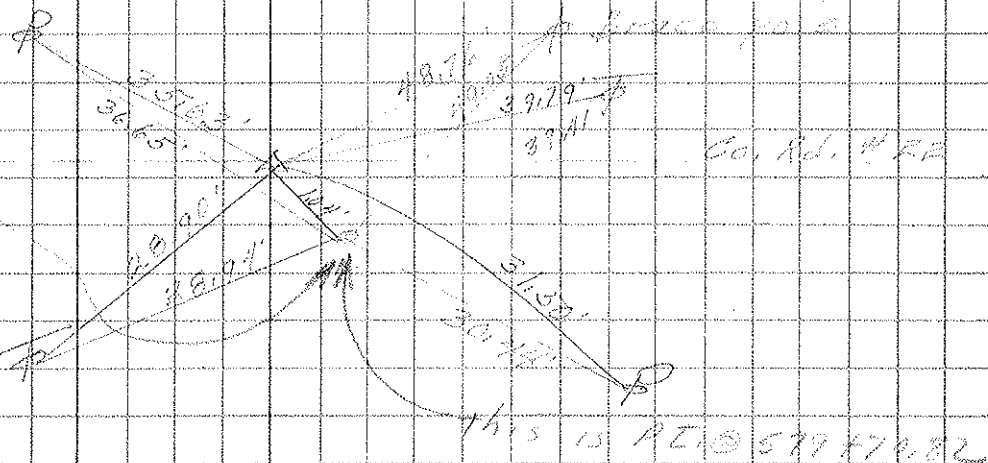

35

P.I.


553+33.17

P.K. Nail on

surface:

County found stone

Reset PK. Nail

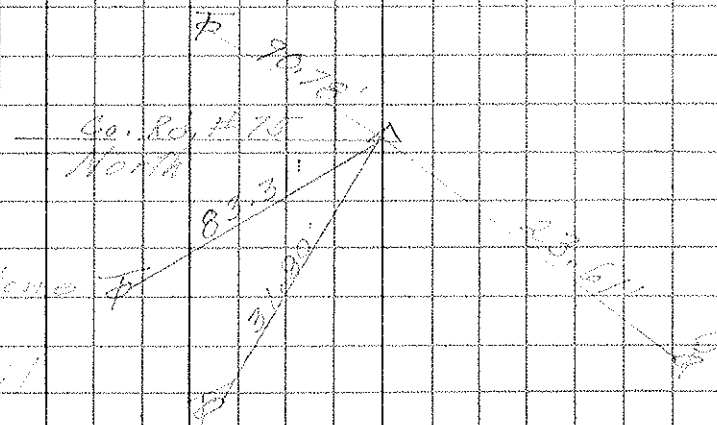

34

PERSONNEL	TITLE	PERSONNEL	TITLE

COUNTY Ottawa DATE 6-12-74

S. R. 163 WEATHER Fair


SEC. 8.28 TEMP. 65

DESCRIPTION Salem Twp. Sec. 5 JOB NO. _____

LEFT

CENTER LINE

RIGHT

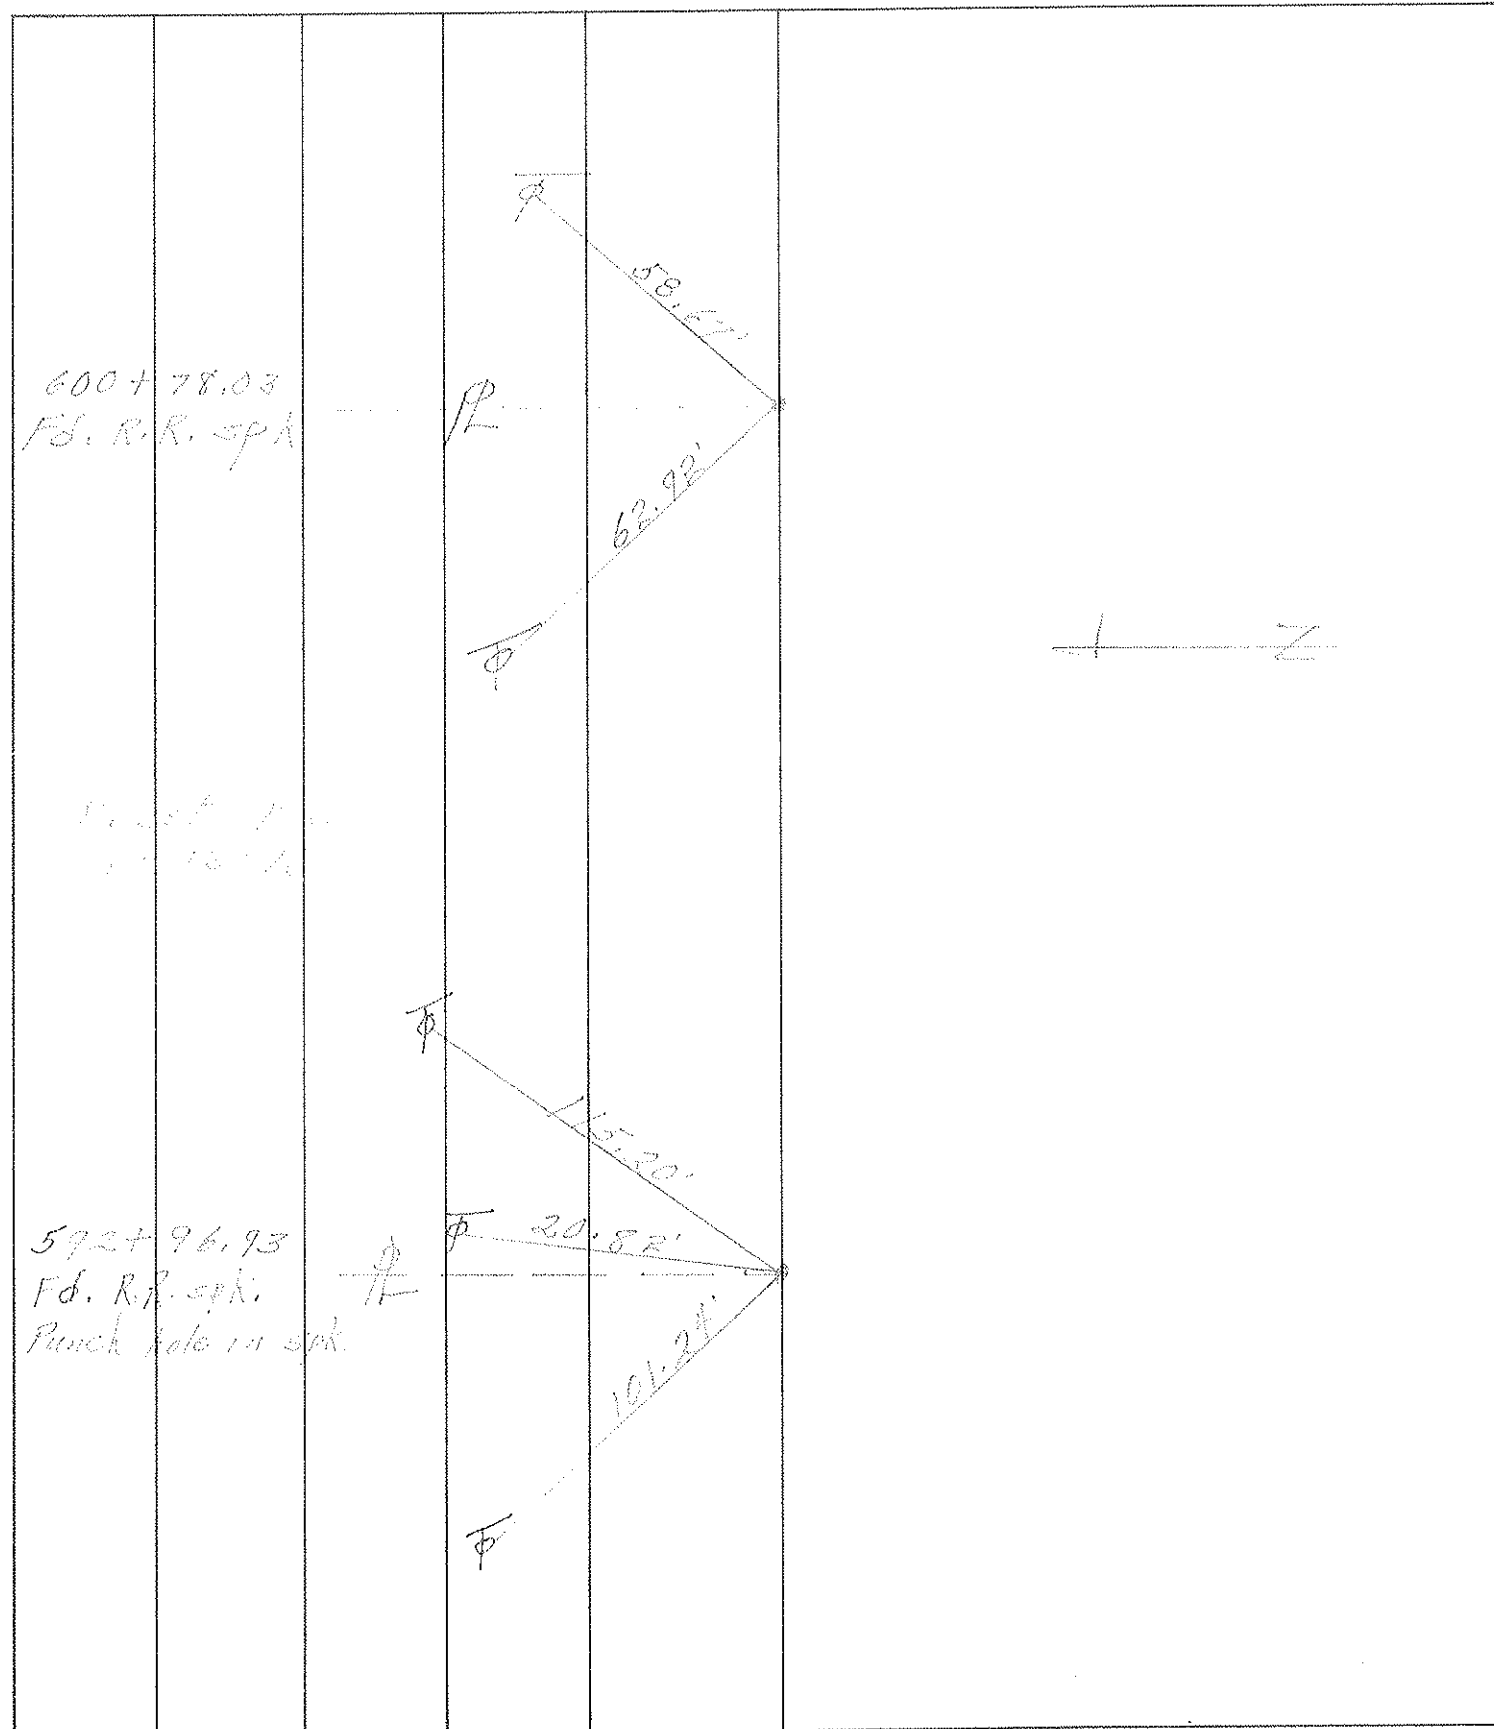


PERSONNEL TITLE PERSONNEL TITLE

COUNTY Ottawa DATE 3-3-66S. R. 163 WEATHERSEC. 9.98 TEMP. 60°DESCRIPTION Control Points JOB NO.

LEFT

CENTER LINE

RIGHT

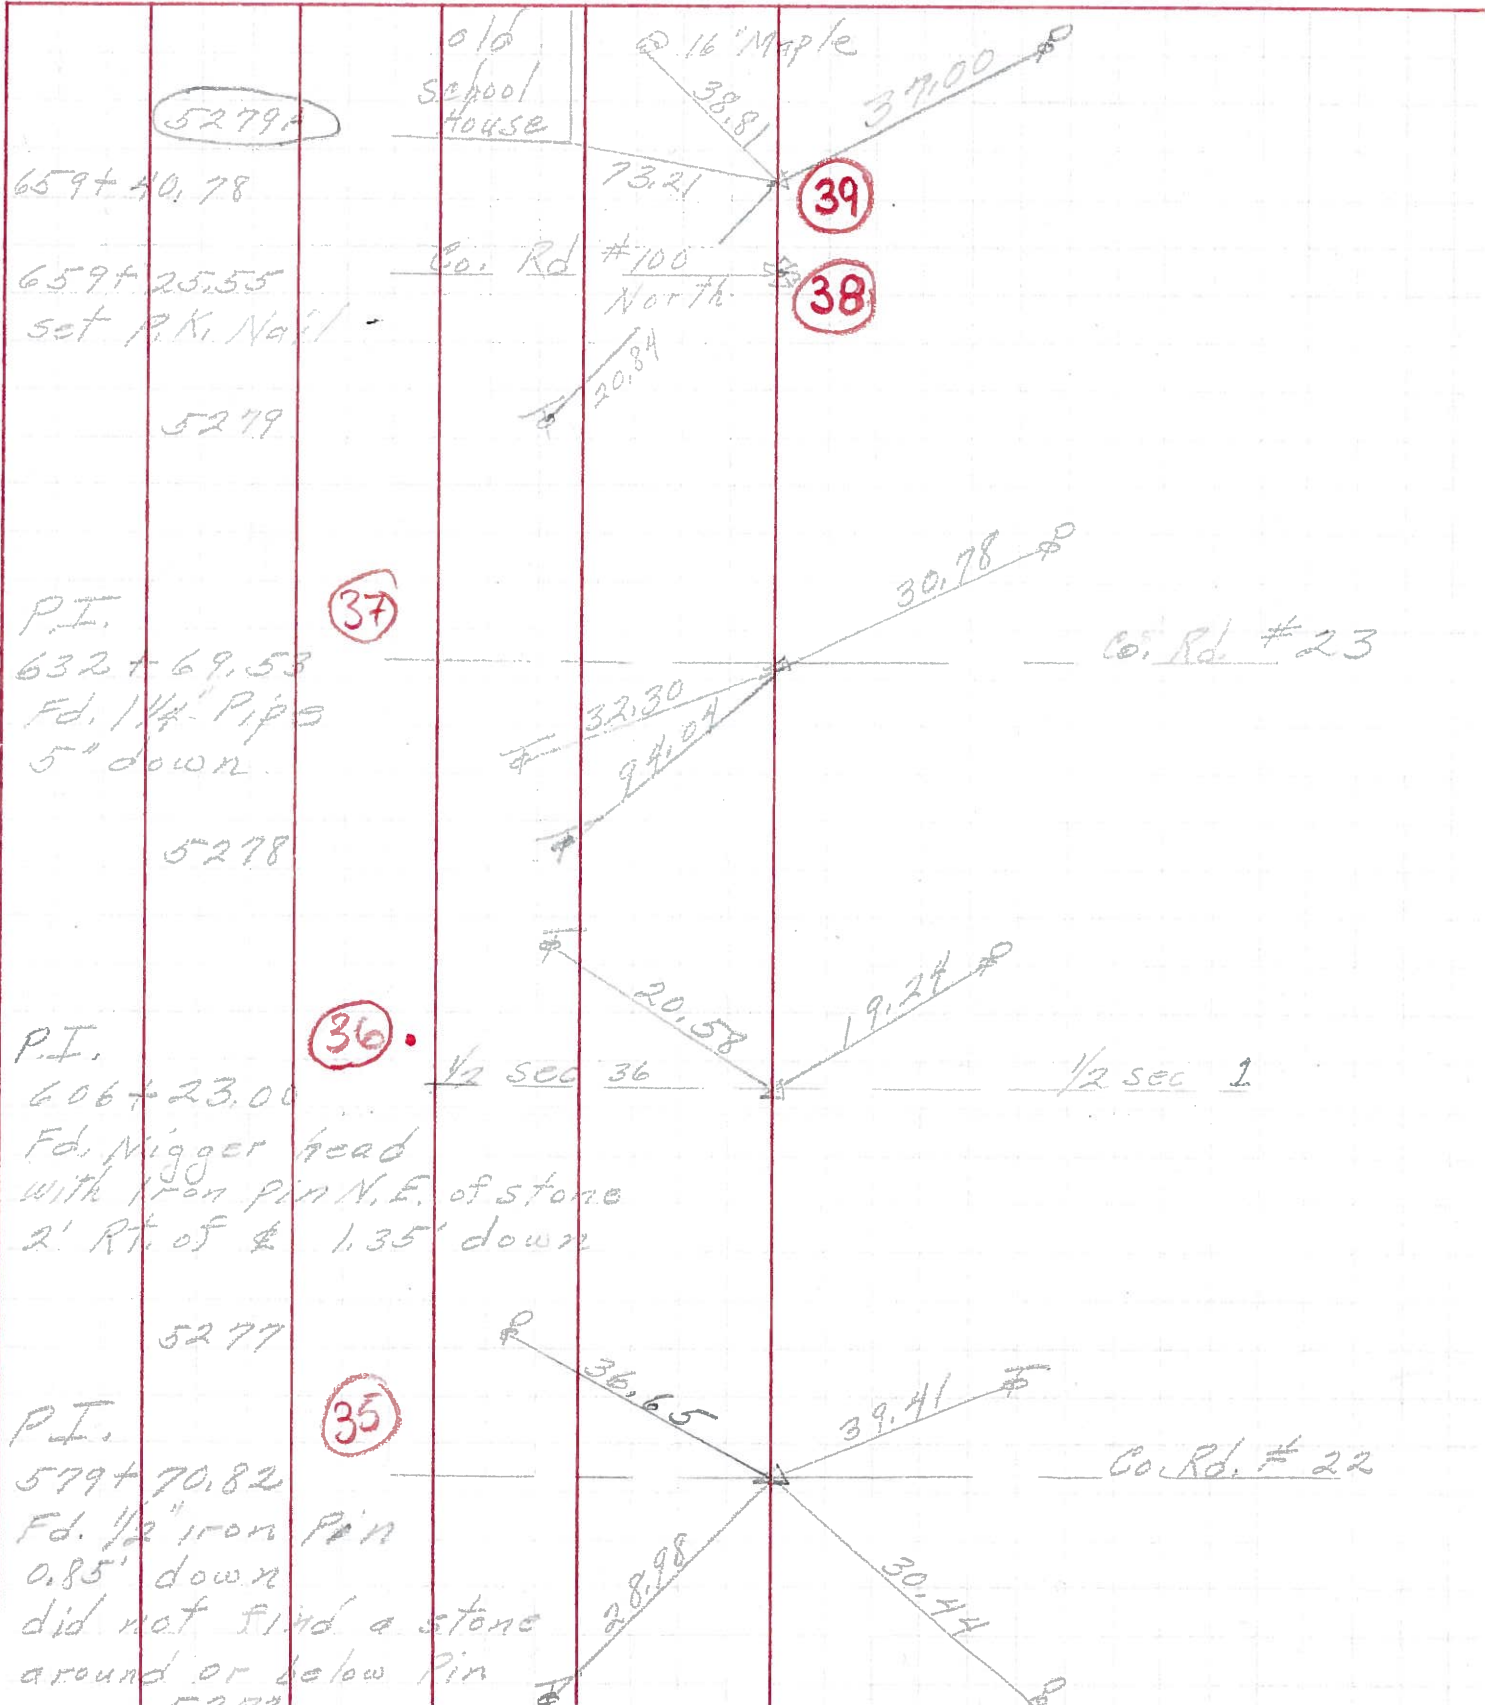

PERSONNEL TITLE PERSONNEL TITLE

COUNTY Ottawa DATE 3-3-66

S. R. 163 WEATHER Fair

SEC. 35-36 & 1-2 TEMP 60°

DESCRIPTION Benton & Harris Twp. JOB NO.

LEFT

CENTER LINE

RIGHT

P.T.

606+23.00

Fd. Nigger Head
with iron pin N.E.
of stone 2' pt.
of & 1.35' down

(36)

P.T.

579+70.82

Fd. 1/2" iron pin
0.85' down
did not find stone
ground or below pin

(35)

P.T.

553+33.17

P.K. Nail on
surface County
found stone

(24)

