

O.D.O.T. DISTRICT 2 SURVEY OFFICE (USE ONLY)

PERSONNEL

REFERENCE NO. 37

SHEET 6 OF 17

NOTES ASTON

DATE 5-13-24

ROUTE SR 163

H.C. NIESE

WEATHER WINDY

COUNTY OTTAWA

R.C. PRESTON-COLVIN

TEMP. 75°

TOWNSHIP HARRIS

MILLER & BLUBAUGH

SECTION 1

DWG BY ASTON

PID 101239

T 6 N R 14 E

TYPE MONUMENT MAG/WASHER

ON SURFACE - ~~BELOW~~ ON

OFFSET Q PAVEMENT ON LT : RT

12.0' TO LT EDGE PAVEMENT


STATION: 633+70

HORZ.DATUM: NAD83(2011)


GEOID: 18

GRID: NORTHING: 674683.417

EASTING: 1781278.489

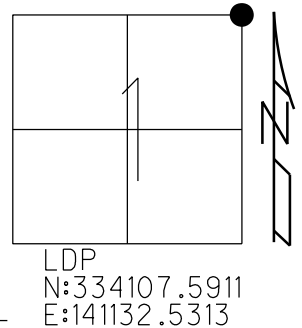

RECORD: P.I.
STA 632+69.53
FD P.K./WASHER
6/17/93, CHENEY
FD 1 1/2" IPIPE
5" DOWN
SET P.K. NAIL
8/13/76
SET P.K. NAIL
IN CONCRETE
9/27/93, RCC
D.N.F.
5/15/00
FD 1 1/2" IPIPE
1' DOWN
REF37
6-30-24, TDN
SET MAG/W
5-13-24, TDN

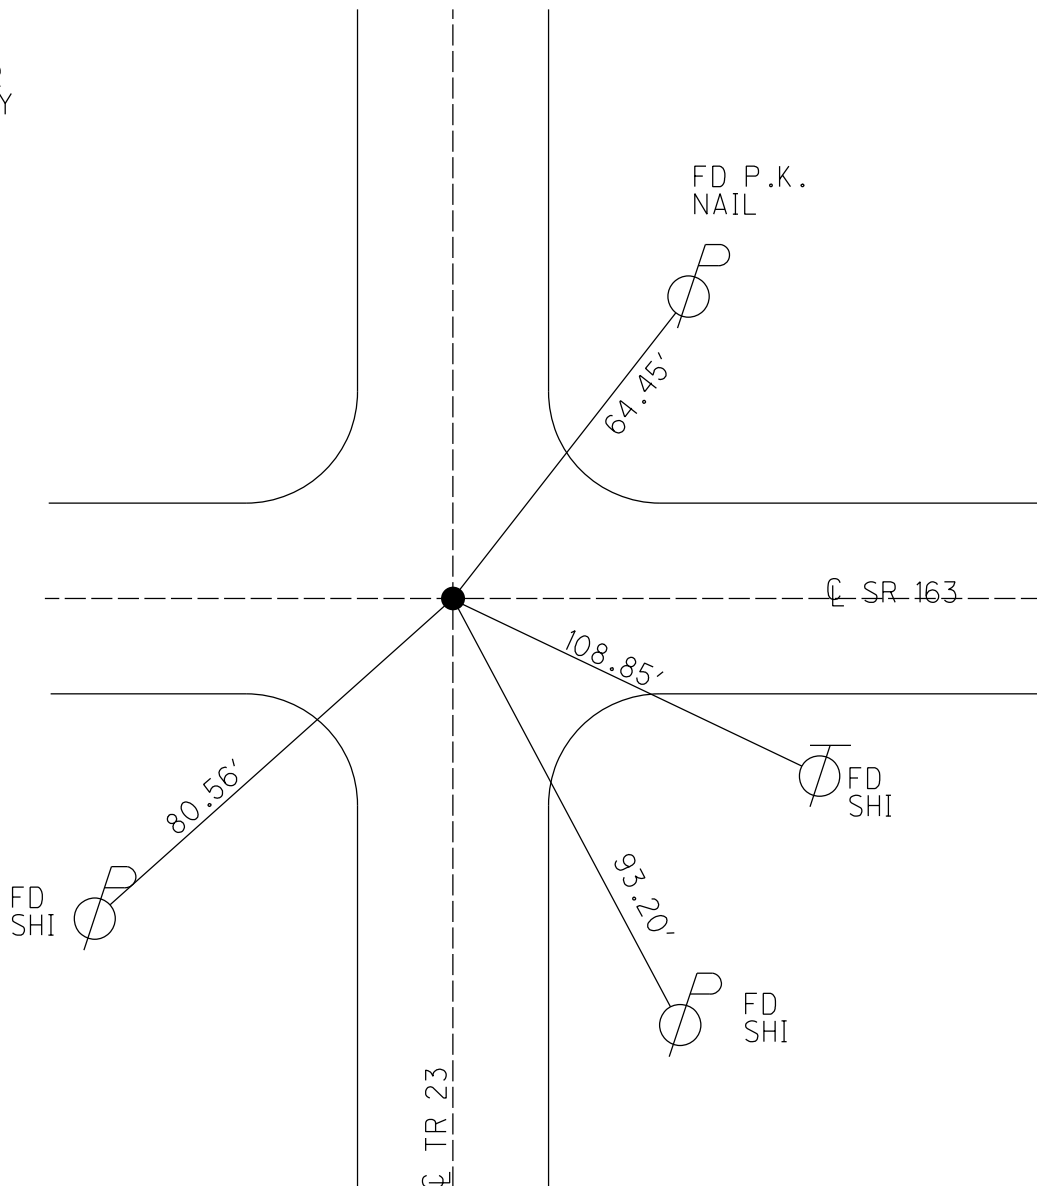

O.D.O.T. DISTRICT 2 SURVEY OFFICE (USE ONLY)

PERSONNEL

REFERENCE NO. 37

SHEET 6 OF 17

NOTES CHENEY

DATE 6/17/93

ROUTE SR 163

H.C. RIPPLE

WEATHER FAIR

COUNTY OTTAWA

R.C. BARBOUR

TEMP. 80°

TOWNSHIP HARRIS

SECTION 1

DWG BY NIESE PID

T 6 N R 14 E

TYPE MONUMENT P.K./WASHER

ON SURFACE - ~~BELOW~~ 3"

OFFSET Q PAVEMENT ON LT : RT

12.0' TO LT EDGE PAVEMENT


STATION: 633+70

HORZ.DATUM:


GEOID:

GRID: NORTHING:

EASTING:

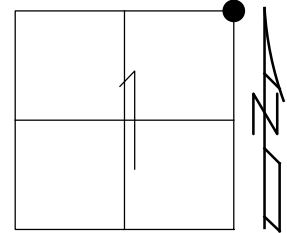

RECORD: P.I.
STA 632+69.53
FD P.K./WASHER
6/17/93, CHENEY
FD 1 1/2" IPIPE
5" DOWN
SET P.K. NAIL
8/13/76
SET P.K. NAIL
IN CONCRETE
9/27/93, RCC
D.N.F.
5/15/00

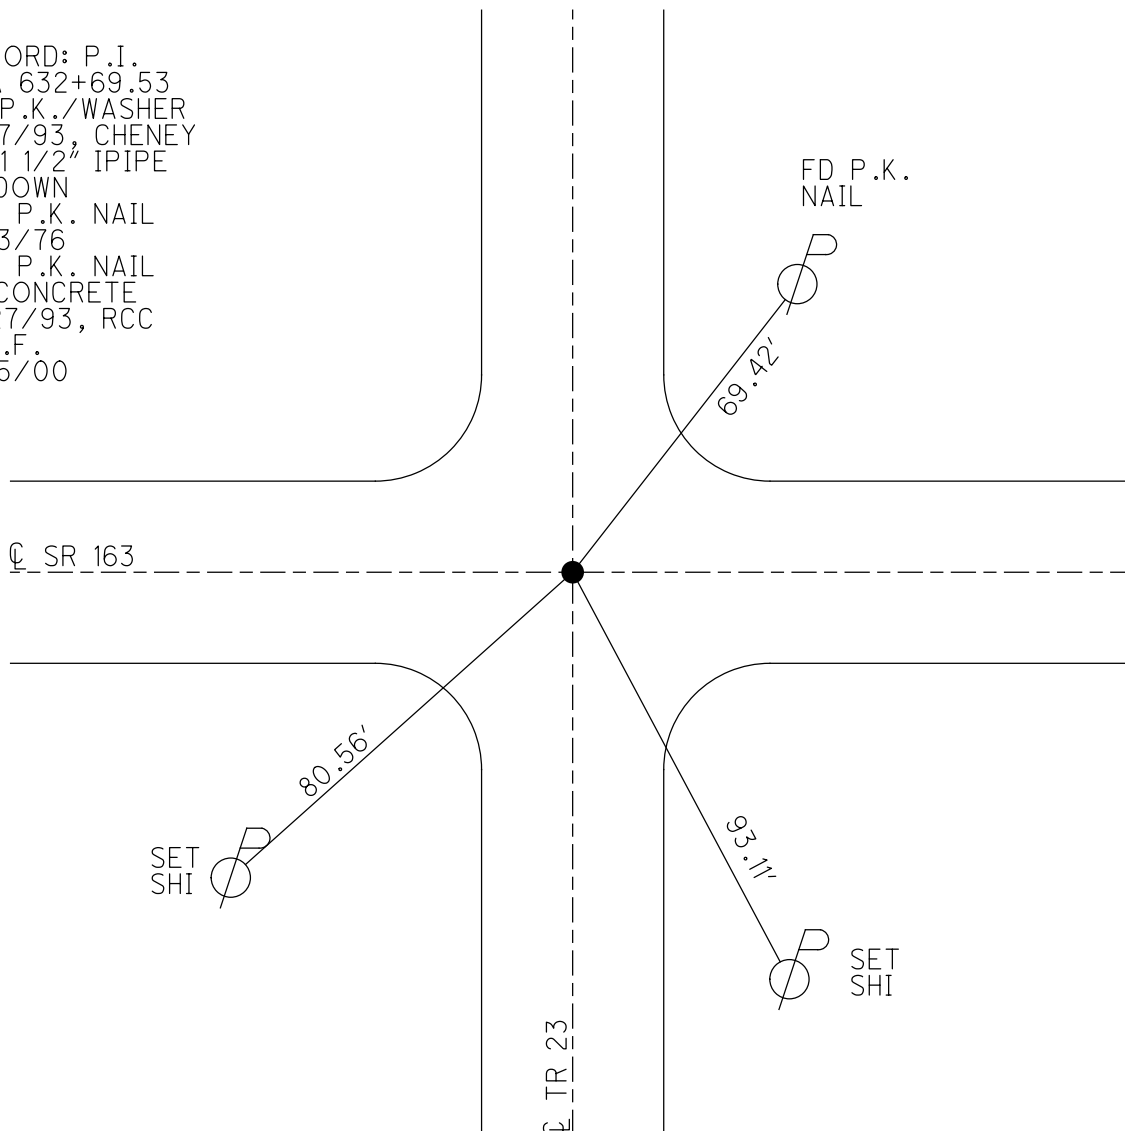

O.D.O.T. DISTRICT 2 SURVEY OFFICE

PERSONNEL

REFERENCE NO. 37

SHEET 18 OF 24

NOTES CHENEY

H.C. RIPPLE

R.C. BARBOUR

DATE 6-17-1993

WEATHER FAIR

TEMP. 80°

ROUTE #163

COUNTY OTTAWA

TOWNSHIP

SECTION

T. R.

TYPE MONUMENT PK/WASHER

~~ON~~ SURFACE - BELOW 3"

~~LEFT~~ - C. PAV'T. - RIGHT ON

12' TO LT. EDGE PAVEMENT

S.L.M. 633470

BENTON 36	SALEM 31
HARRIS 1	SALEM 6



RECORD: 8-13-1976


P.I. STA. 632+69.53

FO. 1 1/2" PIPE 5" DOWN

RESET P.K. NAIL

5-15-00
DID NOT FIND

SET P.K. NAIL IN CONC.
9-27-1993
RCC

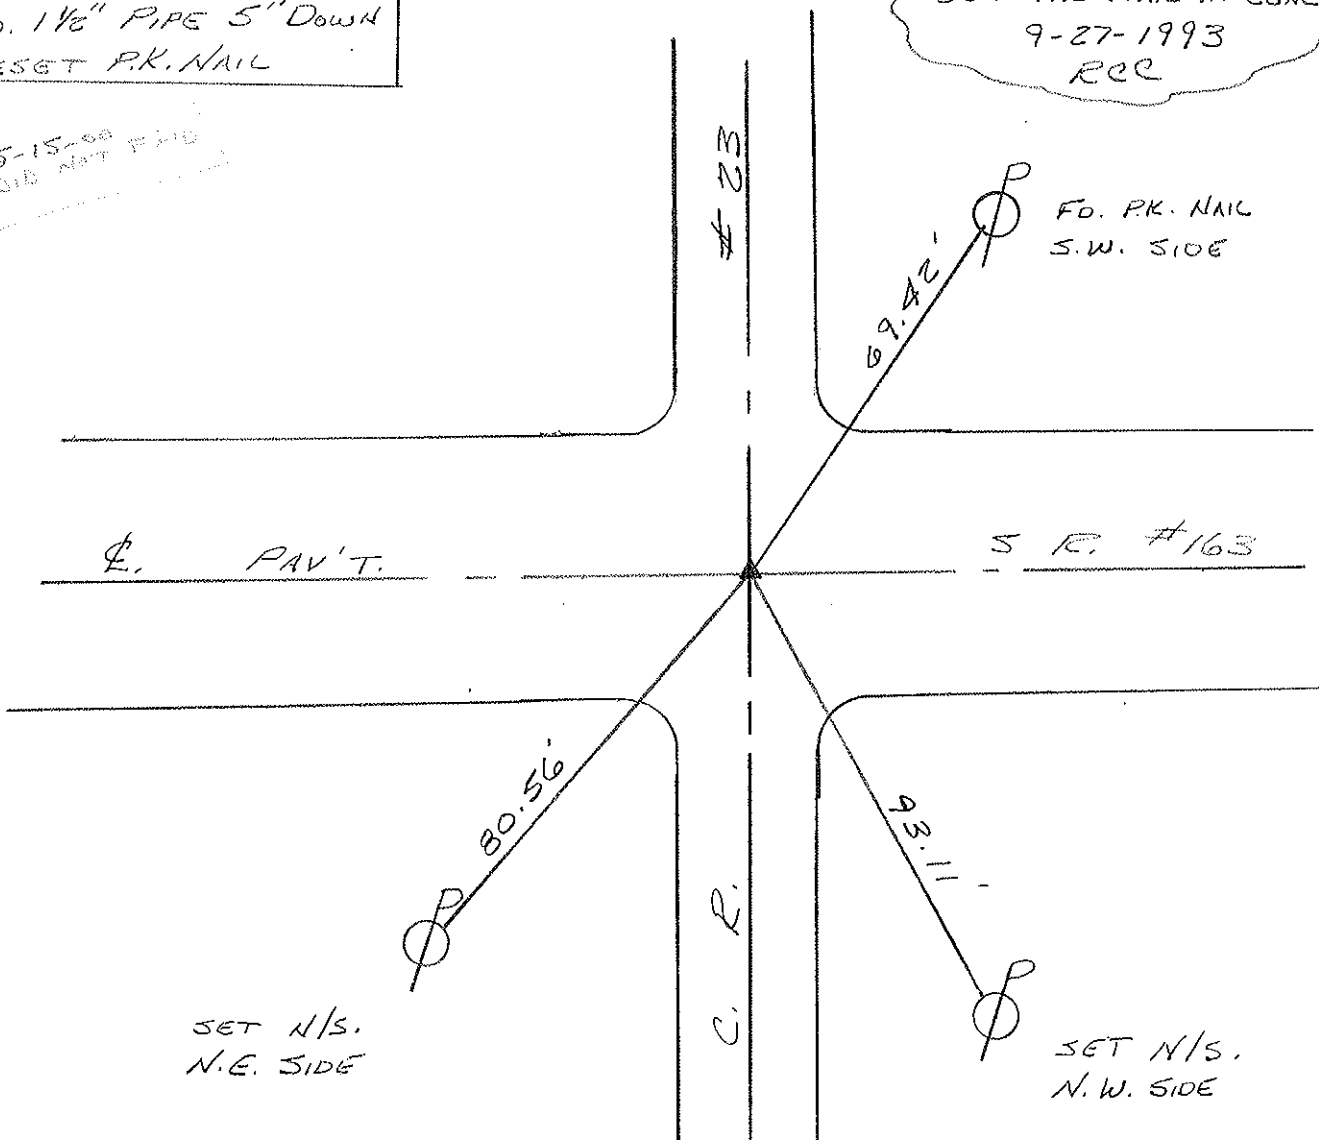

PERSONNEL TITLE PERSONNEL TITLE

COUNTY Ottawa DATE 8-13-76S. R. 163 WEATHER FairSEC. 36-31 1/2 1-6 TEMP. 80°DESCRIPTION Benton, Harris, Salem Townships JOB NO.

LEFT

CENTER LINE

RIGHT

P.I. 40

672+13.07

Ed. P.K. Nail on surface

Reset P.K. Nail

P.I. 37

659+40.73

P.K. Nail

Reset P.K. Nails

659+25.55

Set P.K. Nail

38

Go set R.R. spk.

24" Maple
old school
House
Top 2nd block
29.21'
20.84'
24.90'
Twp. Rd. #100
North

Reset small spk.
Sec. line
south

P.I.

632+69.53

Ed. 1 1/2" Pipe

5" down

Reset P.K. Nail

Carroll Twp.

Benton
Twp.

Salem Twp.

Gen. Rd. #23

Harris Twp.

37

PERSONNEL TITLE PERSONNEL TITLE

COUNTY Ottawa DATE 3-3-66S. R. 163 WEATHERSEC. 36-31 & 1-6 TEMP.DESCRIPTION Benton, Harris, Salem & Carroll Twp. JOB NO.

LEFT

CENTER LINE

RIGHT

P.I.
Fd. P.K. Nail
on surface

(40)

old
School
House

16" Maple

P.I.
659+40.78
P.K. Nail

(39)

659+25.55 Co. Rd. # 100
set P.K. Nail

(38)

← Z →

P.I.
632+69.53
Fd. 1 1/2" pipe
5" down
Twp. Cor.

(37)


Carroll Twp.

Salem Twp.

Co. Rd. # 23

Harris Twp.

Benton Twp.

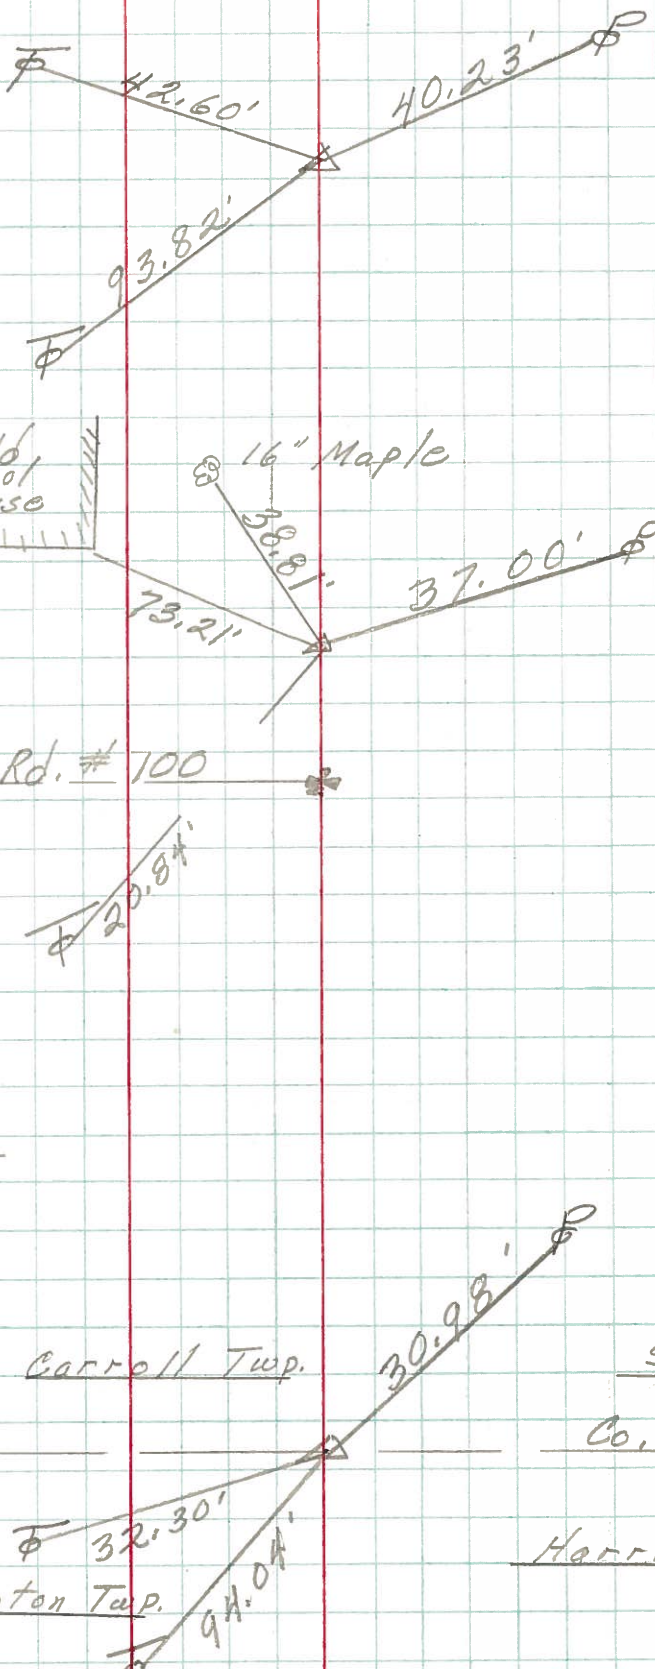

PERSONNEL TITLE PERSONNEL TITLE

COUNTY OttawaDATE 3-3-66S. R. 163

WEATHER

SEC. 9, 98TEMP. 60°

DESCRIPTION

Control Points

JOB NO.

LEFT

CENTER LINE

RIGHT

