

O.D.O.T. DISTRICT 2 SURVEY OFFICE (USE ONLY)

PERSONNEL

REFERENCE NO. 37 A

SHEET 7 OF 17

NOTES ASTON

DATE 7-3-23

ROUTE SR 163

H.C. NIESE

WEATHER FAIR

COUNTY OTTAWA

R.C. AUBLE

TEMP. 70°

TOWNSHIP SALEM

SECTION 6

DWG BY ASTON

PID 101239

T 6 N R 15 E

TYPE MONUMENT R.R. SPIKE

ON SURFACE - ~~BELOW~~ ON

OFFSET Q PAVEMENT LT : RT

 TO EDGE PAVEMENT


STATION: 659+13 ±

HORIZ.DATUM:


GEOID:

GRID: NORTHING:

EASTING:

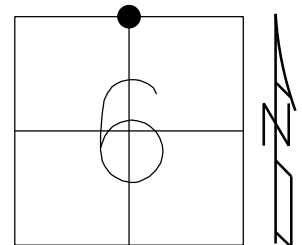

RECORD:
COUNTY SET R.R. SPIKE
ON SEC. LINE SOUTH
SET SM.R.R. SPIKE
8/13/76
D.N.F. -1993
D.N.F.
7-3-23, TDN

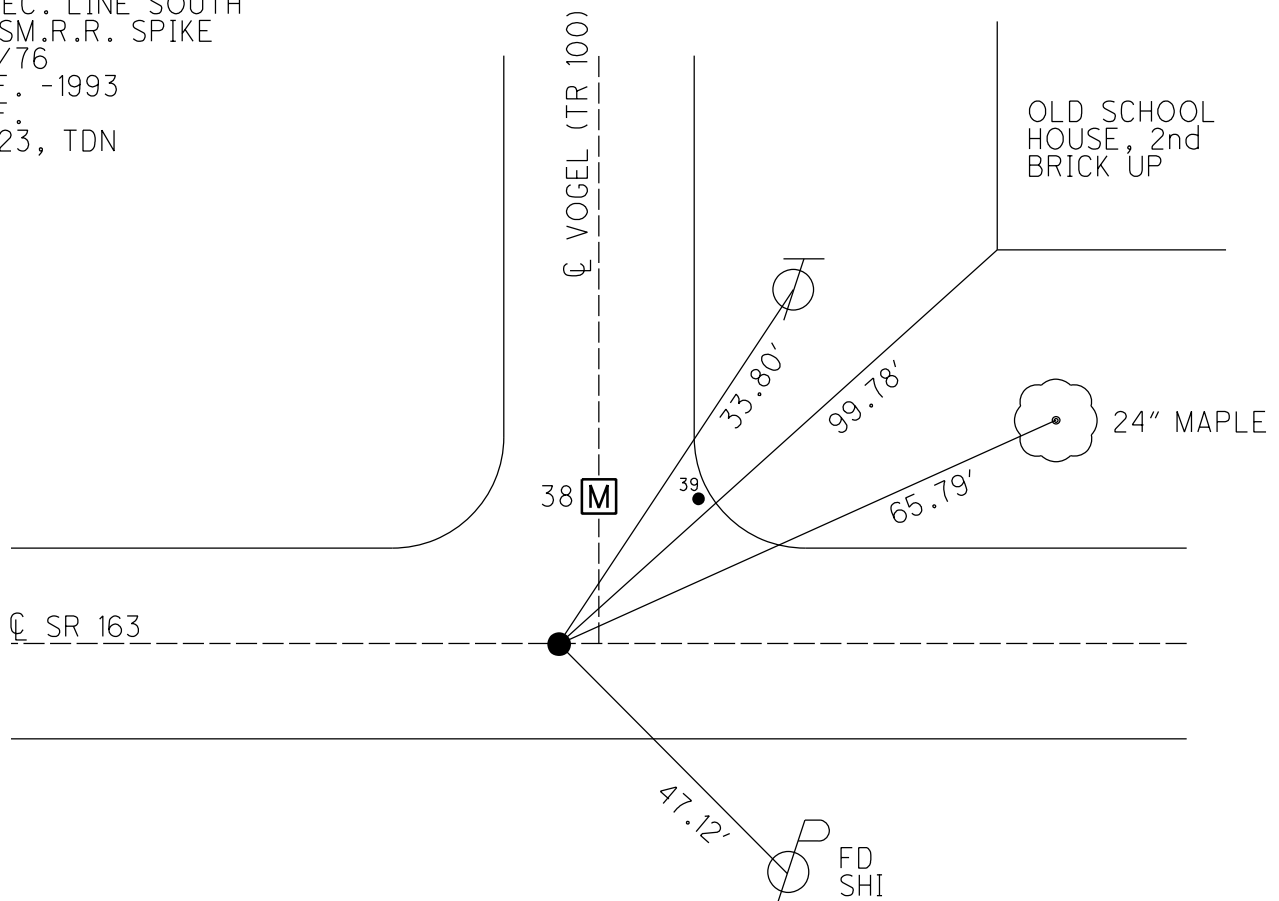

O.D.O.T. DISTRICT 2 SURVEY OFFICE (USE ONLY)

PERSONNEL

REFERENCE NO. 37 A

SHEET 7 OF 17

NOTES CHENEY DATE 8/13/76
H.C. RIPPLE WEATHER FAIR
R.C. BARBOUR TEMP. 80°

ROUTE SR 163
COUNTY OTTAWA
TOWNSHIP SALEM
SECTION 6
T 6 N R 15 E

DWG BY NIESE PID _____

TYPE MONUMENT R.R. SPIKE

ON SURFACE - ~~BELOW~~ ON


OFFSET $\varnothing$ PAVEMENT _____ LT : RT

_____ TO _____ EDGE PAVEMENT


STATION: 659+13 ±

HORIZ.DATUM: _____ GEOID: _____

GRID: NORTHING: _____ EASTING: _____

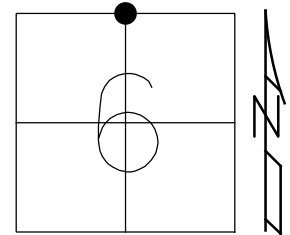

RECORD:
COUNTY SET R.R. SPIKE
ON SEC. LINE SOUTH
SET SM.R.R. SPIKE
8/13/76
D.N.F.
1993

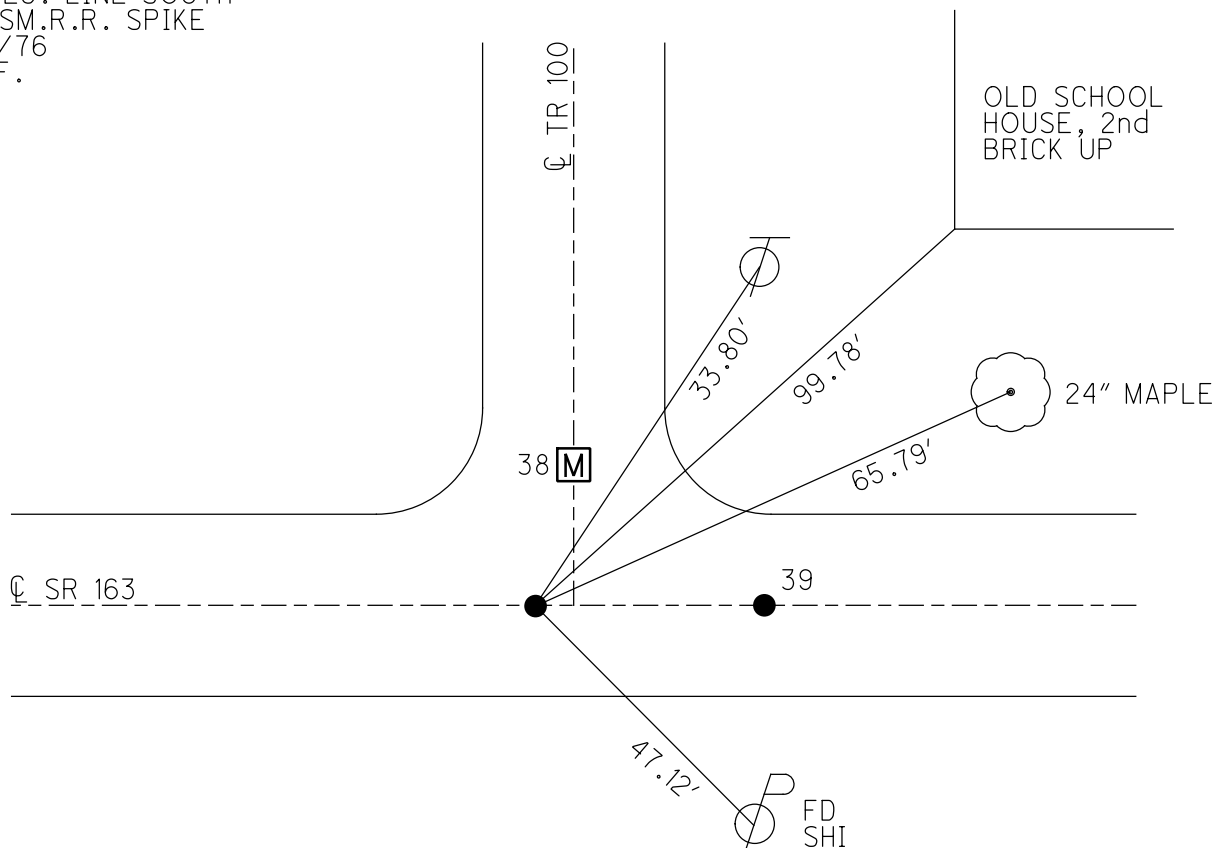

PERSONNEL TITLE PERSONNEL TITLE

COUNTY Ottawa DATE 8-13-76S. R. 163 WEATHER FairSEC. 36-31 1/2 1-6 TEMP. 80°DESCRIPTION Benton, Harris, Salem Townships JOB NO.

LEFT

CENTER LINE

RIGHT

P.I. 40

672+13.07

Ed. P.K. Nail on surface

Reset P.K. Nail

P.I. 37

659+40.73

P.K. Nail

Reset P.K. Nails

659+25.55

Set P.K. Nail

old school
House

Top 2nd block

20.84'

24" Maple

23.21'

24.90'

Twp. Rd. #100

North

38

Go set R.R. spk.

Reset small spk.
See line
south

P.I.

632+69.53

Ed. 1 1/2" Pipe

5" down

Reset P.K. Nail

Carroll Twp.

Benton
Twp.

Salem Twp.

Harris Twp.

37