


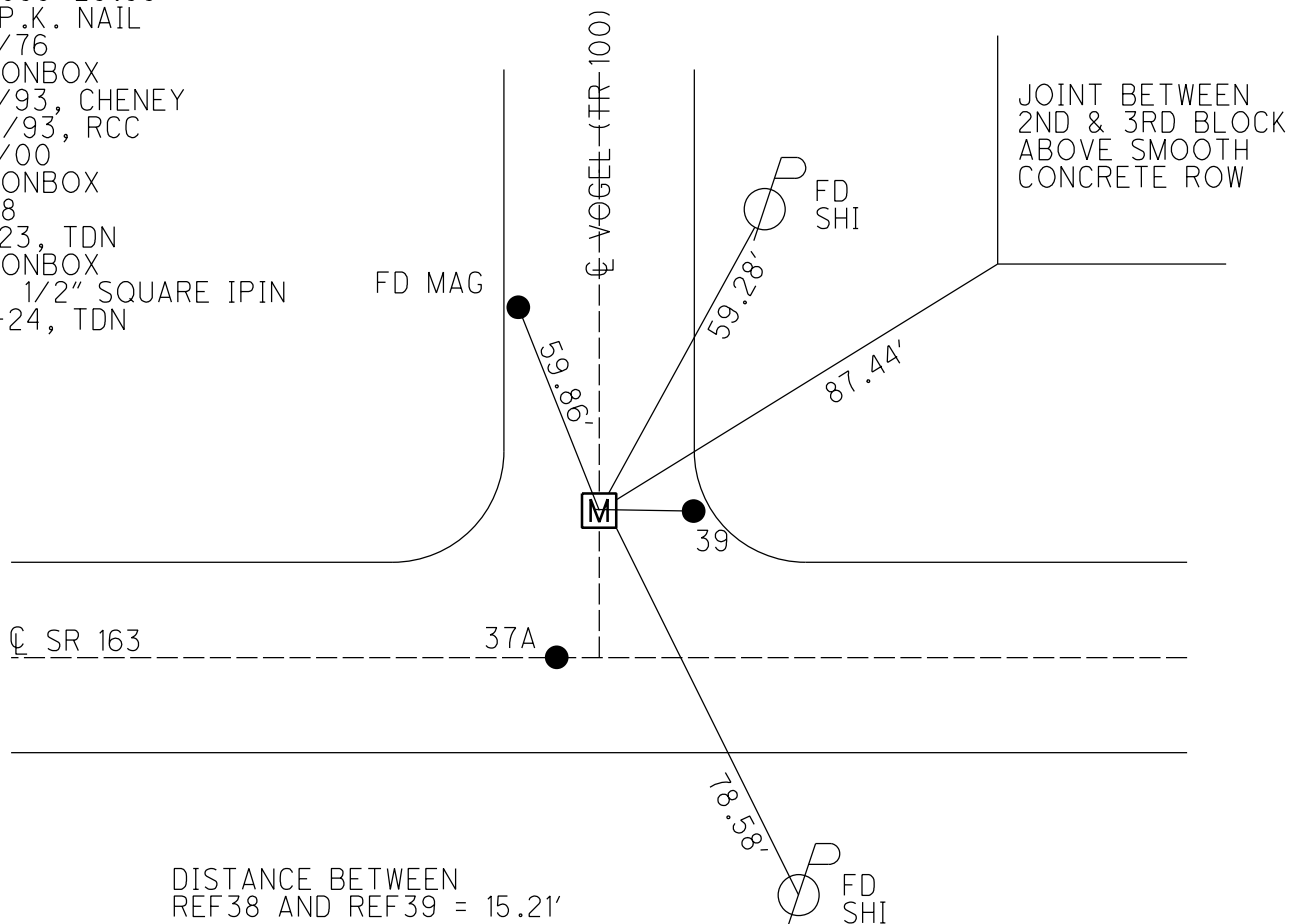

O.D.O.T. DISTRICT 2 SURVEY OFFICE (USE ONLY)

PERSONNEL

REFERENCE NO. 38

SHEET 8 OF 17

NOTES CHENEY

DATE 8/13/76

ROUTE SR 163

H.C. RIPPLE

WEATHER FAIR

COUNTY OTTAWA

R.C. BARBOUR

TEMP. 80°

TOWNSHIP SALEM

SECTION 6

DWG BY NIESE PID

T 6 N R 15 E

TYPE MONUMENT MONBOX

ON SURFACE - ~~BELOW~~ ON

OFFSET Q PAVEMENT 23.0' LT : ~~RT~~

11' RT TO RT EDGE PAVEMENT


STATION: 659+25.55

HORIZ.DATUM:

GEOID:

GRID: NORTHING:

EASTING:

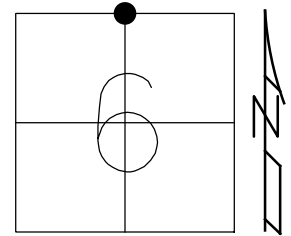

RECORD:

STA 659+25.55

SET P.K. NAIL


8/13/76

FD MONBOX

6/17/93, CHENEY

9/27/93, RCC

5/15/00

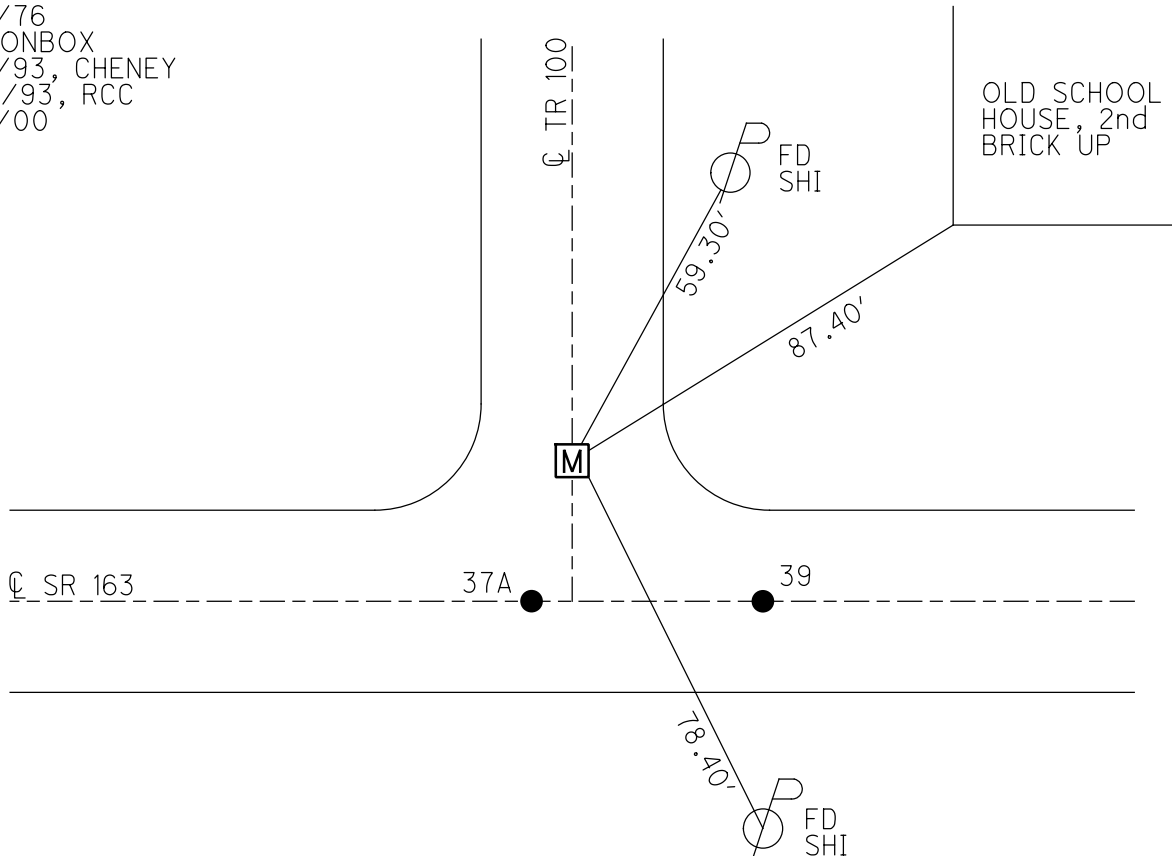

O.D.O.T. DISTRICT 2 SURVEY OFFICE

PERSONNEL

REFERENCE NO. 38-39 SHEET 19 OF 24

NOTES CHENEY

H.C. RIPPLE

R.C. BARBOUR

DATE 6-17-1993

WEATHER FAIR

TEMP. 80°

ROUTE #163

COUNTY OTAWA

TOWNSHIP SALEM

SECTION 6, 31

T 6 N R 15 E


TYPE MONUMENT MONUMENT BOX

ON SURFACE - BELOW ON

LEFT - 0 PAV'T. - RIGHT 23'

11' RT. TO RT. EDGE PAVEMENT

S.L.M. 660+40

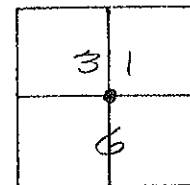

RECORD: 8-13-1976

P.I. STA. 659+40.78 (DID NOT FIND 1993)

RK. NAIL

RESET RK. NAILS

659+25.55 (MON. BOX 1993)

SET RK. NAIL

COUNTY SET RR. SPK.

ON SEC. LINE SOUTH

RESET SMALL SPK.

(DID NOT FIND 1993)

* NOTE: SEE SHEET No. 13
8-13-1976 REF.

Box 15 UP

9-27-1993

RCC

OLD SCHOOL
HOUSE

TOP OF
2ND BLOCK

Fd Mon. Box

T.R. #100

P Fd. N/S.
SW. SIDE

59.3'

87.4'

0. PAV'T.

S.R. #163

78.4'



Fd. N/S.
N. SIDE

Preventive Maintenance
Microsurfaced 2000
Existing Point Uncovered
Date 5-15-00

PERSONNEL TITLE PERSONNEL TITLE

COUNTY Ottawa DATE 8-13-76S. R. 163 WEATHER FairSEC. 36-31 1/2 1-6 TEMP. 80°DESCRIPTION Benton, Harris, Salem Townships JOB NO.

LEFT

CENTER LINE

RIGHT

P.I. 40

672+13.07

Ed. P.K. Nail on surface

Reset P.K. Nail

P.I. 37

659+40.73

P.K. Nail

Reset P.K. Nails

659+25.55

Set P.K. Nail

38

Go set R.R. spk.

24" Maple
old school
House
Top 2nd block
29.21'
20.84'
24.90'
Twp. Rd. #100
North

Reset small spk.
Sec. line
south

P.I.

632+69.53

Ed. 1 1/2" Pipe

5" down

Reset P.K. Nail

Carroll Twp.

Benton
Twp.

Salem Twp.

Gen. Rd. #23

Harris Twp.

37

PERSONNEL TITLE PERSONNEL TITLE

COUNTY Ottawa DATE 3-3-66S. R. 163 WEATHERSEC. 9.98 TEMP. 60°


DESCRIPTION

LEFT

CENTER LINE

RIGHT

JOB NO.

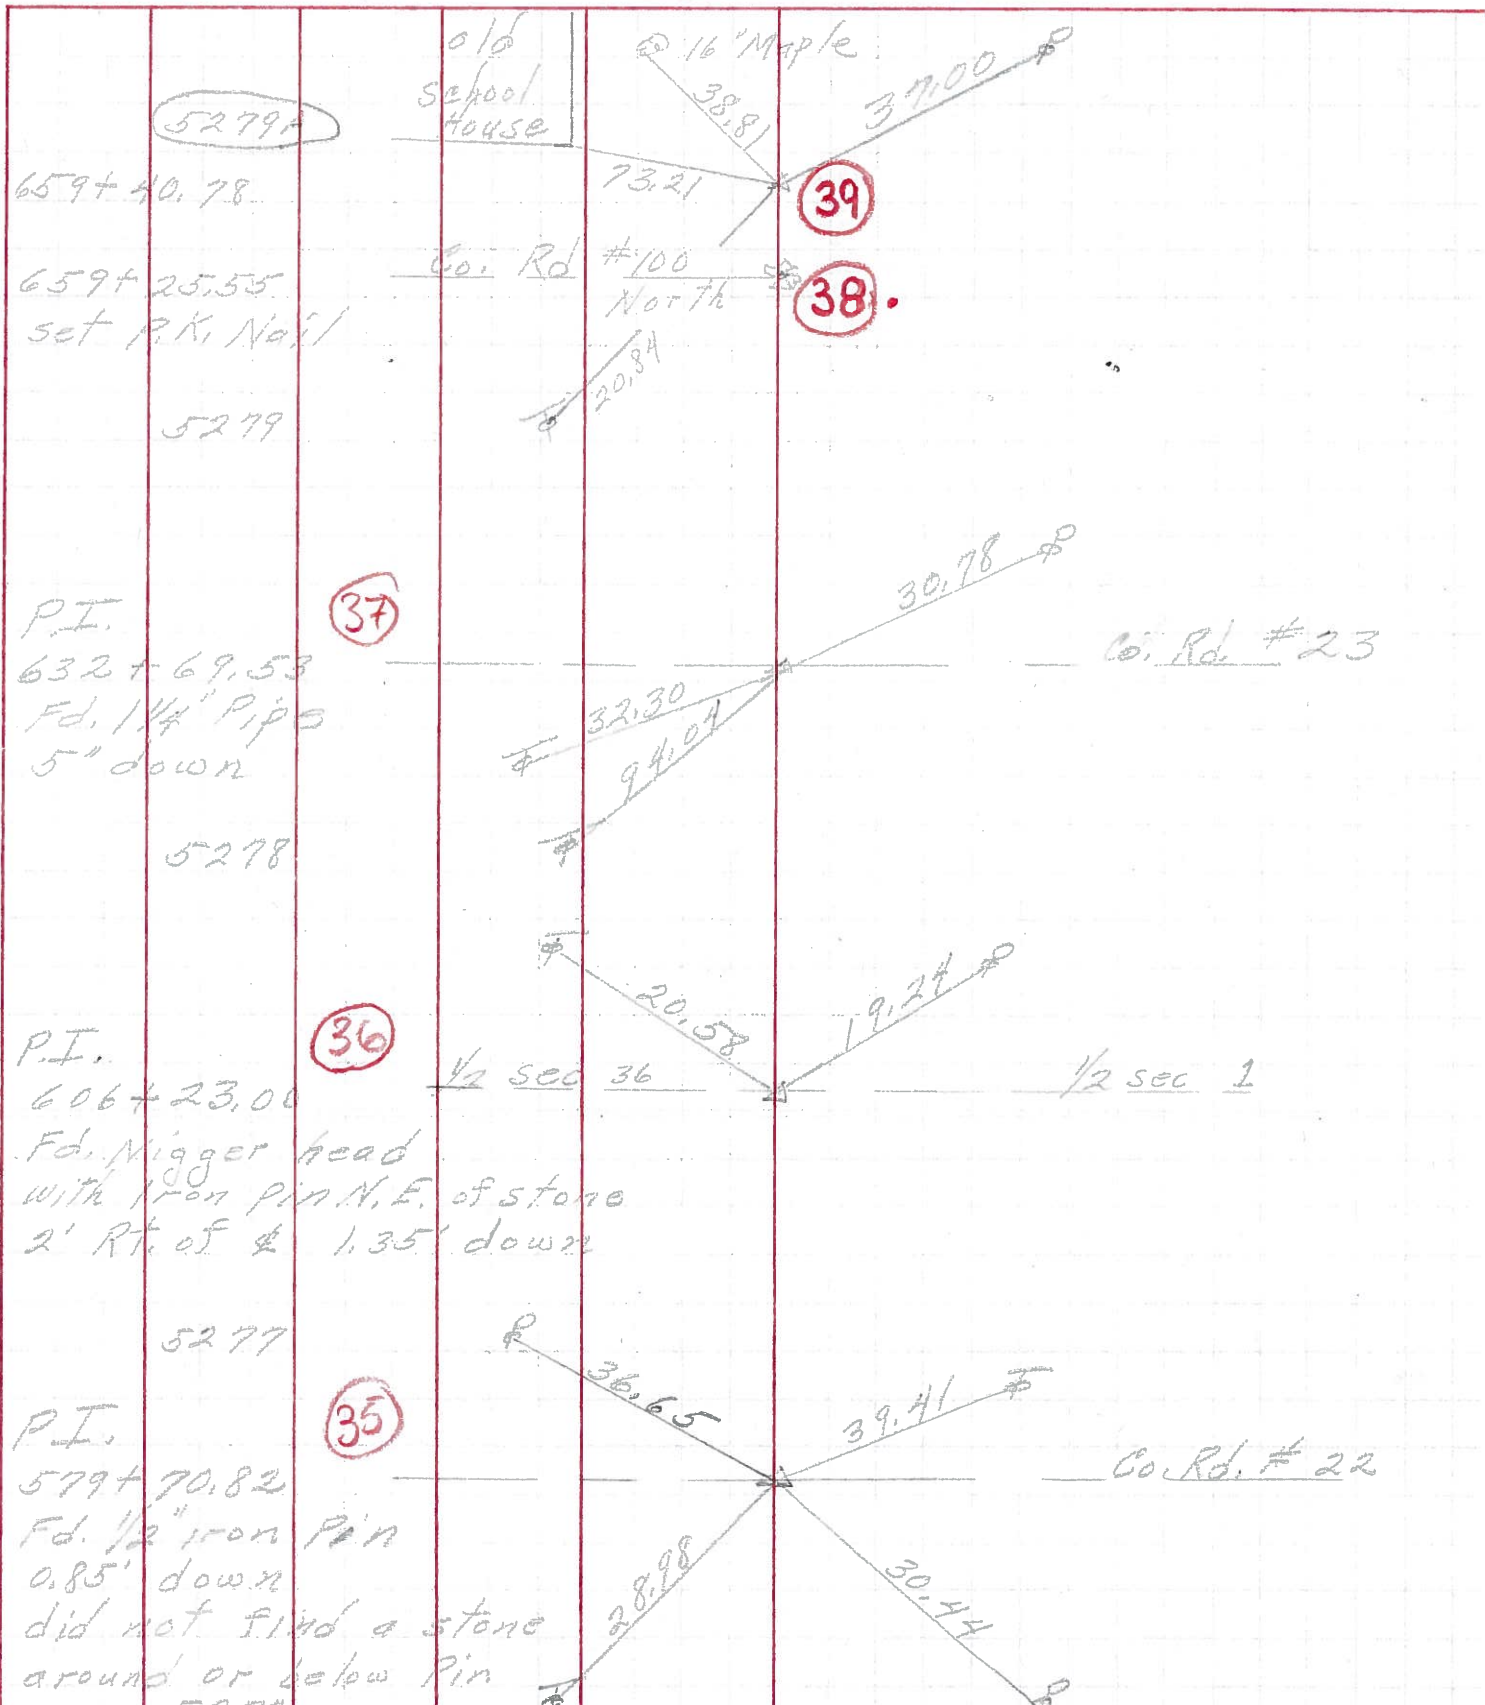

PERSONNEL TITLE PERSONNEL TITLE

COUNTY Ottawa DATE 3-3-66S. R. 163 WEATHERSEC. 36-31 & 1-6 TEMP.DESCRIPTION Benton, Harris, Salem & Carroll Twp. JOB NO.

LEFT

CENTER LINE

RIGHT

P.I.
Fd. P.K. Nail
on surface

(40)

o/d
School
House

16" Maple

P.I.
659+40.78
P.K. Nail

(39)

659+25.55
set P.K. Nail

Co. Rd. # 100

(38)

→ Z

P.I.
632+69.53
Fd. 1 1/2" pipe
5" down
Twp. Cor.

(37)

Carroll Twp.

Salem Twp.

Co. Rd. # 23

Harris Twp.

Benton Twp.

32.30'

94.04'

30.98'

42.60'

40.23'

93.82'

73.21'

58.81'

37.00'

23.84'