

O.D.O.T. DISTRICT 2 SURVEY OFFICE (USE ONLY)

PERSONNEL

REFERENCE NO. 40

SHEET 10 OF 17

NOTES ASTON

DATE 5/13/24

ROUTE SR 163

H.C. NIESE

WEATHER WINDY

COUNTY OTTAWA

R.C. PRESTON-COLVIN

TEMP. 75°

TOWNSHIP SALEM

MILLER & BLUBAUGH

SECTION 6

DWG BY ASTON PID 101239

T 6 N R 15 E

TYPE MONUMENT MAG/WASHER

ON SURFACE - ~~BELOW~~ ON

OFFSET CL PAVEMENT 3.9' ~~LT~~ : RT

TO EDGE PAVEMENT


STATION: 672+13.09

HORIZ.DATUM: NAD83(2011)


GEOID: 18

GRID: NORTHING: 674207.943

EASTING: 1785141.106

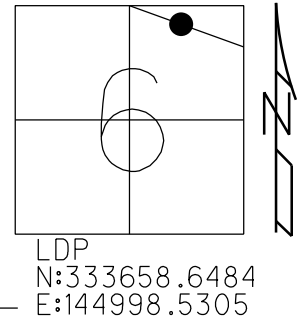

RECORD: P.I.
STA 672+13.09
FD P.K. NAIL
RESET P.K. NAIL
8/13/76
D.N.F.
6/18/95, RIPPLE
FD PK SHANK
7-3-23, TDN
REF40
SET MAG/WASHER
5-13-24, TDN

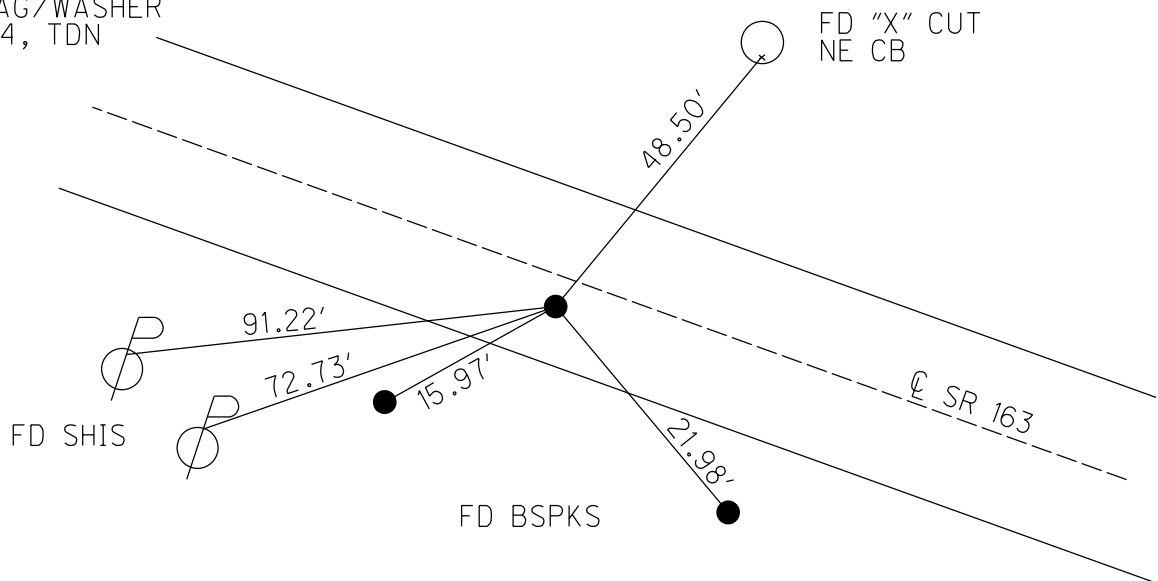

O.D.O.T. DISTRICT 2 SURVEY OFFICE (USE ONLY)

PERSONNEL

REFERENCE NO. 40

SHEET 10 OF 17

NOTES CHENEY

DATE 8/13/76

ROUTE SR 163

H.C. RIPPLE

WEATHER FAIR

COUNTY OTTAWA

R.C. BARBOUR

TEMP. 80°

TOWNSHIP SALEM

SECTION 6

DWG BY NIESE PID

T 6 N R 15 E

TYPE MONUMENT P.K. NAIL

ON SURFACE - ~~BELOW~~ ON


OFFSET Q PAVEMENT ON LT : RT

 TO EDGE PAVEMENT


STATION: 672+13.09

HORZ.DATUM: GEOID:

GRID: NORTHING: EASTING:

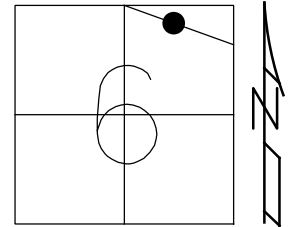

RECORD: P.I.
STA 672+13.09
FD P.K. NAIL
RESET P.K. NAIL
8/13/76
D.N.F.
6/18/95, RIPPLE

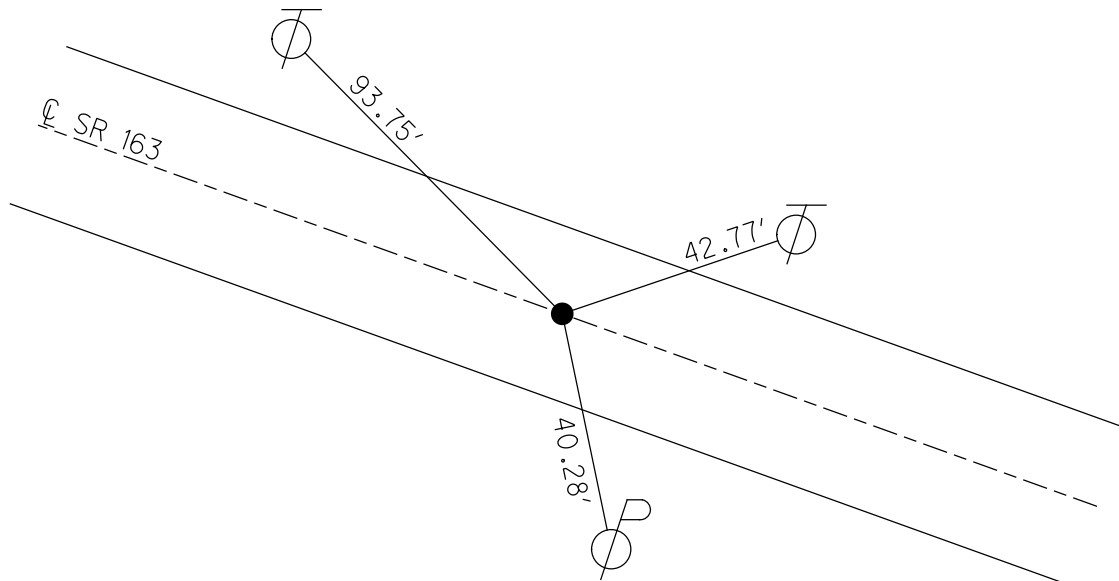

PERSONNEL TITLE PERSONNEL TITLE

COUNTY Ottawa DATE 8-13-76S. R. 163 WEATHER FairSEC. 36-31 1/2 1-6 TEMP. 80°DESCRIPTION Benton, Harris, Salem Townships JOB NO.

LEFT

CENTER LINE

RIGHT

P.I. 40

672+13.07

Ed. P.K. Nail on surface

Reset P.K. Nail

P.I. 37

659+40.73

P.K. Nail

Reset P.K. Nails

659+25.55

Set P.K. Nail

old school
House

Top 2nd grade

20.84'

24" Maple

23.21'

24.90'

Twp. Rd. #100

North

38

Go set R.R. spk.

Reset small spk.
See line
south

P.I.

632+69.53

Ed. 1 1/2" Pipe

5" down

Reset P.K. Nail

Carroll Twp.

Benton
Twp.

Salem Twp.

Harris Twp.

37

PERSONNEL TITLE PERSONNEL TITLE

COUNTY CHOWA DATE 8-16-76S. R. 163 WEATHER FairSEC. 5 TEMP. 15°DESCRIPTION Salem Twp. JOB NO.

LEFT

CENTER LINE

RIGHT

FD. R.R. S.P.K. (P)
Reset R.R. Nail

P.T. 43

7017 81.50

Iron Pin

10' Lb. of edge Permit.

Broke 3/16"

T.S.

6964

1' Lb. of 2

Reset R.R. Nail

P.T. 42

6944 64.56

FD. P.K. Nail

Reset R.R. Nail

P.T. # 41

6974 52.12

FD. P.K. Nail on Top

Reset R.R. Nails

31.42

54.88

101.15

101.15

N.W. cor. of
Red House
Bottom of Top Block

54.67 New

Co. Rd. #92

51.39

54.70

54.33

54.33

87.68

31.83

31.83

Co. Rd. #92
South

PERSONNEL	TITLE	PERSONNEL	TITLE

COUNTY Ottawa DATE 11-19-73

S. R. 16-3 WEATHER cloudy

SEC. 5 TEMP. 37°

DESCRIPTION Salem Twp. JOB NO. _____

