

O.D.O.T. DISTRICT 2 SURVEY OFFICE (USE ONLY)

PERSONNEL

REFERENCE NO. 40 A

SHEET 11 OF 17

NOTES ASTON

DATE 5-13-24

ROUTE SR 163

H.C. NIESE

WEATHER WINDY

COUNTY OTTAWA

R.C. PRESTON-COLVIN
MILLER & BLUBAUGH

TEMP. 75°

TOWNSHIP SALEM

DWG BY ASTON

PID 101239

SECTION 6

T 6 N R 15 E

TYPE MONUMENT MAG/WASHER

ON SURFACE - BELOW ON

OFFSET $\varnothing$ PAVEMENT 5' LT : RT

TO EDGE PAVEMENT


STATION: 687+27.41

HORZ.DATUM: NAD83(2011)

GEOID: 18


GRID: NORTHING: 673677.581

EASTING: 1786559.375

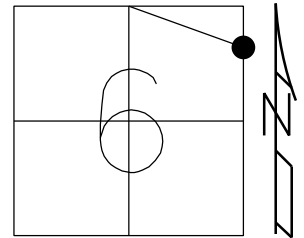

LDP
N:333138.0183
E:146420.4876

RECORD:
FD P.K. NAIL
1970 PLANS
SET P.K. NAIL
8/16/76
FD MAG
REF40A
7-3-23, TDN
SET MAG/WASHER
5-13-24, TDN

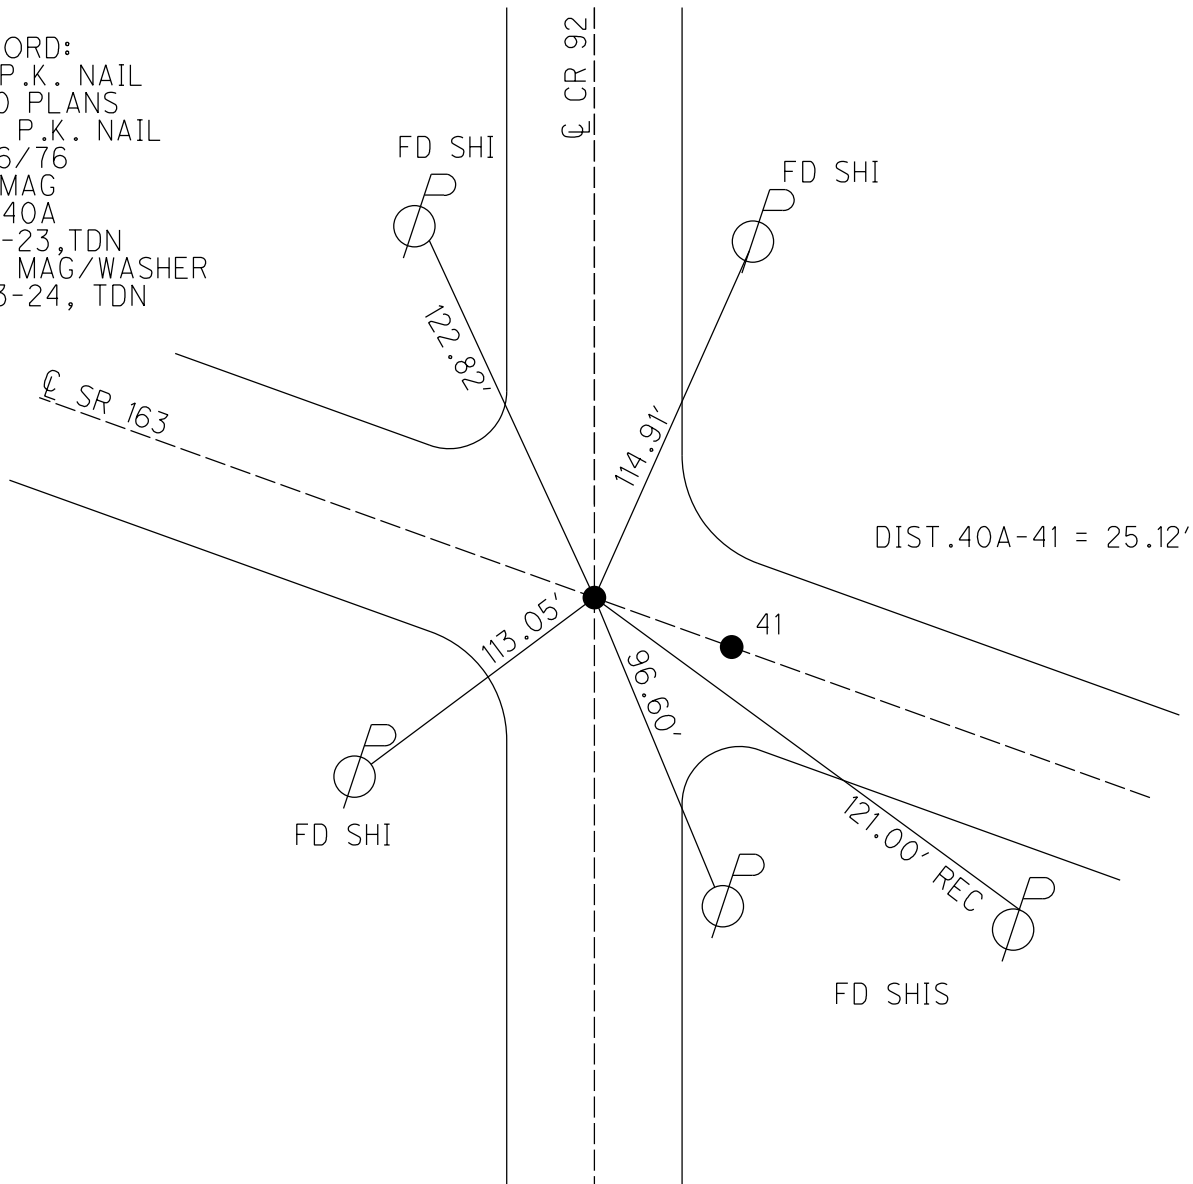

O.D.O.T. DISTRICT 2 SURVEY OFFICE (USE ONLY)

PERSONNEL

REFERENCE NO. 40 A

SHEET 11 OF 17

NOTES CHENEY DATE 8/16/76

H.C. RIPPLE WEATHER FAIR

R.C. BARBOUR TEMP. 75°

ROUTE SR 163

COUNTY OTTAWA

TOWNSHIP SALEMSECTION 6

DWG BY NIESE PID

TYPE MONUMENT P.K. NAIL

ON SURFACE - ~~BELOW~~ ON


OFFSET @ PAVEMENT _____ LT : RT

_____TO_____EDGE PAVEMENT


STATION: 687+27.41

HORZ.DATUM: _____ GEOID: _____

GRID: NORTHING: _____ EASTING: _____

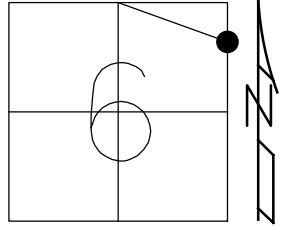

RECORD:
FD P.K. NAIL
1970 PLANS
SET P.K. NAIL
8/16/76

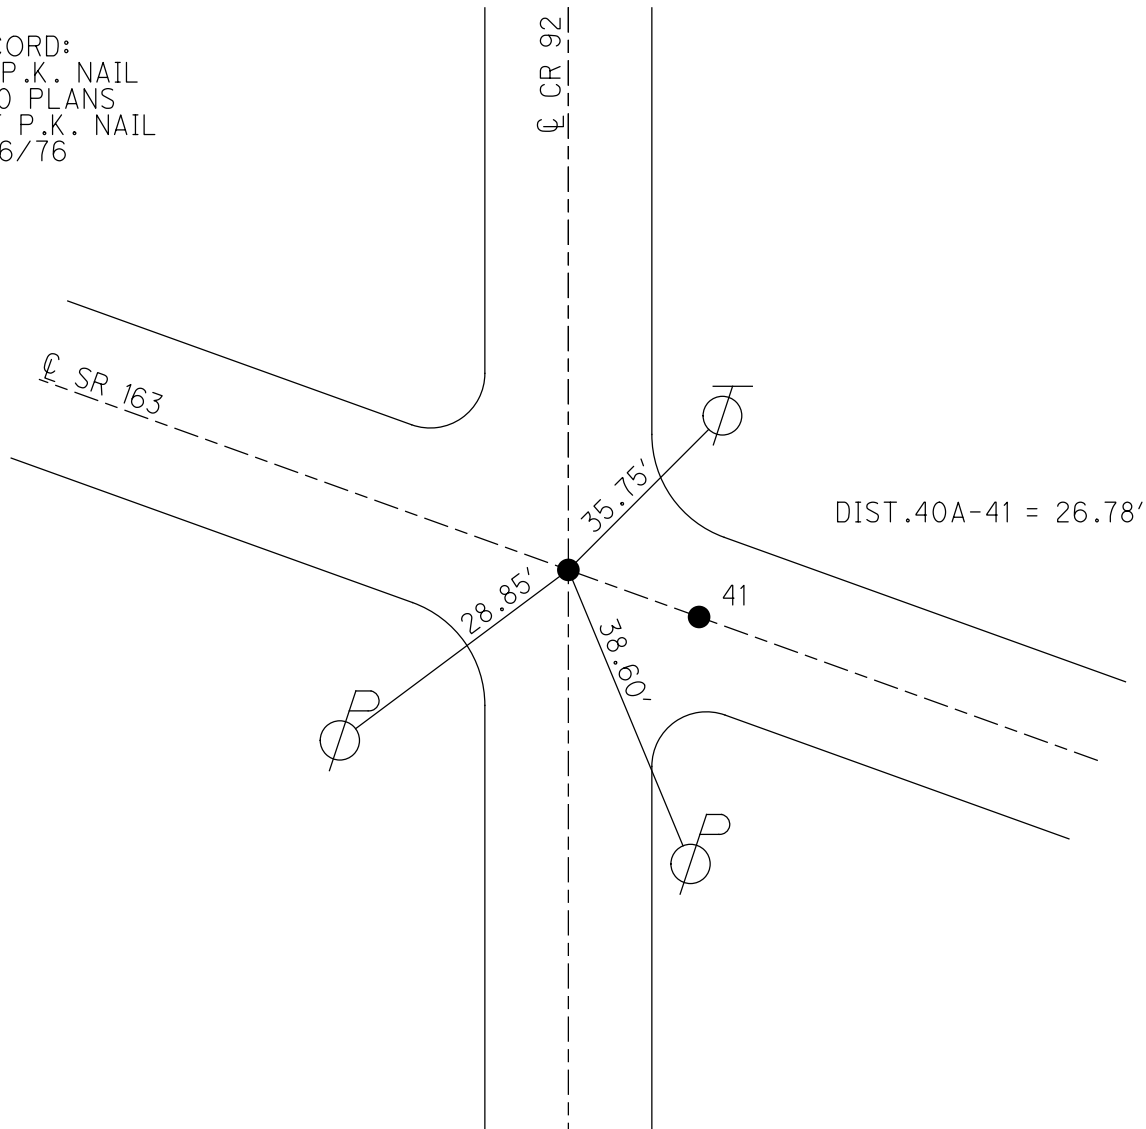

PERSONNEL TITLE PERSONNEL TITLE

COUNTY Ottawa DATE 8-16-76

S. R. 163 WEATHER Fair

SEC. 5 TEMP. 75°

DESCRIPTION Salem Twp. JOB NO.

LEFT

CENTER LINE

RIGHT

FD. R.R. S.P.K. (P)
Reset R.R. Nail

P.T. 43

7017 81.50

Iron Pin

10' Lt. of edge Permit.

Broke 3/16"

T.S.

6964

1' Lt. of 2

Reset R.R. Nail

P.T. 42

6944 64.56

FD. P.K. Nail

Reset R.R. Nail

P.T. # 41

6974 52.12

FD. P.K. Nail on Top

Reset R.R. Nails

31.42

54.88

101.15

101.15

N.W. cor. of
Red House
Bottom of Top Block

54.67 New

E 20' Maple

51.39

54.70

54.33

54.33

87.68

31.83

31.83

Co. Rd. # 92
South