

O.D.O.T. DISTRICT 2 SURVEY OFFICE (USE ONLY)

PERSONNEL

REFERENCE NO. 41

SHEET 12 OF 17

NOTES ASTON

DATE 5-13-24

ROUTE SR 163

H.C. NIESE

WEATHER WINDY

COUNTY OTTAWA

R.C. PRESTON-COLVIN

TEMP. 75°

TOWNSHIP SALEM

MILLER & BLUBAUGH

SECTION 5

DWG BY ASTON PID 101239

T 6 N R 15 E

TYPE MONUMENT MAG/WASHER

ON SURFACE - BELOW ON

OFFSET 4' PAVEMENT LT : RT

TO EDGE PAVEMENT


STATION: 687+52.18

HORIZ.DATUM: NAD83(2011)


GEOID: 18

GRID: NORTHING: 673669.663

EASTING: 1786583.189

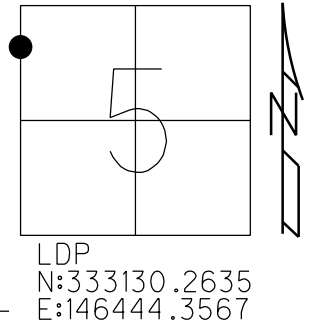

RECORD: P.I.
STA 687+5218
 $\Delta = 11^\circ 00''$ LT
1970 PLANS
FD P.K. NAIL
SET P.K. NAIL
8/16/76
D.N.F.
6/18/93, RIPPLE
FD PK SHANK
REF41
7-3-24, TDN
SET MAG/W
5-13-24, TDN

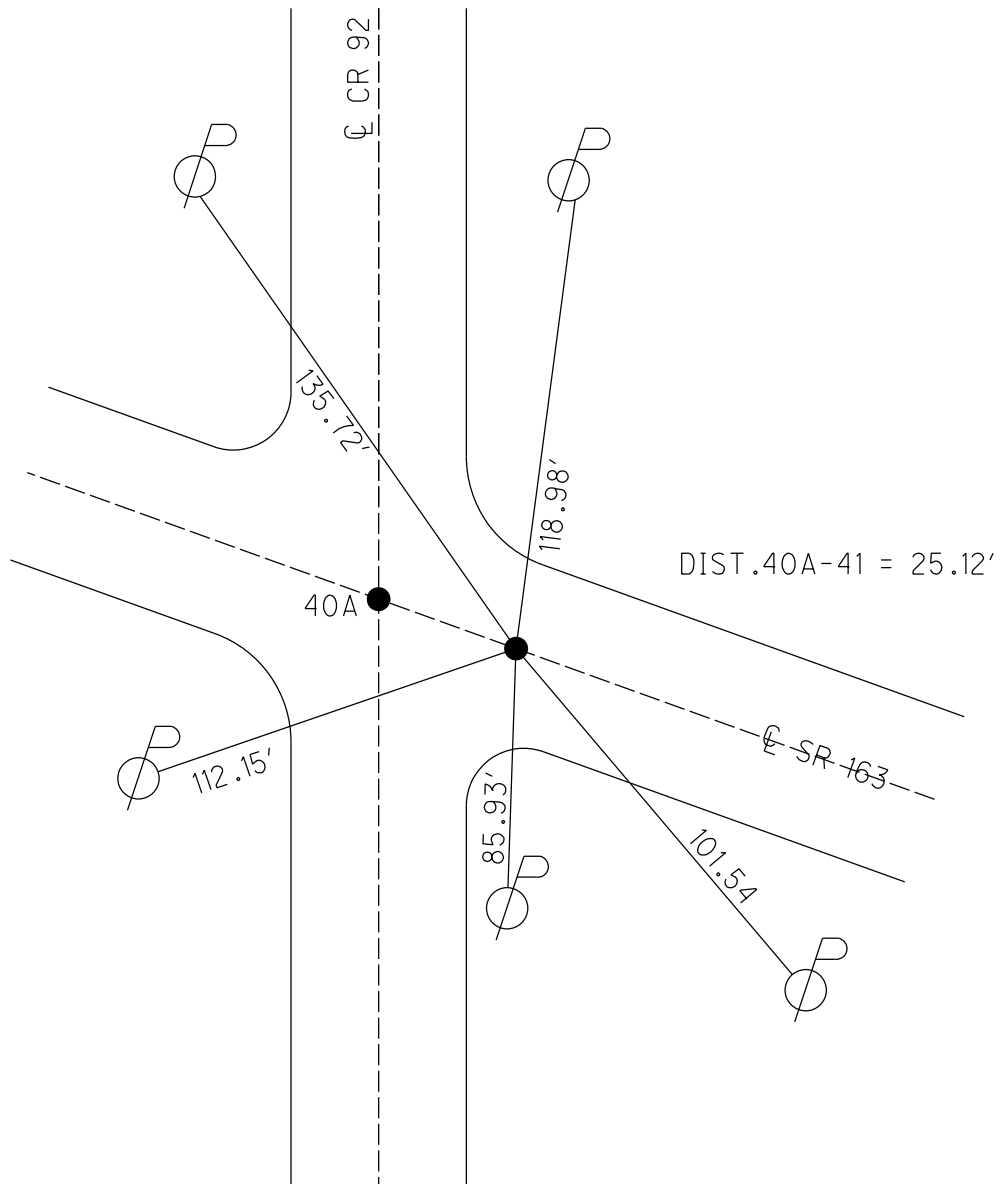

O.D.O.T. DISTRICT 2 SURVEY OFFICE (USE ONLY)

PERSONNEL

REFERENCE NO. 41

SHEET 12 OF 17

NOTES CHENEY

DATE 8/16/76

ROUTE SR 163

H.C. RIPPLE

WEATHER FAIR

COUNTY OTTAWA

R.C. BARBOUR

TEMP. 75°

TOWNSHIP SALEM

SECTION 5

DWG BY NIESE

PID

T 6 N R 15 E

TYPE MONUMENT P.K. NAIL

ON SURFACE - ~~BELOW~~ ON

OFFSET Q PAVEMENT LT : RT

 TO EDGE PAVEMENT


STATION: 687+52.18

HORZ.DATUM:


GEOID:

GRID: NORTHING:

EASTING:

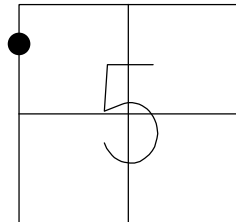

RECORD: P.I.
STA 687+5218
 $\Delta = 11^{\circ} 00''$ LT
1970 PLANS
FD P.K. NAIL
SET P.K. NAIL
8/16/76
D.N.F.
6/18/93, RIPPLE

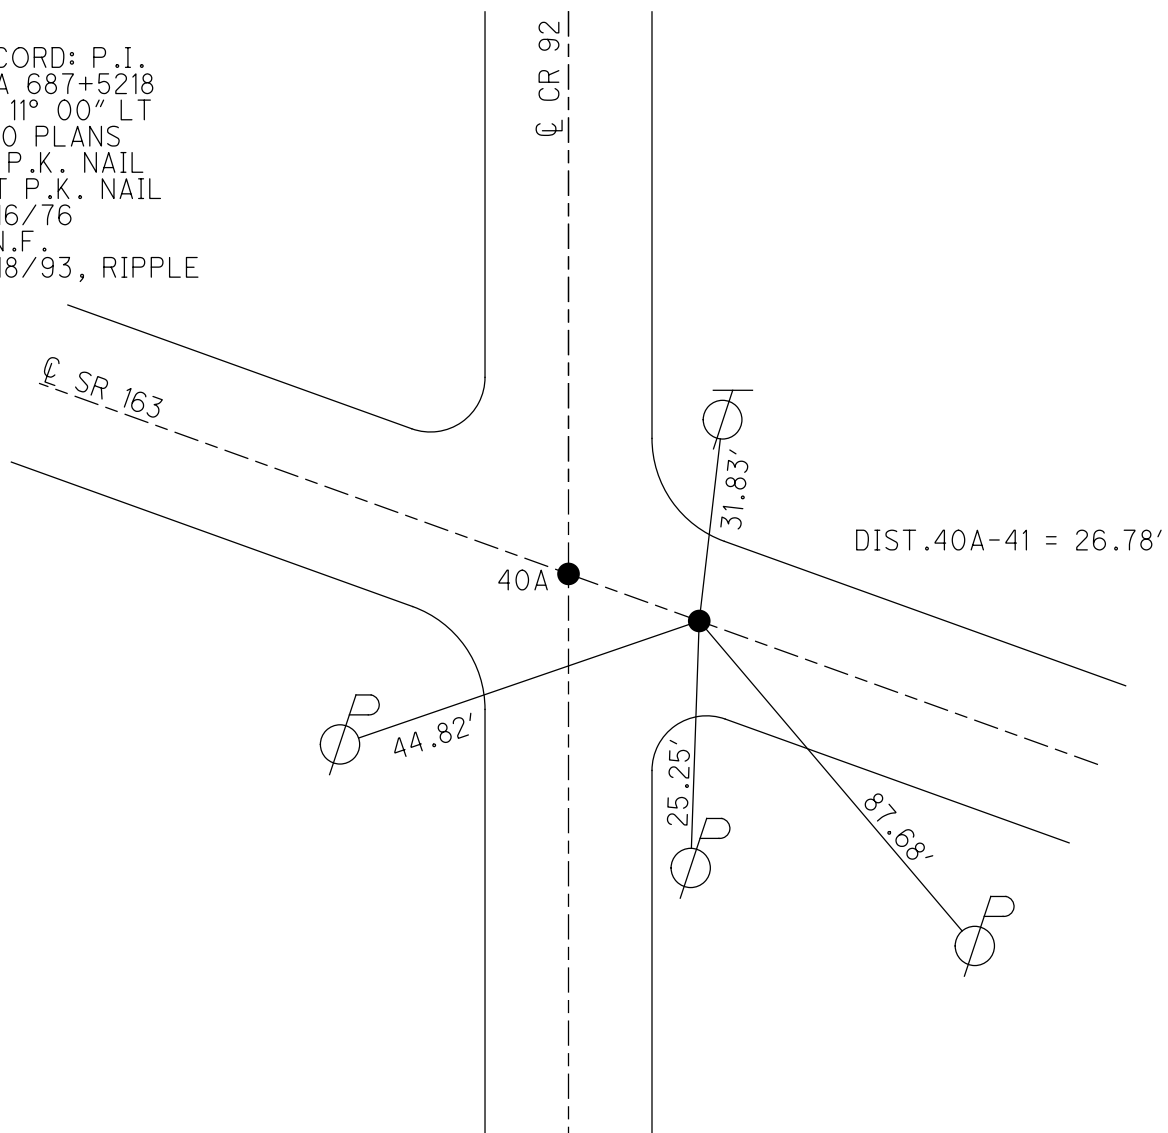

PERSONNEL TITLE PERSONNEL TITLE

COUNTY Ottawa DATE 8-16-76

S. R. 163 WEATHER Fair

SEC. 5 TEMP. 75°

DESCRIPTION Salem Twp. JOB NO.

LEFT

CENTER LINE

RIGHT

FD. R.R. S.P.K. (P)
Reset R.R. Nail

P.T. 43

7017 81.50

Iron Pin

10' Lt. of edge Permit.

Broke 3/16"

T.S.

6964

1' Lt. of 2

Reset R.R. Nail

P.T. 42

6944 64.56

FD. P.K. Nail

Reset R.R. Nail

P.T. # 41

6974 52.12

FD. P.K. Nail on Top

Reset R.R. Nails

31.42

54.88

101.15

101.15

N.W. cor. of
Red House
Bottom of Top Block

54.67 New

Co. Rd. #92

51.39

54.70

54.33

54.33

87.68

31.83

31.83

Co. Rd. #92
South