

O.D.O.T. DISTRICT 2 SURVEY OFFICE (USE ONLY)

PERSONNEL

REFERENCE NO. 42

SHEET 13 OF 17

NOTES ASTON

DATE 5-13-24

ROUTE SR 163

H.C. NIESE

WEATHER WINDY

COUNTY OTTAWA

R.C. PRESTON-COLVIN

TEMP. 75°

TOWNSHIP SALEM

MILLER & BLUBAUGH

SECTION 5

DWG BY ASTON PID 101239

T 6 N R 15 E

TYPE MONUMENT MAG/WASHER

ON SURFACE - BELOW ON

OFFSET $\odot$ PAVEMENT LT : RT

TO EDGE PAVEMENT


STATION: 694+64.56

HORZ.DATUM: NAD83(2011)

GEOID: 18


GRID: NORTHING: 673552.293

EASTING: 1787285.850

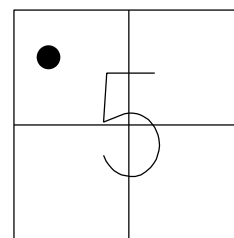

LDP
N:333017.7206
E:147147.8456

RECORD: P.I.
STA 694+64.56
 $\Delta = 12^\circ 45' 30''$ LT
1970 PLANS
FD P.K. NAIL
SET P.K. NAIL
8/16/76
D.N.F.
6/18/93, RIPPLE
D.N.F.
7-3-23, TDN
SET MAG/W
BY COORDINATES
REF42
5-13-24, TDN

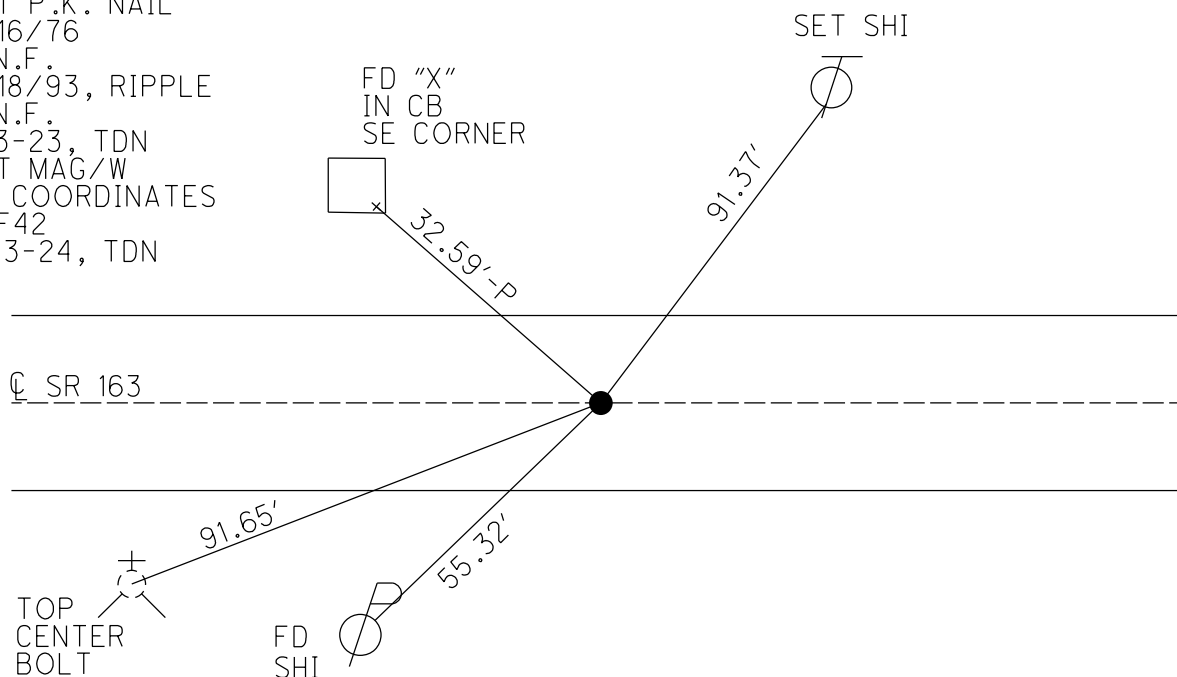

O.D.O.T. DISTRICT 2 SURVEY OFFICE (USE ONLY)

PERSONNEL

REFERENCE NO. 42

SHEET 13 OF 17

NOTES CHENEY

DATE 8/16/76

ROUTE SR 163

H.C. RIPPLE

WEATHER FAIR

COUNTY OTTAWA

R.C. BARBOUR

TEMP. 75°

TOWNSHIP SALEM

SECTION 5

DWG BY NIESE PID

T 6 N R 15 E

TYPE MONUMENT P.K. NAIL

ON SURFACE - ~~BELOW~~ ON

OFFSET Q PAVEMENT LT : RT

 TO EDGE PAVEMENT


STATION: 694+64.56

HORZ.DATUM:


GEOID:

GRID: NORTHING:

EASTING:

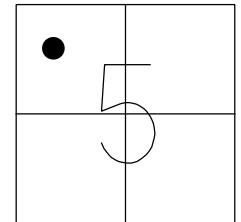

RECORD: P.I.
STA 694+64.56
 $\Delta = 12^\circ 45' 30''$ LT
1970 PLANS
FD P.K. NAIL
SET P.K. NAIL
8/16/76
D.N.F.
6/18/93, RIPPLE

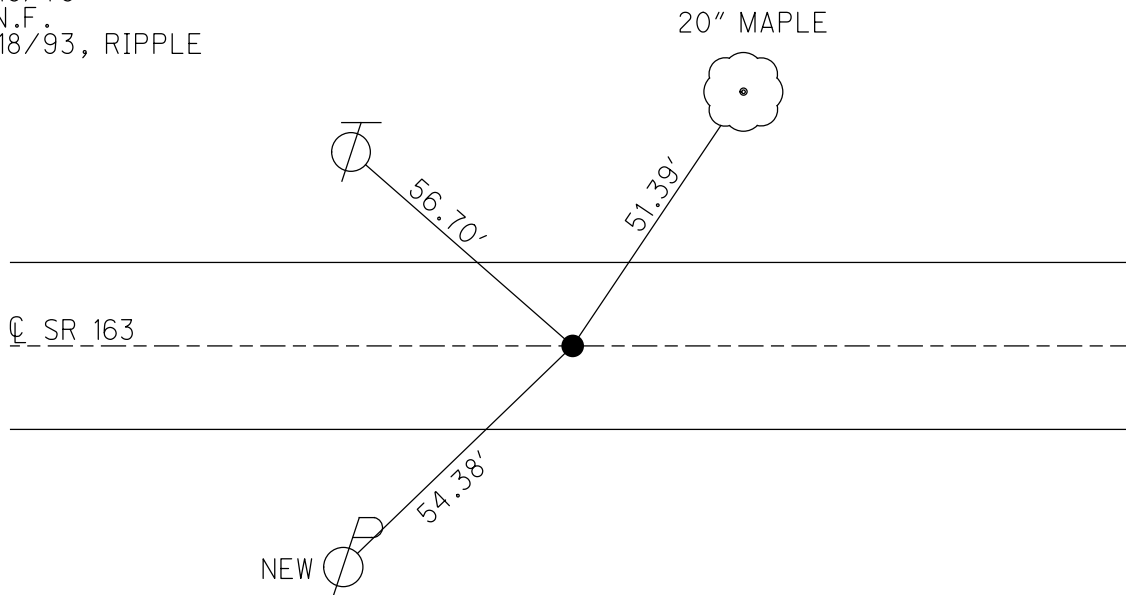

PERSONNEL TITLE PERSONNEL TITLE

COUNTY CHOWA DATE 8-16-76S. R. 163 WEATHER FairSEC. 5 TEMP. 75°DESCRIPTION Salem Twp. JOB NO. _____

LEFT

CENTER LINE

RIGHT

FD. R.R. S.P.K. (P)
Reset R.R. Nail

P.T. 43

7017 81.50

Iron Pin

10' Lb. of edge Permit.

Broke 3/16"

T.S.

6964

1' Lb. of 2

Reset R.R. Nail

P.T. 42

6944 64.56

FD. P.K. Nail

Reset R.R. Nail

P.T. # 41

6974 52.12

FD. P.K. Nail on Top

Reset R.R. Nails

31.42

54.88

101.15

82.29

99.50

54.67

51.39

54.70

54.33

87.68

31.83

35.25

24.78

28.85

24.82

24.82

N.W. cor. of
Red House
Bottom of Topoblock

New

Co. Rd. # 92

51.39

54.70

54.33

87.68

31.83

35.25

24.78

28.85

24.82

24.82

Co. Rd. # 92
South