

O.D.O.T. DISTRICT 2 SURVEY OFFICE (USE ONLY)

PERSONNEL

REFERENCE NO. 43

SHEET 15 OF 17

NOTES ASTON

DATE 7-3-2023

ROUTE SR 163

H.C. NIESE

WEATHER SUNNY

COUNTY OTTAWA

R.C. AUBLE

TEMP. 75°

TOWNSHIP SALEM

SECTION 5

DWG BY ASTON

PID 101239

T 6 N R 15 E


TYPE MONUMENT 3/4" IPIN

~~ON SURFACE~~ - BELOW 5"

OFFSET CL PAVEMENT LT : RT

10.0' TO LT EDGE PAVEMENT

STATION: 701+81.50

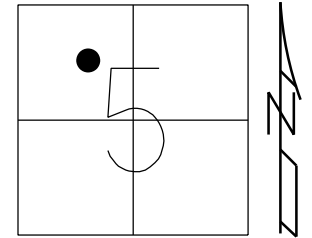

LDP
N:333063.7948
E:147863.4591

HORZ.DATUM: NAD83(2011)


GEOID: 18

GRID: NORTHING: 673593.445

EASTING: 1788001.725

RECORD: P.I.
STA 701+81.50
 $\Delta = 37^\circ 39' RT$
1970 PLANS
FD IPIN
8/16/76
D.N.F.
6/18/93, RIPPLE
FD 3/4" IPIN
5" BELOW
7-3-2023, TDN

MAGRUDER
MED GROUP
1' UP SE
CORNER

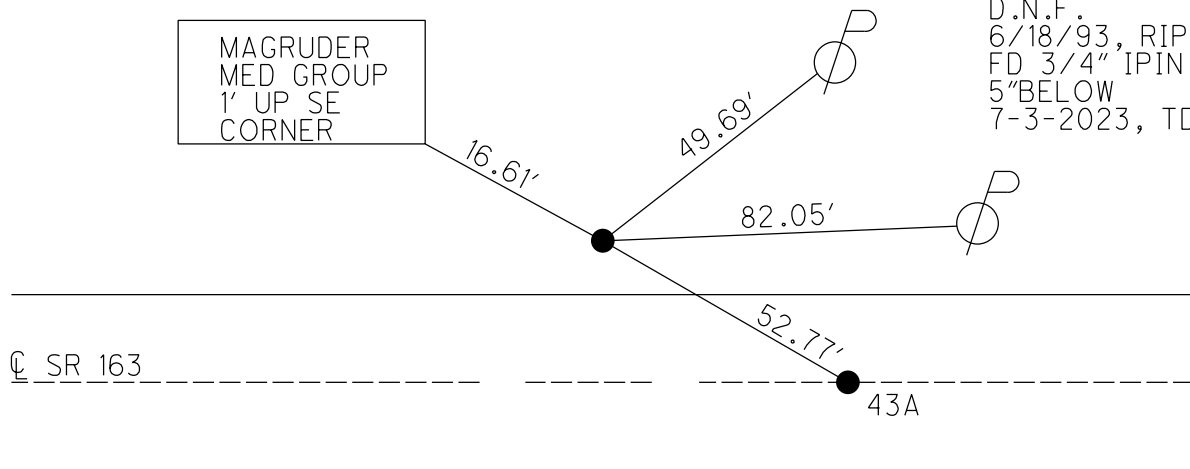

O.D.O.T. DISTRICT 2 SURVEY OFFICE (USE ONLY)

PERSONNEL

REFERENCE NO. 43

SHEET 15 OF 17

NOTES CHENEY

DATE 8/16/76

ROUTE SR 163

H.C. RIPPLE

WEATHER FAIR

COUNTY OTTAWA

R.C. BARBOUR

TEMP. 75°

TOWNSHIP SALEM

DWG BY NIESE

PID

SECTION 5

T 6 N R 15 E

TYPE MONUMENT IPIN

ON SURFACE - ~~BELOW~~ ON


OFFSET Q PAVEMENT LT : RT

10.0' TO LT EDGE PAVEMENT


STATION: 701+81.50

HORIZ.DATUM: GEOID:

GRID: NORTHING: EASTING:

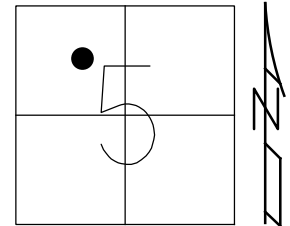

RECORD: P.I.
STA 701+81.50
 $\Delta = 37^\circ 39' \text{ RT}$
1970 PLANS
FD IPIN
8/16/76
D.N.F.
6/18/93, RIPPLE

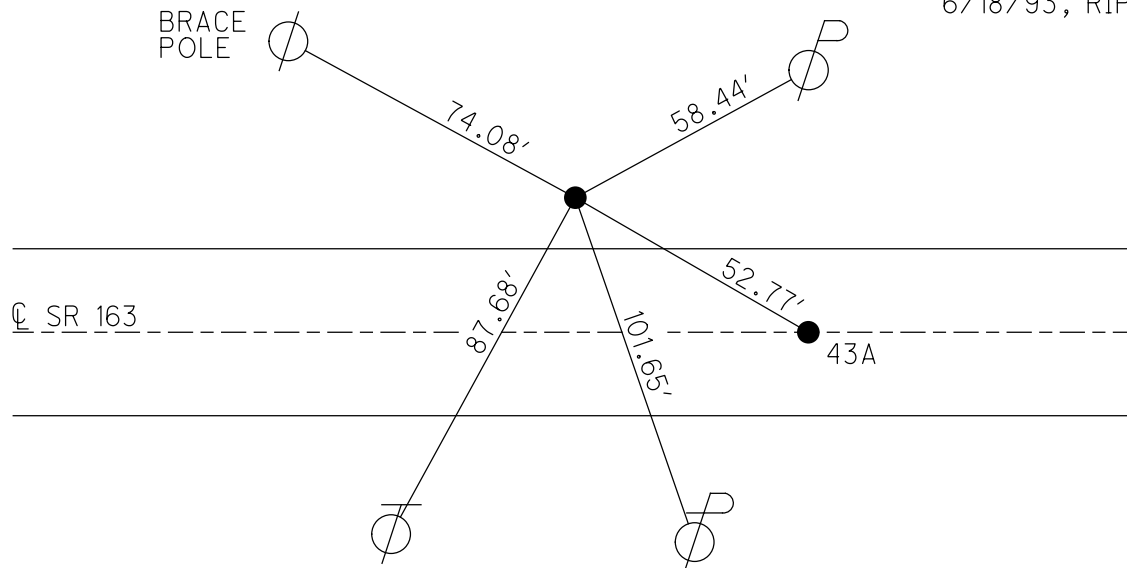

PERSONNEL TITLE PERSONNEL TITLE

COUNTY Ottawa DATE 8-16-76

S. R. 163 WEATHER Fair

SEC. 5 TEMP. 150

DESCRIPTION Salem Twp. JOB NO.

LEFT

CENTER LINE

RIGHT

FD. R.R. S.P.K. (P)
Reset R.R. Nail

P.T. 43

7017 81.50

Iron Pin

10' Lt. of edge Permit.

Broke 3/16"

T.S.

6964

1' Lt. of 2

Reset R.R. Nail

P.T. 42

6944 64.56

FD. P.K. Nail

Reset R.R. Nail

P.T. # 41

6974 52.12

FD. P.K. Nail on Top

Reset R.R. Nails

31.42

54.88

101.15

82.29

99.50

54.67

51.39

54.33

87.68

31.83

35.25

24.86

24.82

24.82

N.W. cor. of
Red House
Bottom of Topoblock

New

Co. Rd. # 92

51.39

54.70

54.33

54.33

Co. Rd. # 92
South

PERSONNEL TITLE PERSONNEL TITLE

COUNTY 163 DATE 11-17-66S. R. Ottawa WEATHERSEC. Oak Harbor TEMP. 60°

DESCRIPTION LEFT CENTER LINE RIGHT JOB NO.

P.I.
720+40.97

5286

(46)

N. E. cor. gas station

N. E. cor. doorway

S. E. cor. gas station

S. R. 163

83.25
41.83

61.73

89.57

N. E. cor. of Foundation Restaurant

1/2" above ground
2" Pipe

44.92

53.42

89.84

Oak Harbor Corp Limits (?)

5285

(45)

P.I.
709+98.01
P.K. Nail

5284

(44)

30.19

28.99

128.89

P.I.
701+81.50
Iron Pin

5283

(43)

73.97

101.63

11.00'

87.80

N. & S. in Permit