

O.D.O.T. DISTRICT 2 SURVEY OFFICE (USE ONLY)

PERSONNEL

REFERENCE NO. 44

SHEET 17 OF 17

NOTES ASTON

DATE 5-14-2024

ROUTE SR 163

H.C. NIESE

WEATHER CLEAR

COUNTY OTTAWA

R.C. PRESTON-COLVIN

TEMP. 70°

TOWNSHIP SALEM

DWG BY ASTON PID NO PID

SECTION 5

T 6 N R 15 E

TYPE MONUMENT MAG/WASHER

ON SURFACE - ~~BELOW~~ ON

OFFSET Q PAVEMENT ON LT : RT
TO EDGE PAVEMENT


STATION: 709+98.01

HORIZ.DATUM: NAD83(2011)

GEOID: 18


GRID: NORTHING: 673132.765

EASTING: 1788675.690

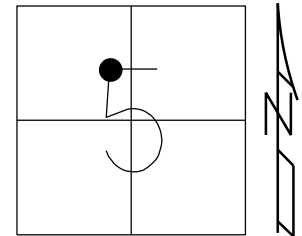

LDP
N:332607.7337
E:148540.6119

RECORD: P.I.
STA 709+98.01
 $\Delta = 0^\circ 27' RT$
1970 PLANS
FD P.K. NAIL
SET P.K. NAIL
8/16/76
D.N.F.
6/18/93, RIPPLE
SET MAG/WASHER
REF44
5-14-24, TDN

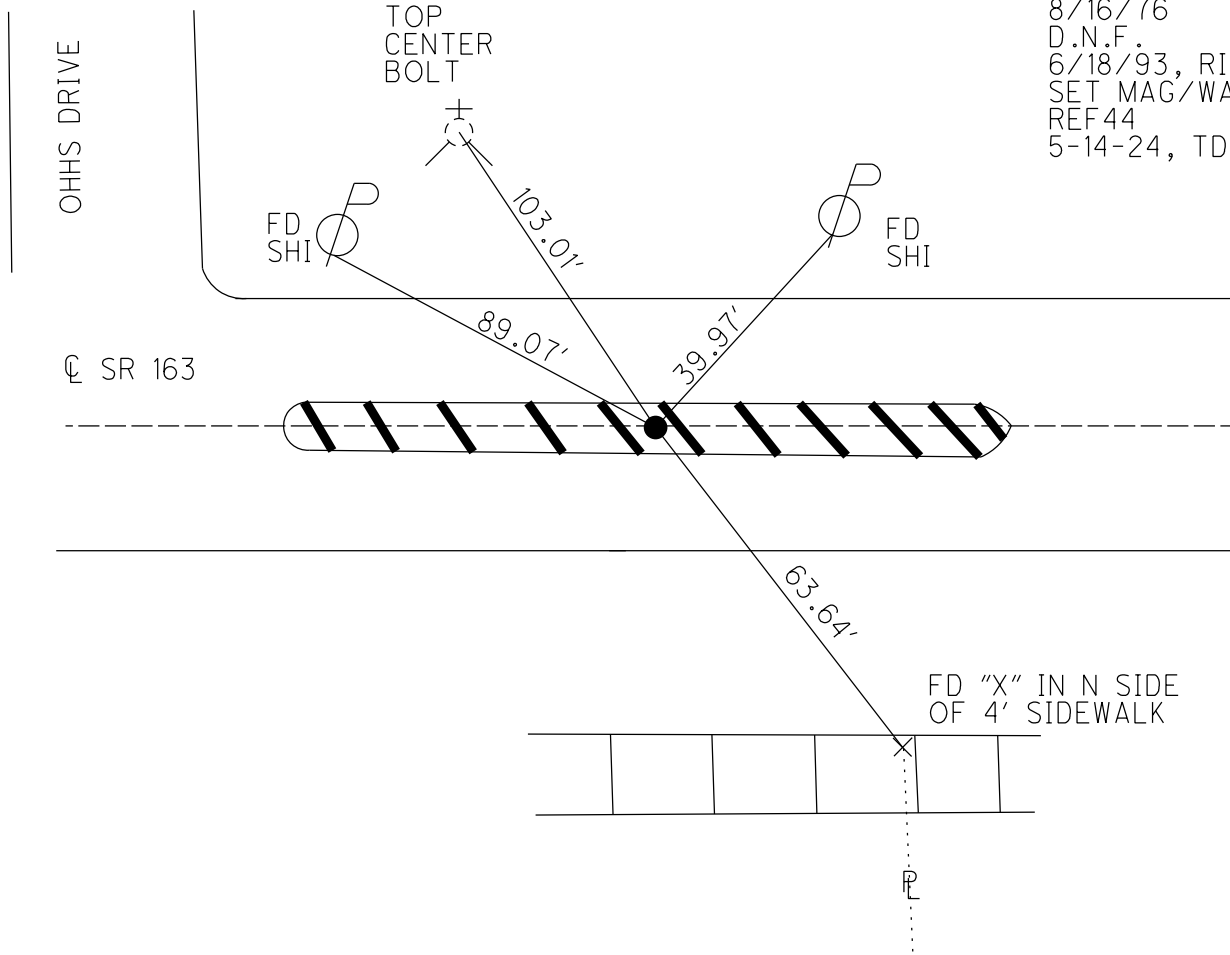

O.D.O.T. DISTRICT 2 SURVEY OFFICE (USE ONLY)

PERSONNEL

REFERENCE NO. 44

SHEET 17 OF 17

NOTES CHENEY

DATE 8/16/76

ROUTE SR 163

H.C. RIPPLE

WEATHER FAIR

COUNTY OTTAWA

R.C. BARBOUR

TEMP. 76°

TOWNSHIP SALEM

DWG BY NIESE PID

SECTION 5

T 6 N R 15 E

TYPE MONUMENT P.K. NAIL

ON SURFACE - ~~BELOW~~ ON


OFFSET Q PAVEMENT ON LT : RT

 TO EDGE PAVEMENT

STATION: 709+98.01


HORIZ.DATUM: GEOID:

GRID: NORTHING: EASTING:

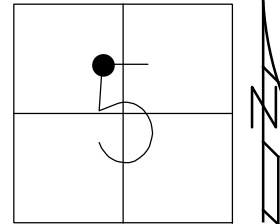

BETWEEN THE
2 VALVES ON
FIRE HYDRANT

RECORD: P.I.
STA 709+98.01
 $\Delta = 0^\circ 27' \text{ RT}$
1970 PLANS
FD P.K. NAIL
SET P.K. NAIL
8/16/76
D.N.F.
6/18/93, RIPPLE

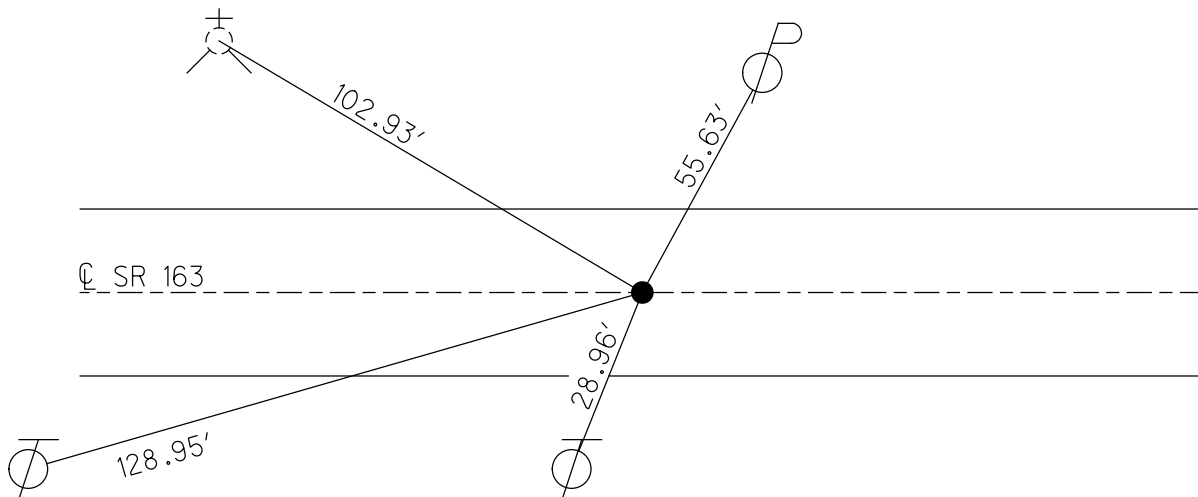

PERSONNEL	TITLE	PERSONNEL	TITLE
-----------	-------	-----------	-------

COUNTY O'Hawa DATE 8-16-76

S. R. 163 WEATHER Fair

SEC. 5 Water Twp. TEMP 70°

DESCRIPTION Oak Harbor


gas station

JOB NO.

LEFT

CENTER LINE

RIGHT

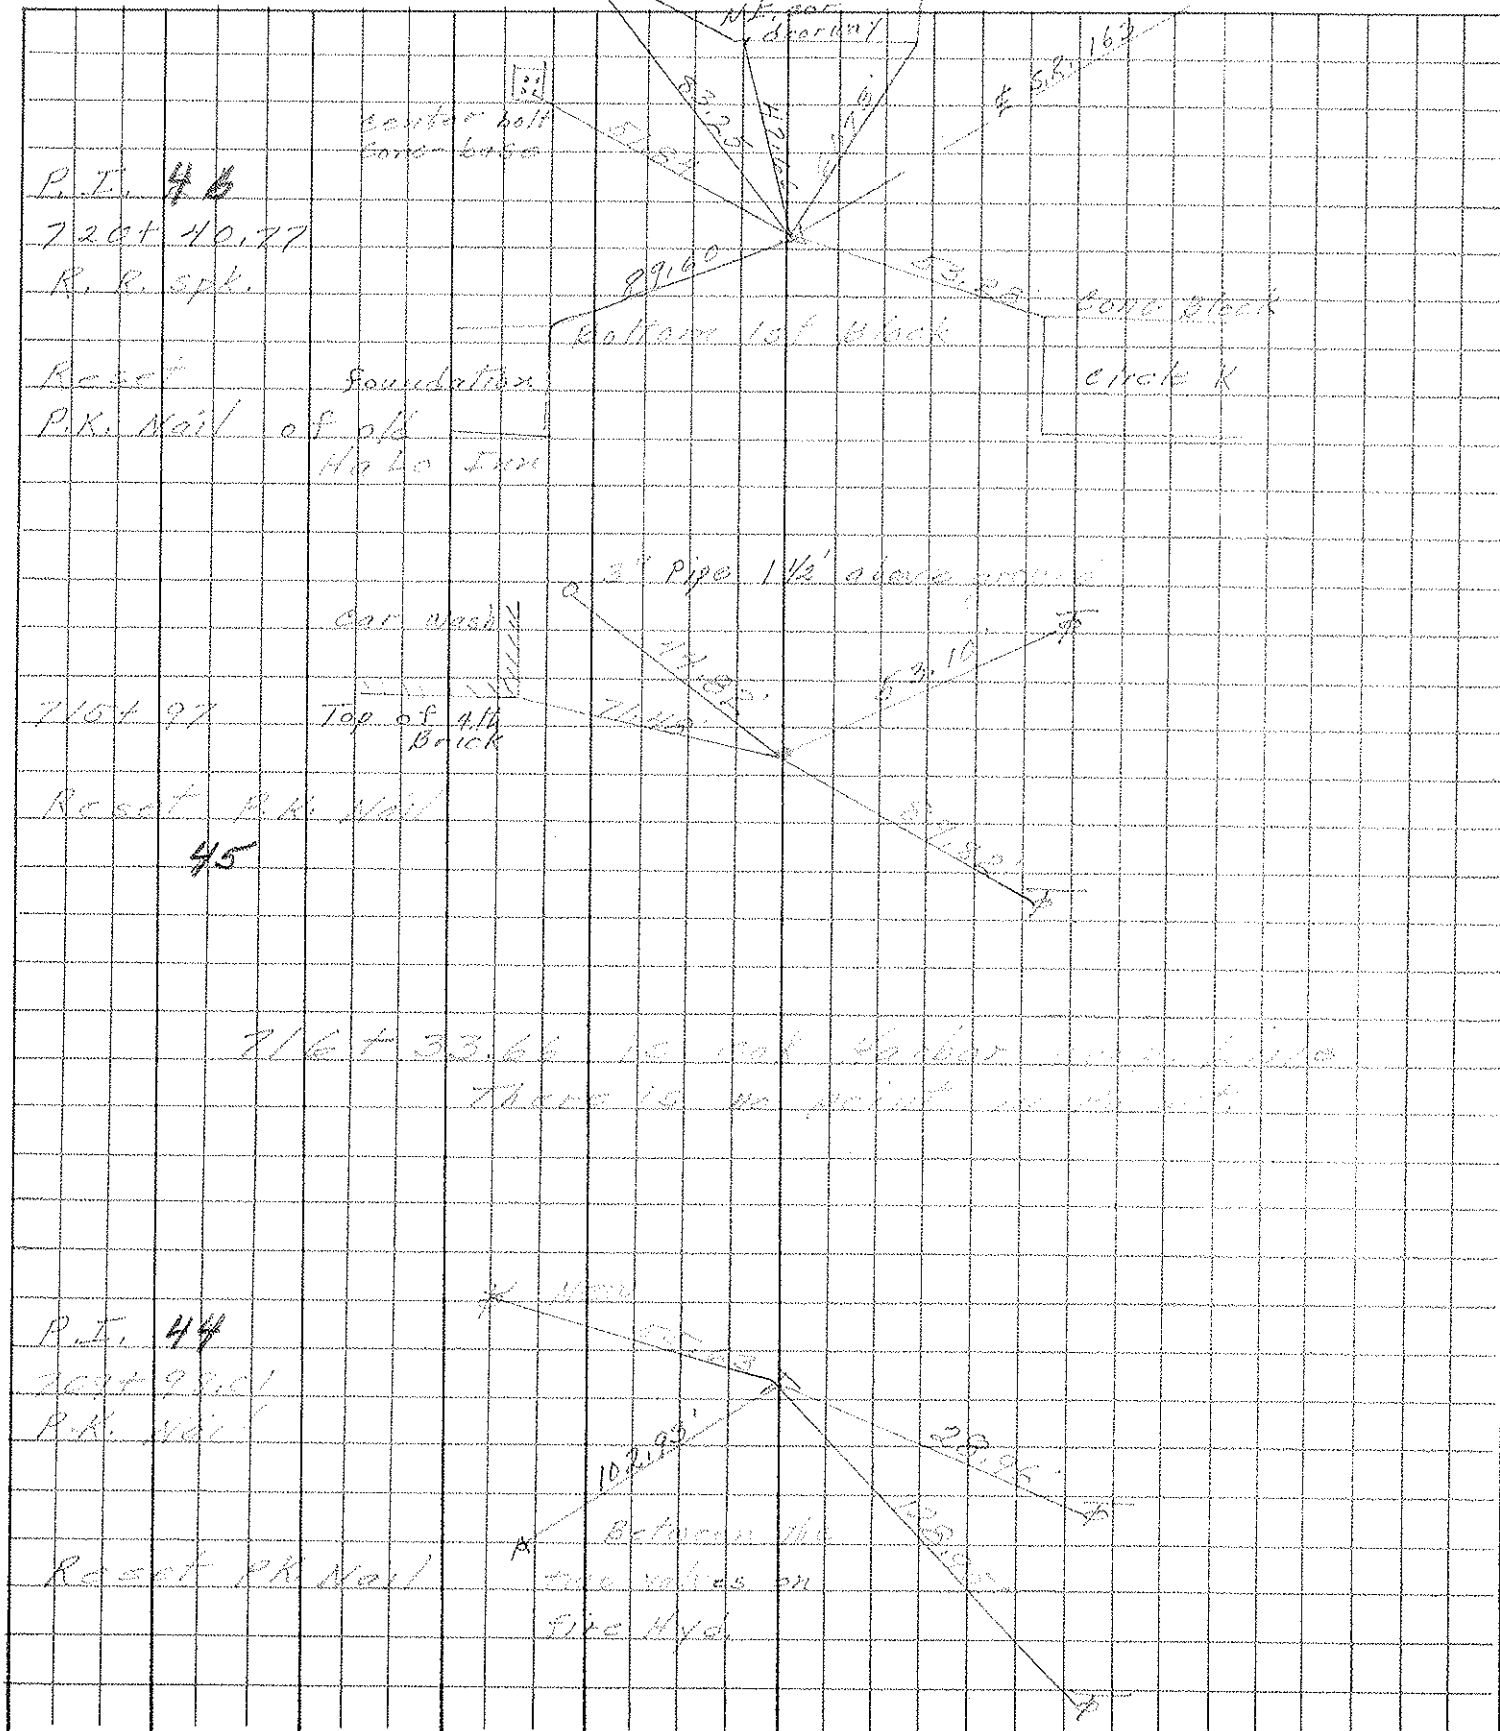

PERSONNEL TITLE PERSONNEL TITLE

COUNTY 163 DATE 11-17-66S. R. Ottawa WEATHERSEC. Oak Harbor TEMP. 60°

DESCRIPTION LEFT CENTER LINE RIGHT JOB NO.

P.I.
720+40.97

5286

(46)

N. E. cor. gas station

N. E. cor. doorway

S. E. cor. gas station

S. R. 163

83.25
41.83

61.73

89.57

N. E. cor. of Foundation Restaurant

1/2" above ground
2" Pipe

44.92

53.42

89.84

Oak Harbor Corp Limits (?)

5285

(45)

P.I.
709+98.01
P.K. Nail

5284

(44)

30.19

28.99

128.89

P.I.
701+81.50
Iron Pin

5283

(43)

73.97

101.63

11.00'

N. & S. in Permit

87.80

PERSONNEL

TITLE

PERSONNEL

TITLE

COUNTY

Ottawa

DATE

11-17-66

S. R.

163

WEATHER

Fair

SEC.

5 Salem Twp

TEMP.

60°

DESCRIPTION

Oak Harbor

JOB NO.

LEFT

CENTER LINE

RIGHT

P. I.

720+40.77

(46)

N.E. cor.
gas stationN.E. cor.
doorway

S.E. cor. gas station

S.R. # 163

83.25'

47.83'

61.73'

89.57'

N.E. cor. of foundation Restaurant

2" Pipe - 1 1/2' above the ground

44.92'

53.42' ϕ

Oak Harbor Corp Line

716+33.66

Corp Line

Oak Harbor

(45)

89.84'

P. I.

709+98.01

P. K. Nail

 $\Delta = 0^{\circ} 27' 8''$

(44)

 ϕ

30.19'

28.99' ϕ 128.89' ϕ