

O.D.O.T. DISTRICT 2 SURVEY OFFICE (USE ONLY)

PERSONNEL

REFERENCE NO. 47 A

SHEET 4 OF 74

NOTES ASTON

DATE 5-14-24

ROUTE SR 163

H.C. NIESE

WEATHER CLEAR

COUNTY OTTAWA

R.C. PRESTON-COLVIN

TEMP. 70°

TOWNSHIP SALEM

SECTION 5

DWG BY ASTON

PID NO PID

T 6 N R 14 E

TYPE MONUMENT MAG/WASHER

ON SURFACE - ~~BELOW~~ ON

OFFSET Q PAVEMENT 0.3' LT : ~~RT~~

TO EDGE PAVEMENT


STATION: 723+21

HORIZ.DATUM: NAD83 2011


GEOID: 18

GRID: NORTHING: 672228.869

EASTING: 1789528.070

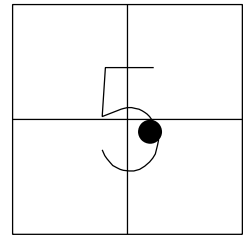

LDP
N:331709.6696
E:149399.2307

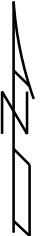

RECORD:

FD P.K./WASHER

8-1-00 SAH

SET P.K./WASHER

11-28-00, SAH

SHOT P.K./WASHER

REFA47

FD P.K./WASHER

6-28-17, JLL

SET MAG/WASHER

7-10-18, JLL

FD MAG/W

REF47A

5-14-24, TDN



23.80'

32.88'

60.17'

Q OTTAWA ST

DIST. 47A-47B = 1.35'

47B

45.22'

FD "+" CUT
TOP WEST
BONNET BOLT

Q SR 163

SET SAWCUT "+"
29' FROM W END CURB
AT WALK

O.D.O.T. DISTRICT 2 SURVEY OFFICE (USE ONLY)

PERSONNEL

REFERENCE NO. 47 A

SHEET 4 OF 74

NOTES LEU

DATE 6-28-17

ROUTE SR 163

H.C. LEU

WEATHER SUNNY

COUNTY OTTAWA

R.C. CARSON

TEMP. 67°

TOWNSHIP SALEM

SECTION 5

DWG BY JAMES

PID 95757

T 6 N R 14 E

TYPE MONUMENT P.K./WASHER

ON SURFACE - ~~BELOW~~ ON

OFFSET Q PAVEMENT 0.3' LT : ~~RT~~

TO EDGE PAVEMENT


STATION: 723+21

HORZ.DATUM: NAD83 2011

GEOID: NAVD88 2012A

GRID: NORTHING: 672228.838

EASTING: 1789528.118

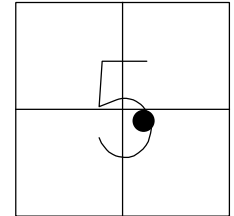

RECORD:

FD P.K./WASHER

8-1-00 SAH

SET P.K./WASHER

11-28-00, SAH

SHOT P.K./WASHER


REFA47

FD P.K./WASHER

6-28-17, JLL

SET MAG/WASHER

7-10-18, JLL

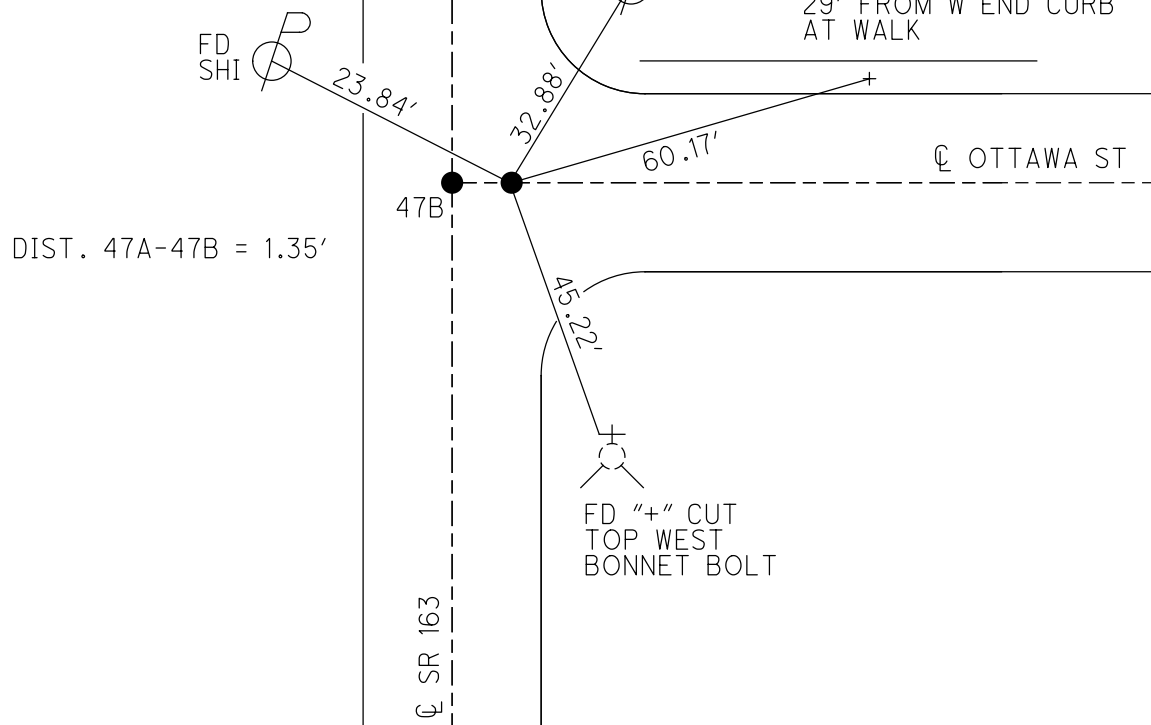

O.D.O.T. DISTRICT 2 SURVEY OFFICE

PERSONNEL

REFERENCE NO. 47

SHEET 1 OF 63

NOTES Huss

H.C. Condes

R.C. Huss

DATE 8-1-00

WEATHER Cloudy-Fair

TEMP. 75°F

ROUTE 163

COUNTY Ottawa

TOWNSHIP Salem

SECTION 5

T 6 N R 14 E


TYPE MONUMENT (A) - PK (B) - PK

ON SURFACE - BELOW Surf.

LEFT - CL PAV'T. - RIGHT (A) - CL (B) - 1.3' RET

TO EDGE PAVEMENT


S.L.M. 723 + 21

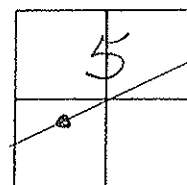

Set PK/w
both points

11-28-00
SAM

Distance
between points
A - B
1.3'

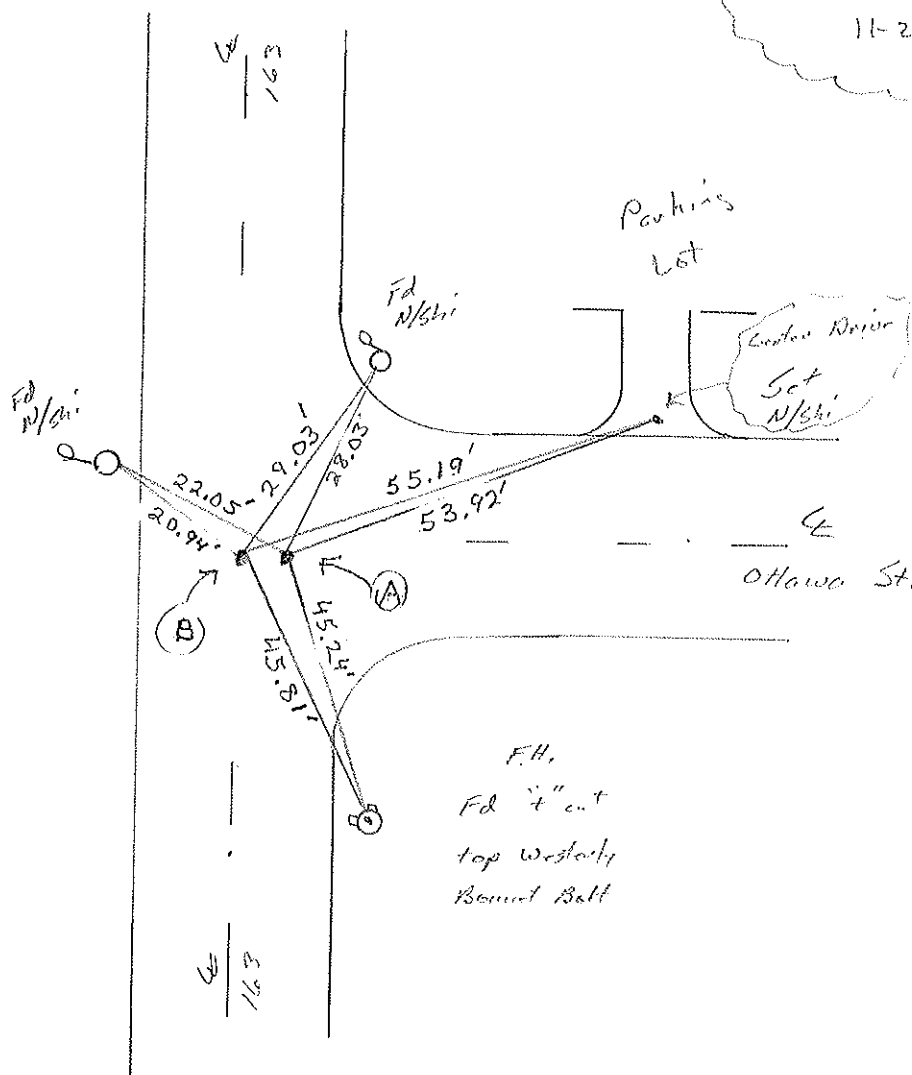

Resurfaced 2000

O.D.O.T. DISTRICT 2 SURVEY OFFICE

PERSONNEL

REFERENCE NO. 47

SHEET 23 OF 24

NOTES CHENEY

H.C. FIPPLE

R.C. BARBOUR

GEYMAN

DATE 6-21-1993

WEATHER CLOUDY

TEMP. 75°

ROUTE #163

COUNTY OTTAWA

TOWNSHIP SALEM

SECTION 5-OAK HARBOR

T6N R 15E


TYPE MONUMENT HOLES IN PAV'T. (P.K.'S KNOCKED OUT)

ON SURFACE - ~~BELOW~~ ON

LEFT - CL PAV'T. - RIGHT A" = 0.7' LT. ; B" = 0.7' RT.

A" = 17.0'
B" = 15.6' TO RT. EDGE PAVEMENT

S.L.M. 724+63

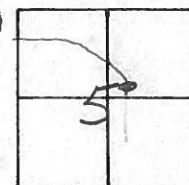

RECORDED: 11-19-1973

P.O.T. STA. 723+49.51

2 P.K. NAILS


RESET P.K. NAILS (8-16-76)

SET PK/WASHER
7-27-1993
RCC

FD. N/S.
S.E. SIDE

FD. N/S.
S.W. SIDE

1.30' BET.
PT. A" & R. B"

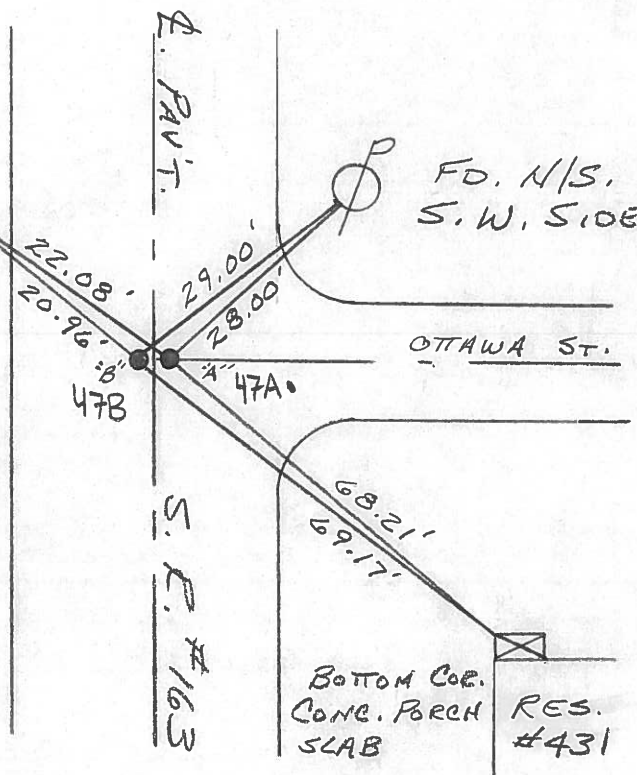

PERSONNEL TITLE PERSONNEL TITLE

COUNTY Ottawa

DATE 11-19-73

S. R. 163

WEATHER Cloudy

SEC. Oak Harbor

TEMP. 50°

DESCRIPTION Sec 4 Salem Twp.

JOB NO.


LEFT

CENTER LINE

RIGHT

48


727+70
R.R. Spk.

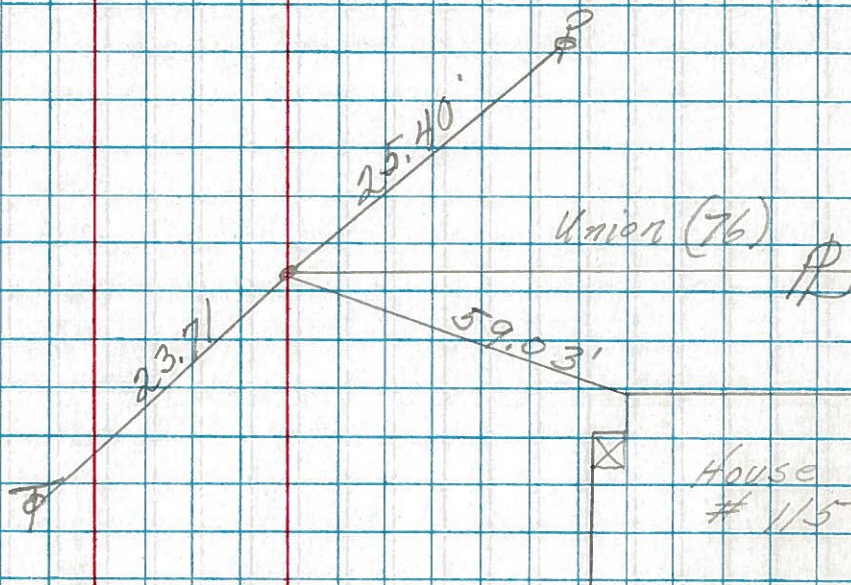

Reset P.K. Nails
8-16-76

Face First Hyd.

P.O.T. 47
723+49.51
2-P.K. Nail

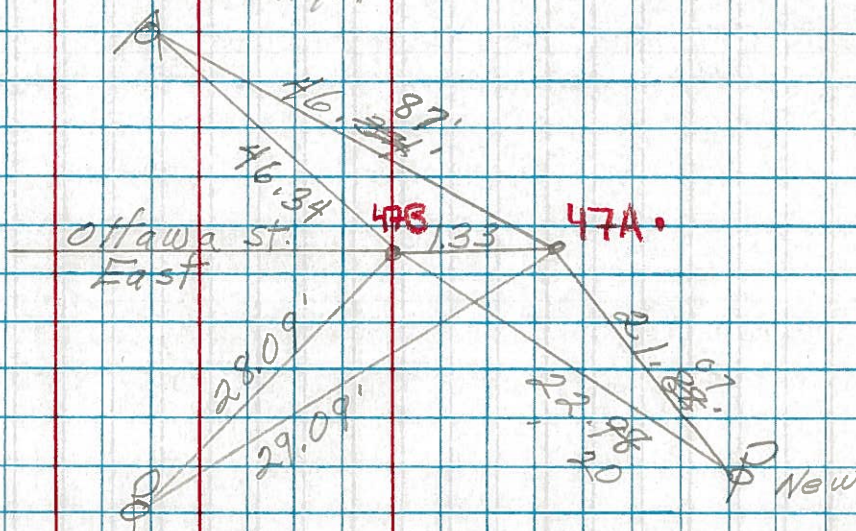

PERSONNEL TITLE PERSONNEL TITLE

COUNTY Ottawa DATE 11-17-66S. R. 163 WEATHER FairSEC. Oak Harbor TEMP. 60°DESCRIPTION Sec 4 Salem Twp. JOB NO. _____


LEFT

CENTER LINE

RIGHT

P.K. Nail

49

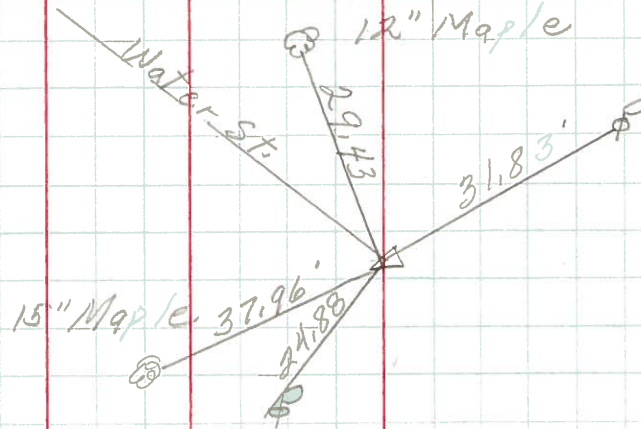


P.I.

729+48.41

P.K. Nail

48

49A

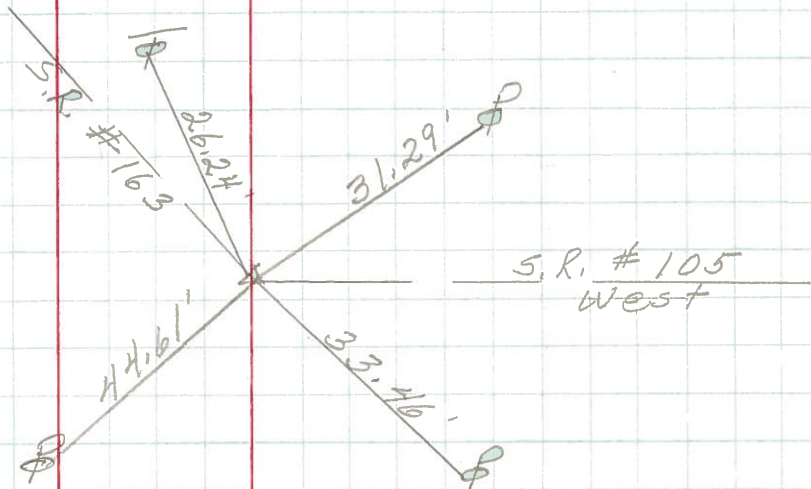


P.O.T.

723+49.51

2-P.K. Nails

47A

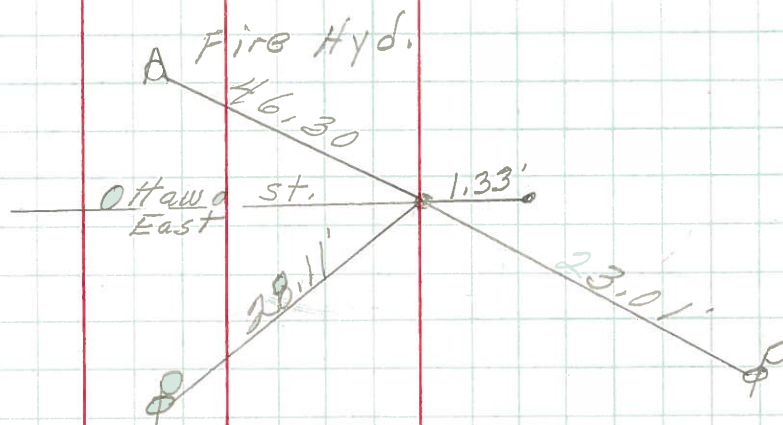

PERSONNEL TITLE PERSONNEL TITLE

COUNTY Ottawa DATE 11-17-66S. R. 163 WEATHERSEC. Oak Harbor TEMP. 60°DESCRIPTION Control Points JOB NO.

LEFT


CENTER LINE

RIGHT

729+48.41
P.K. Nail

5288

(49)

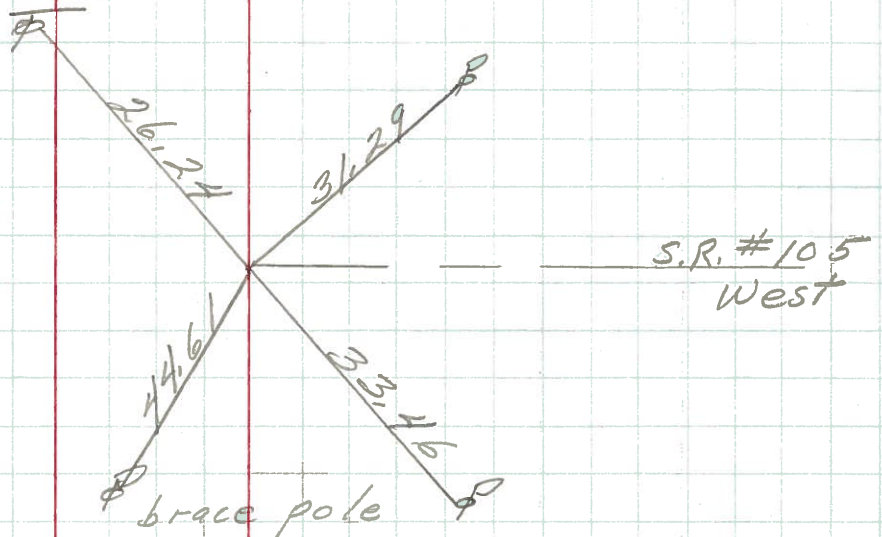

P.O.T.
723+49.51

5287

(47A)

