

O.D.O.T. DISTRICT 2 SURVEY OFFICE (USE ONLY)

PERSONNEL

REFERENCE NO. 177

NOTES MILLER

DATE 3/4/25

ROUTE SR 163

H.C. NIESE

WEATHER CLOUDY

COUNTY OTTAWA

R.C. BARRIERE

TEMP. 45°

TOWNSHIP DANBURY

SECTION 10

DWG BY BARRIERE PID 99588

TYPE MONUMENT MONBOX W/ 1" IPIN

ON SURFACE - BELOW ON


OFFSET $\odot$ PAVEMENT 13.0' LT

STATION: 2188+70

HORZ.DATUM: NAD83('11)/OTT OCCS GEOID: 18

GRID: NORTHING: EASTING:

LDP: NORTHING: 333915.325 EASTING: 256654.479

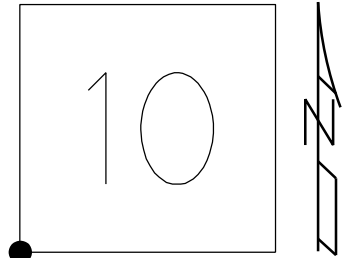

RECORD:
FD MONBOX
W/ 1" IPIN
W/ DIMPLE
NEWREF177
10/14/22, DSA
FD MONBOX
W/ 1" IPIN
W/ DIMPLE
W/O LID
3/4/25, TDN

