

O.D.O.T. DISTRICT 2 SURVEY OFFICE (USE ONLY)

PERSONNEL _____ REFERENCE NO. 6 SHEET 7 OF 7
 NOTES RHOADES DATE 11/17/21 ROUTE SR 269
 H.C. O'DONNELL WEATHER CLOUDY COUNTY OTTAWA
 R.C. SLUSHER TEMP. 50° TOWNSHIP DANBURY
 SECTION 4-26
 DWG BY RHOADES PID 114099

TYPE MONUMENT TIE CROSSING

ON SURFACE - ~~BELOW~~ ON

OFFSET 9.5' TO LT EDGE PAVEMENT

STATION: 29+10


HORIZ.DATUM: NAD83 2011

GEOID: NAVD88 2012A


GRID: NORTHING: 670631.417

EASTING: 1878350.745

NOTE:
THIS MAP IS FOR ODOT PURPOSES ONLY
TO INDEX REFERENCE TIES, AND DOES NOT
REPRESENT TRUE LAND SUBDIVISION.

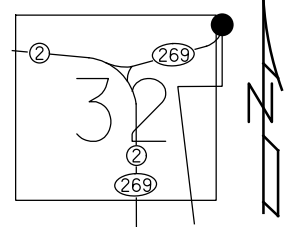

RECORD: P.I.
 STA. 29+00.58
 FD P.K./WASHER
 3/28/00, CL
 SET P.K./WASHER
 6/16/00, CL
 D.N.F.
 SHOT TIE XING
 REF6
 11/17/21, JFO

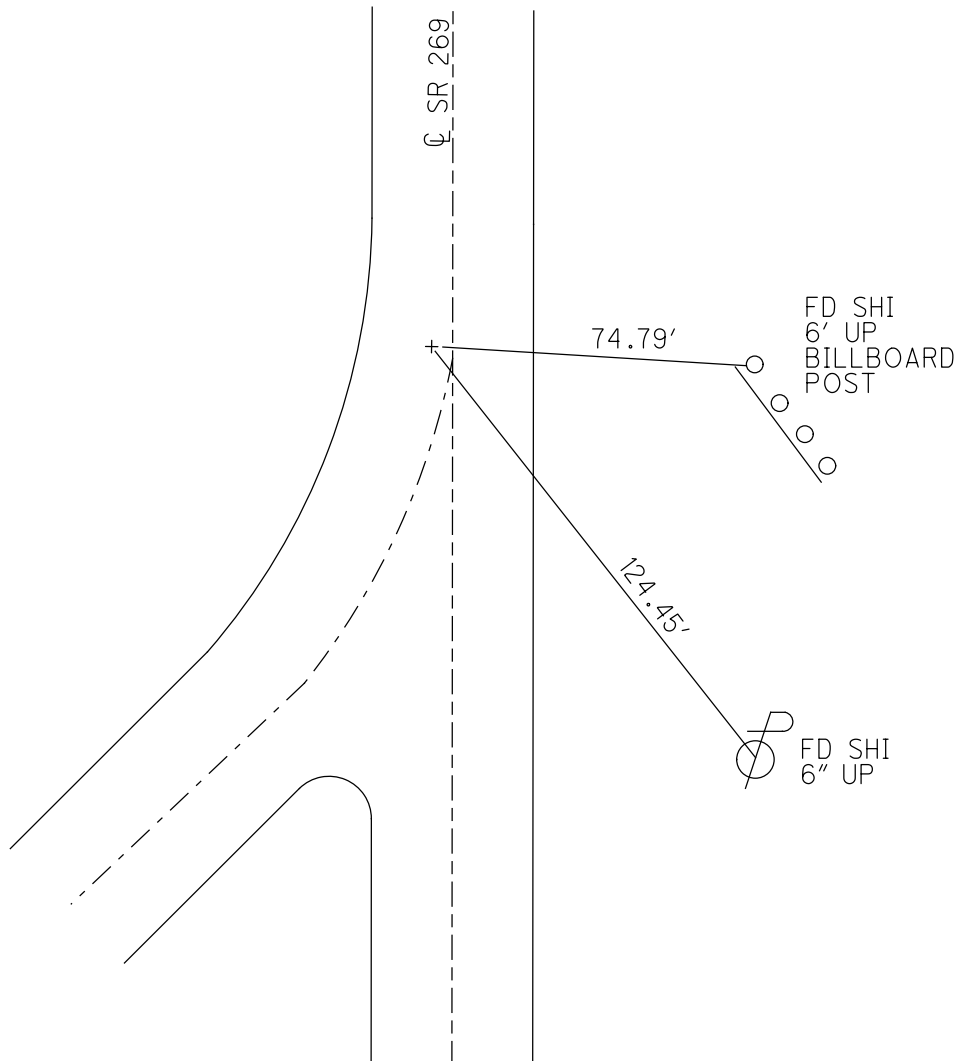

O.D.O.T. DISTRICT 2 SURVEY OFFICE

PERSONNEL _____ REFERENCE NO. 6 SHEET _____ OF _____


NOTES Huss, Loehcke
 H.C. Loehcke
 R.C. Huss

DATE 3-28-00
 WEATHER Pt. Cldy - Fair
 TEMP. + 50° F.


ROUTE 269
 COUNTY Ottawa
 TOWNSHIP Danbury
 SECTION _____
 T _____ R _____

TYPE MONUMENT PK/W
ON SURFACE - ~~BELOW~~ Surface
LEFT - ① ~~BELOW MONUMENT~~
9.5' TO Lt. EDGE PAVEMENT
 S.L.M. 29 + 10

Set P.K./WASHER
 6-16-00
 C.H.

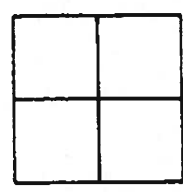

Record: P.I.
 Sta 29+00.58 set
 PK/W atop "+" in conc.
 Cronin

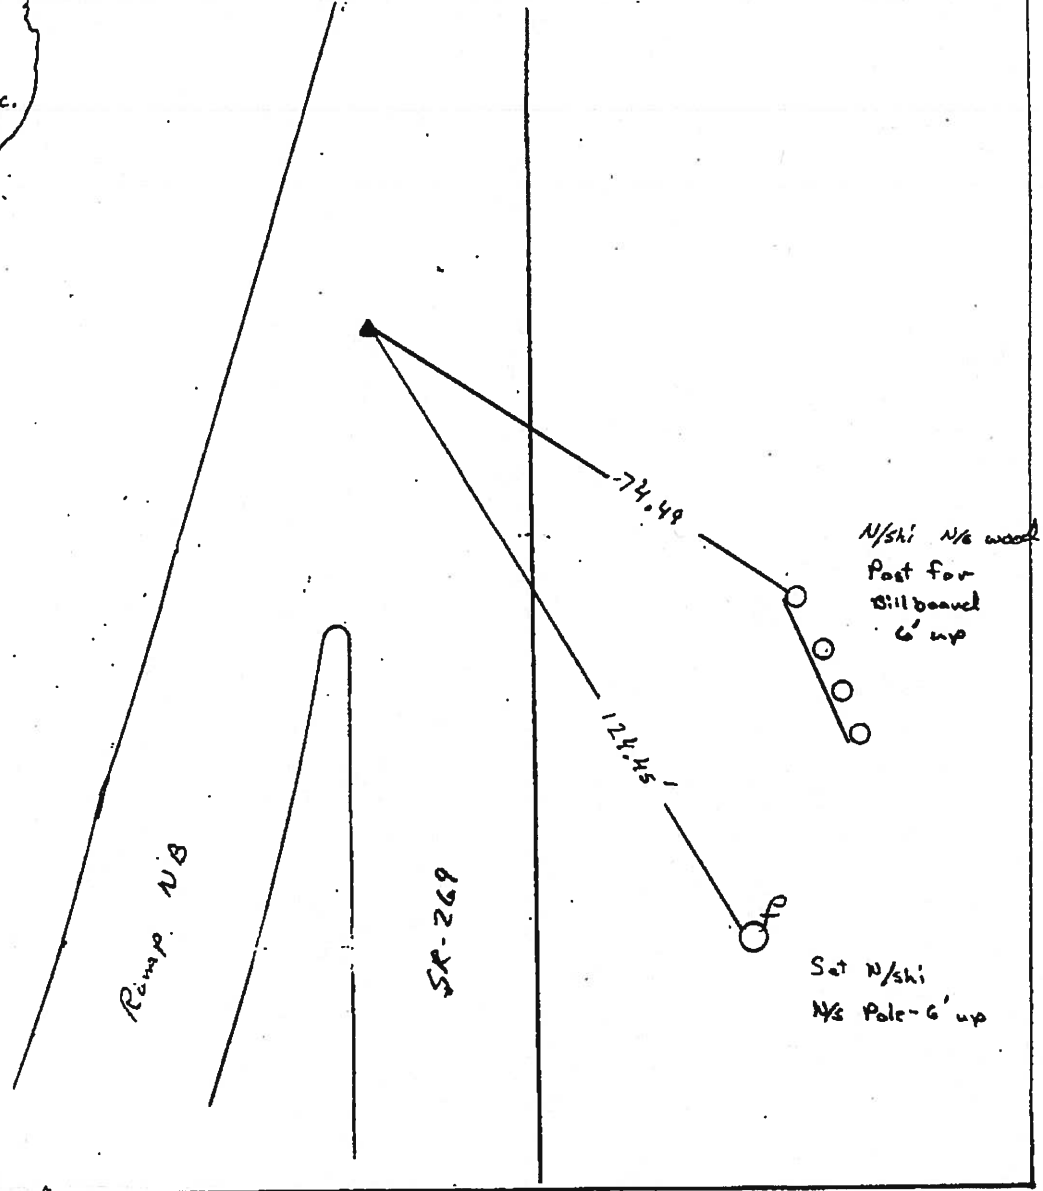

Q.D.O.T. DISTRICT 2 SURVEY OFFICE

SHEET 4 OF

County Ottawa S.R. # 269

Date 8/29/84

Township Darbury

Weather sunny - windy

Section _____

Temp. 82°

T.N, R.E


Personnel Cronin

Ripple

Geyman


Barbour

6

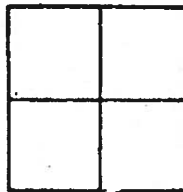

P.I.
29+0.58
set PK & waster atop
+ in conc.

set post spike
in conc. isl.

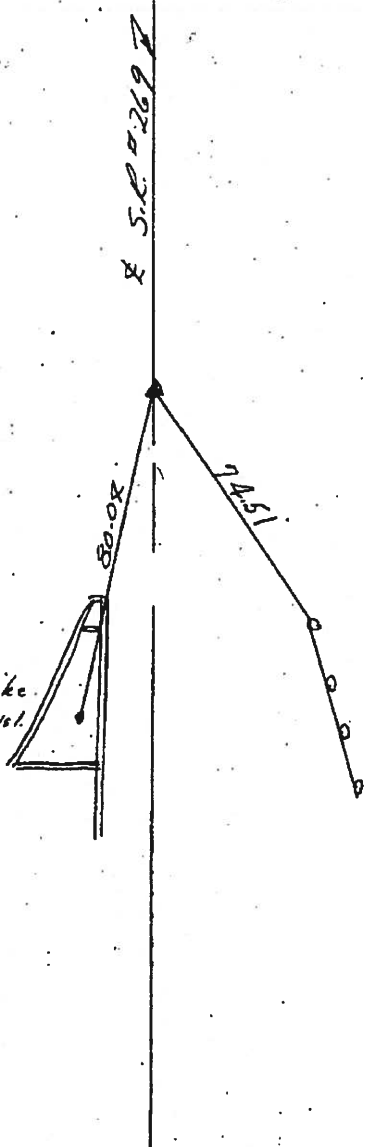

PERSONNEL TITLE PERSONNEL TITLE

COUNTY Ottawa DATE 6-21-71

S. R. 269 WEATHER Hot

SEC. _____ TEMP. 80°

DESCRIPTION Old S.R. 240 LEFT CENTER LINE RIGHT JOB NO. _____

