

O.D.O.T. DISTRICT 2 SURVEY OFFICE (USE ONLY)

PERSONNEL _____ REFERENCE NO. 2 SHEET 3 OF 27

NOTES HOMAN DATE 9/25/12 ROUTE SR 357

H.C. HOMAN WEATHER PTLY CLOUDY COUNTY OTTAWA

R.C. ROUSOS TEMP. 53° SOUTH BASS ISLAND

DWG BY RHOADES PID 25525

TYPE MONUMENT P.K.NAIL

ON SURFACE - ~~BELOW~~ ON _____

OFFSET ϕ PAVEMENT 4.6' ~~LT~~ : RT

5.0' TO RT EDGE PAVEMENT


STATION: 78+30.86

HORZ.DATUM: NAD 1983 GEOID: 2003

GRID: NORTHING: 725293.120 EASTING: 1884190.131



RECORD:
FD P.K.NAIL
RSV134
9/20/07, RGN
POINT RECOVERED
RSV134
9/25/12
SET MAG/WASHER
11/25/12, DCH

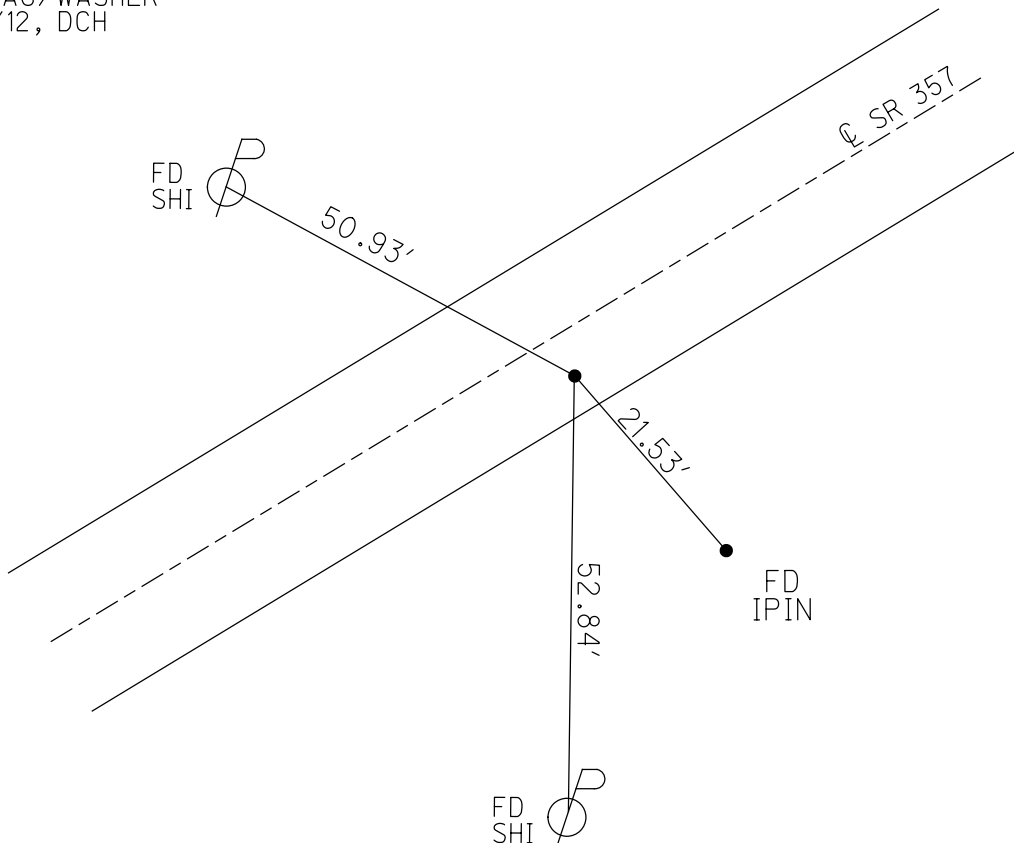

O.D.O.T. DISTRICT 2 SURVEY OFFICE

PERSONNEL _____

REFERENCE NO. _____

SHEET _____ OF _____

NOTES Huss

H.C. R. van

R.C. Huss

DATE 9-20-07

WEATHER _____

TEMP _____

ROUTE 357

COUNTY _____

TOWNSHIP _____

SECTION _____

T. _____ R. _____


TYPE MONUMENT _____ PK

ON SURFACE - BELOW Surf

LEFT - ☉ PAV'T. (RIGHT) 4.6'

S.D TO RT EDGE PAVEMENT

S.L.M. _____

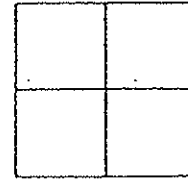

RSU 134 - GPS

