

O.D.O.T. DISTRICT 2 SURVEY OFFICE (USE ONLY)

PERSONNEL _____ REFERENCE NO. 6 SHEET 9 OF 27
 NOTES HOMAN DATE 9/25/12 ROUTE SR 357
 H.C. HOMAN WEATHER PTLY CLOUDY COUNTY OTTAWA
 R.C. ROUSOS TEMP. 53° SOUTH BASS
 _____ ISLAND

DWG BY RHOADES PID 25525

TYPE MONUMENT P.K.NAIL

ON SURFACE - ~~BELOW~~ ON _____


OFFSET \odot PAVEMENT 1.0' ~~RT~~ : RT

8.0' TO RT EDGE PAVEMENT


STATION: 87+27.68

HORIZ.DATUM: NAD 1983 GEOID: 2003

GRID: NORTHING: 725670.387 EASTING: 1885001.965

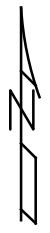

RECORD:
 FD P.K.NAIL
 RSV145
 9/20/07, RGN
 POINT RECOVERED
 RSV145
 9/25/12
 SET MAG/WASHER
 11/25/12, DCH

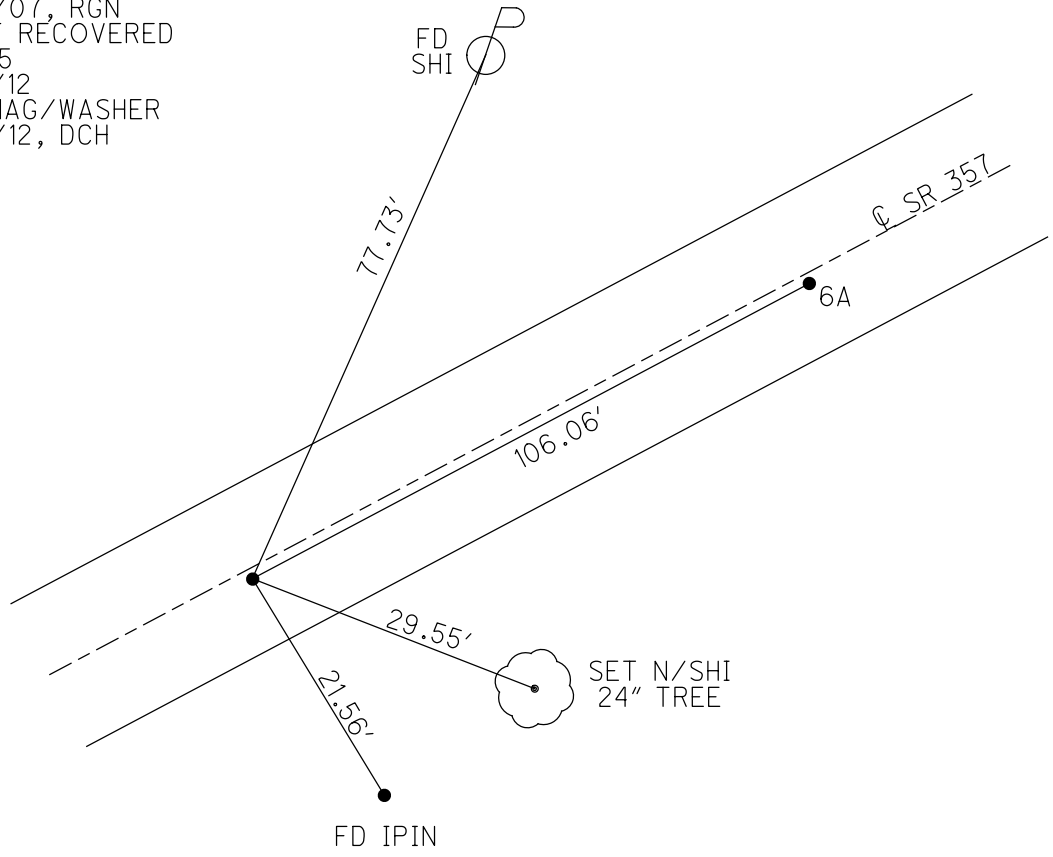

O.D.O.T. DISTRICT 2 SURVEY OFFICE

PERSONNEL

REFERENCE NO. _____

SHEET _____ OF _____

NOTES Huss

H.C. Ryan

R.C. Huss

DATE 9-20-07

WEATHER _____

TEMP. _____

ROUTE 357

COUNTY OH

TOWNSHIP _____

SECTION _____

T _____ R _____

A- PK

B- PK

TYPE MONUMENT _____

ON SURFACE - BELOW Surf

LEFT - PAV'T. - RIGHT A - 1.0 RT

B - 3.5 TO RT EDGE PAVEMENT

S.L.M. _____

