


O.D.O.T. DISTRICT 2 SURVEY OFFICE (USE ONLY)

PERSONNEL _____	REFERENCE NO. <u>8 B</u>	SHEET <u>15</u> OF <u>27</u>
NOTES <u>HOMAN</u>	DATE <u>11/25/12</u>	ROUTE <u>SR 357</u>
H.C. <u>HOMAN</u>	WEATHER <u>PTLY CLOUDY</u>	COUNTY <u>OTTAWA</u>
R.C. <u>ROUSOS</u>	TEMP. <u>53°</u>	<u>SOUTH BASS ISLAND</u>


DWG BY RHOADES PID 25525

TYPE MONUMENT MAG NAIL
 ON SURFACE - ~~BELOW~~ ON
 OFFSET C PAVEMENT 1.2' LT : ~~RT~~
9.5' TO RT EDGE PAVEMENT
 STATION: 99+43.88

HORZ. DATUM: NAD 1983 GEOID: 2003
 GRID: NORTHING: 726503.063 EASTING: 1885870.598

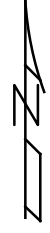

RECORD:
 FD MAG NAIL
 RSV104
 9/20/07, RGN
 POINT RECOVERED
 RSV104
 9/25/12
 SET MAG/WASHER
 11/25/12, DCH

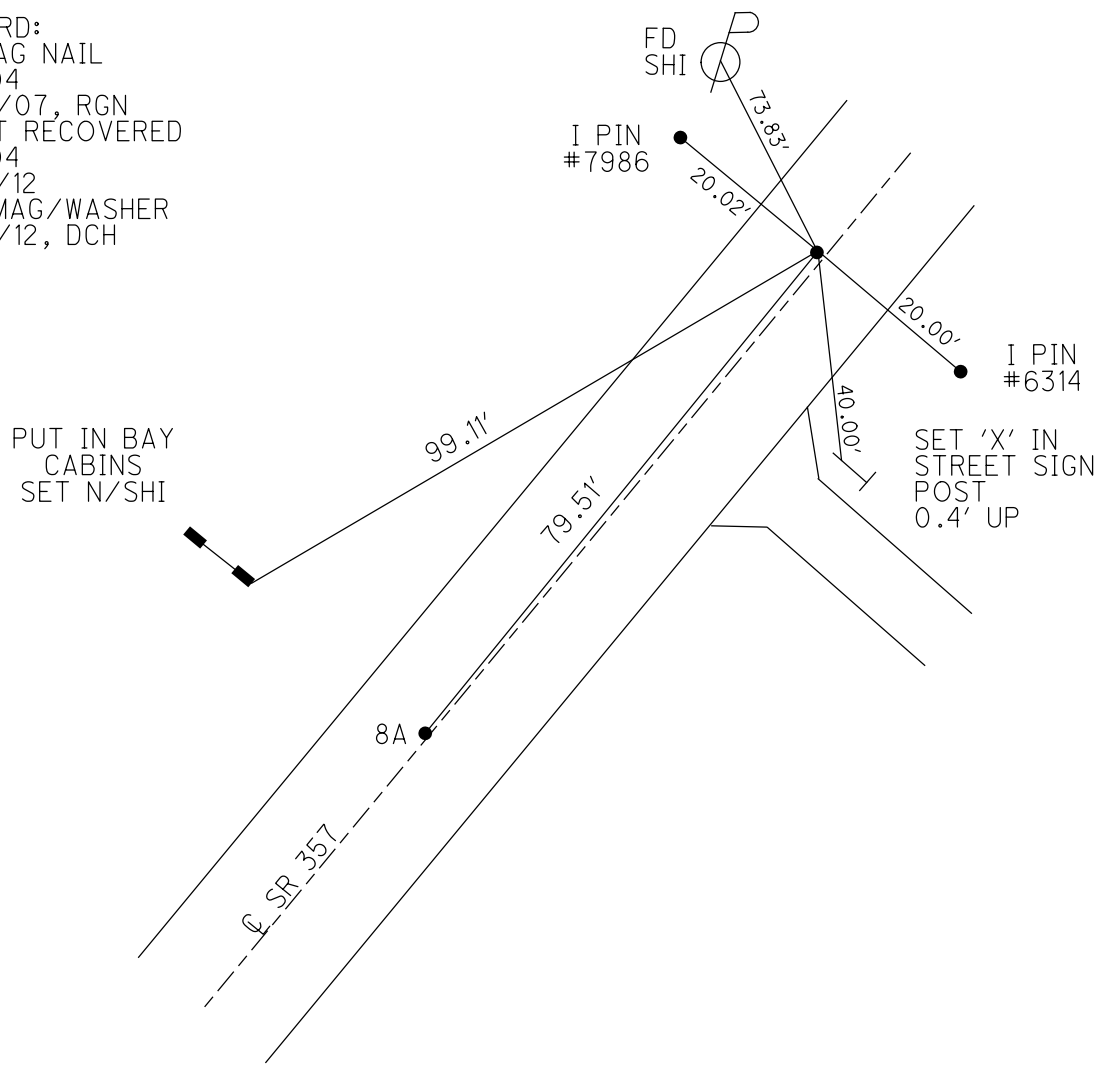

O.D.O.T. DISTRICT 2 SURVEY OFFICE

PERSONNEL

REFERENCE NO. _____

SHEET _____ OF _____

NOTES Huss

H.C. Ryan

R.C. Huss

DATE 9-20-07

WEATHER Pt Cldy - Fair

TEMP. _____

ROUTE 357

COUNTY OH

TOWNSHIP _____

SECTION _____

T _____ R _____


TYPE MONUMENT A - PK
B - ~~Mag~~ Mag C - ~~Mag~~ Mag

ON SURFACE - BELOW Surf

LEFT - & PAV'T. - RIGHT A = 0.6' Rt. B = 0.7' Lt. C = 1.2' Lt.

A = 8.2 TO Rt EDGE PAVEMENT B = 9.3' Rt. C = 9.5 Rt.

S.L.M. _____

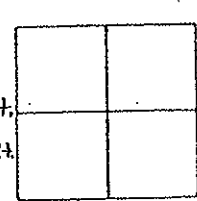


A R SU 1374

B R SU 103

C R SU 104

C-A-3103
and Not Shoot

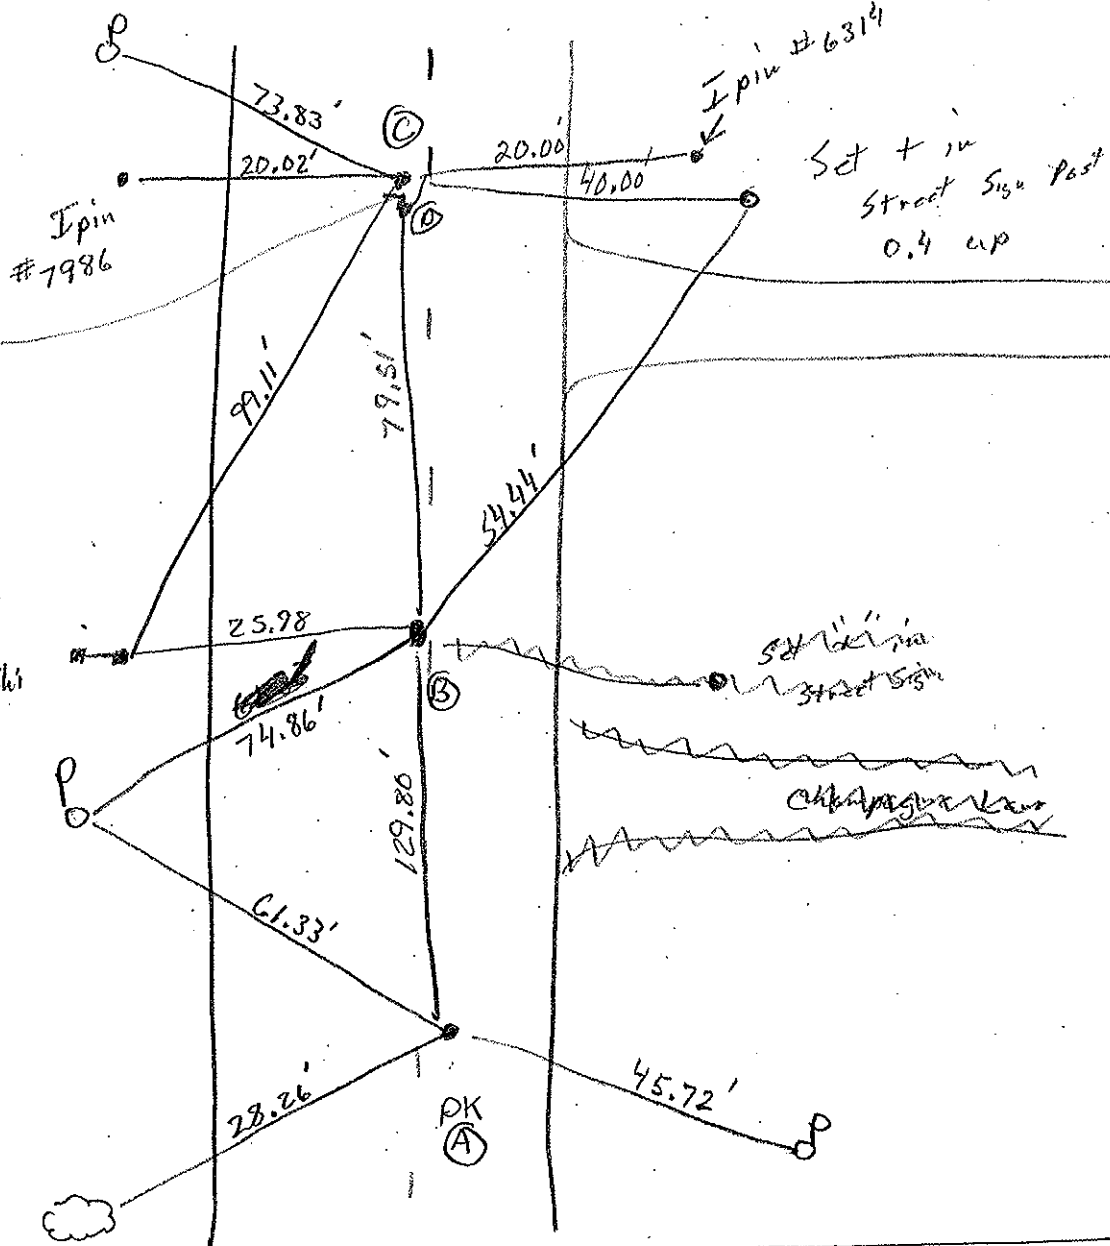

Put-In-Box
Cabins
Set N/S

Set in
Street Sign

Set
N/S
10" tree