

O.D.O.T. DISTRICT 2 SURVEY OFFICE (USE ONLY)

PERSONNEL

REFERENCE NO. 14

SHEET 23 OF 27

NOTES HOMAN

DATE 11/25/12

ROUTE SR 357

H.C. HOMAN

WEATHER PTLY CLOUDY

COUNTY OTTAWA

R.C. ROUSOS

TEMP. 53°

SOUTH BASS
ISLAND

DWG BY RHOADES PID 25525

TYPE MONUMENT MINI MAG NAIL

ON SURFACE - ~~BELOW~~ ON

OFFSET 0.9' RT : RT

7.0' TO RT EDGE PAVEMENT


STATION: 119+68.85

HORZ.DATUM: NAD 1983

GEOID: 2003

GRID: NORTHING: 726015.865

EASTING: 1887222.893

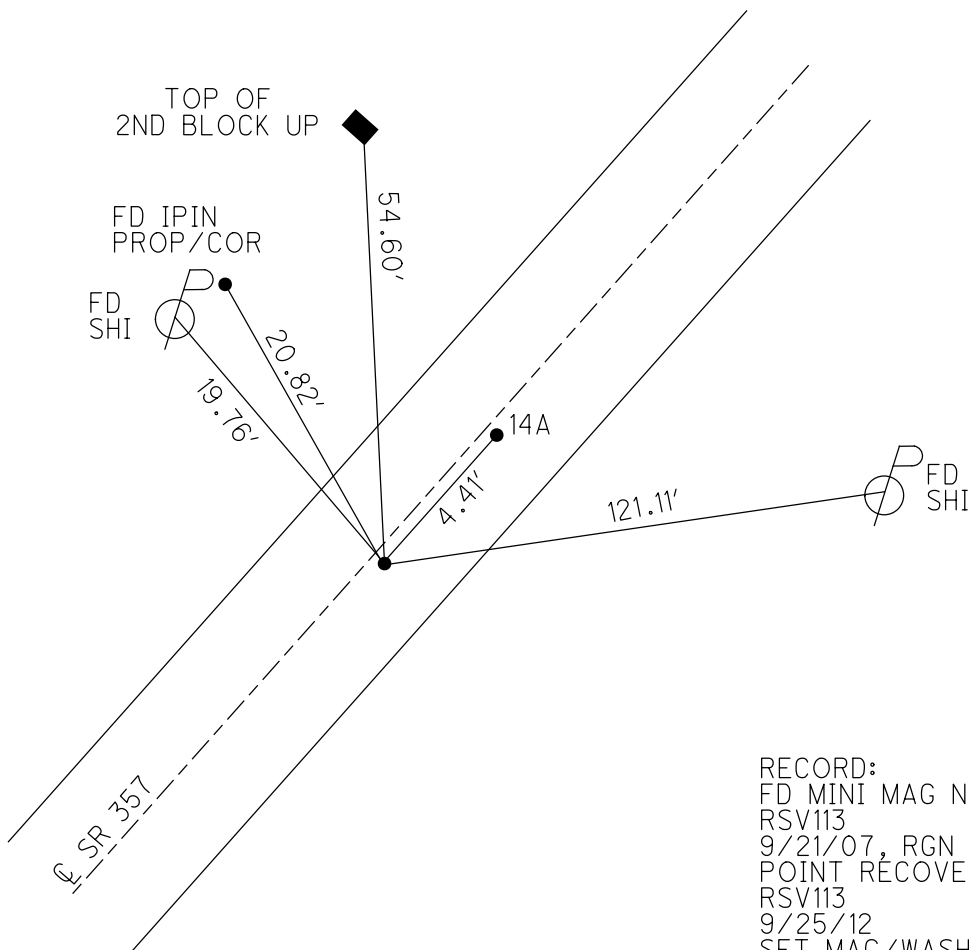

RECORD:
 FD MINI MAG NAIL
 RSV113
 9/21/07, RGN
 POINT RECOVERED
 RSV113
 9/25/12
 SET MAG/WASHER
 11/25/12, DCH

O.D.O.T. DISTRICT 2 SURVEY OFFICE

PERSONNEL _____

REFERENCE NO. _____

SHEET _____ OF _____

NOTES Huss

H.C. Ryan

R.C. Huss

DATE 9-21-07

WEATHER Clear - Fair

TEMP. +84°F

ROUTE SR 357

COUNTY OH

TOWNSHIP _____

SECTION _____

T _____ R _____


TYPE MONUMENT (A) Mini Mag (B) Mag

ON SURFACE - BELOW (A) Surf (B) Surf

LEFT - CL PAV'T. - (RIGHT) (A) 0.9 Rt (B) 0.9 Rt


7.0 TO RT EDGE PAVEMENT (B) 7.0' Rt

S.L.M. _____

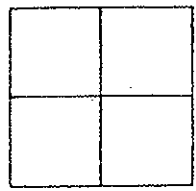

$A - B = 4.41'$

Top of
2nd block
up

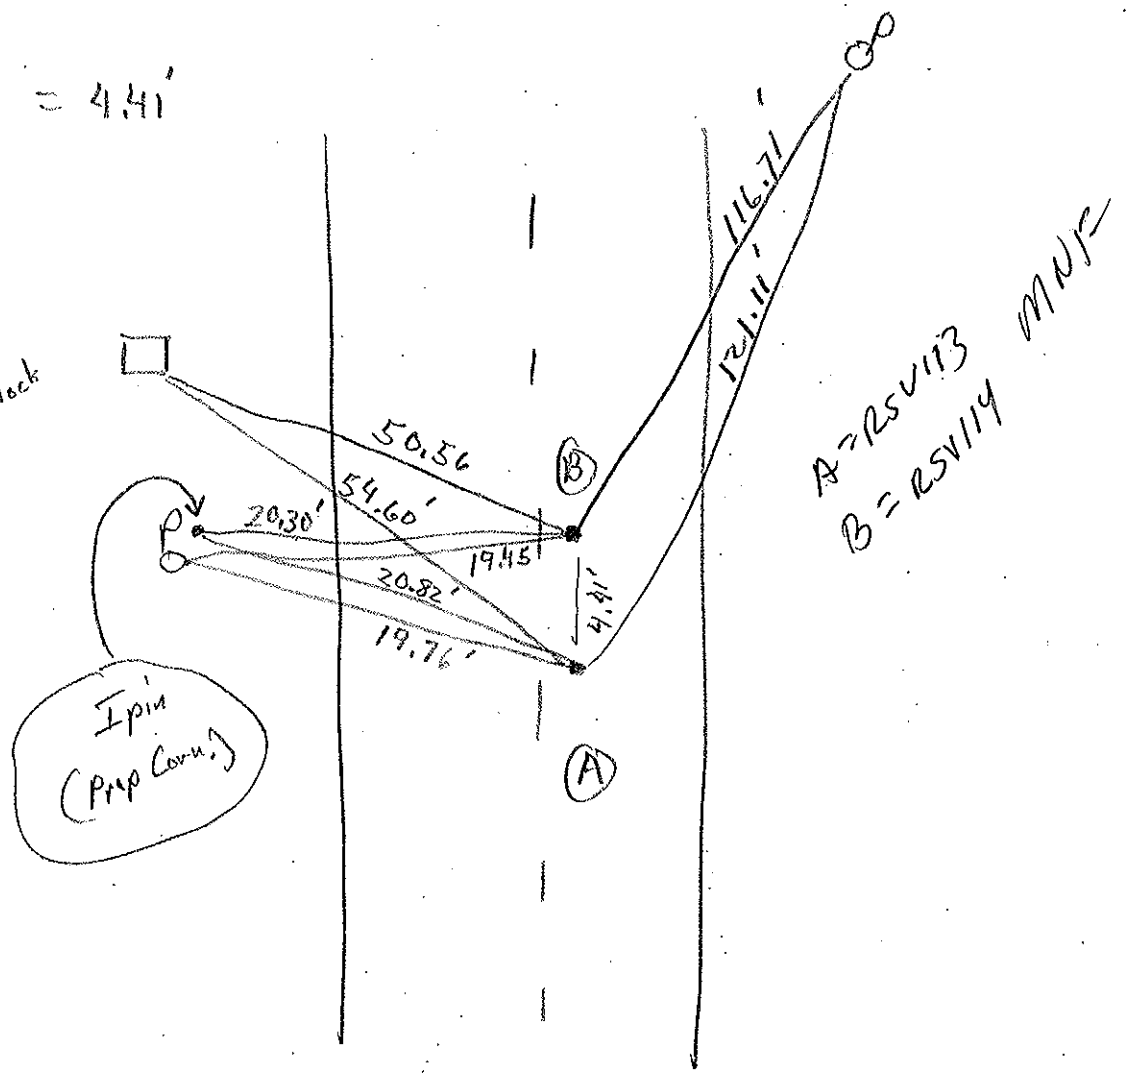

A = 25V113
B = 25V114 MNP