

O.D.O.T. DISTRICT 2 SURVEY OFFICE (USE ONLY)

PERSONNEL

REFERENCE NO. 13

SHEET 10 OF 30

NOTES HUSS DATE 1/27/06
 H.C. NUHFER WEATHER CLEAR
 R.C. RYAN H. TEMP. 31°

ROUTE SR 590
 COUNTY OTTAWA
 TOWNSHIP HARRIS
 SECTION 10
 T 6 N R 14 E

DWG BY _____ PID PAVE TRAIN

TYPE MONUMENT P.K./WASHER


ON SURFACE - ~~BELOW~~ ON _____

OFFSET \odot PAVEMENT 9.28' LT : ~~RT~~
 - TO - EDGE PAVEMENT

STATION: 129+37.3


HORZ.DATUM: NAD83 2001 GEOID: 2012A

GRID: NORTHING: 666370.765 EASTING: 1770718.274

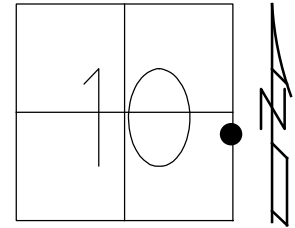

RECORD:
 FD P.K./WASHER
 1/27/06
 12/01/06, RGN
 SVA88
 8/04/08
 FD MAG/WASHER
 7-31-20, DSA

NOTE: REF88 SR105

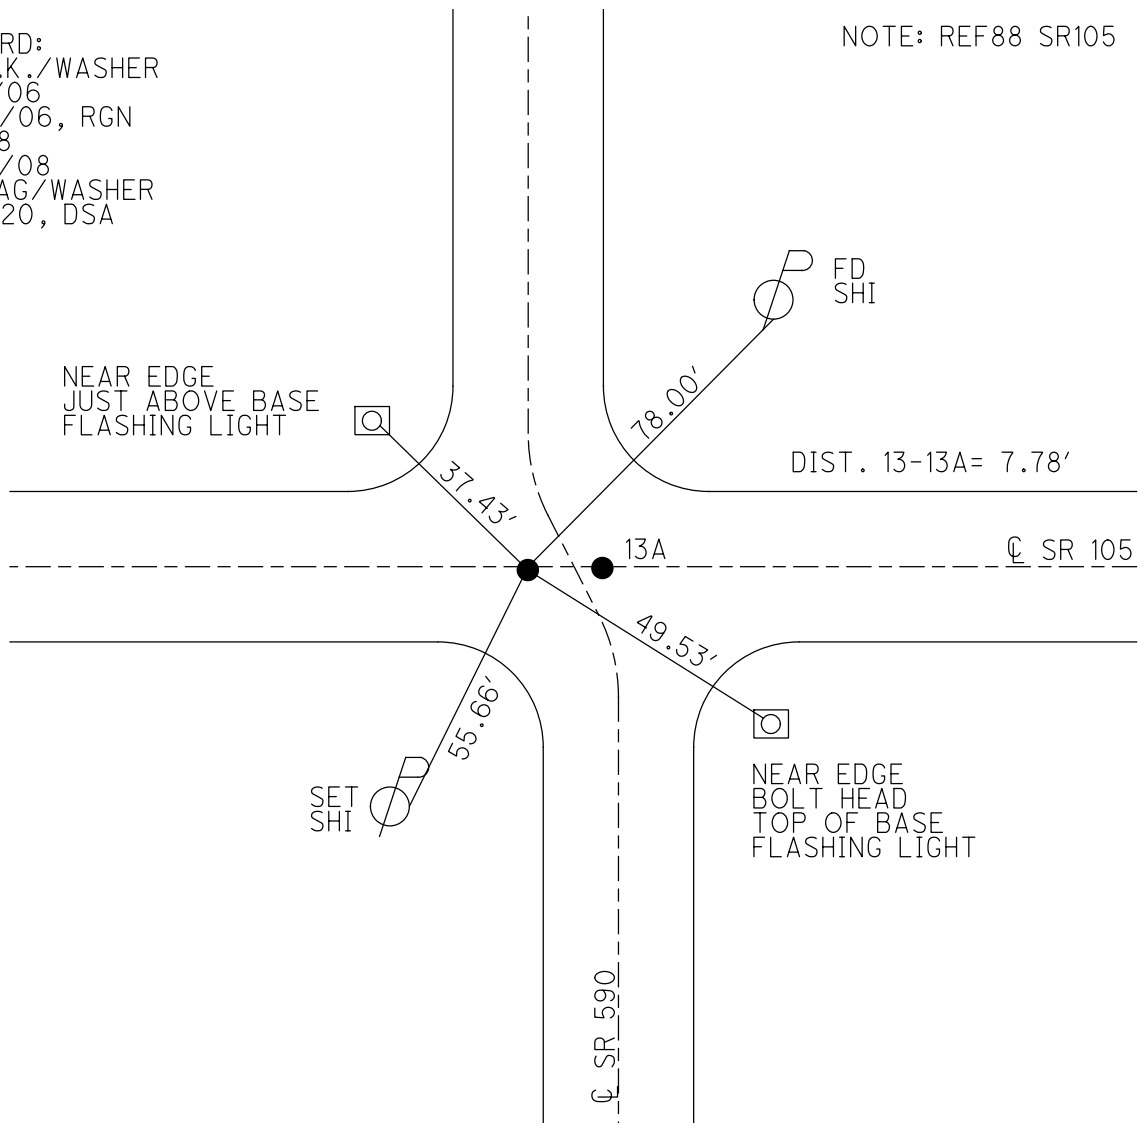

O.D.O.T. DISTRICT 2 SURVEY OFFICE (Use Only)

SR-105-88A

PERSONNEL _____

REFERENCE NO. 13

SHEET _____ OF _____

NOTES HUSS

DATE 01/27/06

ROUTE S.R. 590

H.C. RYAN N

WEATHER CLEAR/COLD

COUNTY OTTAWA

R.C. RYAN H

TEMP. +31 F.

TOWNSHIP HARRIS

SECTION 10 & 11

T 6 N R 14 E

TYPE MONUMENT P.K./WASHER@ BOTH

~~ON SURFACE~~ - BELOW SURFACE



~~LEFT - C PAV'T - RIGHT~~ A= 9.28' LT, B= 1.5' LT

TO EDGE PAVEMENT

S.L.M. 129+37.30


GRID: Northing: 666370.746 Easting: 1770718.231- PT "A"

GRID: Northing: 666372.293 Easting: 1770725.868-PT "B"

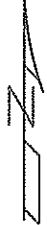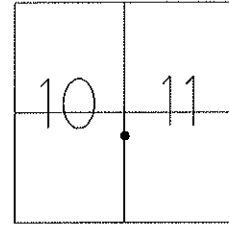

GPS POINTS
SVA-88, SVB-88
08-04-08

FD.- PK/W. BOTH POINTS
12-01-06
RGN

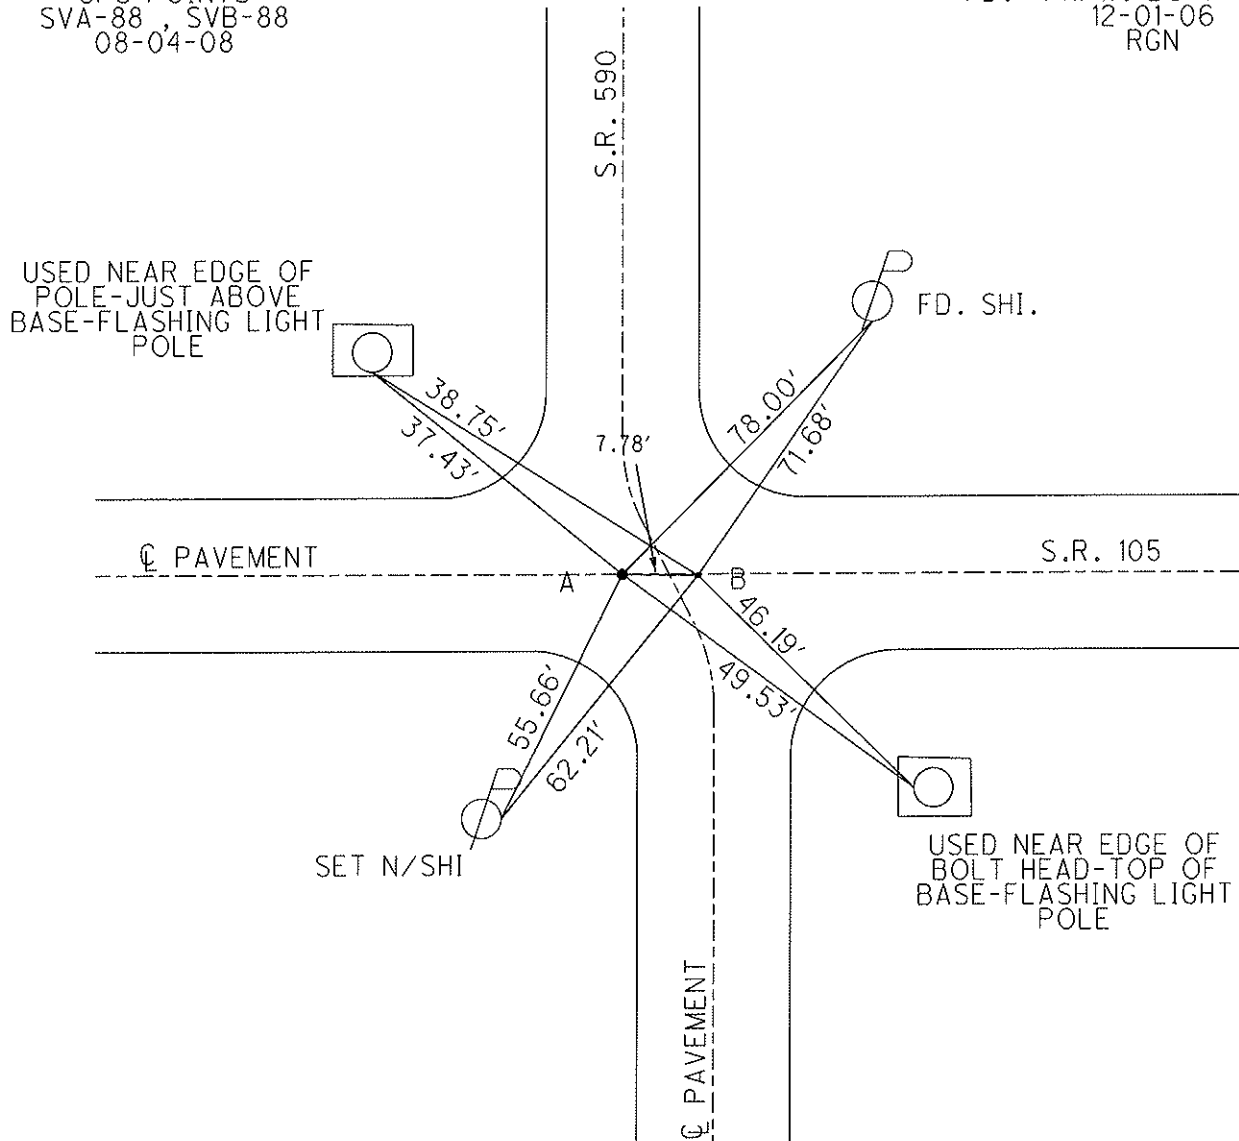

O.D.O.T. DISTRICT 2 SURVEY OFFICE

PERSONNEL

REFERENCE NO. 88-A SHEET OF
 #13 SR590

NOTES K. MOSER

H.C. M. CANTERBURY

DATE 4-21-00

ROUTE S.R. 105

R.C. M. BARNHSEL

WEATHER CLOUDY

COUNTY OTTAWA

TEMP. 46.0°F

TOWNSHIP HARRIS

SECTION 11

T6 N R 14 E


TYPE MONUMENT PK / WASHERS

ON SURFACE - ~~BELOW~~ SURFACE


~~TO~~ - PAV'T. - ~~RIGHT~~ A & B CE PAV'T

TO - EDGE PAVEMENT

S.L.M. A = 366 + 83 B = 366 + 91

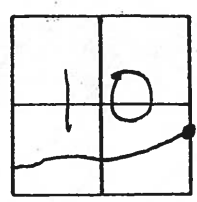

RESET PK/WASHERS
6-14-00
KPM

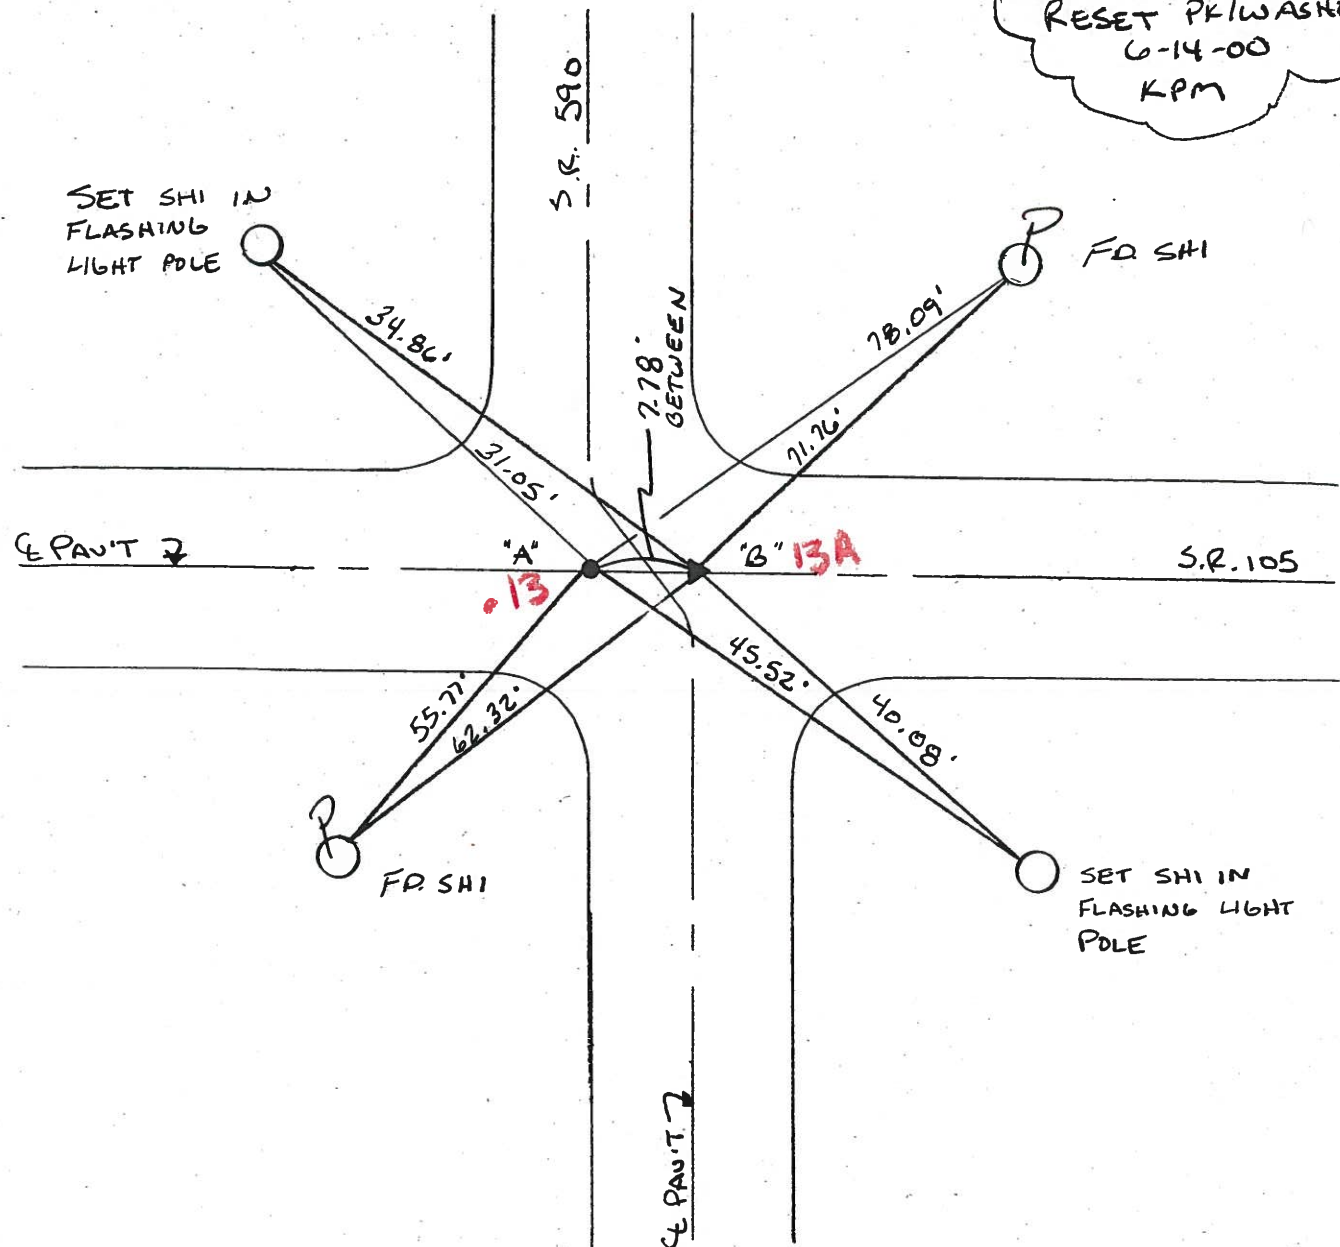

O.D.O.T. DISTRICT 2 SURVEY OFFICE

PERSONNEL

REFERENCE NO. 13

SHEET 9 OF 12

NOTES Schneider

H.C. Mosser

R.C. BARBOUR

Geyman

VINSON

DATE 7/26/71

WEATHER Cloudy

TEMP. 72°

ROUTE SR# 590

COUNTY OTTAWA

TOWNSHIP HARRIS

SECTION 10 & 11

T 6 N R 14 E



TYPE MONUMENT Two R.R. Spks.

ON SURFACE - BELOW _____

LEFT - & PAV'T. - RIGHT _____

_____ TO _____ EDGE PAVEMENT



S.L.M. 129+37.30

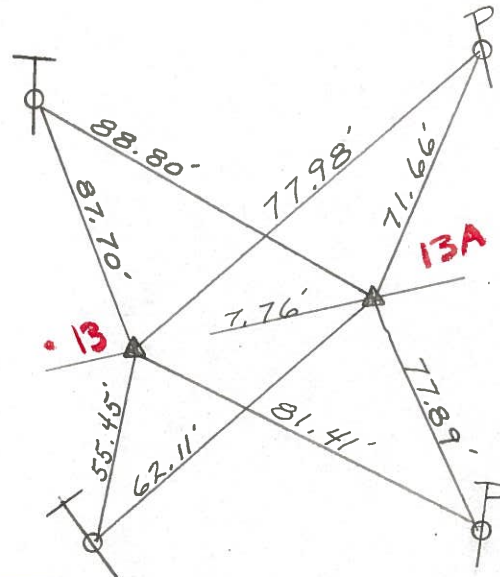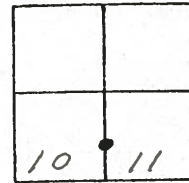

SR# 105
EAST

Check OLD TIES AT START
of this section & BRIDGE PLAN
R/rd PLAN.

PERSONNEL	TITLE	PERSONNEL	TITLE
_____	_____	_____	_____
COUNTY <u>Ottawa</u> DATE <u>7-26-71</u>			
S. R. <u>590</u> WEATHER <u>cloudy</u>			
SEC. <u>10 & 11</u> TEMP. <u>72°</u>			
DESCRIPTION <u>Sandusky Co. Line North Harris Twp.</u> JOB NO. _____			

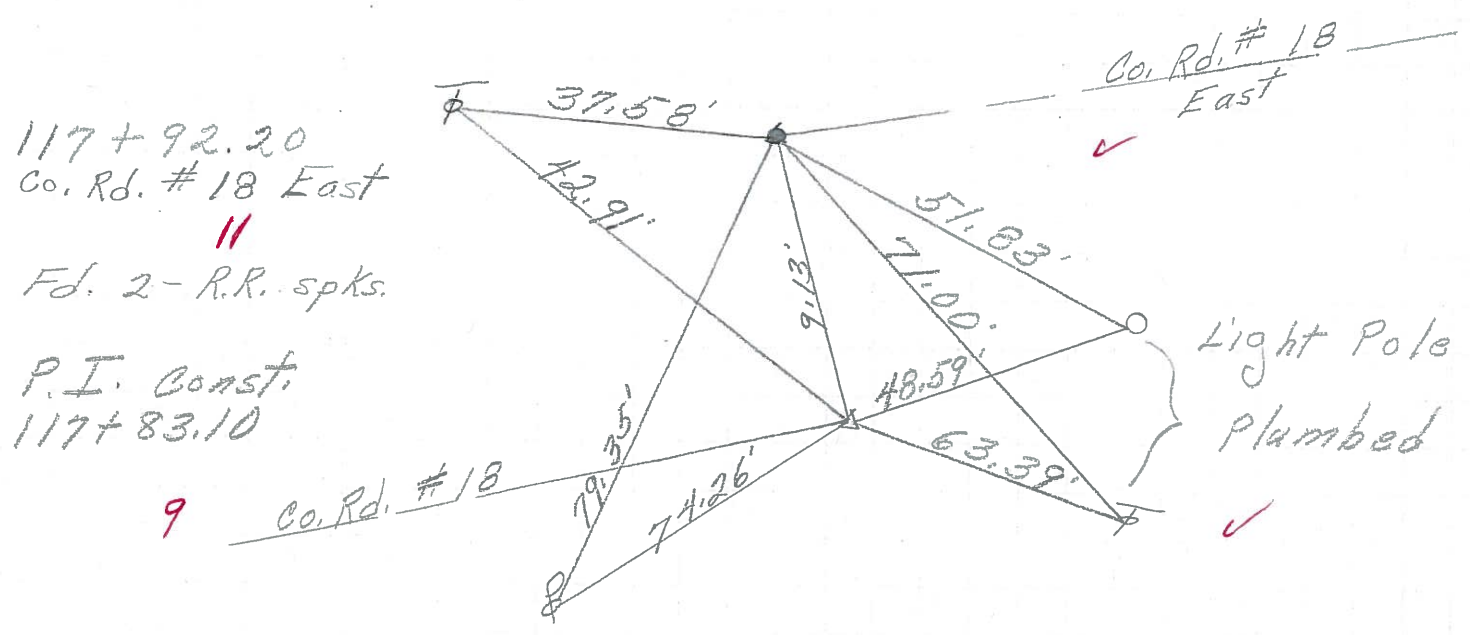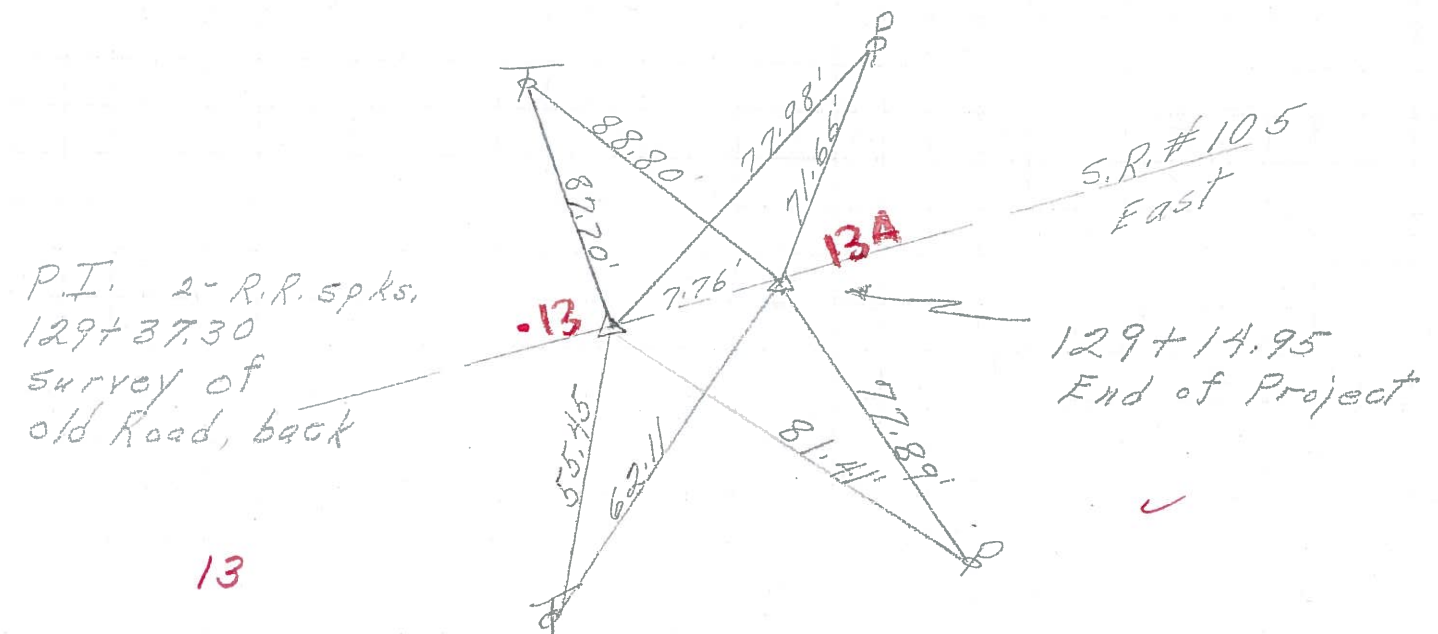

PERSONNEL	TITLE	PERSONNEL	TITLE
Schneider		Potts	
Mosser			
Barbour			
Redding			

COUNTY Ottawa DATE 4-9-68
 S. R. 590 WEATHER cloudy-windy
 SEC. San. Co. Line North TEMP. 60°

DESCRIPTION Ties for Control Points JOB NO. _____

