

O.D.O.T. DISTRICT 2 SURVEY OFFICE (USE ONLY)

PERSONNEL

REFERENCE NO. 20

SHEET 20 OF 30

NOTES BARRIERE
H.C. MILLER
R.C. BLUBAUGH

DATE 8/21/24
WEATHER SUNNY
TEMP. 63°

ROUTE SR 590
COUNTY OTTAWA
TOWNSHIP BENTON
SECTION 27
T 7 N R 14 E

DWG BY BARRIERE PID 107604

TYPE MONUMENT MAG NAIL/WASHER

ON SURFACE - BELOW ON

OFFSET Q PAVEMENT 5.5' LT LT : RT

TO EDGE PAVEMENT

STATION: 293+09

HORIZ.DATUM: NAD83 (2011)


GEOID: 18

GRID: NORTHING: 682729.766


EASTING: 1770859.048

LDP: NORTHING: 342048.701

EASTING: 130567.954

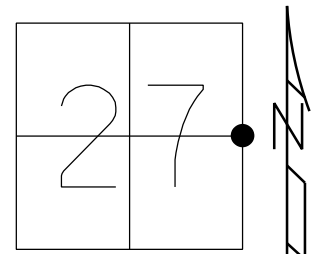

RECORD:
FD P.K./WASHER
1/30/06, MC
SV-120
8-13-08, MC
SET MAG/WASHER
6-9-09, SAH
FD MAG/WASHER
REF20
2-26-18, 4-23-18
10-4-18, JFO
FD MAG/WASHER
REF20
4/10/23, TDN
5/31/25, JAM

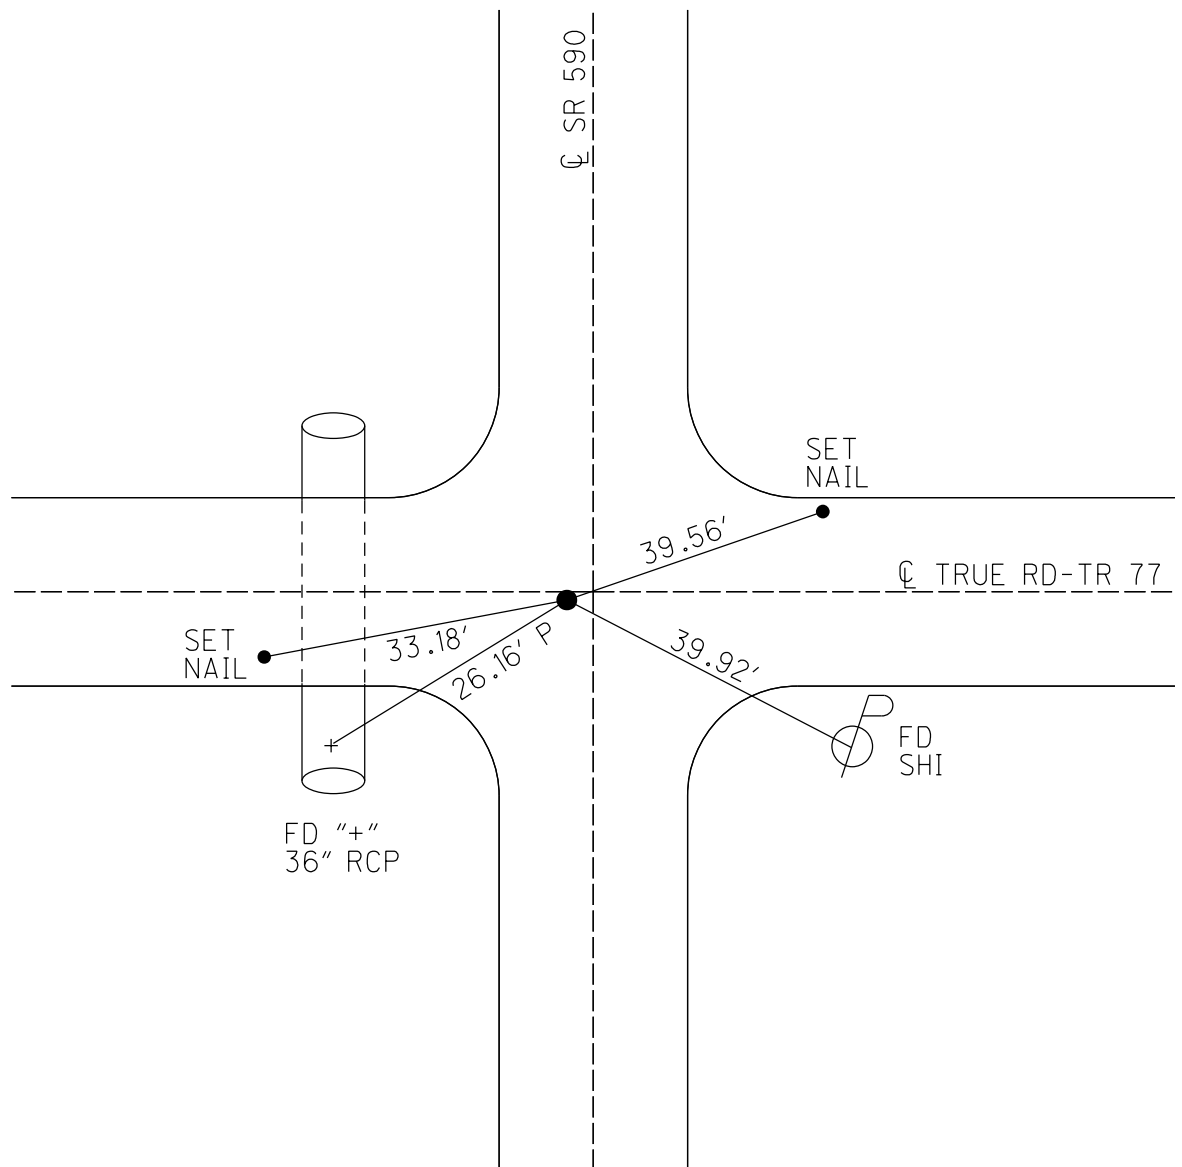

O.D.O.T. DISTRICT 2 SURVEY OFFICE (USE ONLY)

PERSONNEL

REFERENCE NO. 20

SHEET 20 OF 30

NOTES RHOADES

DATE 2/26/18

ROUTE SR 590

H.C. O'DONNELL

WEATHER SUNNY

COUNTY OTTAWA

R.C. RHOADES

TEMP. 41°

TOWNSHIP BENTON

SECTION 27

DWG BY MILLER

PID 101240

T 7 N R 14 E

TYPE MONUMENT MAG/WASHER

ON SURFACE - ~~BELOW~~ ON

OFFSET CL PAVEMENT 5.5' LT : ~~RT~~

- TO - EDGE PAVEMENT


STATION: 293+09

HORZ.DATUM: NAD83-2011

GEOID: NAVD88-2012A

GRID: NORTHING: 682695.807

EASTING: 1770770.941

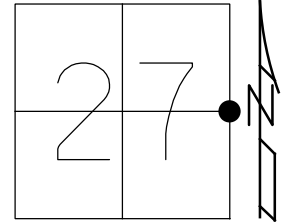

RECORD:

FD P.K./WASHER

1/30/06, MC

SV-120

8-13-08, MC

SET MAG/WASHER

6-9-09, SAH

FD MAG/WASHER

REF20


2-26-18, 4-23-18

10-4-18, JFO

FD MAG/WASHER

REF20

4/10/23, TDN

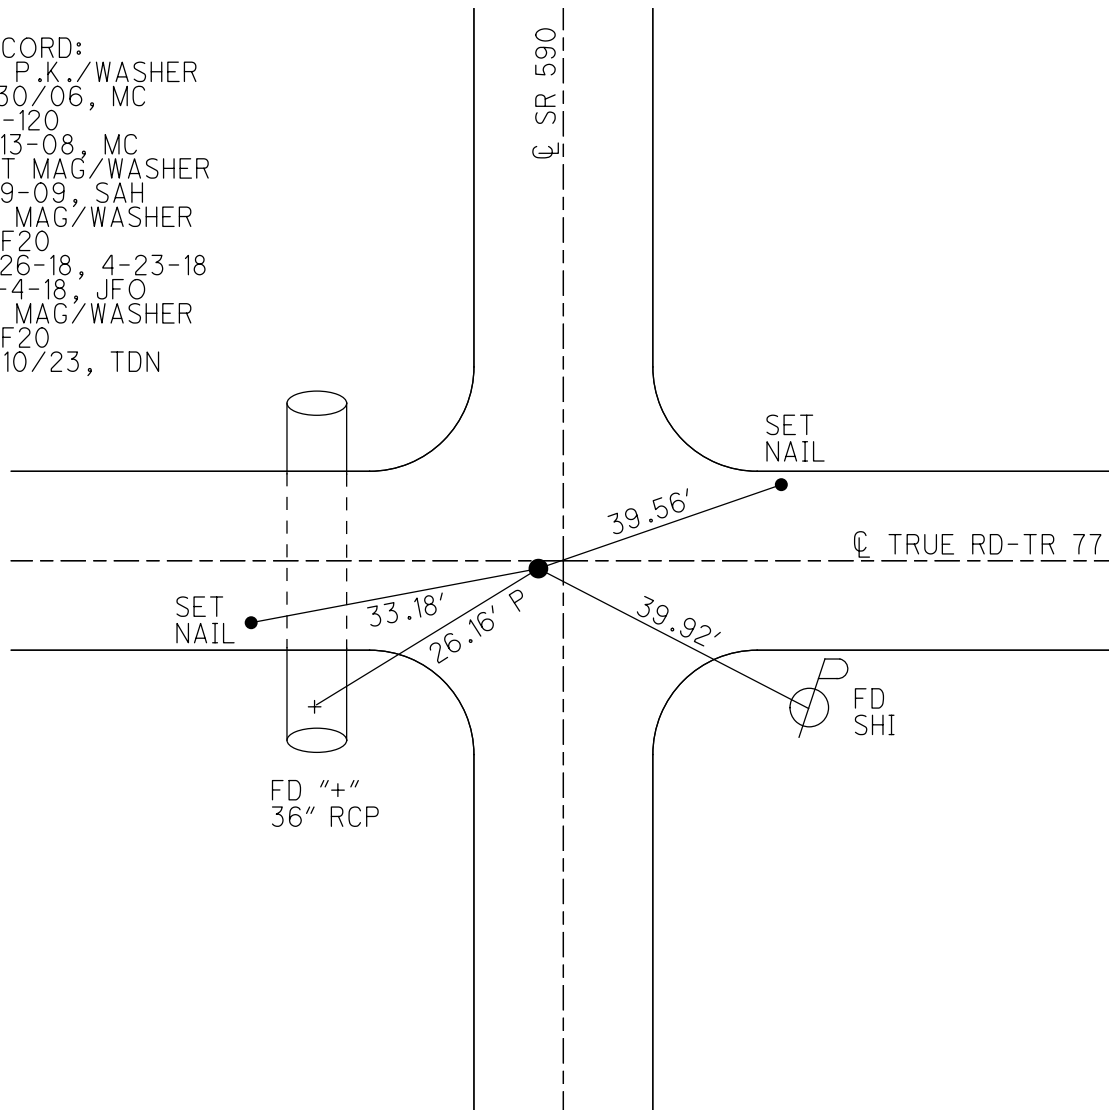

O.D.O.T. DISTRICT 2 SURVEY OFFICE (USE ONLY)

PERSONNEL

REFERENCE NO. 20

SHEET 20 OF 30

NOTES RHOADES

DATE 2/26/18

ROUTE SR 590

H.C. O'DONNELL

WEATHER SUNNY

COUNTY OTTAWA

R.C. RHOADES

TEMP. 41°

TOWNSHIP BENTON

DWG BY MILLER

PID 101240

SECTION 27

T 7 N R 14 E

TYPE MONUMENT MAG/WASHER

ON SURFACE - ~~BELOW~~ ON

OFFSET CL PAVEMENT 5.5' LT : ~~RT~~

- TO - EDGE PAVEMENT


STATION: 293+09

HORZ.DATUM: NAD83-2011


GEOID: NAVD88-2012A

GRID: NORTHING: 682695.815

EASTING: 1770770.981

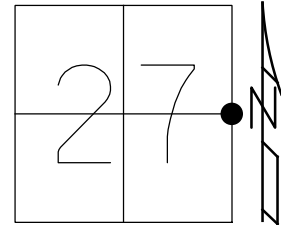

RECORD:
FD P.K./WASHER
1/30/06, MC
SV-120
8-13-08, MC
SET MAG/WASHER
6-9-09, SAH
FD MAG/WASHER
REF20
2-26-18, 4-23-18
10-4-18, JFO

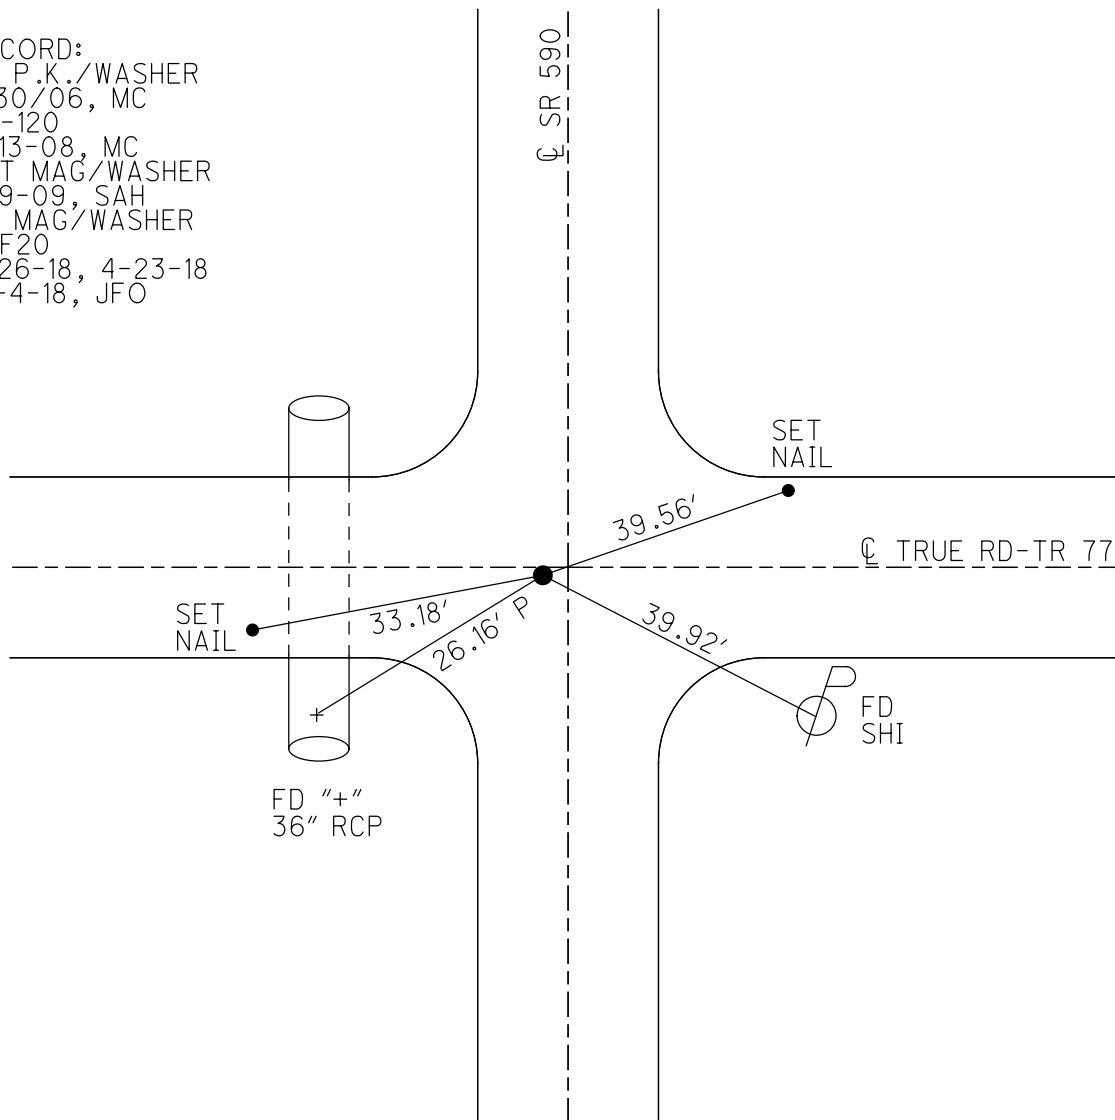

O.D.O.T. DISTRICT 2 SURVEY OFFICE (Use Only)

PERSONNEL

NOTES _____
H.C. _____
R.C. _____

REFERENCE NO. 20

DATE 1-30-06
WEATHER CLEAR/ COLD
TEMP. +40

SHEET _____ OF _____

ROUTE S.R. 590
COUNTY OTTAWA
TOWNSHIP BENTON
SECTION 26 & 27
T 7 N R 14 E



TYPE MONUMENT _____ P.K./WASHER

~~ON SURFACE~~ - ~~BELOW~~ SURFACE

LEFT - C PAV'T - ~~RIGHT~~ 5.5' LT.

TO EDGE PAVEMENT


S.L.M. 293+09

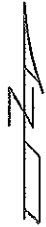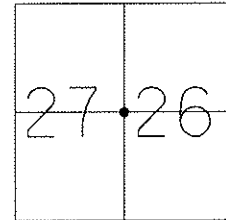

GRID: Northing: 682695.806 Easting: 1770770.928

SET MAG/W 6-9-09 SAH


SHOT GPS SV-120
08-13-08

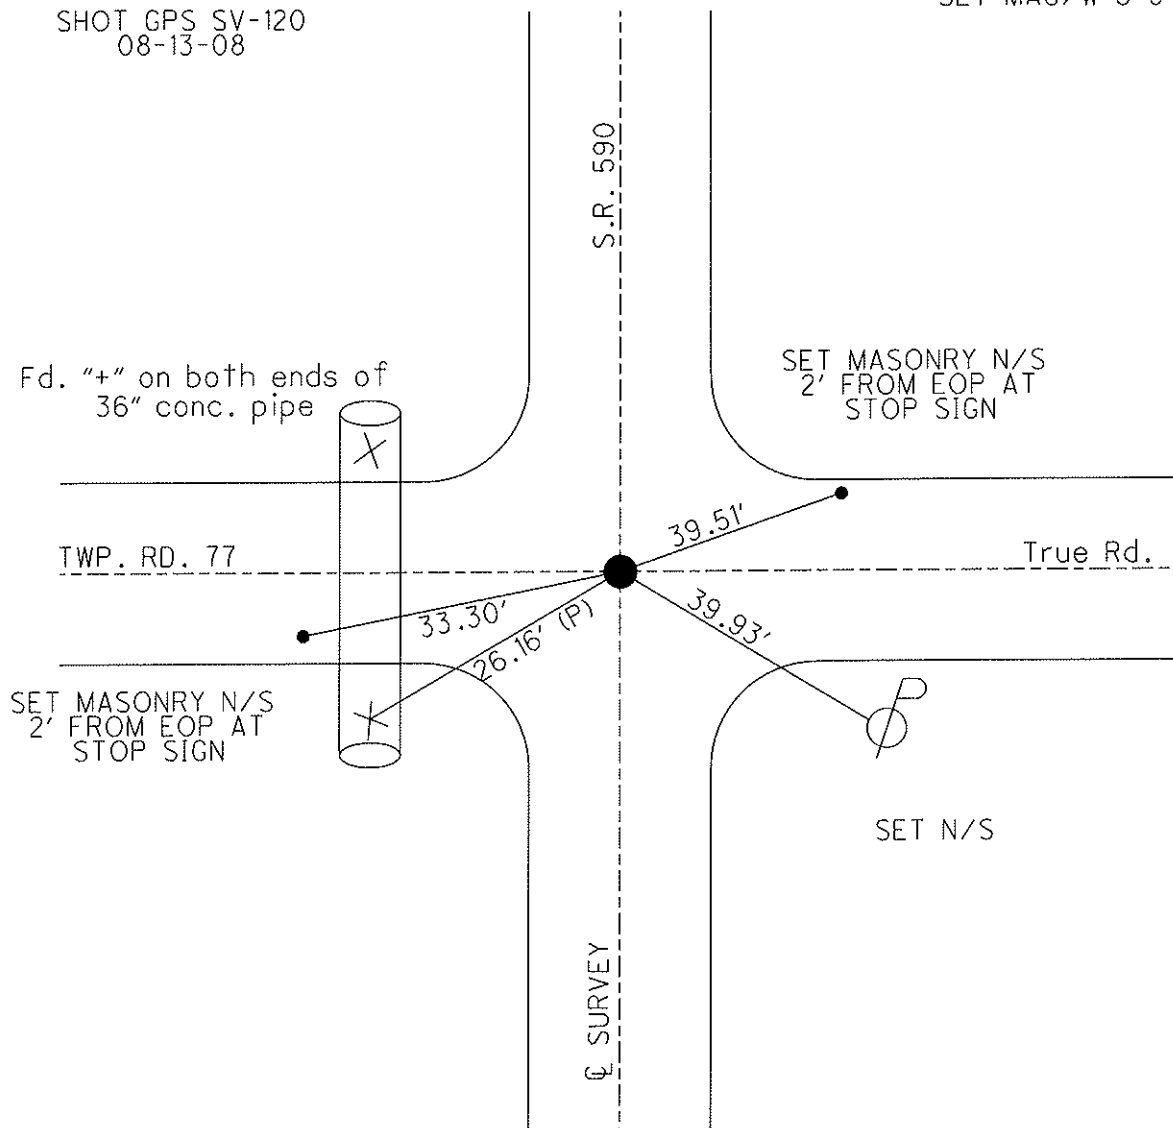


O.D.O.T. DISTRICT 2 SURVEY OFFICE (USE ONLY)

PERSONNEL	REFERENCE NO. <u>20</u>	SHEET <u>20</u> OF <u>30</u>	
NOTES	DATE <u>1/30/06</u>	ROUTE <u>SR 590</u>	
H.C. <u>HUSS</u>	WEATHER <u>CLEAR</u>	COUNTY <u>OTTAWA</u>	
R.C. <u>NUHFER</u>	TEMP. <u>40°</u>	TOWNSHIP <u>BENTON</u>	
		SECTION <u>27</u>	
		T <u>7</u> N R <u>14</u> E	

TYPE MONUMENT P.K./WASHER
~~ON SURFACE~~ - BELOW ON
 LEFT - CL PAV'T - ~~RIGHT~~ 5.5'
TO - EDGE PAVEMENT
 S.L.M. 293+09

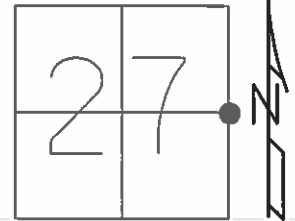

GRID: NORTHING: 682695.806 EASTING: 1770770.928

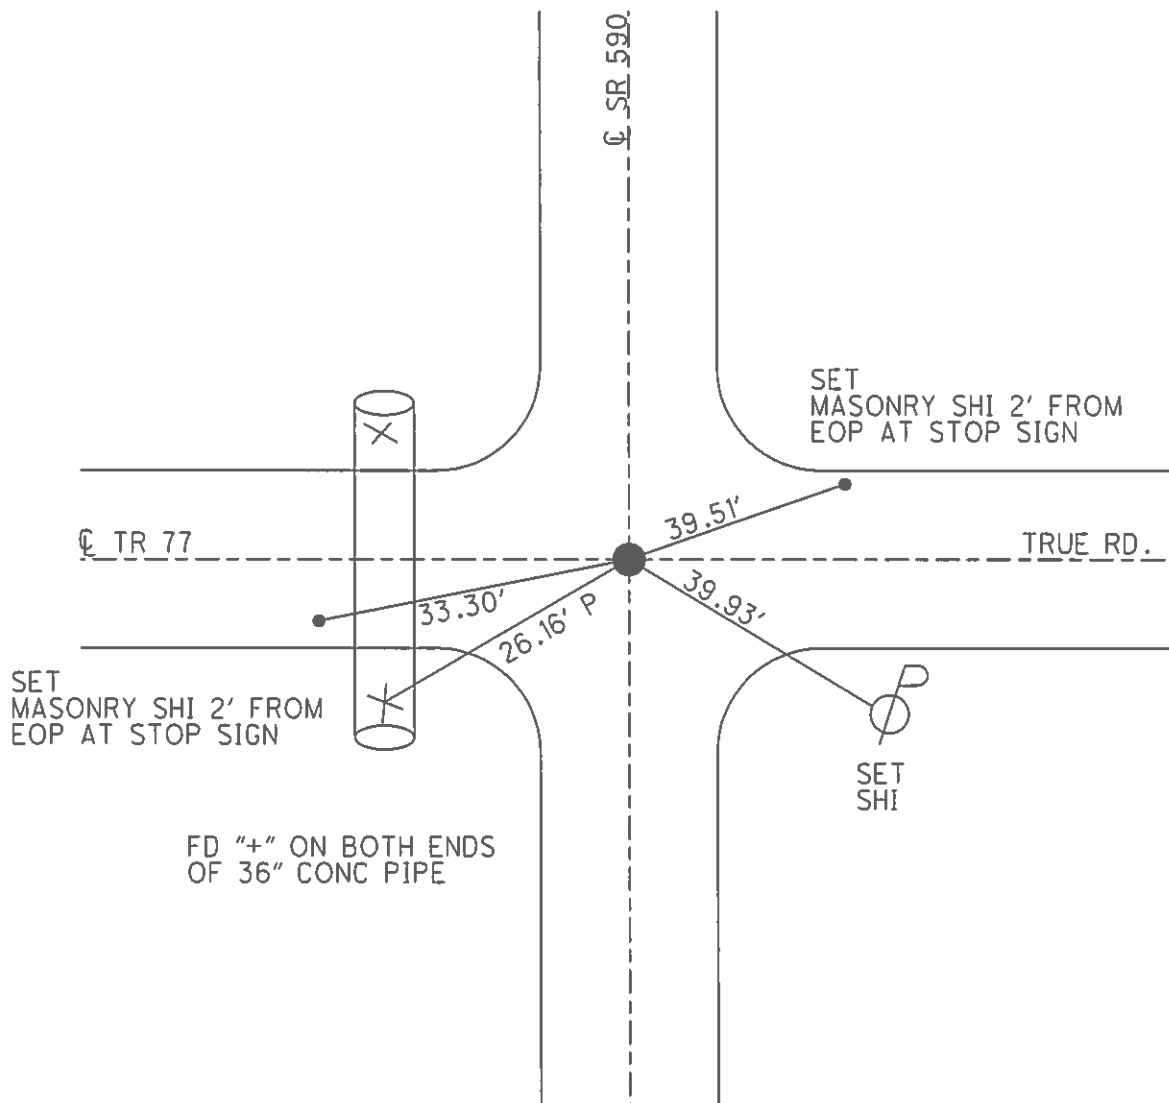

O.D.O.T. DISTRICT 2 SURVEY OFFICE

PERSONNEL

REFERENCE NO. 20 SHEET 3 OF 1

NOTES RIPPLE

H.C. BARBOUR

R.C. GEYMAN

DATE 8/06/90 DRAWN 8/08/90

WEATHER CLOUDY

TEMP. 62°

ROUTE SR #590


COUNTY OTTAWA

TOWNSHIP BENTON


SECTION E 1/4 POST #27 W 1/4 POST #26

T 7 N R 14 E

TYPE MONUMENT SET P.K. & WASHER
ON SURFACE - BELOW A TOP P.K. & WASHER
LEFT - 6' LT. & PAY. RIGHT 6' LT. & PAY.
TO EDGE PAVEMENT
S.L.M.

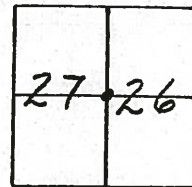

FD PK & WASHER
@ SURFACE
9-12-94

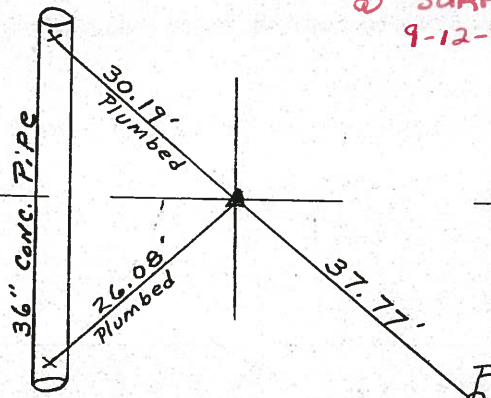

SR # 5907

O.D.O.T. DISTRICT 2 SURVEY OFFICE

PERSONNEL

REFERENCE NO. 20 SHEET 3 OF 1

NOTES Ripple

H.C. BARBOUR

R.C. GeyMAN

DATE 8/06/90 DRAWN 8/08/90

WEATHER Cloudy

TEMP. 62°

ROUTE SR #590



COUNTY OTTAWA

TOWNSHIP BENTON

SECTION E 1/4 POST #27 W 1/4 POST #26

T 7 N R 14 E

TYPE MONUMENT Set P.K. & washer
 ON SURFACE - BELOW A Top P.K. & washer
 LEFT - & PAV'T. - RIGHT 6' LT. & PAV.
 TO EDGE PAVEMENT
 S.L.M.

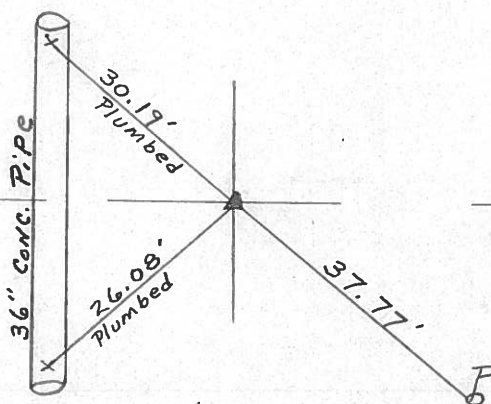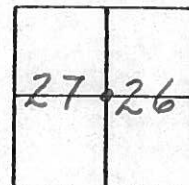

SR # 5907

O.D.O.T. DISTRICT 2 SURVEY OFFICE

SHEET

OF

County Ottawa S.R. #590

Township Benton

Section E 1/4 Post 27 - W 1/4 post 26

TZN, R14E

Personnel Cronin - Draw

Ripple

Geyman

Mosser


Barbour

20


Date 7/19/82 Drawn 8/5/82

Weather sunny-humid

Temp. 85°

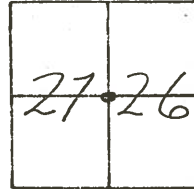

Set P.K. & washer
atop P.K. & washer
6" Lt. & Pavement

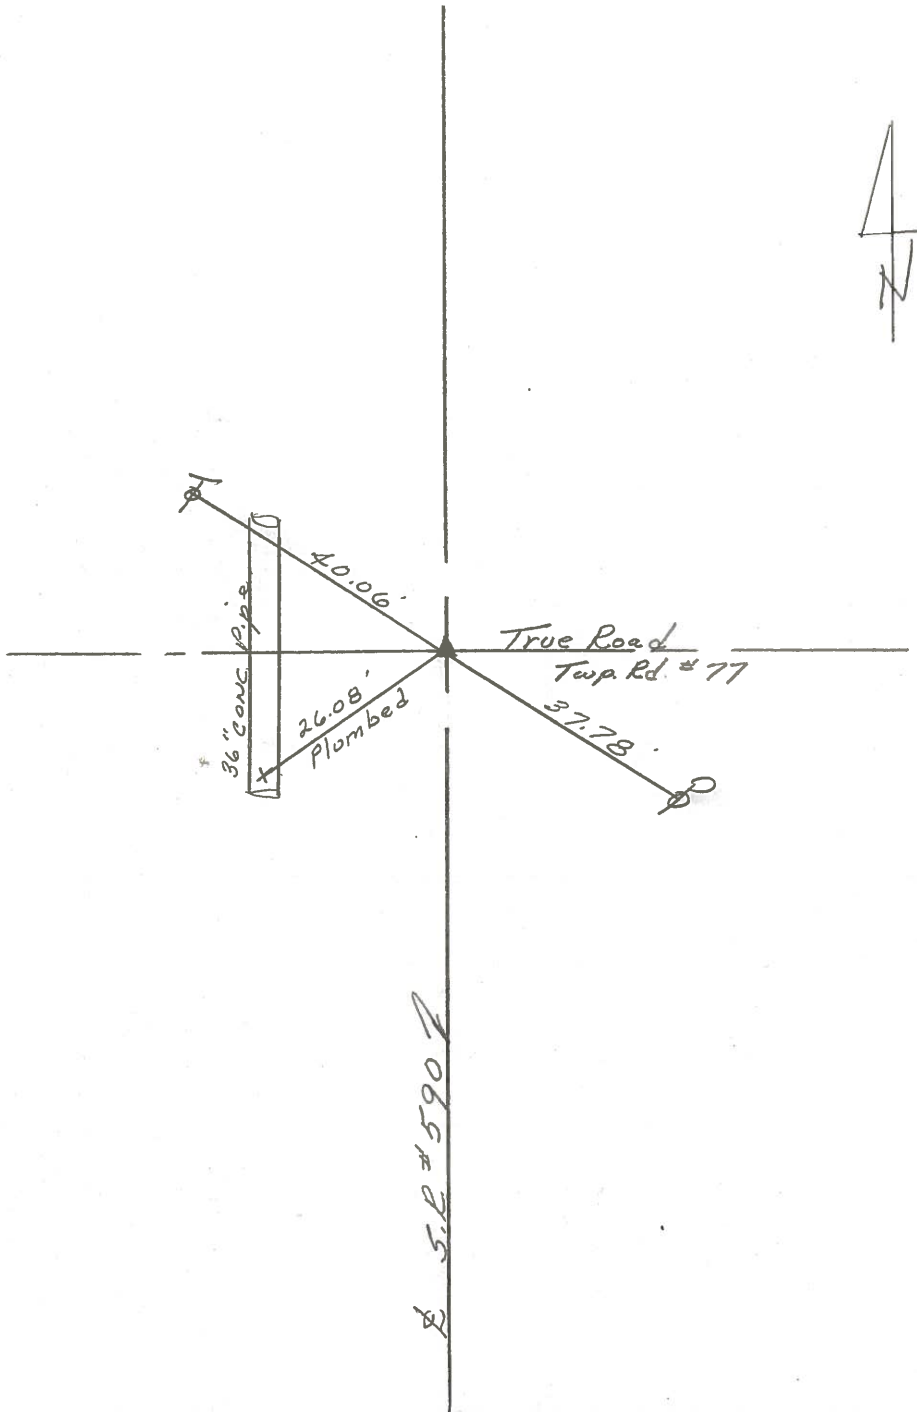


PERSONNEL TITLE PERSONNEL TITLE

COUNTY Ottawa DATE 7-27-71S. R. 590 WEATHER CloudySEC. 27 & 26 TEMP. 75°DESCRIPTION S.R. #163 to S.R. #2 Benton Twp. JOB NO. _____

LEFT

CENTER LINE

RIGHT

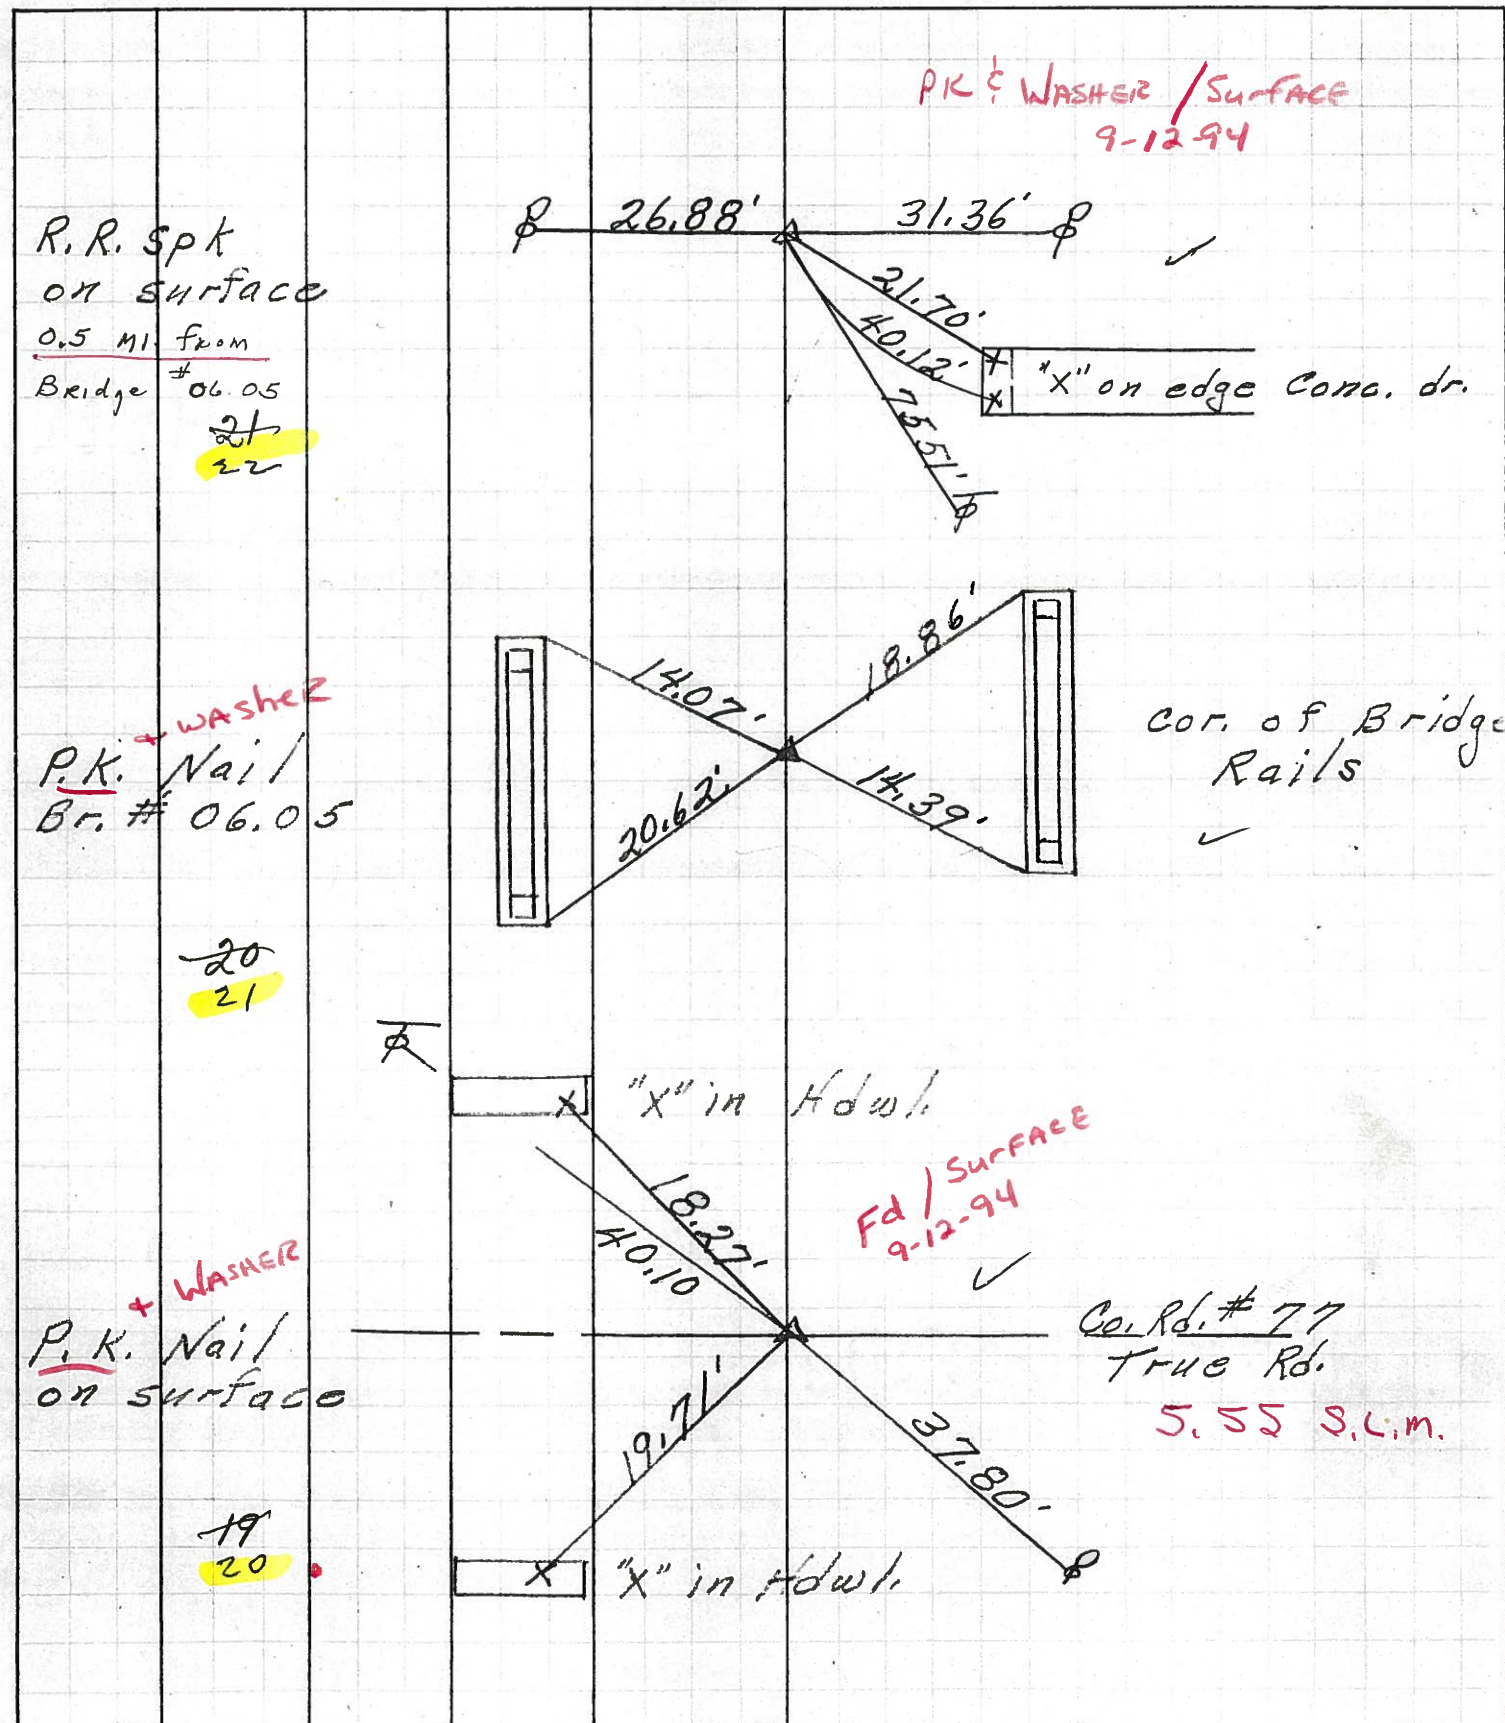



PERSONNEL TITLE PERSONNEL TITLE

COUNTY Ottawa DATE 7-27-71S. R. 590 WEATHER CloudySEC. 27 & 26 TEMP. 75°DESCRIPTION S.R. #163 to S.R. #2 Benton Twp. JOB NO. _____


LEFT

CENTER LINE

RIGHT

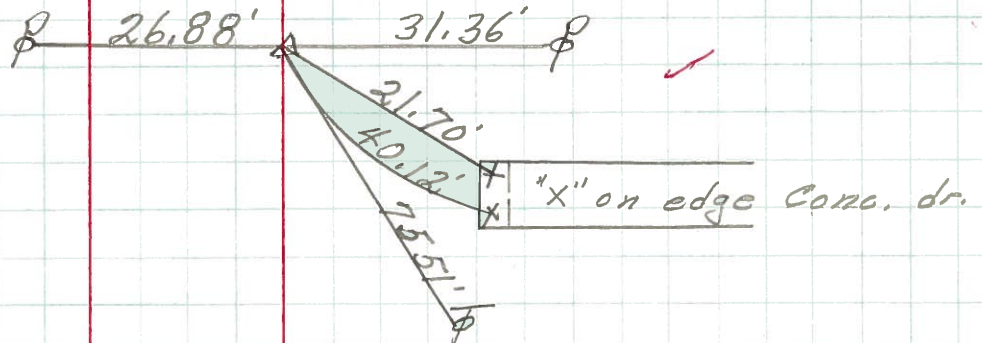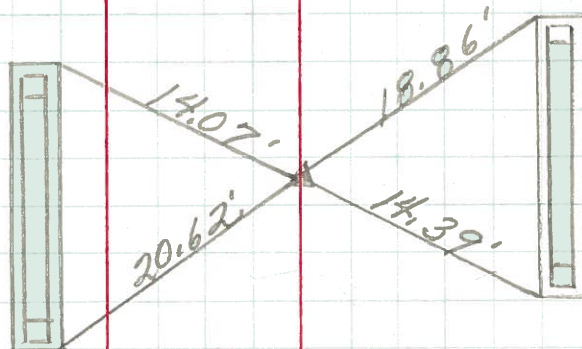R.R. Spk
on surface0.5 MI. from
Bridge # 06.0521
22P.K. Nail
Br. # 06.0520
21Cor. of Bridge
Rails

✓

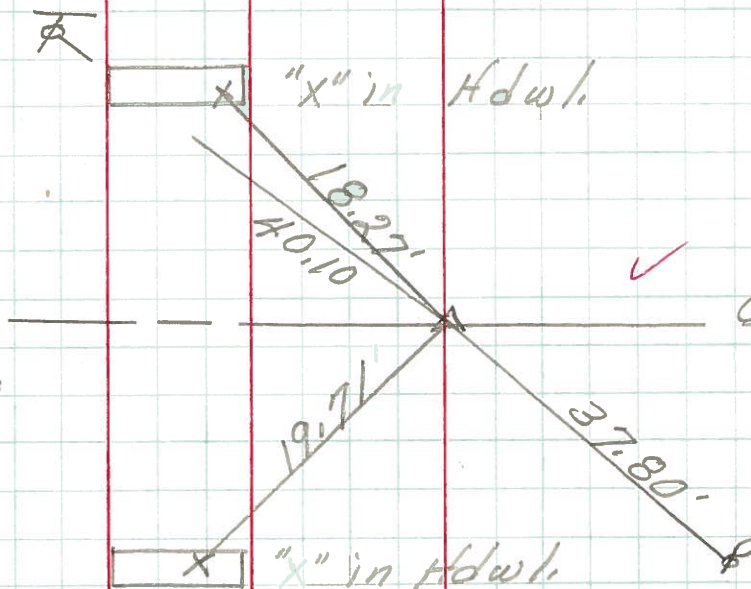P.K. Nail
on surface19
20Co. Rd. # 77
True Rd.

PERSONNEL TITLE PERSONNEL TITLE

SchneiderMosserBarbourCOUNTY Ottawa DATE 6-21-68S. R. 590 WEATHER cloudy - windySEC. S.R.#163 to S.R.#2 TEMP. 60°DESCRIPTION Ties for Control Points JOB NO. _____

LEFT

CENTER LINE

RIGHT

P.K. Nail
on surface

6483

(20)

FRAMP
RES.Large Iron pin
10" down

6482

(19)

P.K. Nail
on surface

6481

(18A)

