

O.D.O.T. DISTRICT 2 SURVEY OFFICE (USE ONLY)

PERSONNEL

REFERENCE NO. 22

SHEET 23 OF 30

NOTES BARRIERE
H.C. MILLER
R.C. BLUBAUGH

DATE 5/31/24
WEATHER SUNNY
TEMP. 52°

ROUTE SR 590
COUNTY OTTAWA
TOWNSHIP BENTON
SECTION 22

DWG BY BARRIERE PID 107604

T 7 N R 14 E

TYPE MONUMENT MAG NAIL/WASHER

ON SURFACE - BELOW ON

OFFSET $\varnothing$ PAVEMENT 3.8' RT LT : RT

6.5' TO RT EDGE PAVEMENT

STATION: 346+33

HORZ.DATUM: OH NORTH/OTT LDP


GEOID: 18

GRID: NORTHING: 688041.318

EASTING: 1770917.684


LDP: NORTHING: 347360.792

EASTING: 130590.114

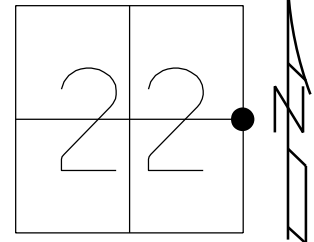

RECORD:
FD P.K./WASHER
7/10/08
SV122,
8/13/08, MC
SET MAG/WASHER
6/09/09, SAH
FD MAG/WASHER
REF22
2-26-18, 4-23-18
10-4-18, JFO
FD MAG/WASHER
REF22
4/10/23, TDN
FD MAG/WASHER
REF22
5/31/24, JAM

NOTE:
4.75 x 7.5" HIGH POINTED
SANDSTONE FD BY CO.
14.25" DOWN

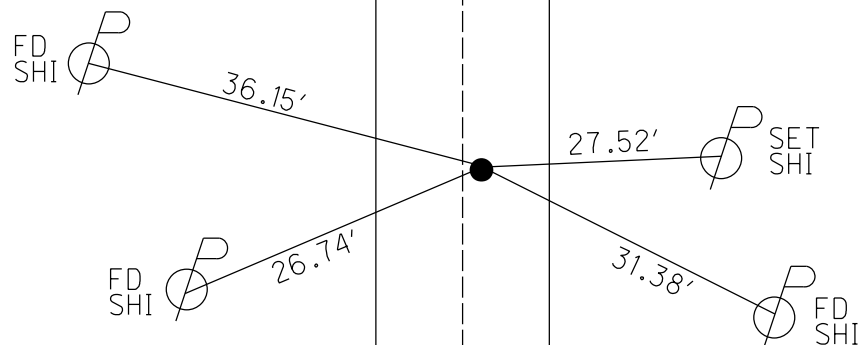

CONC DR
RES #2493

O.D.O.T. DISTRICT 2 SURVEY OFFICE (USE ONLY)

PERSONNEL

REFERENCE NO. 22

SHEET 23 OF 30

NOTES RHOADES

DATE 2/26/18

ROUTE SR 590

H.C. O'DONNELL

WEATHER SUNNY

COUNTY OTTAWA

R.C. RHOADES

TEMP.

TOWNSHIP BENTON

SECTION 22

DWG BY MILLER PID 101240

T 7 N R 14 E

TYPE MONUMENT MAG/WASHER

ON SURFACE - ~~BELOW~~ ON

OFFSET CL PAVEMENT 3.8' ~~LT~~ : RT

6.5' TO RT EDGE PAVEMENT


STATION: 346+33

HORZ.DATUM: NAD83-2011

GEOID: NAVD88-2012A


GRID: NORTHING: 688007.054

EASTING: 1770829.573

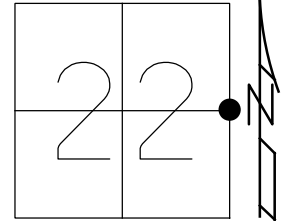

RECORD:
FD P.K./WASHER
7/10/08
SV122,
8/13/08, MC
SET MAG/WASHER
6/09/09, SAH
FD MAG/WASHER
REF22
2-26-18, 4-23-18
10-4-18, JFO
FD MAG/WASHER
REF22
4/10/23, TDN

NOTE:
4.75 x 7.5" HIGH POINTED
SANDSTONE FD BY CO.
14.25" DOWN

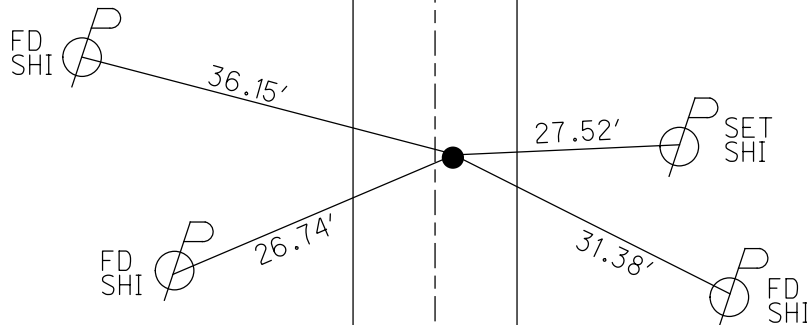

CONC DR
RES #2493

O.D.O.T. DISTRICT 2 SURVEY OFFICE (USE ONLY)

PERSONNEL

REFERENCE NO. 22

SHEET 23 OF 30

NOTES RHOADES

DATE 2/26/18

ROUTE SR 590

H.C. O'DONNELL

WEATHER SUNNY

COUNTY OTTAWA

R.C. RHOADES

TEMP. _____

TOWNSHIP BENTON

DWG BY MILLER

PID 101240

SECTION 22

T 7 N R 14 E

TYPE MONUMENT MAG/WASHER

ON SURFACE - ~~BELOW~~ ON

OFFSET $\odot$ PAVEMENT 3.8' ~~LT~~ : RT

6.5' TO RT EDGE PAVEMENT


STATION: 346+33

HORZ.DATUM: NAD83-2011

GEOID: NAVD88-2012A


GRID: NORTHING: 688007.072

EASTING: 1770829.584

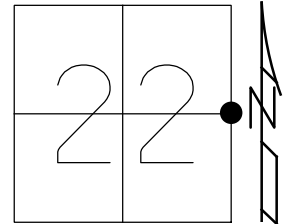

RECORD:
FD P.K./WASHER
7/10/08
SV122,
8/13/08, MC
SET MAG/WASHER
6/09/09, SAH
FD MAG/WASHER
REF 22
2-26-18, 4-23-18
10-4-18, JFO

NOTE:
4.75 x 7.5" HIGH POINTED
SANDSTONE FD BY CO.
14.25" DOWN

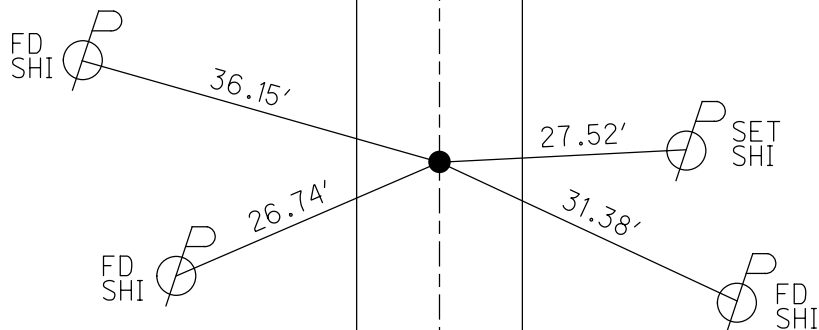


CONC DR
RES #2493

O.D.O.T. DISTRICT 2 SURVEY OFFICE (USE ONLY)

PERSONNEL _____ REFERENCE NO. 22 SHEET 23 OF 30
 NOTES CANTERBURY DATE 7/10/08 ROUTE SR 590
 H.C. HUSS WEATHER FAIR COUNTY OTTAWA
 R.C. CANTERBURY TEMP. 78° TOWNSHIP BENTON
 SECTION 22
 T 7 N R 14 E


TYPE MONUMENT _____ P.K./WASHER _____
 ON SURFACE - ~~BELOW~~ ON _____
~~LEFT~~ - C PAV'T - RIGHT 3.8'
6.5' TO RT EDGE PAVEMENT
 S.L.M. 346+33

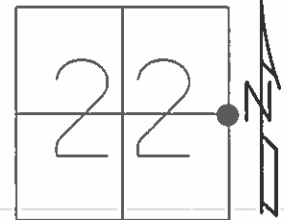

GRID: NORTHING: _____ EASTING: _____

RECORD:
 SET MAG/WASHER
 6/09/09, SAH
 GPS SV122,
 8/13/08

NOTE:
 4.75"X7.5" HIGH POINTED
 SANDSTONE FOUND BY COUNTY
 14.25" BELOW SURF

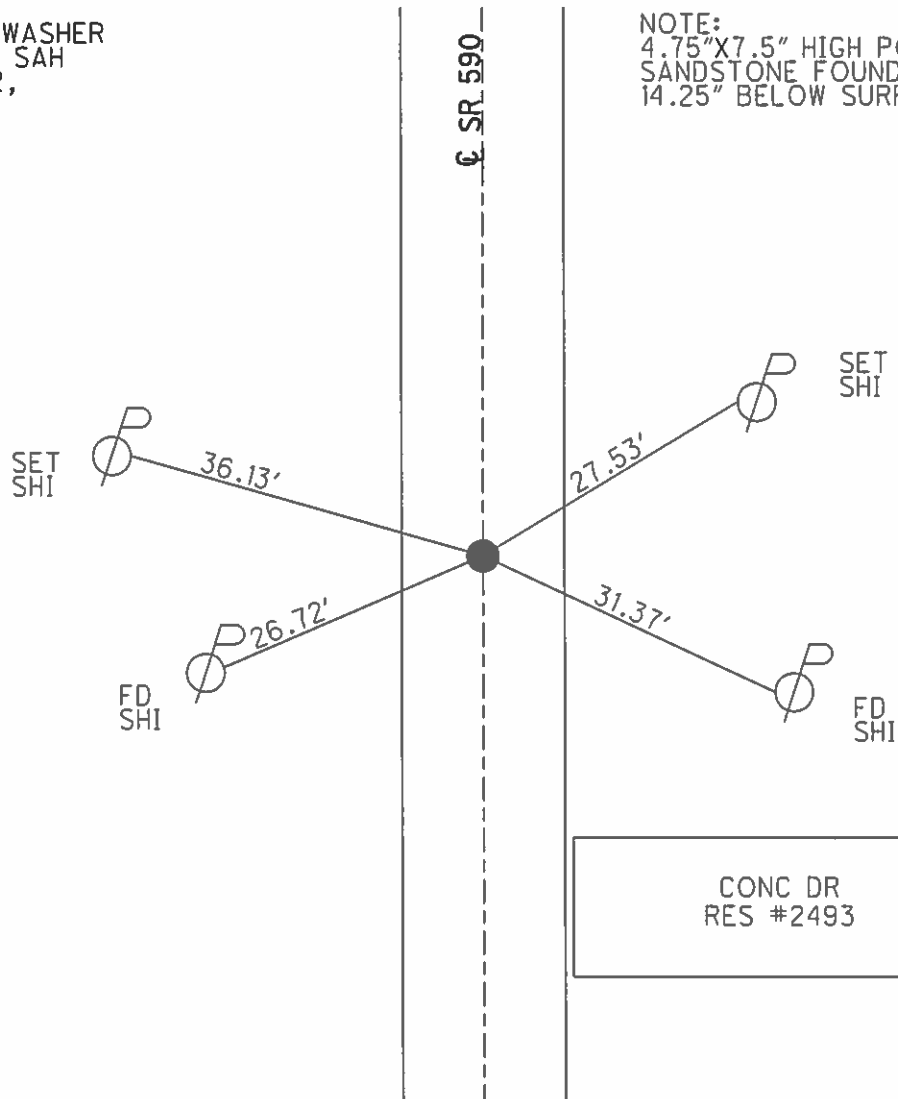

O.D.O.T. DISTRICT 2 SURVEY OFFICE (Use Only)

PERSONNEL

REFERENCE NO. 22

SHEET OF

NOTES CANTERBURY

DATE 7-10-08

ROUTE S.R. 590

H.C. HUSS

WEATHER FAIR

COUNTY OTTAWA

R.C. CANTERBURY

TEMP. +78

TOWNSHIP BENTON

SECTION 22 & 23

T 7 N R 14 E



TYPE MONUMENT P.K./WASHER

ON SURFACE - ~~BELOW~~ SURFACE

~~LEFT~~ - C PAV'T - RIGHT 3.8' RT


6.5' TO RT EDGE PAVEMENT

S.L.M. 346+33

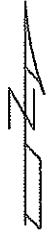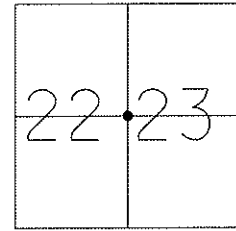

SHOT GPS SV122
08-13-08

RECORD:
4.75" X 7.5" HIGH POINTED
SANDSTONE FOUND BY COUNTY
14.25" BELOW SURFACE
SET MAG/W 6-9-09 SAH

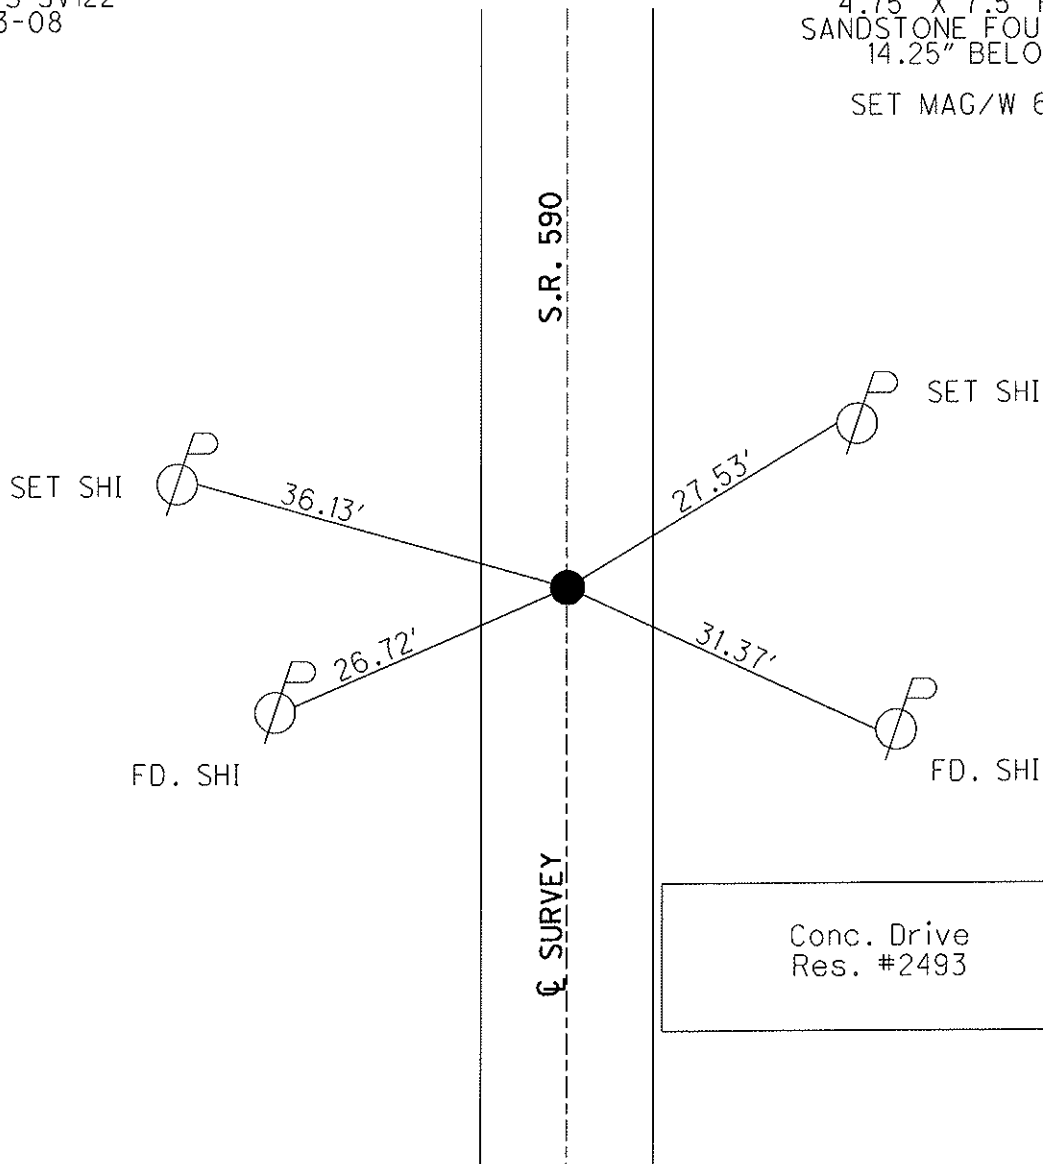

O.D.O.T. DISTRICT 2 SURVEY OFFICE

PERSONNEL

REFERENCE NO. 22 SHEET 6 OF 1

NOTES Ripple

H.C. BARBOUR

R.C. Geyman

DATE 8/06/90 DRAWN 8/08/90

WEATHER Cloudy

TEMP. 62°

ROUTE SR#590


COUNTY OTTAWA

TOWNSHIP BENTON


SECTION E 1/4 Post #22 W. 1/4 Post #23

T R


TYPE MONUMENT Set P.K. & Washer
ON SURFACE - BELOW SANDSTONE
LEFT - CL PAV'T. - RIGHT 3.5' ± RT. & PVT.
TO EDGE PAVEMENT
S.L.M.

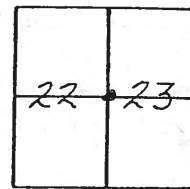

FD PK & WASHER
SURFACE
9-12-94

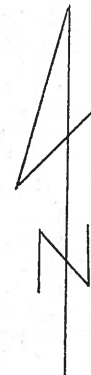

4 3/4" x 7 1/2" high pointed
SANDSTONE found by County
14 1/4" below surface

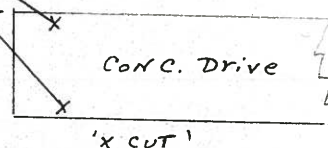

SR. 590

O.D.O.T. DISTRICT 2 SURVEY OFFICE

PERSONNEL

REFERENCE NO. 22

SHEET 6 OF 1

NOTES RIPPLE

H.C. BARBOUR

R.C. GEYMAN

DATE 8/06/90 DRAWN 8/08/90

WEATHER CLOUDY

TEMP. 62°

ROUTE SR#590

COUNTY OTTAWA

TOWNSHIP BENTON

SECTION E 1/4 POST #22 W. 1/4 POST #23

T R



TYPE MONUMENT SET P.K. & WASHER

ON SURFACE - BELOW SANDSTONE

LEFT- & PAV'T. - RIGHT 3.5' ± RT. & PVT.

 TO EDGE PAVEMENT

S.L.M.

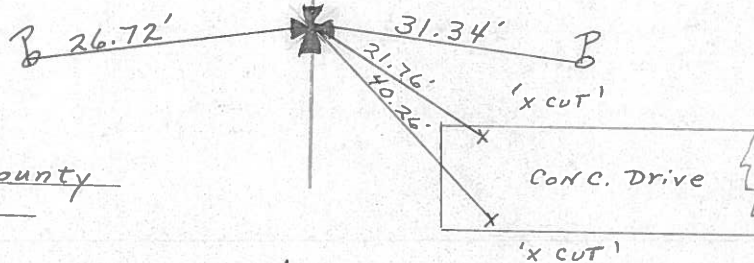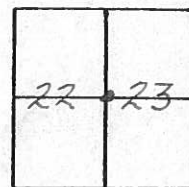

4 3/4" x 7 1/2" high pointed
SANDSTONE found by County
14 1/4" below surface

SR. 590

O.D.O.T. DISTRICT 2 SURVEY OFFICE

SHEET

OF

County Ottawa S.R. #590

Township Benton

Section E $\frac{1}{4}$ Post #22 - W $\frac{1}{4}$ Post #23

TZN, R14E

Personnel Cronin-Draw

Ripple

Geyman


Mosser

Barbour

Date 7/19/82 Drawn 8/5/82

Weather sunny - humid


Temp. 85°

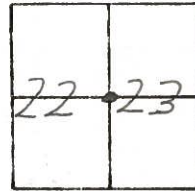

#22



4 $\frac{3}{4}$ " x 7 $\frac{1}{2}$ " x 8 $\frac{1}{4}$ " high pointed
sandstone found by County
14 $\frac{1}{4}$ " below surface - Set
P.K. & Washer at top - 3.0'
Rt. & Pavement

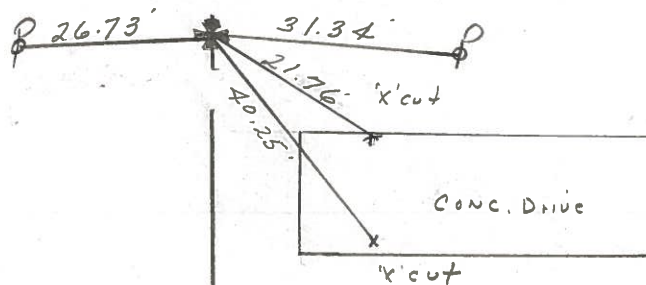

S.R. #590

PERSONNEL TITLE PERSONNEL TITLE

COUNTY Ottawa DATE 7-27-71S. R. 590 WEATHER CloudySEC. 27 & 26 TEMP. 75°DESCRIPTION S.R. #163 to S.R. #2 Benton Twp. JOB NO. _____

LEFT

CENTER LINE


RIGHT

R.R. Spk
on surface0.5 MI. from
Bridge #06.0521
22P.K. ^{+ WASHER} Nail
Br. # 06.0520
21P.K. ^{+ WASHER} Nail
on surface19
20

26.88' 31.36'

P.K. ^{+ WASHER} / SURFACE
9-12-94

"X" on edge conc. dr.

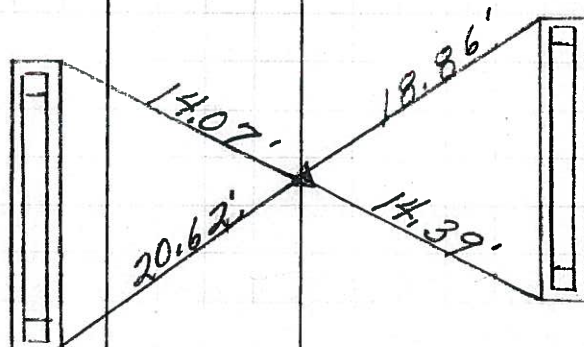Cor. of Bridge
Rails

"X" in Hdwl.

Fd / SURFACE
9-12-9418.22'
40.10'Co. Rd. # 77
True Rd.

5.55 S.L.M.

19.71'

37.80'

"X" in Hdwl.

PERSONNEL TITLE PERSONNEL TITLE

COUNTY Ottawa DATE 7-27-71S. R. 590 WEATHER cloudySEC. 27 & 26 TEMP. 75°DESCRIPTION S.R. #163 & S.R. #2 Benton Twp. JOB NO. _____


LEFT

CENTER LINE

RIGHT


R.R. Spk
on surface
0.5 mi from
Bridge # 06.05

21
22.

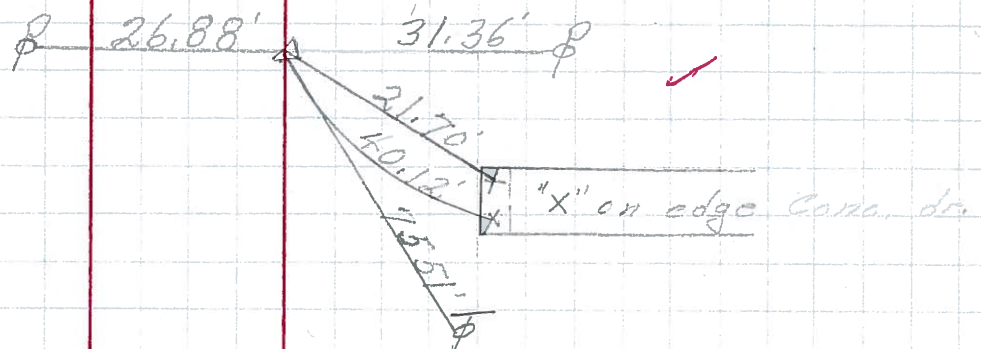

P.K. Nail
Br. # 06.05


20
21

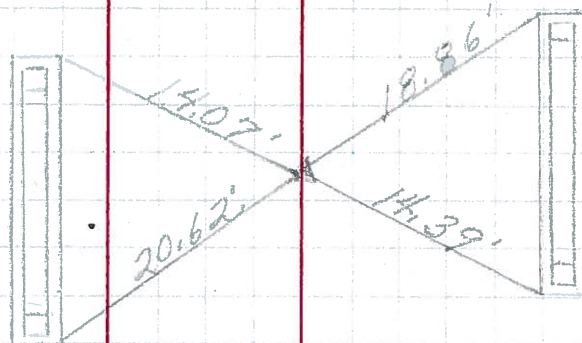

cor. of Bridge
Rails

P.K. Nail
on surface

19
20

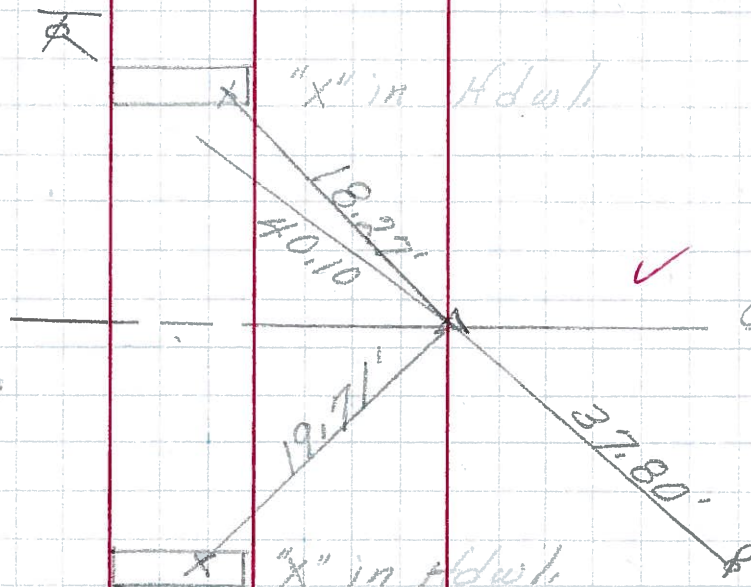

Co. Rd. # 77
True Rd.

PERSONNEL TITLE PERSONNEL TITLE

Schneider

Mosser

Barbour

COUNTY Ottawa

DATE 6-21-68

S. R. 590

WEATHER Cloudy-Windy

SEC. S.R. #163 to S.R. #2

TEMP 75°

DESCRIPTION Ties for Control Points

JOB NO.

LEFT

CENTER LINE

RIGHT

R.R. spk.
on top

6486

(23)

R.R. spk.
on top

6485

(22)

P.K. Nail
Br. # 06.05

6484

(21)

