

O.D.O.T. DISTRICT 2 SURVEY OFFICE (USE ONLY)

PERSONNEL

REFERENCE NO. 40

SHEET 12 OF 34

NOTES PRESTON-COLVIN

DATE 9-4-24

ROUTE US 6

H.C. NEISE

WEATHER SUNNY

COUNTY SANDUSKY

R.C. BARRIERE

TEMP. 78°

TOWNSHIP RILEY

SECTION 11

DWG BY PRESTON-COLVIN PID PAVING TRAIN

T 5 N R 16 E

TYPE MONUMENT P.K./WASHER

ON SURFACE - BELOW ON

OFFSET $\odot$ PAVEMENT 1.5' ~~LT~~ : RT

- TO - EDGE PAVEMENT

STATION: 1341+85

HORZ.DATUM: NAD83 (2011)


GEOID: NAVD88 2018

GRID: NORTHING: 634963.061


EASTING: 1838735.931

LDP: NORTHING: 331219.8

EASTING: 198865.4

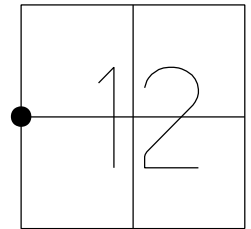

RECORD:
STA 115+96.5
PREVIOUS MONUMENTS:
P.K./WASHER
MINE SPIKE
FD P.K./WASHER
3/16/02, DCH
SET P.K./WASHER
6/10/02 DCH
FD P.K./WASHER
REF40
11/22/17, DCH
SET MAG/WASHER
8-2-19, JLL
FD MAG/WASHER
2/10/22, JFO
1/20/23, JMR
FD MAG/WASHER
REF40
9/4/24, TDN
FD MEG/WASHER
10/3/24, JAM

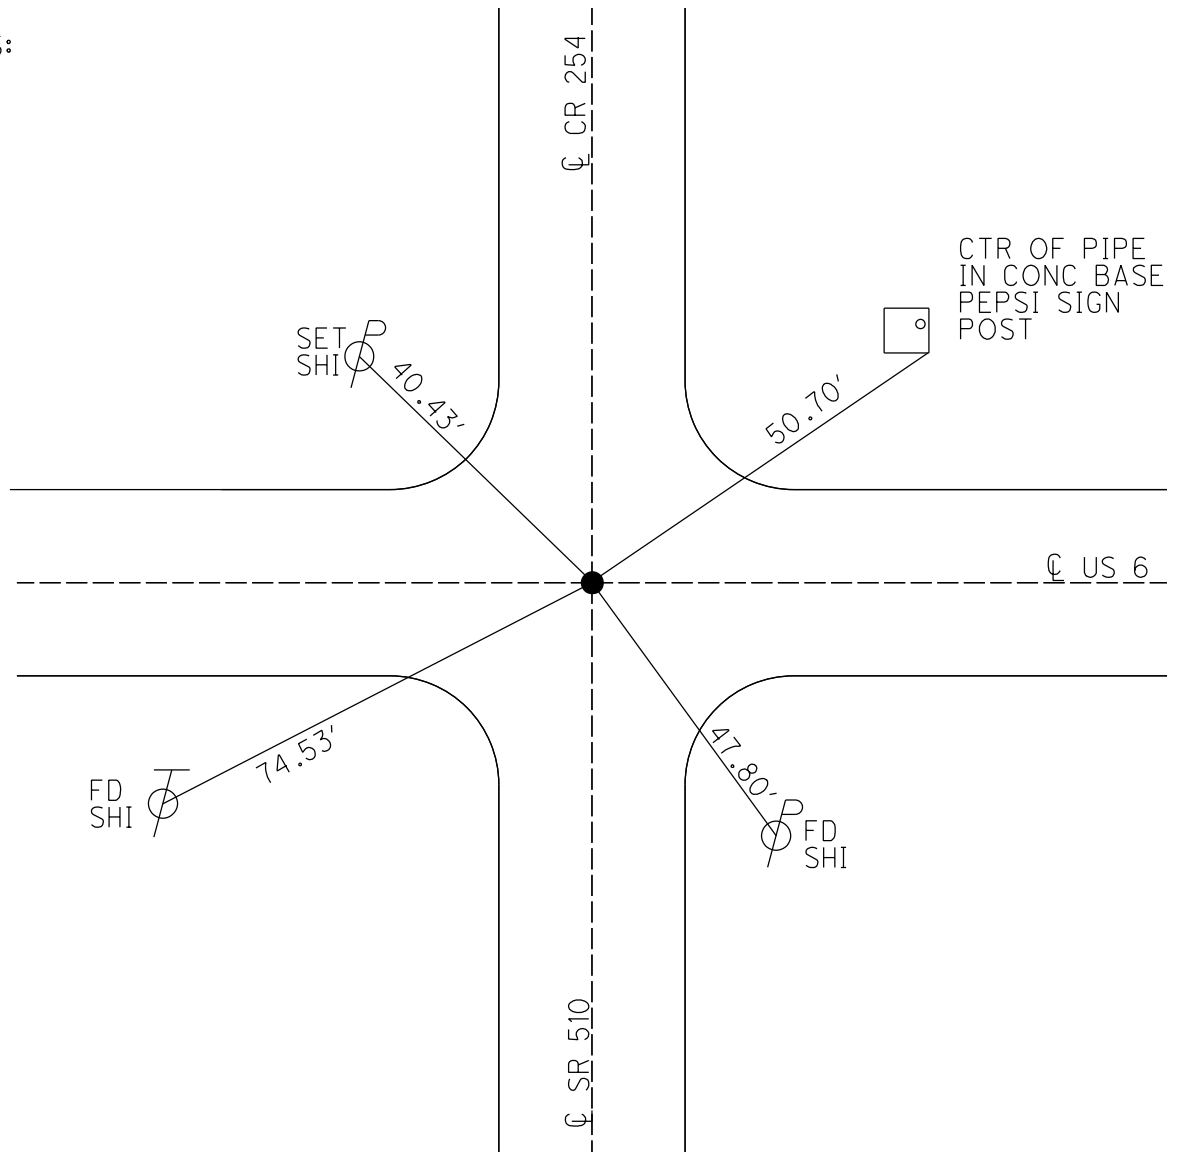

O.D.O.T. DISTRICT 2 SURVEY OFFICE (USE ONLY)

PERSONNEL

REFERENCE NO. 40

SHEET 12 OF 34

NOTES LEU

DATE 8/1/18

ROUTE US 6

H.C. LEU

WEATHER CLOUDY

COUNTY SANDUSKY

R.C. TRENKA

TEMP. 76°

TOWNSHIP RILEY

DWG BY AUBLE

PID PAVETRAIN

SECTION 12

T 5 N R 16 E

TYPE MONUMENT P.K./WASHER

ON SURFACE - ~~BELOW~~ ON

OFFSET Q PAVEMENT 1.5' ~~LT~~ : RT

- TO - EDGE PAVEMENT


STATION: 1356+56

HORZ.DATUM: NAD83 (2011)

GEOID: 2012A

GRID: NORTHING: 634963.061

EASTING: 1838735.931

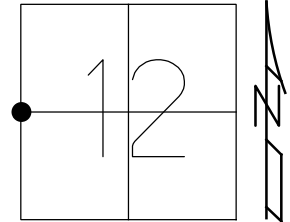

RECORD:

STA 115+96.5

PREVIOUS MONUMENTS:

P.K./WASHER

MINE SPIKE

FD P.K./WASHER

3/16/02, DCH

SET P.K./WASHER

6/10/02 DCH

FD P.K./WASHER

REF40

11/22/17, DCH


SET MAG/WASHER

8-2-19, JLL

FD MAG/WASHER

2/10/22, JFO

1/20/23, JMR

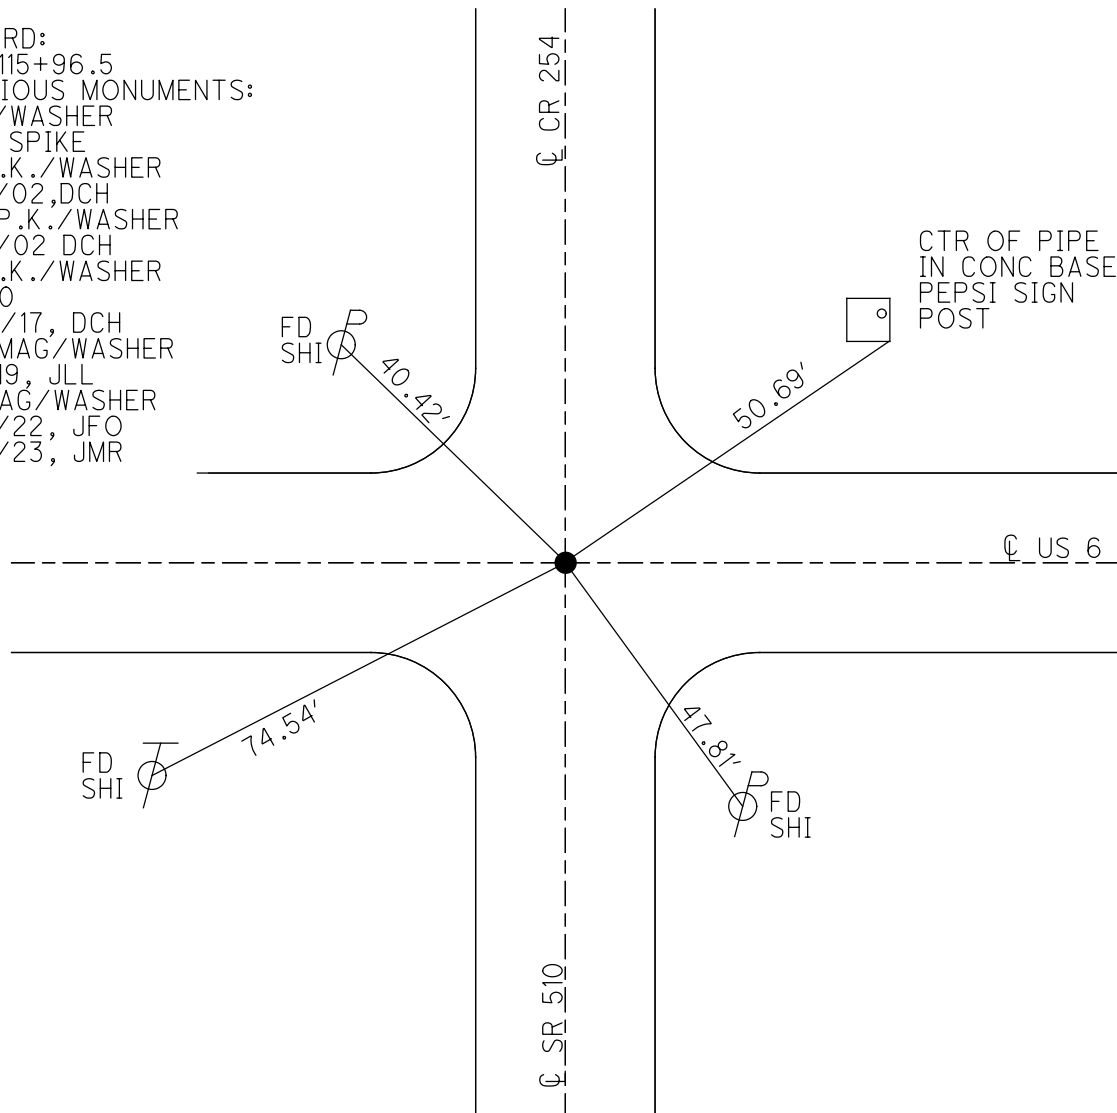

O.D.O.T. DISTRICT 2 SURVEY OFFICE (USE ONLY)

PERSONNEL

REFERENCE NO. 40

SHEET 12 OF 34

NOTES LEU

DATE 8/1/18

ROUTE US 6

H.C. LEU

WEATHER CLOUDY

COUNTY SANDUSKY

R.C. TRENKA

TEMP. 76°

TOWNSHIP RILEY

DWG BY AUBLE

PID 95769

SECTION 12

T 5 N R 16 E

TYPE MONUMENT P.K./WASHER

ON SURFACE - ~~BELOW~~ ON

OFFSET CL PAVEMENT 1.5' ~~LT~~ : RT

- TO - EDGE PAVEMENT


STATION: 1356+56

HORZ.DATUM: NAD83 (2011)


GEOID: 2012A

GRID: NORTHING: 634963.061

EASTING: 1838735.931

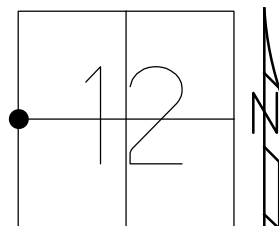

RECORD:
STA 115+96.5
PREVIOUS MONUMENTS:
P.K./WASHER
MINE SPIKE
FD P.K./WASHER
3/16/02, DCH
SET P.K./WASHER
6/10/02 DCH
FD P.K./WASHER
REF40
11/22/17, DCH
SET MAG/WASHER
8-2-19, JLL
FD MAG/WASHER
2/10/22, JFO

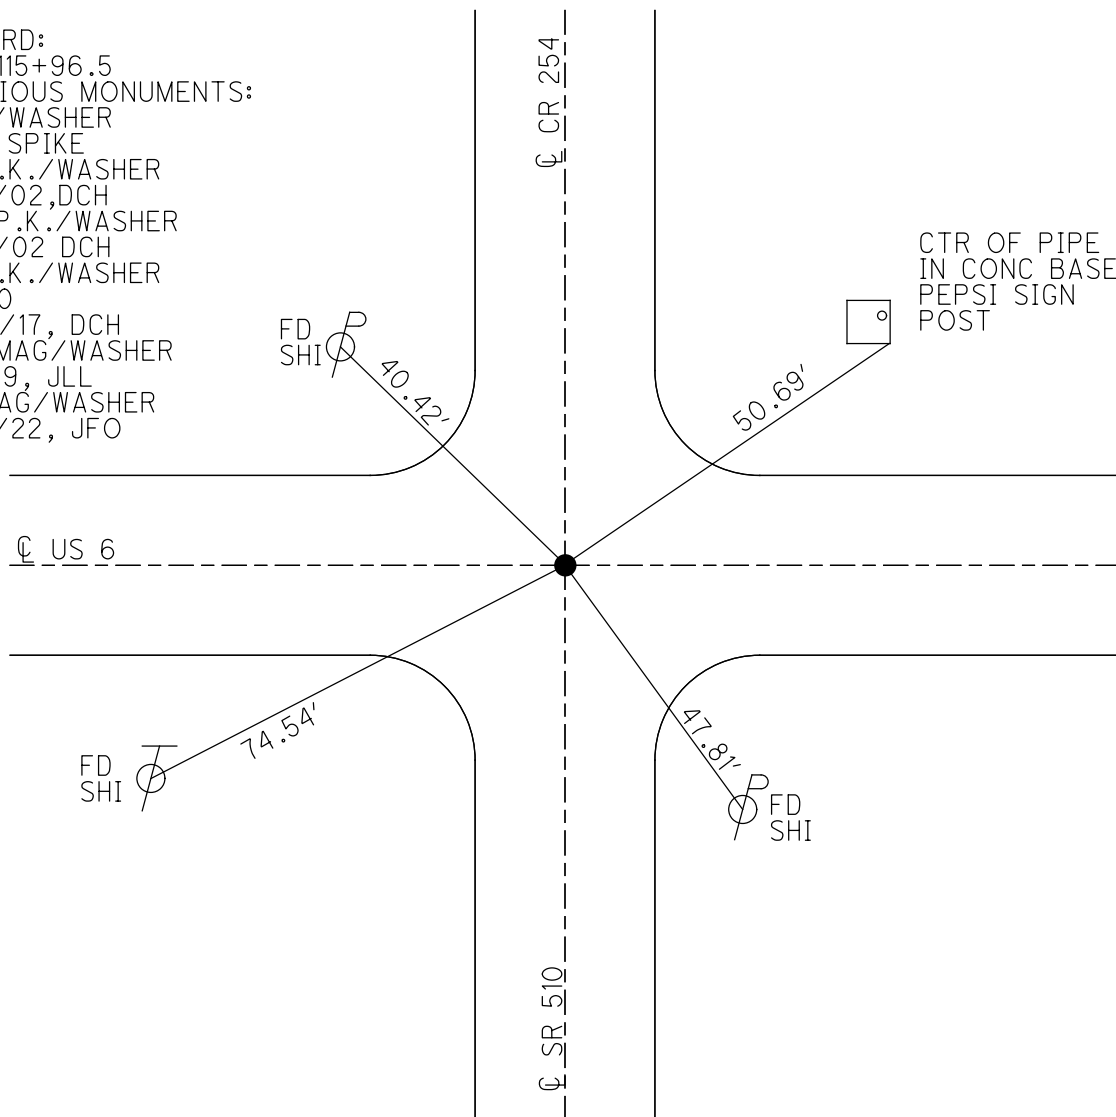

O.D.O.T. DISTRICT 2 SURVEY OFFICE (USE ONLY)

PERSONNEL

REFERENCE NO. 40

SHEET 12 OF 34

NOTES LEU

DATE 8/1/18

ROUTE US 6

H.C. LEU

WEATHER CLOUDY

COUNTY SANDUSKY

R.C. TRENKA

TEMP. 76°

TOWNSHIP RILEY

SECTION 12

DWG BY AUBLE PID 95769

T 5 N R 16 E

TYPE MONUMENT P.K./WASHER

ON SURFACE - ~~BELOW~~ ON

OFFSET CL PAVEMENT 1.5' ~~LT~~ : RT

- TO - EDGE PAVEMENT


STATION: 1356+56

HORIZ.DATUM: NAD83 (2011)


GEOID: 2012A

GRID: NORTHING: 634963.061

EASTING: 1838735.931

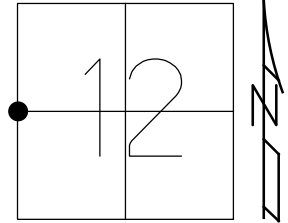


RECORD:
STA 115+96.5
PREVIOUS MONUMENTS:
P.K./WASHER
MINE SPIKE
FD P.K./WASHER
3/16/02, DCH
SET P.K./WASHER
6/10/02 DCH
FD P.K./WASHER
REF40
11/22/17, DCH
SET MAG/WASHER
8-2-19, JLL

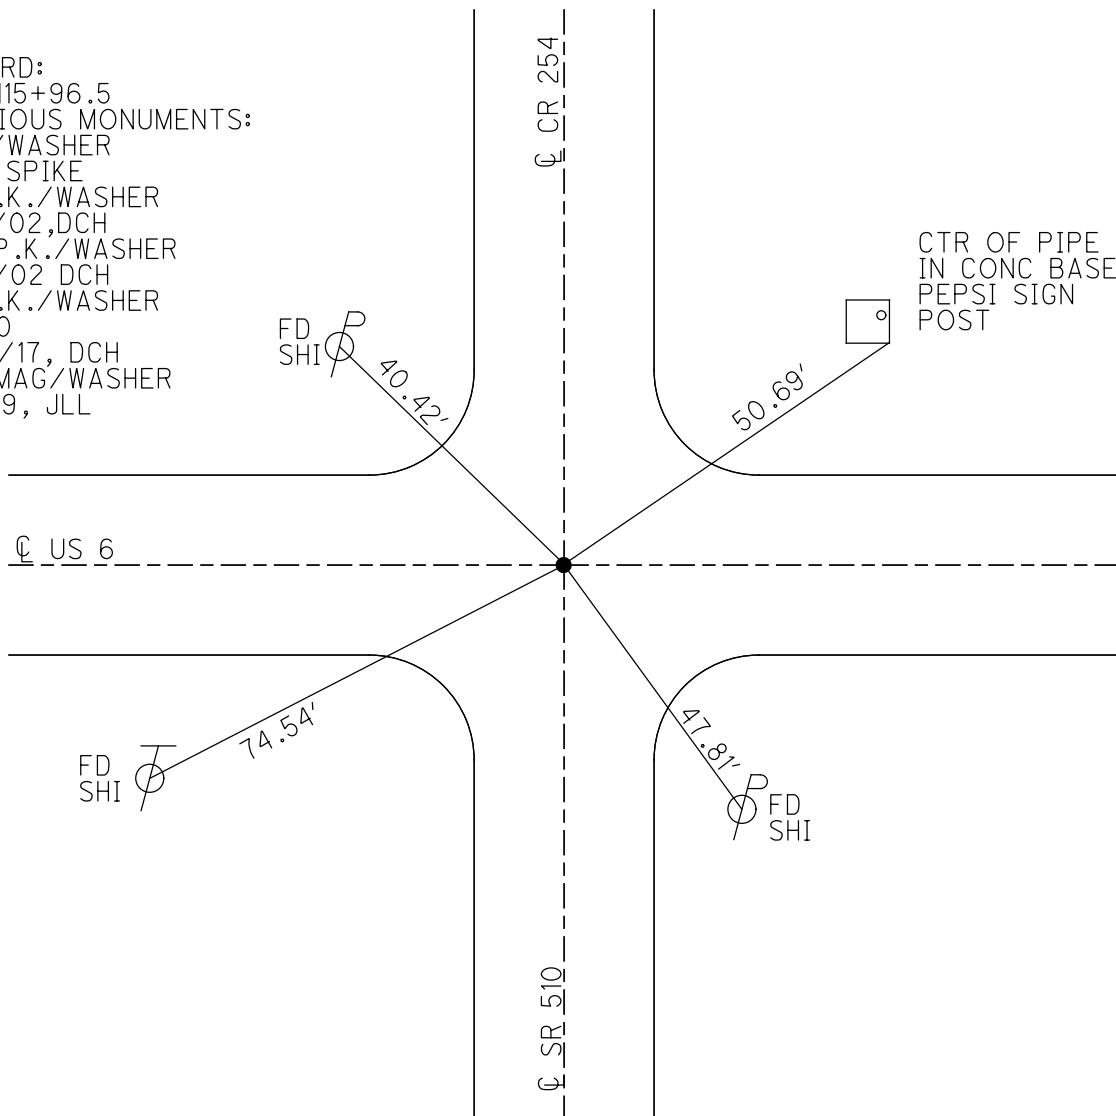


O.D.O.T. DISTRICT 2 SURVEY OFFICE (USE ONLY)

PERSONNEL _____ REFERENCE NO. 40 SHEET 11 OF 31
 NOTES ROUSOS _____ DATE 03/16/02 ROUTE US 6
 H.C. VAN DUSEN _____ WEATHER WINDY COUNTY SANDUSKY
 R.C. MOSSER _____ TEMP. 28° TOWNSHIP RILEY
 HOMAN _____ SECTION 12
 T 5 N R 16 E

TYPE MONUMENT _____ PK/WASHER _____
 ON SURFACE - ~~BELOW~~ _____ ON _____
~~LEFT~~ - Q PAV'T - RIGHT 1.0'
 - TO - EDGE PAVEMENT
 S.L.M. 1356+56
 GRID: NORTHING: _____ EASTING: _____

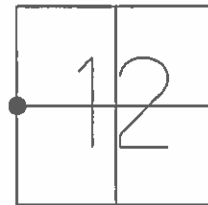

RECORD:
 OLD STA 115+96.5
 PREVIOUS MONUMENTS
 PK/WASHER
 MINE SPK
 SET PK/WASHER
 06/10/02 DCH

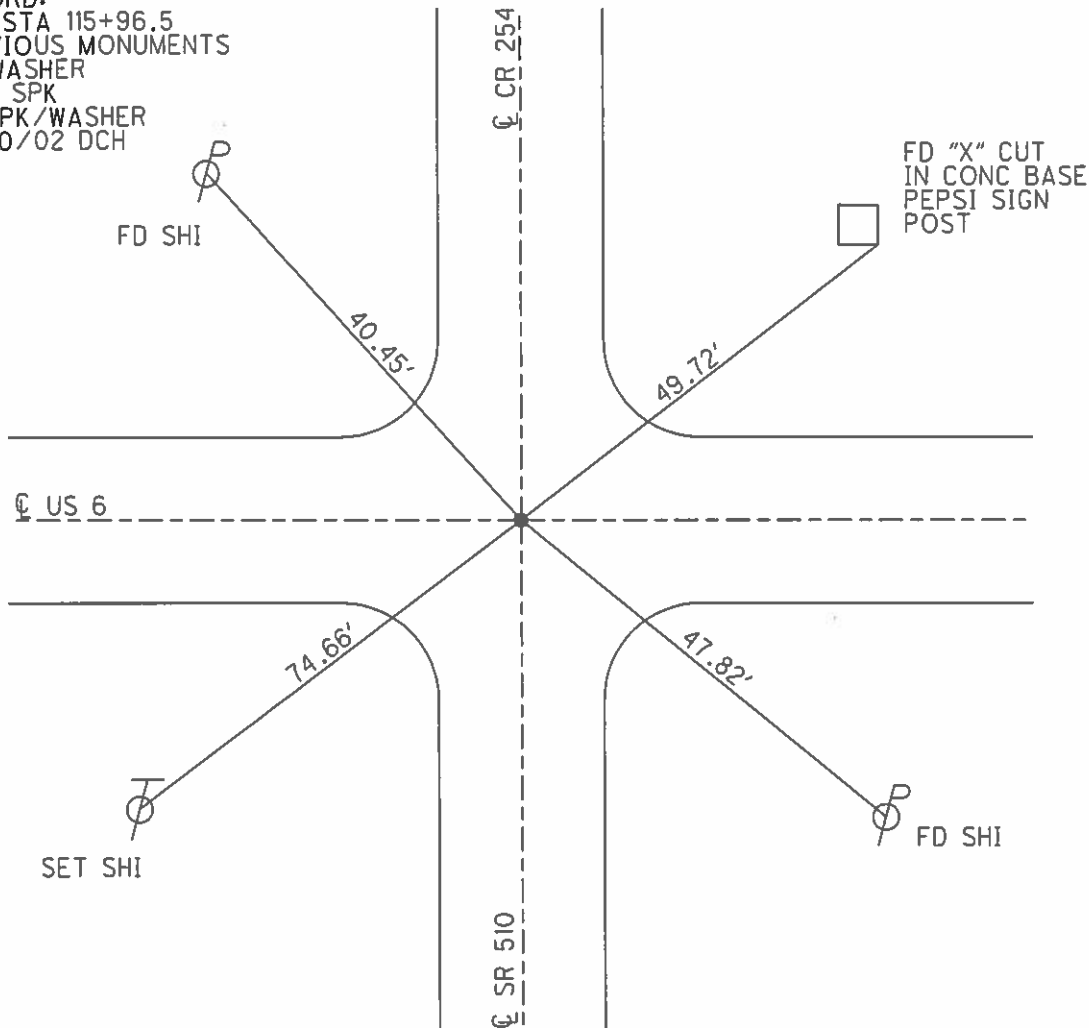

O.D.O.T. DISTRICT 2 SURVEY OFFICE

PERSONNEL

NOTES ROUSOS
H.C. VAN DUSEN
R.C. MOSSER
HOMAN


REFERENCE NO. 40

DATE 3/16/02
WEATHER WINDY
TEMP. 28°

SHEET 9 OF 27


ROUTE ~~SR~~ 6
COUNTY SANDUSKY
TOWNSHIP RILEY
SECTION 12
T 5 N R 16 E

TYPE MONUMENT PK/WASHER
ON SURFACE - ~~BELOW~~ ON
~~LEFT~~ - Q PAV'T - RIGHT 1.0'
TO EDGE PAVEMENT
S.L.M. 1356+56

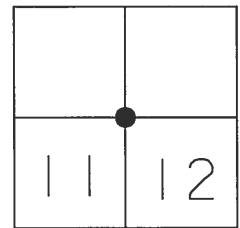

OLD STA 115+96.5
PREVIOUS MONUMENTS
PK/WASHER
MINE SPK

SET PK/WASHER
6-10-02
DCH

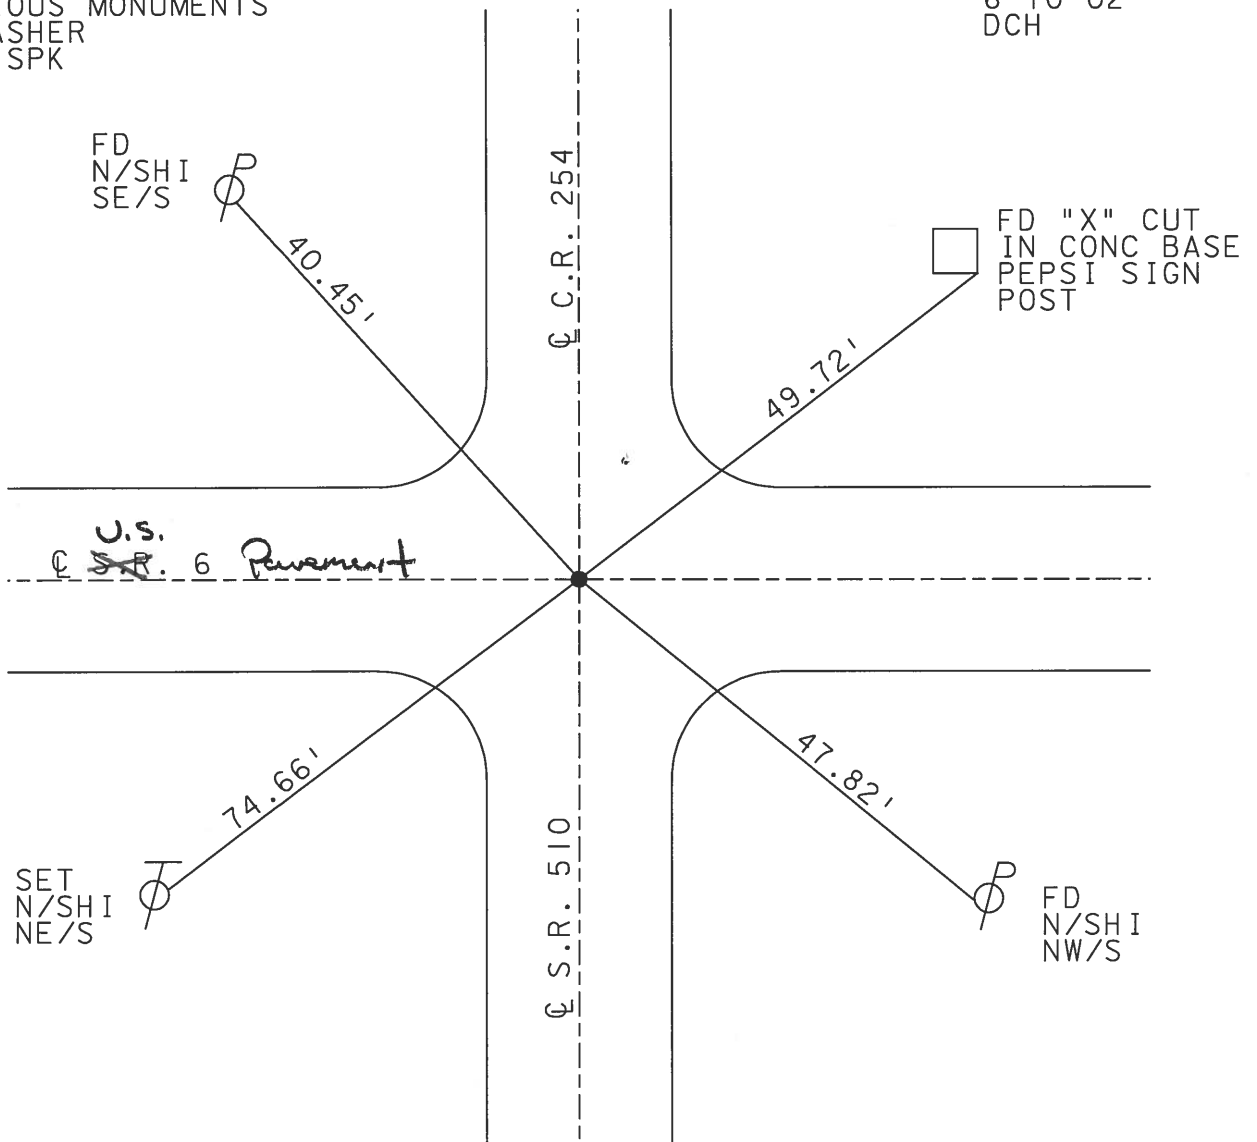

O.D.O.T. DISTRICT 2 SURVEY OFFICE

PERSONNEL

REFERENCE NO. 40

SHEET 21 OF 39

NOTES CHENEY

H.C. RIPPLE

R.C. BARBOW

DATE 3-16-1991

WEATHER SUNNY

TEMP. 85°

ROUTE 6

COUNTY SANDUSKY

TOWNSHIP RILEY

SECTION 12

T5N R16E


TYPE MONUMENT PK/WASHER

ON SURFACE - BELOW

LEFT - PAV'T. - RIGHT —

— TO — EDGE PAVEMENT

S.L.M. 1356+56

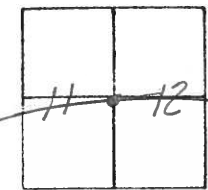


OLD STATION = 115+96.5

PREVIOUS MONUMENTS

P.K/WASHER

MINE SPK.

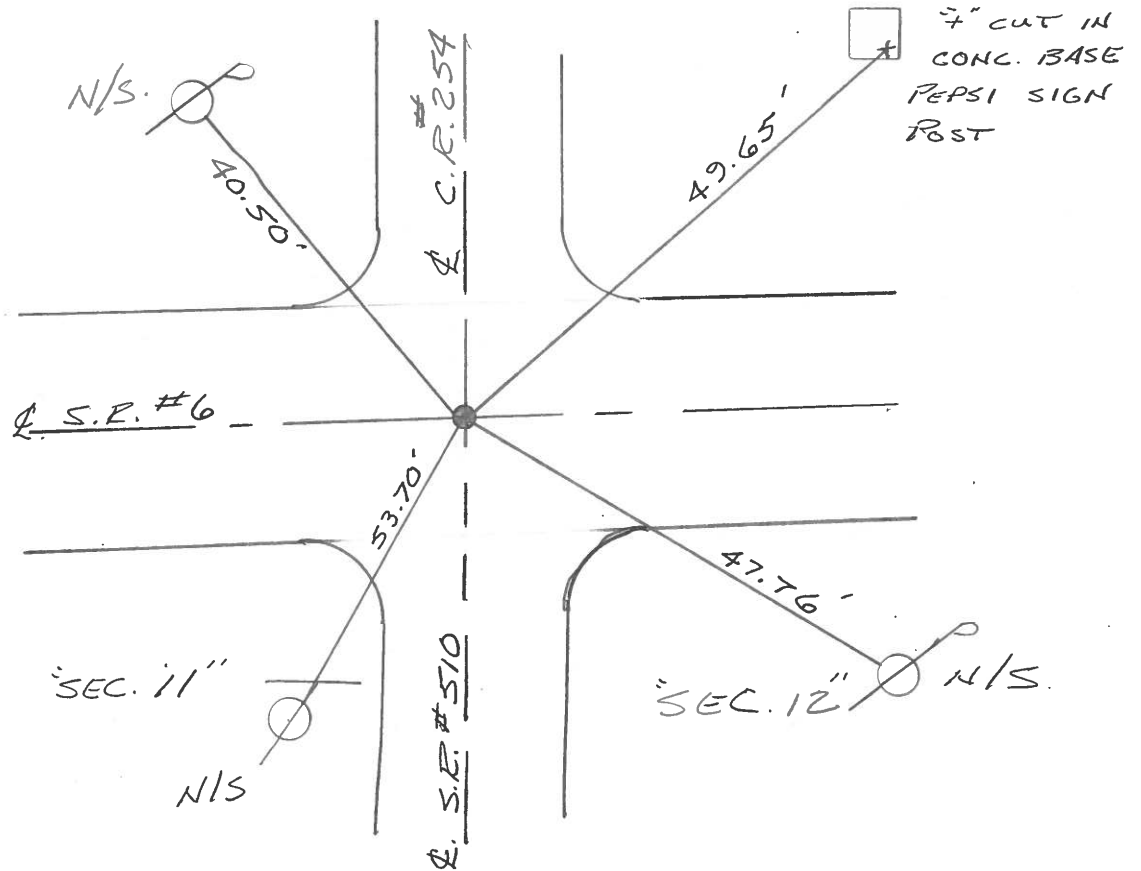

PERSONNEL	TITLE	PERSONNEL	TITLE
1	2	3	4
5	6	7	8
9	10	11	12
13	14	15	16
17	18	19	20
21	22	23	24
25	26	27	28
29	30	31	32
33	34	35	36
37	38	39	40
41	42	43	44
45	46	47	48
49	50	51	52
53	54	55	56
57	58	59	60
61	62	63	64
65	66	67	68
69	70	71	72
73	74	75	76
77	78	79	80
81	82	83	84
85	86	87	88
89	90	91	92
93	94	95	96
97	98	99	100

COUNTY Sandwich DATE 7/29/75

S. R. 6 WEATHER Sunny

SEC. I - Fremont - East TEMP. 84°

DESCRIPTION Ties for Control 1047's JOB NO.

LEFT

CENTER LINE

RIGHT

CHENEY
RIPPLE
BARBOUR

12
40

PEPSI Sec

Play Two

Rec'd P.K. Wash. -
8/13/79 Cloudy 75°

 $1356 + 56$

154-155

57/1000 1000-01

1992

Reel 12 WASHER

9-16-1991

1.5' 5.0 6.0 7.0

Reset PK to Warsaw
cloudy 8/13/79 75°

P.T. Borch

500 - 23.64 / 25.02 /

13-13-4 10 37

5/1	1000	1000
-----	------	------

1341+85

P.T. Convey 1/2

1014-22,47

62-12064X-5021

1743-10-13

1	2	3	100
---	---	---	---	---	---	---	---	---	----	----	-----

RE-SET 9-16-21

PREWACHKE 35

100-443887-1

delineator.

1' above ground new

~~79.81~~

~~X~~ in


M. H.

7130

a above ground

2 door

PERSONNEL	TITLE	PERSONNEL	TITLE
Cronin		Schneider	
Ash		Mosser	
Geyman		Barbour	

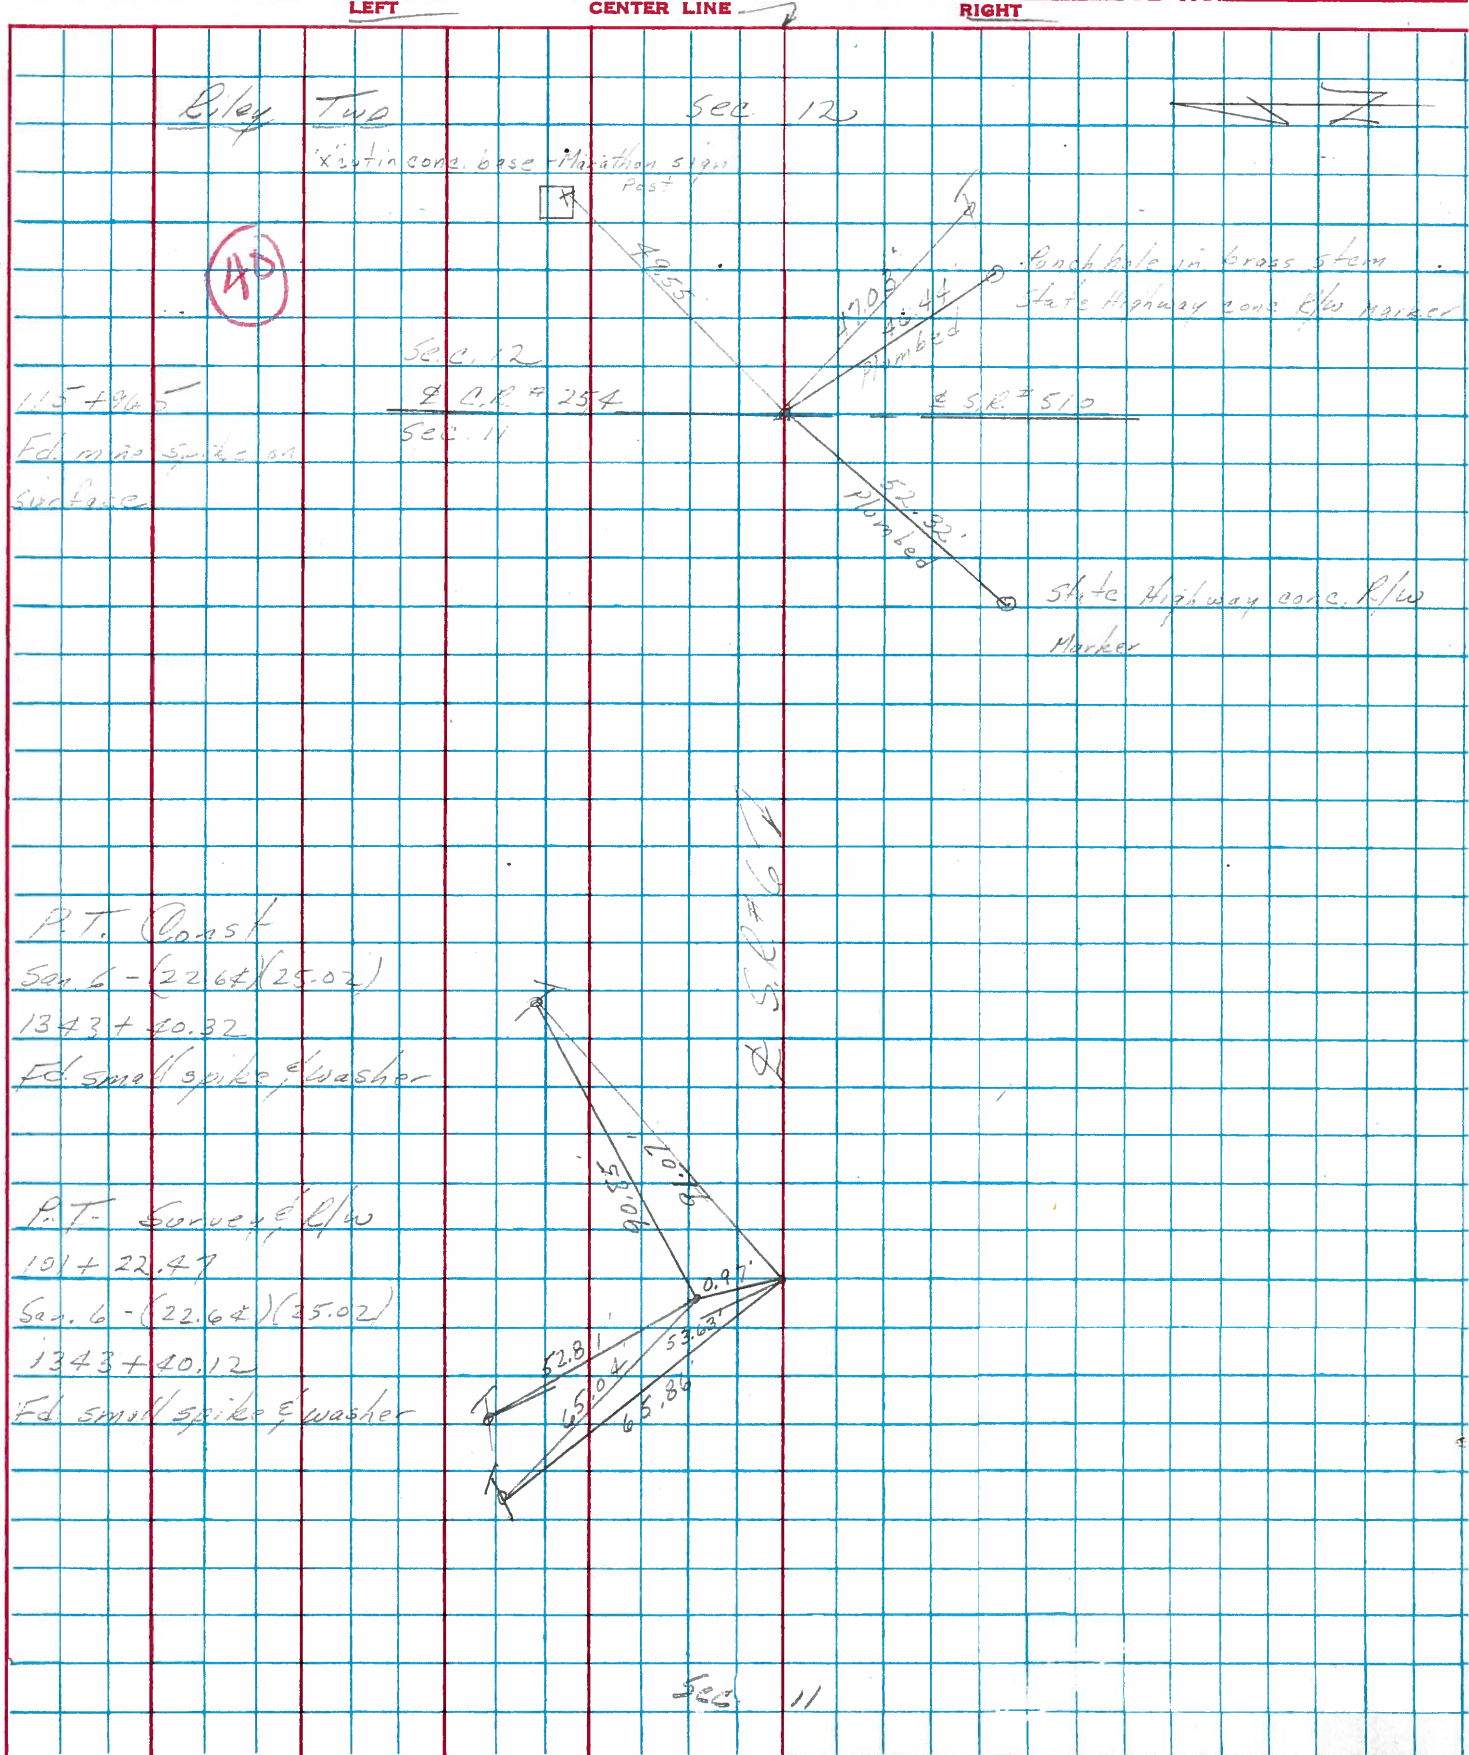COUNTY Sandusky DATE 7/29/75S. R. #6 WEATHER sunnySEC. I - Fremont-East TEMP. 84°DESCRIPTION Ties for Control Points JOB NO. _____

PERSONNEL	TITLE	PERSONNEL	TITLE
Schneider			
Mosser			
Cronin			
Barbour			

COUNTY SanduskyDATE 3-10-63S. R. U.S. #6WEATHER Cloudy-windSEC. 25.76TEMP. 25°DESCRIPTION Ties for Control Points of BridgeJOB NO.

LEFT

CENTER LINE

RIGHT

1364+00

1.00'

1361+96.25

N. & S. on E. side tree

8" Elm

63.86'

E. Const.

39.75'

50'

1361+96.25

1.00'

86.30'

20" willow

116.50'

E. Const.

116.50'

E. Survey

10" Ash

88.46'

1.00'

1360+29.75

41.54'

N. & S. on W. side pole

88.09'

30" Ash

1359+79.75

90°00'

P.I.

1357+82.70

1.00' Δ

40

PERSONNEL	TITLE	PERSONNEL	TITLE
1	2	3	4
5	6	7	8
9	10	11	12
13	14	15	16
17	18	19	20
21	22	23	24
25	26	27	28
29	30	31	32
33	34	35	36
37	38	39	40
41	42	43	44
45	46	47	48
49	50	51	52
53	54	55	56
57	58	59	60
61	62	63	64
65	66	67	68
69	70	71	72
73	74	75	76
77	78	79	80
81	82	83	84
85	86	87	88
89	90	91	92
93	94	95	96
97	98	99	100

COUNTY Sandwich DATE 1-11-61

S. R. 115 6 WEATHER cloudy

SEC. Raccoon Ck. Br. TEMP. 33°

DESCRIPTION	LEFT	CENTER LINE	RIGHT	JOB NO.
Tie for P.I. stations on each side Br. # 504 E 35.77				

