

O.D.O.T. DISTRICT 2 SURVEY OFFICE (USE ONLY)

PERSONNEL


REFERENCE NO. 22A

NOTES NIESE DATE 3/20/24
H.C. NIESE WEATHER FAIR
R.C. PRESTON-COLVIN TEMP. 69°

ROUTE SR 53
COUNTY SANDUSKY
TOWNSHIP SANDUSKY
SECTION 27 (FRAC.)
T 5 N R 15 E

DWG BY BARRIERE PID 110039

TYPE MONUMENT MONBOX W/ 1" IPIN
ON SURFACE - BELOW ON
OFFSET $\varnothing$ PAVEMENT ON

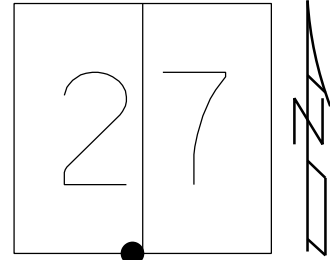

STATION: 414+78.85

HORZ.DATUM: OH NORTH/SAN OCCS GEOID: 18

GRID: NORTHING: 618013.660 EASTING: 1799008.810

LDP: NORTHING: 313996.108 EASTING: 159253.160

RECORD:
FD MONBOX
W/ 1" IPIN
REF22A
UNKNOWN ORIGIN
3/20/24, TDN

