

O.D.O.T. DISTRICT 2 SURVEY OFFICE (USE ONLY)

PERSONNEL


REFERENCE NO. 22B

NOTES NIESE DATE 3/20/24
H.C. NIESE WEATHER FAIR
R.C. PRESTON-COLVIN TEMP. 69°

ROUTE SR 53
COUNTY SANDUSKY
TOWNSHIP SANDUSKY
SECTION 27 (FRAC.)
T 5 N R 15 E

DWG BY BARRIERE PID 110039

TYPE MONUMENT 1" SQUARE IRON PIN
ON SURFACE - BELOW ON
OFFSET $\varnothing$ PAVEMENT 21' RT

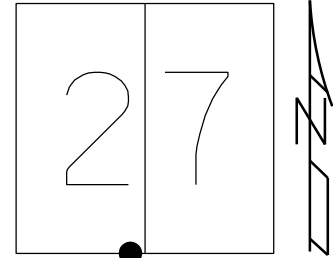

STATION: 414+83.92

HORIZ.DATUM: OH NORTH/SAN OCCS GEOID: 18

GRID: NORTHING: 618013.660 EASTING: 1799008.810

LDP: NORTHING: 313996.108 EASTING: 159253.160

RECORD:
FD 1" SQUARE IPIN
REF22B
UNKNOWN ORIGIN
(*POSS. ON OLD
R/W LINE:
SAN-53-10.15-1953)
3/20/24, TDN

