

O.D.O.T. DISTRICT 2 SURVEY OFFICE (USE ONLY)

PERSONNEL


REFERENCE NO. 1

SHEET 1 OF 11

NOTES MILLER DATE 8/7/24
H.C. MILLER WEATHER SUNNY
R.C. BARRIERE TEMP. 70
BLUBAUGH, ASTON, PRESTON-COLVIN
DWG BY BLUBAUGH PID 114849

ROUTE SR 101
COUNTY SANDUSKY
TOWNSHIP GREEN CREEK
SECTION 35
T 4 N R 16 E


TYPE MONUMENT 5/8" IPIN
~~ON SURFACE~~ - BELOW 6.5"
OFFSET Q PAVEMENT 10.5' LT : ~~RT~~
- TO - EDGE PAVEMENT
STATION: 0+00

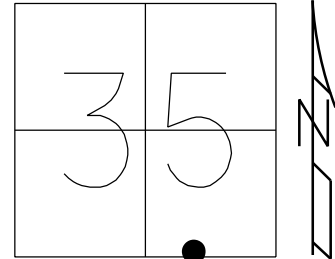

HORZ.DATUM: NAD83 2011 GEOID: NAVD88-2018
GRID: NORTHING: 579407.932 EASTING: 1836662.427
LDP: NORTHING: 275647.428 EASTING: 197174.603

RECORD:
P.I. STA.0+00
FD IPIN
5" DOWN
SET P.K./WASHER
10/1/92
SET MAG/WASHER
10/15/08, DCH
FD P.K./WASHER ATOP
IPIN, 5" DOWN
10/7/09, DCH
FD 5/8" IPIN
6.5" DOWN
REF1
6/16/16, JFO
FD HOLE W/IPIN
9/12/17, JMR
REF1
12/11/23, JAM
FD TONE. DID NOT
UNCOVER. PAINTED
8/7/24, JAM

NOTE: REF 66 SEN CO.

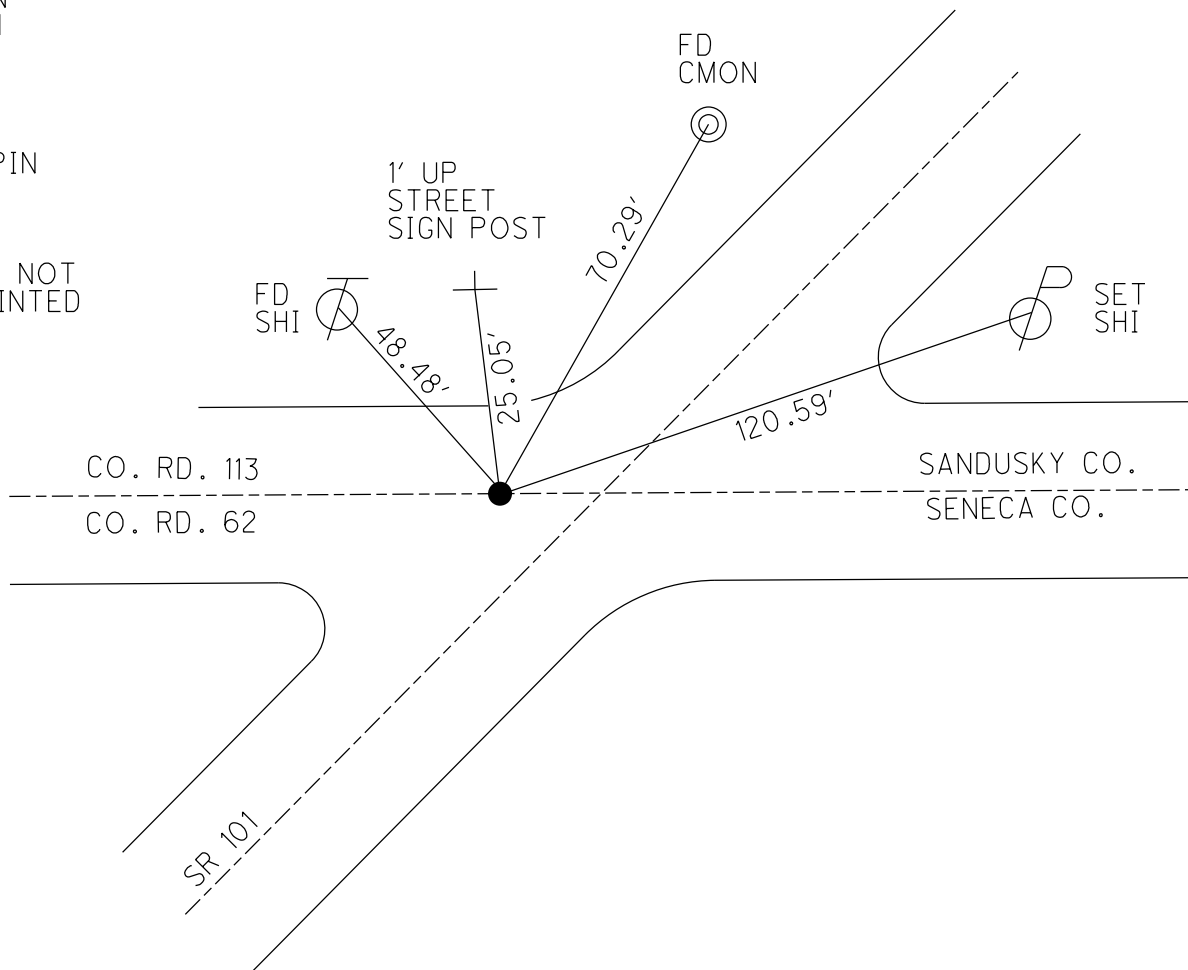

O.D.O.T. DISTRICT 2 SURVEY OFFICE (USE ONLY)

PERSONNEL

REFERENCE NO. 1

SHEET 1 OF 11


NOTES
H.C. RHOADES
R.C. O'DONNELL
HELDMAN

DATE 3/28/17
WEATHER CLOUDY
TEMP. 43°

ROUTE SR 101
COUNTY SANDUSKY
TOWNSHIP GREEN CREEK
SECTION 35
T 4 N R 16 E


TYPE MONUMENT 5/8" IPIN
~~ON SURFACE~~ - BELOW 6.5"
LEFT - ℄ PAV'T - ~~RIGHT~~ 10.5'
- TO - EDGE PAVEMENT
S.L.M. 0+00

GRID: NORTHING: 579407.932 EASTING: 1836662.427

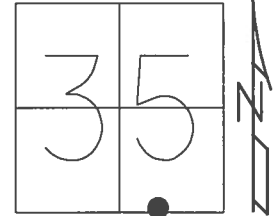

RECORD:
P.I. STA. 0+00
FD IPIN
5" DOWN
SET P.K./WASHER
10/1/92
SET MAG/WASHER
10/15/08, DCH
FD P.K./WASHER ATOP
IPIN, 5" DOWN
10/7/09, DCH
FD 5/8" IPIN
6.5" DOWN
REF1
6/16/16, JFO
FD HOLE W/IPIN
9/12/17, JMR


NOTE: REF 66 SEN CO.

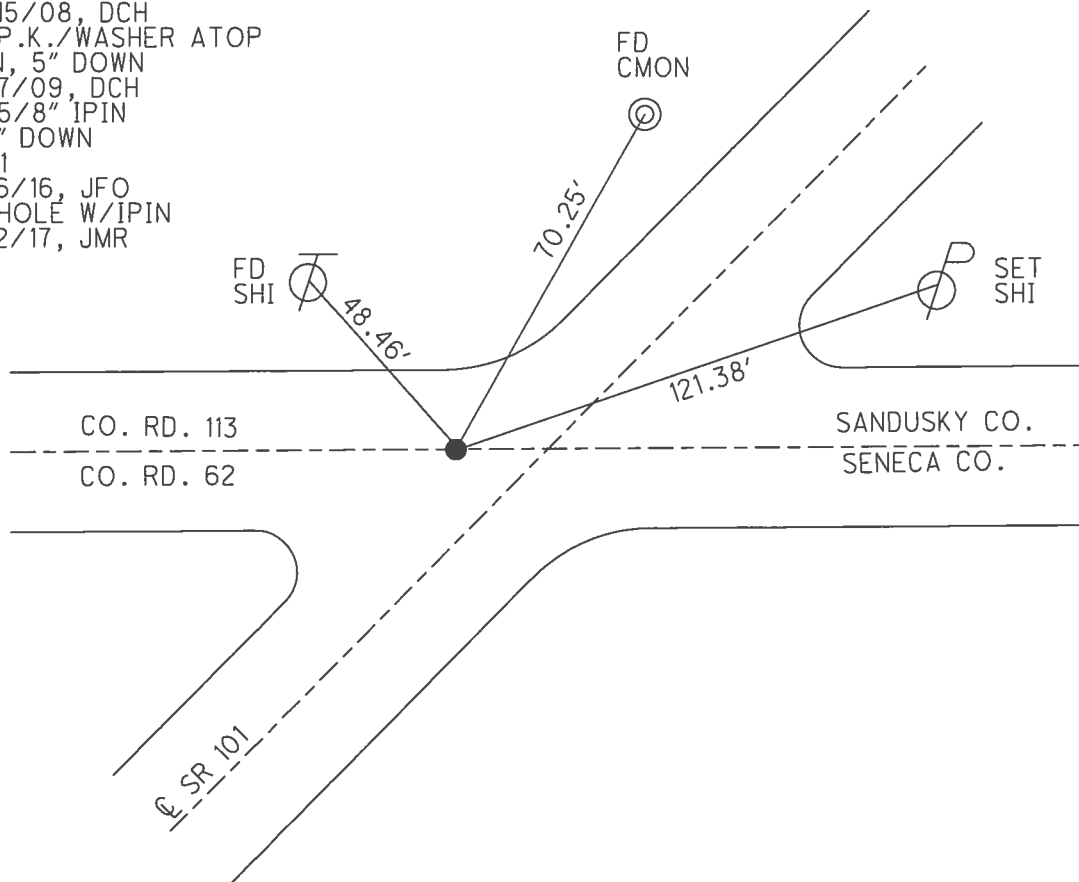

O.D.O.T. DISTRICT 2 SURVEY OFFICE (USE ONLY)


PERSONNEL _____ REFERENCE NO. 1 SHEET 1 OF 10
 NOTES HOMAN DATE 6-26-2008 ROUTE SR 101
 H.C. ROUSOS WEATHER CLOUDY COUNTY SANDUSKY
 R.C. HOMAN TEMP. 85° TOWNSHIP GREEN CREEK
 SECTION 35
 T 4 N R 16 E

TYPE MONUMENT MAG/WASHER
 ON SURFACE - ~~BELOW~~ ON
 LEFT - ℄ PAV'T - ~~RIGHT~~ 10.5'
- TO - EDGE PAVEMENT
 S.L.M. 0+00
 GRID: NORTHING: - EASTING: -

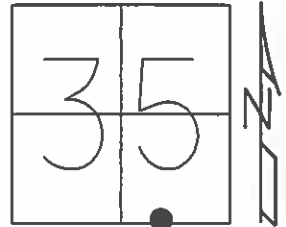

RECORD:
 P.I. STA. 0+00
 SET P.K./WASHER
 10/1/92

SET MAG/WASHER
 10/15/08

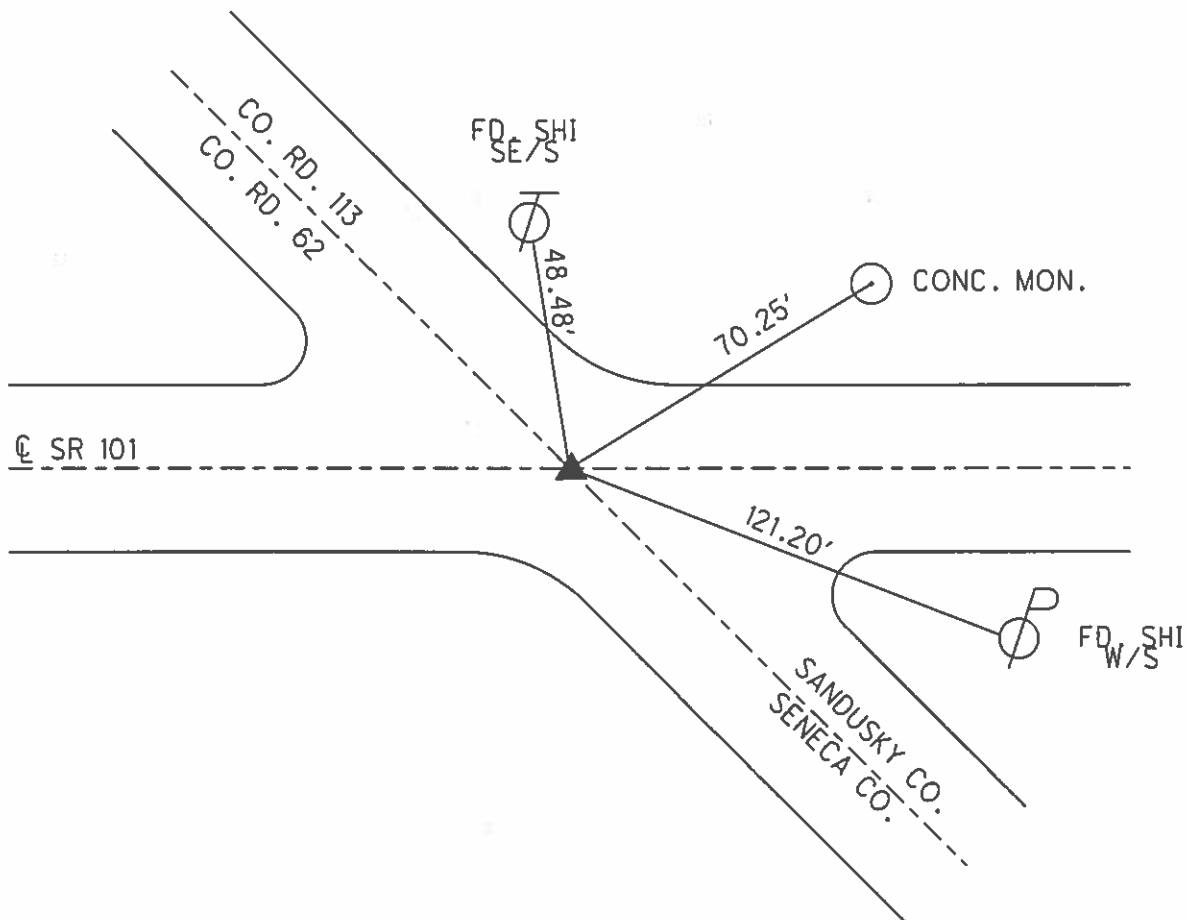

O.D.O.T. DISTRICT 2 SURVEY OFFICE

PERSONNEL

REFERENCE NO. 1

SHEET 1 OF 10

NOTES Cheney

H.C. RIPPLE

R.C. BARBOUR

DATE 10-1-92

WEATHER SUNNY

TEMP. 70°

ROUTE SR#101

COUNTY SANDUSKY

TOWNSHIP Green Creek

SECTION #35

T4 NR 16 E

TYPE MONUMENT P.K. & WASHER


ON SURFACE - ~~BELOW~~ YES

LEFT- & PAV'T. - ~~RIGHT~~ 10.5'


TO EDGE PAVEMENT


S.L.M. 0+00

1

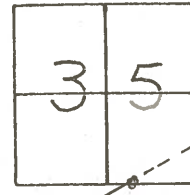

Record: P.I. sta 0+00

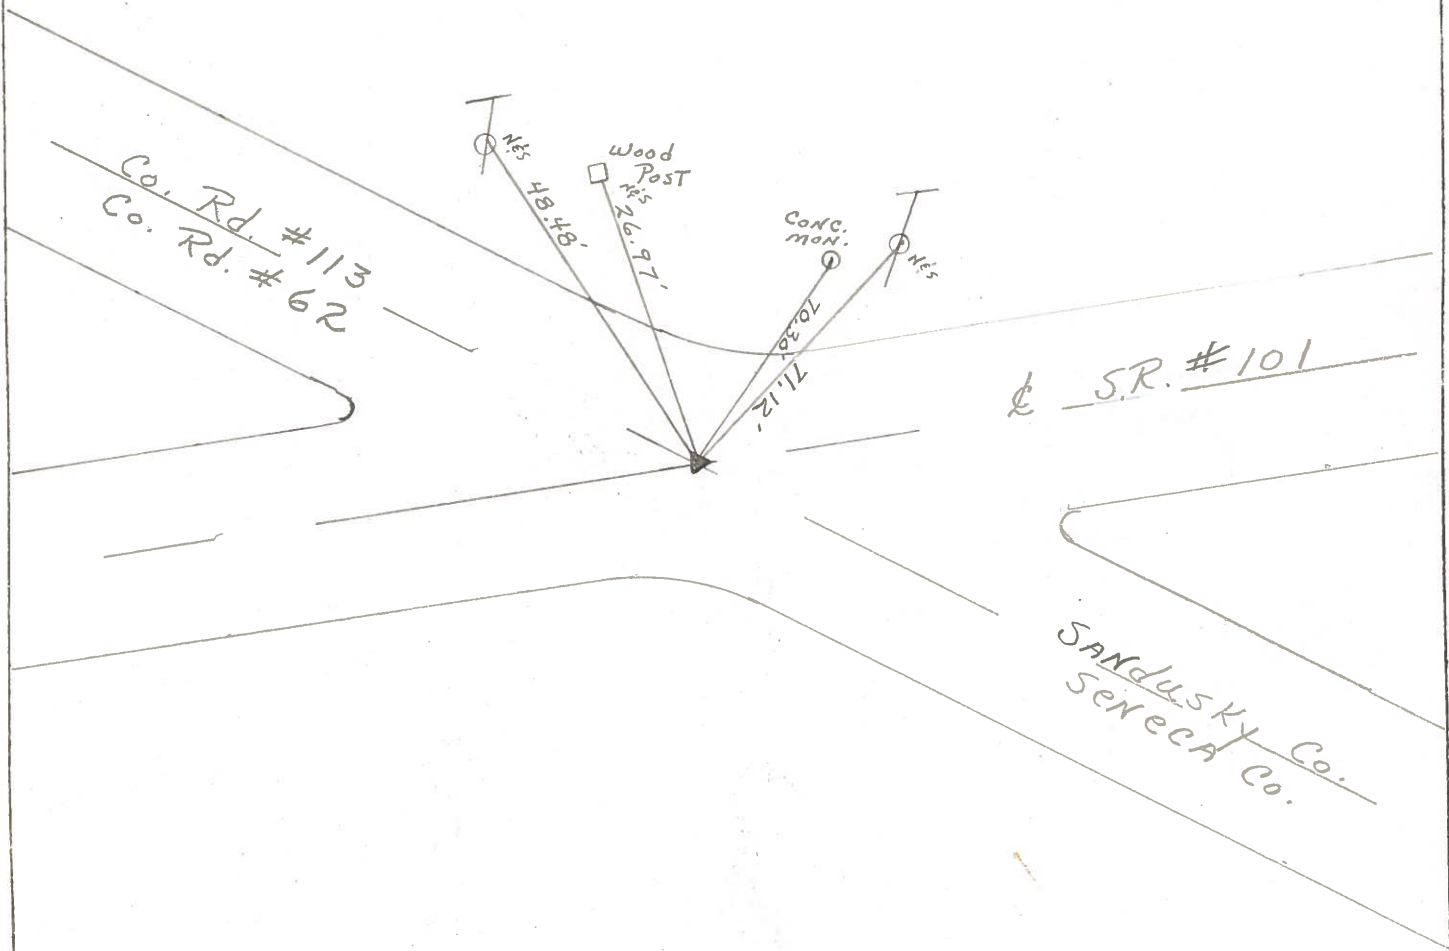

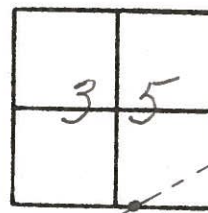County Sandusky S.R. #101Township Green CreekSection #35T 4 N, R 16 EPersonnel CroninRippleGeymanBarbourDate 11/17/83Weather overcastTemp. 34°

#1

conc. mon
71.12'
10.30'

wood post 26.97'

48.48'

Co. Rd. #113
Co. Rd. #62Sandusky Co.
Seneca Co.

P.I.


0+00

Fd. P.K. & washer on
surface 10.5' Lt & Paint

S.R. #101

PERSONNEL	TITLE	PERSONNEL	TITLE	COUNTY	DATE	WEATHER	TEMP.
Schneider				Sandusky	Feb. 29, 1968	Cloudy-snow	25'
Mosser				S. R. # 101			
Barbour				SEC. Sen-5 n . Line North			
Potts							

DESCRIPTION Ties for Control P 3 JOB NO. _____

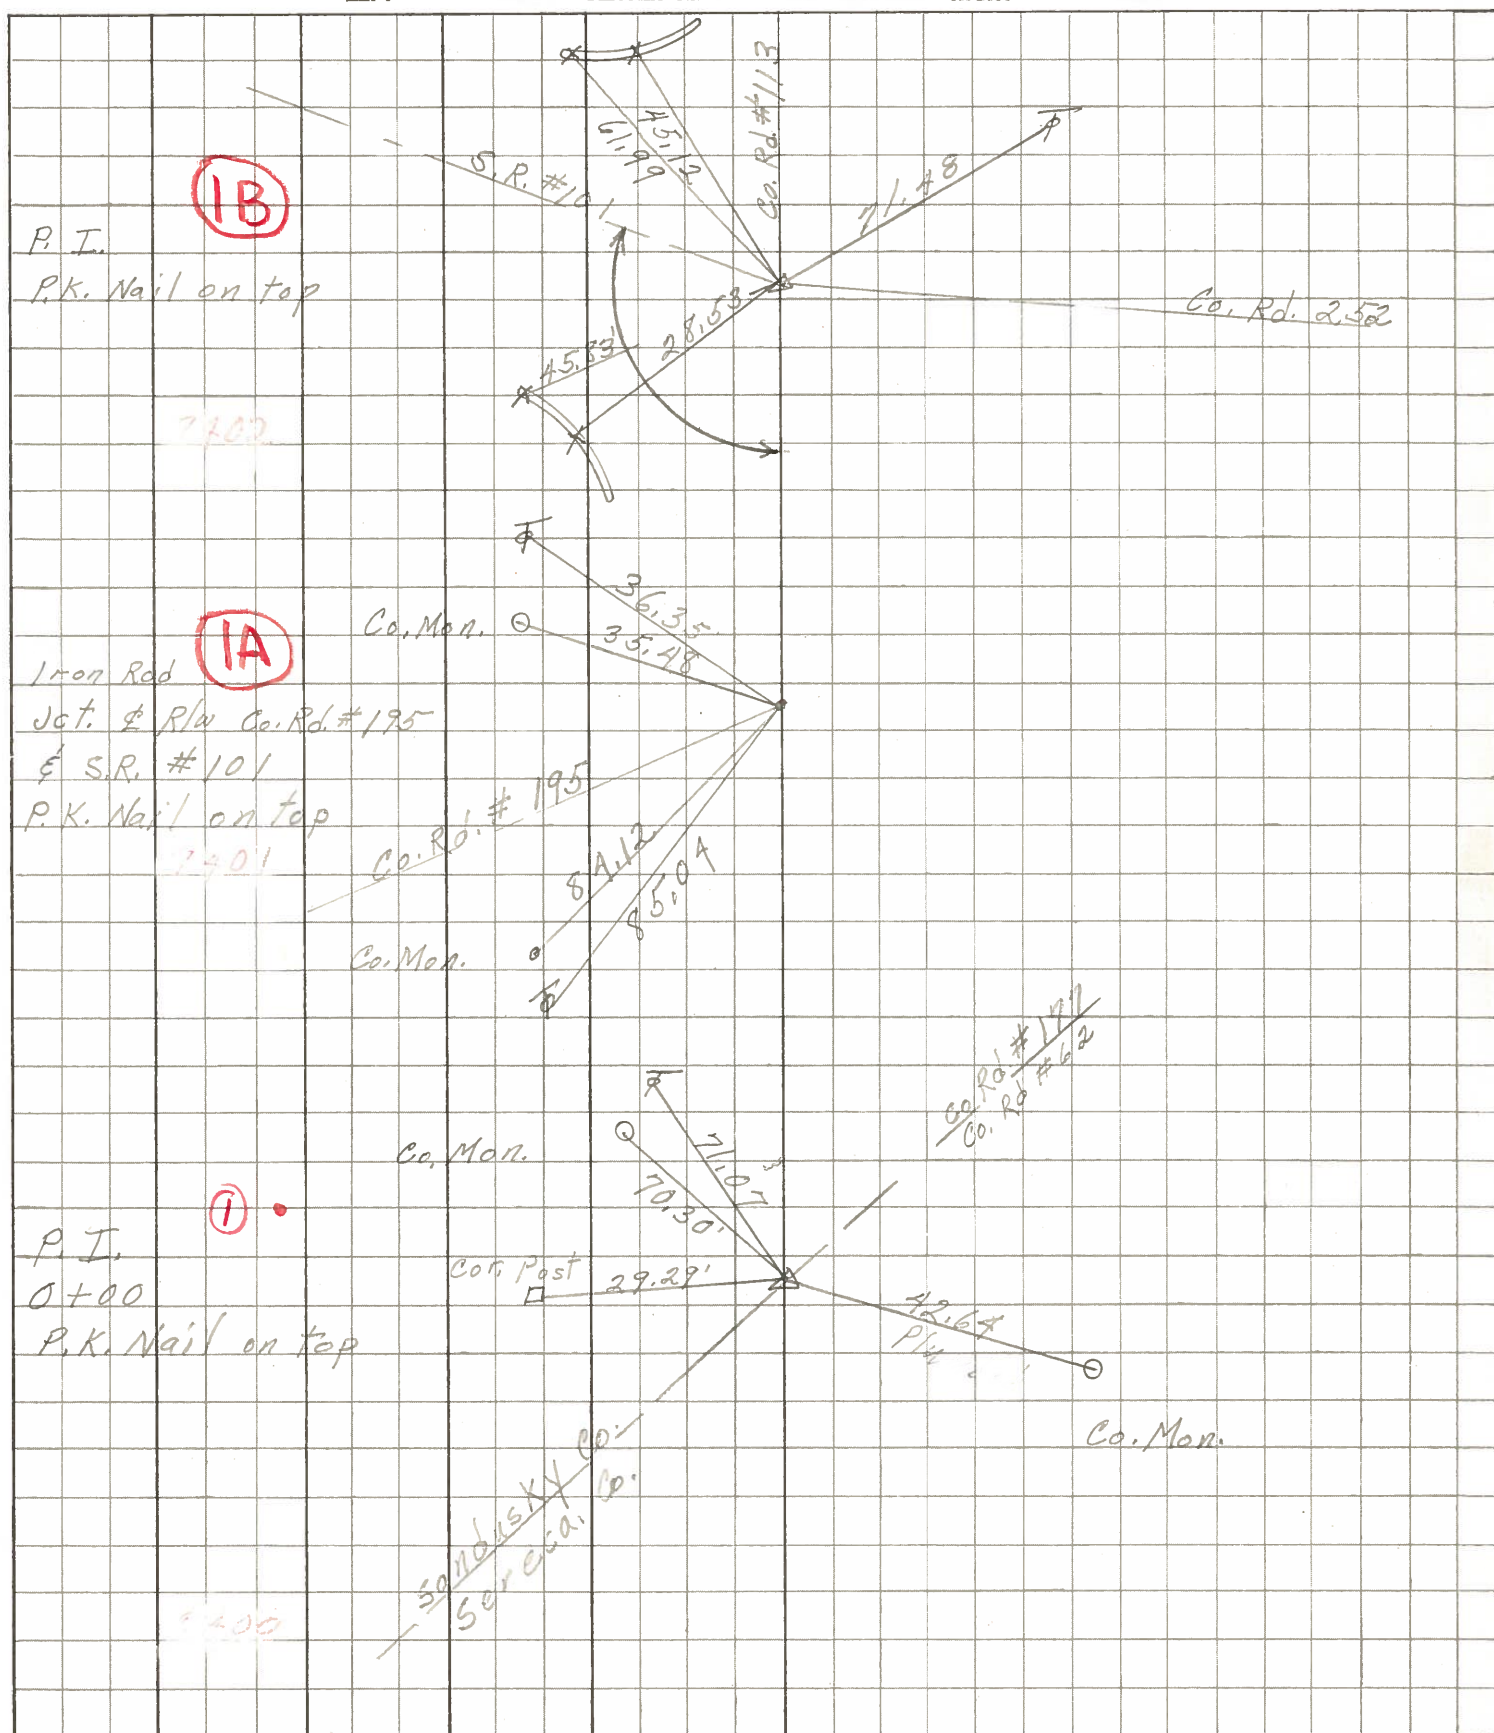

PERSONNEL TITLE PERSONNEL TITLE

COUNTY Sandusky DATE 3-4-64

PERSONNEL TITLE PERSONNEL TITLE S. R. 101 WEATHER

PERSONNEL TITLE PERSONNEL TITLE SEC. TEMP.

DESCRIPTION Seneca Co Line to N.P. & ST.L. RR JOB NO.

LEFT


CENTER LINE

RIGHT

0+00

P.I. $\Delta = 12^\circ 50' RT$

Iron pin (1)

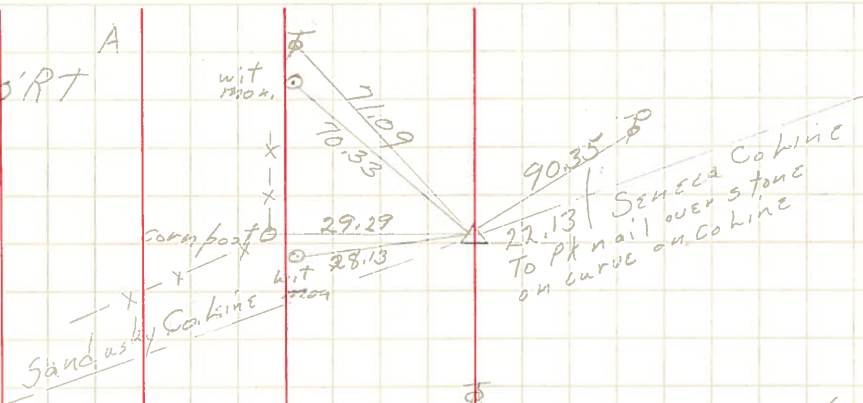

old sta 272+14.1


old $\Delta = 13^\circ 10' RT$

New sta 0+00

New $\Delta = 12^\circ 50' RT$ 

PK nail over stone on Co Line

B

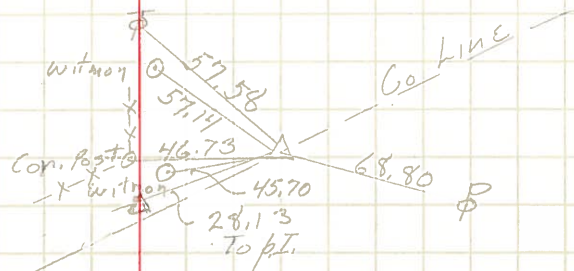


(1A)

6+49.78

P.O.T.

R.R. spike

C

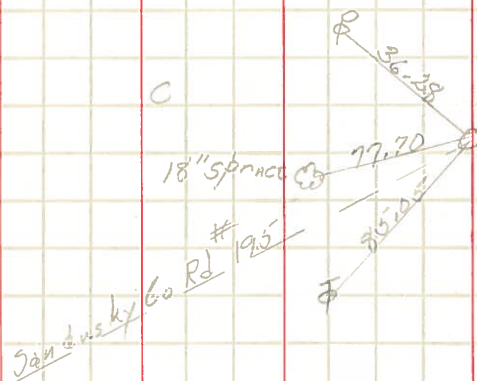

(1B)

12+81.85

P.I. $\Delta = 114^\circ 19' 30'' LT$

R.R. spike

S.R. 101

D

