


O.D.O.T. DISTRICT 2 SURVEY OFFICE (USE ONLY)


PERSONNEL	REFERENCE NO. <u>3</u>	SHEET <u>5</u> OF <u>11</u>
NOTES <u>MILLER</u>	DATE <u>8/7/24</u>	ROUTE <u>SR 101</u>
H.C. <u>MILLER</u>	WEATHER <u>SUNNY</u>	COUNTY <u>SANDUSKY</u>
R.C. <u>BARRIERE</u>	TEMP. <u>70</u>	TOWNSHIP <u>GREEN CREEK</u>
<u>BARRIERE, ASTON, PRESTON-COLVIN</u>		SECTION <u>35</u>
DWG BY <u>MILLER</u>	PID <u>114849</u>	T <u>4</u> N R <u>16</u> E

TYPE MONUMENT MAG NAIL
~~ON SURFACE~~ - BELOW 1.5"
 OFFSET Q PAVEMENT 2' ~~LT~~ : RT
TO EDGE PAVEMENT
 STATION: 60+46

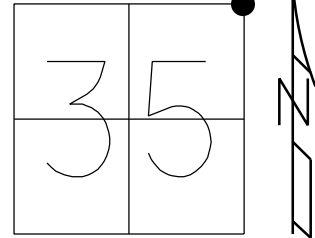

HORZ.DATUM: <u>NAD83 2011</u>	GEOID: <u>NAVD88-2018</u>
GRID: NORTHING: <u>584691.909</u>	EASTING: <u>1837894.008</u>
LDP: NORTHING: <u>280940.279</u>	EASTING: <u>198369.821</u>

RECORD:
 FD R.R.SPIKE
 2" BELOW
 11/14/83
 SET P.K./WASHER
 10/1/92
 FD R.R.SPIKE
 4" DOWN
 6/30/08, DCH
 SET MAG/WASHER
 10/16/08
 FD MAG NAIL
 1" DOWN
 REF3
 6/16/16, JFO
 UNCOVERED
 9/12/17, JMR
 FD MAG NAIL
 1" DOWN
 REF3
 12/11/23, JAM
 FD TONE DID NOT
 UNCOVER, PAINTED.
 8/7/24, JAM

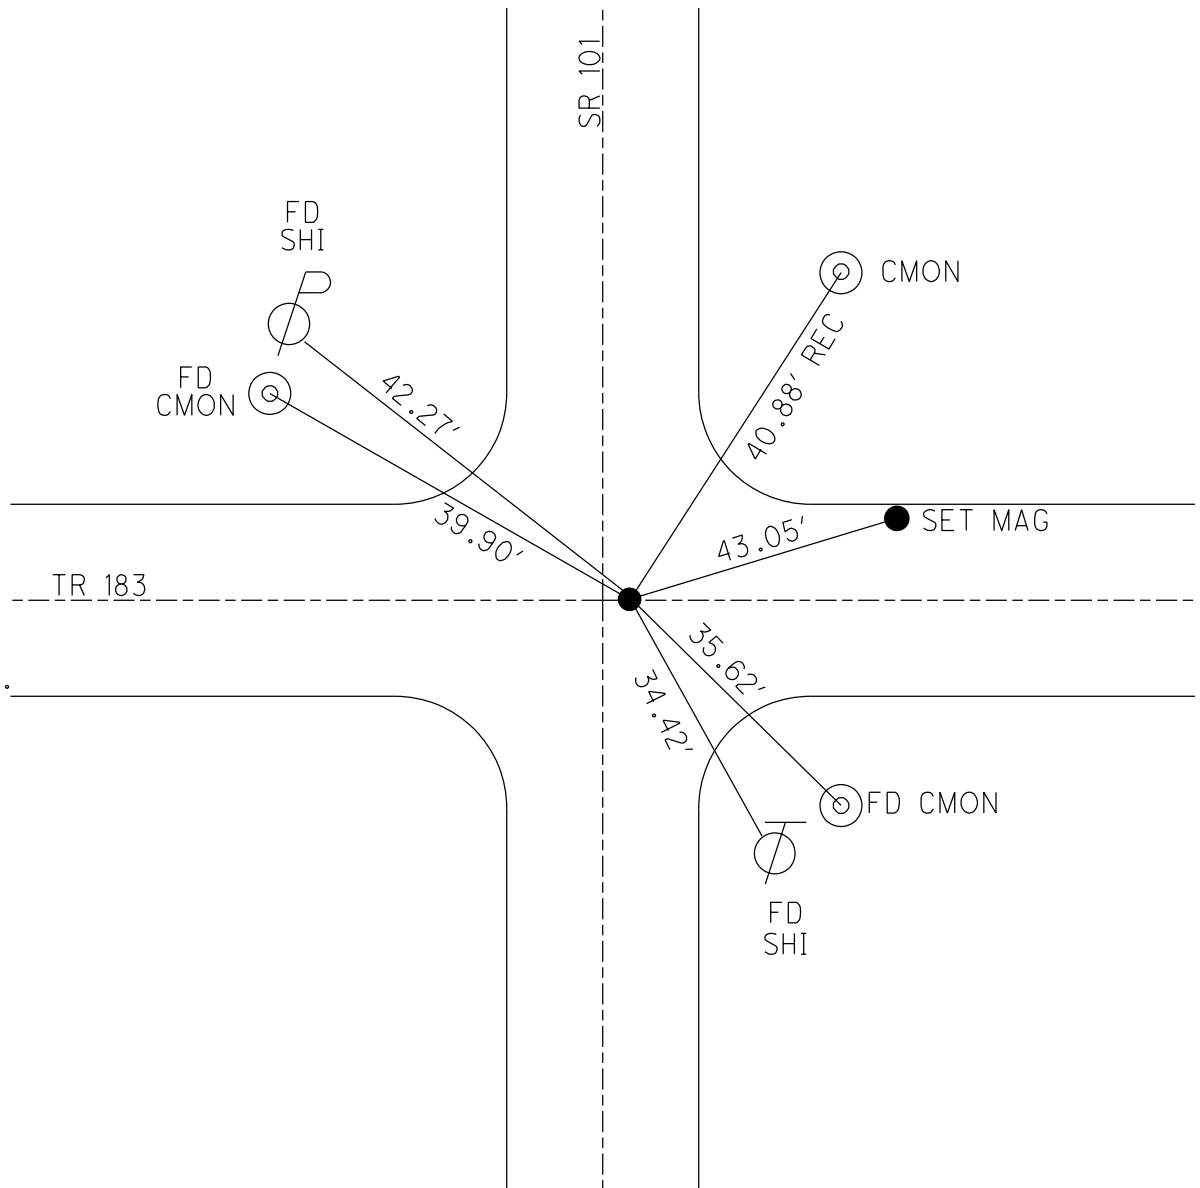

O.D.O.T. DISTRICT 2 SURVEY OFFICE (USE ONLY)

PERSONNEL

REFERENCE NO. 3

SHEET 5 OF 11

NOTES

RHOADES

DATE

3/28/17

ROUTE

SR 101

H.C.

O'DONNELL

WEATHER

MIST

COUNTY

SANDUSKY

R.C.

HELDMAN

TEMP.

43°

TOWNSHIP

GREEN CREEK

SECTION

35, 36

T 4 N R 16 E

TYPE MONUMENT

MAG NAIL

~~ON SURFACE~~ - BELOW

1"

~~LEFT~~ - Q PAV'T - RIGHT


2'

- TO - EDGE PAVEMENT

S.L.M.

60+46

GRID: NORTHING: 584691.909 EASTING: 1837894.008

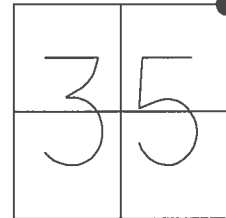

RECORD:

FD R.R.SPIKE

2" BELOW

11/14/83

SET P.K./WASHER

10/1/92

FD R.R.SPIKE

4" DOWN

6/30/08, DCH

SET MAG/WASHER

10/16/08

FD MAG NAIL


1" DOWN

REF3

6/16/16, JFO

UNCOVERED

9/12/17, JMR

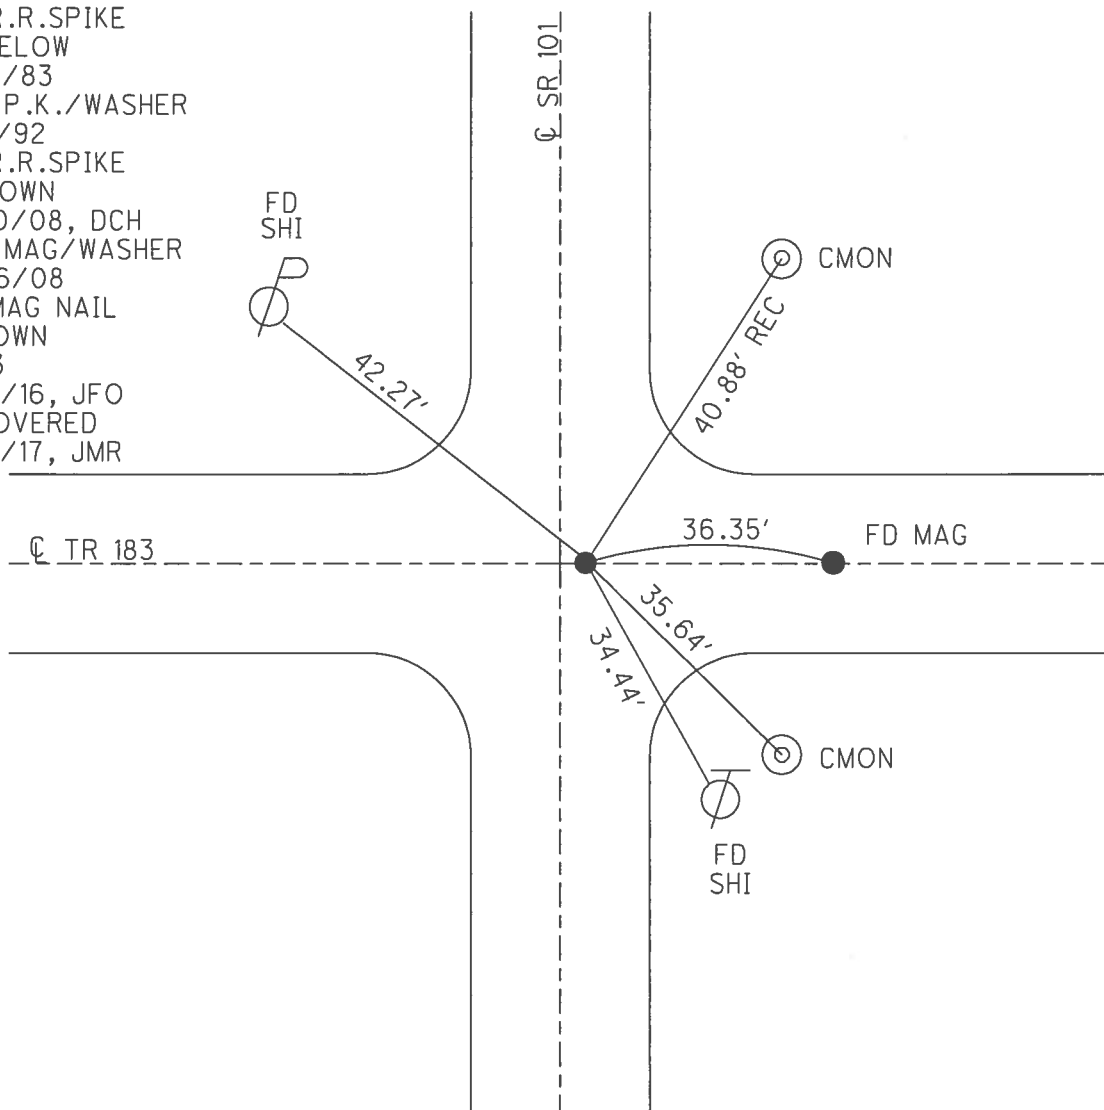

O.D.O.T. DISTRICT 2 SURVEY OFFICE (USE ONLY)

PERSONNEL _____ REFERENCE NO. 3 SHEET 5 OF 10
 NOTES _____ DATE 6-30-2008 ROUTE SR 101
 H.C. ROUSOS WEATHER CLOUDY/RAIN COUNTY SANDUSKY
 R.C. HOMAN TEMP. 70° F TOWNSHIP GREEN CREEK
 SECTION 35, 36
 T 4 N R 16 E

TYPE MONUMENT _____ RR SPK _____



~~ON SURFACE~~ - BELOW 4"

~~LEFT~~ - Q PAV'T - RIGHT 2'

- TO - EDGE PAVEMENT

S.L.M. 60+46

GRID: NORTHING: 584691.935 EASTING: 1837893.899

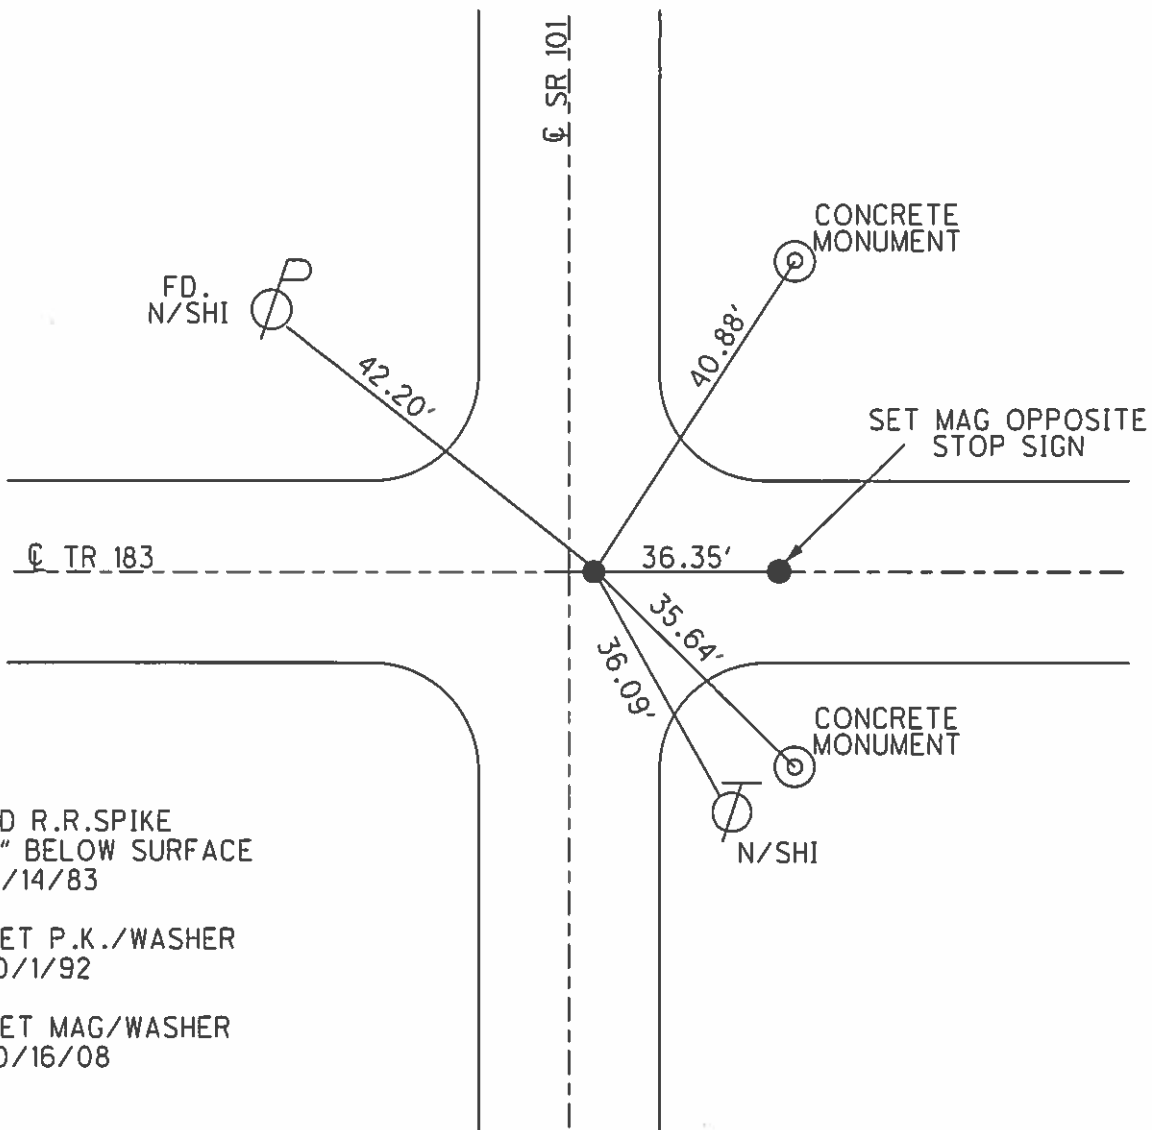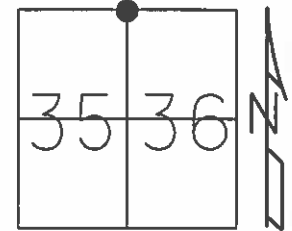

FD R.R. SPIKE
2" BELOW SURFACE
11/14/83

SET P.K./WASHER
10/1/92

SET MAG/WASHER
10/16/08

O.D.O.T. DISTRICT 2 SURVEY OFFICE

PERSONNEL

REFERENCE NO. # 3

SHEET 5 OF 10

NOTES Cheney

H.C. Rippl'e

R.C. Barbour

DATE 10-1-92

WEATHER SUNNY

TEMP. 70°

ROUTE SR#101

COUNTY SANDUSKY

TOWNSHIP GREEN CREEK

SECTION 35 & 36

T 4 N R 16 E

TYPE MONUMENT R.R. SPK.

~~ON SURFACE~~ - BELOW 4"


~~LEFT - C PAV'T.~~ - RIGHT 3' RT. & Pav't.

TO EDGE PAVEMENT


S.L.M. 60+46

Re-set
PK/washer
10-1-92

③

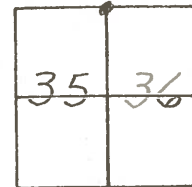


Record: Fd R.R. SPK 2"
Below surface 11-14-83

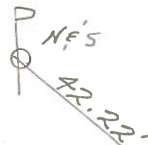


Tw. Rd. #183


36.15'

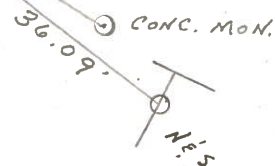

SR #101

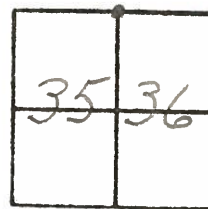County Sandusky S.R. # 101Township Green CreekSection N.E. $\frac{1}{4}$ Sec. 35 - N.W. $\frac{1}{4}$ Sec. 36T 4 N, R 16 EPersonnel CroninRippleGeymanBarkourDate 11/14/83Weather sunny - windyTemp. 42°

#3

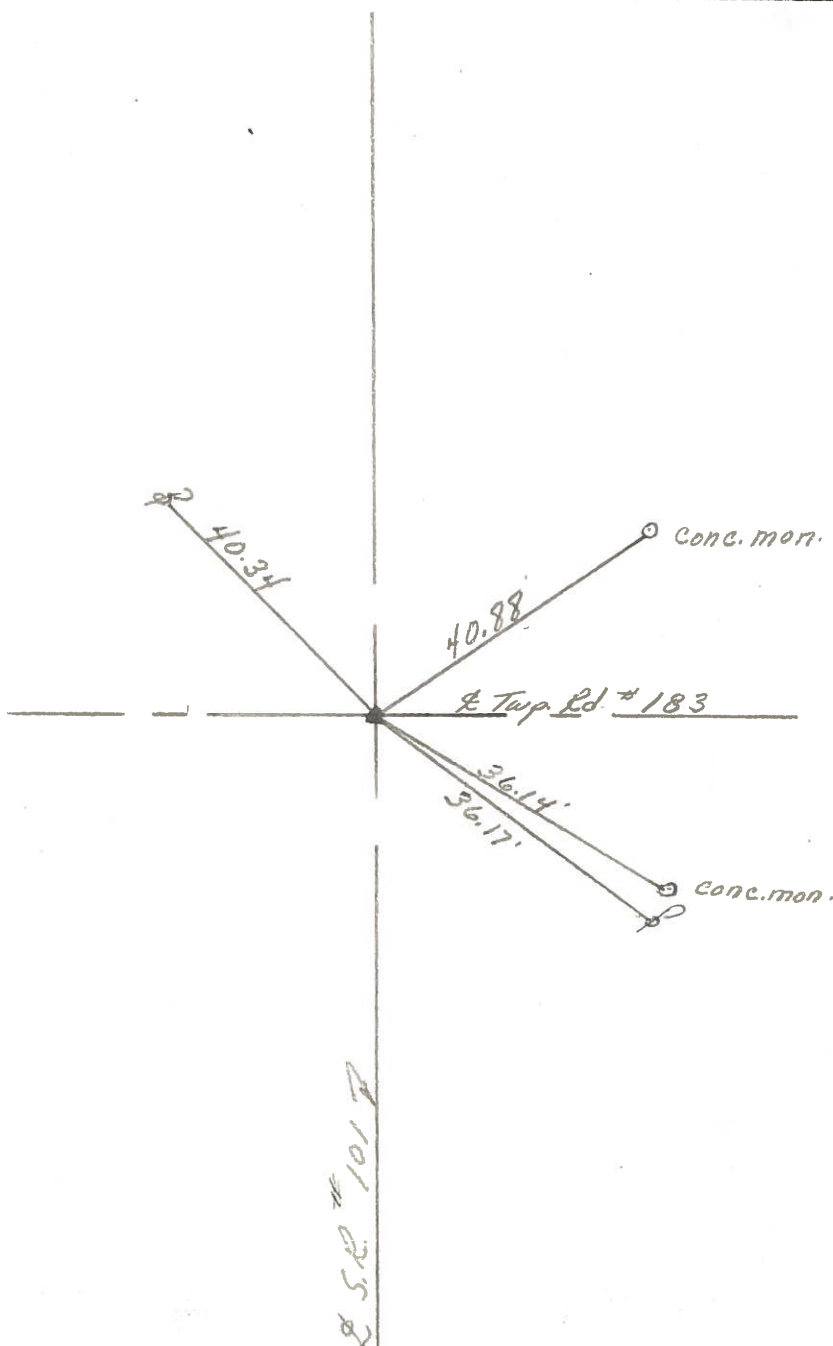

1" P.L. spike 2"
below surface. 2.6'
at 1st point.

PERSONNEL TITLE PERSONNEL TITLE

SchneiderCOUNTY SanduskyDATE Feb. 29, 1968MosserS. R. # 101WEATHER Cloudy & snowBarbourSEC. Sen. - San. Co. Line North TEMP. 25°PottsDESCRIPTION Ties for Control Points

JOB NO.

LEFT

CENTER LINE

RIGHT

Center of sec- 26 E

(3)

P. I.

R.R. spk. Rt. of &

on top

Co. Mon.

Co. Mon.

Co. Rd # 183

Co. Mon.

(2)

P. I. Iron Pin

Center sec- 35 & 36

13.1' south of N.K.P. R.R.

1' off Rt. edge of Permit

6" down

Co. Mon.

Co. Mon.

Co. Mon.

Plumbed