

O.D.O.T. DISTRICT 2 SURVEY OFFICE (USE ONLY)

PERSONNEL

REFERENCE NO. 3A

SHEET 6 OF 11

NOTES MILLER

DATE 8/7/24

ROUTE SR 101

H.C. MILLER

WEATHER SUNNY

COUNTY SANDUSKY

R.C. BARRIERE

TEMP. 70

TOWNSHIP GREEN CREEK

BARRIERE, ASTON, PRESTON-COLVIN

SECTION 26

DWG BY MILLER

PID 114849

T 4 N R 16 E

TYPE MONUMENT MAG NAIL

ON SURFACE - ~~BELOW~~ 0.5"

OFFSET Q PAVEMENT 1.5' LT : ~~RT~~

TO EDGE PAVEMENT

STATION: 87+04

HORZ.DATUM: NAD83 2011


GEOID: NAD88 2018

GRID: NORTHING: 587349.999


EASTING: 1837917.242

LDP: NORTHING: 283598.624

EASTING: 198374.834

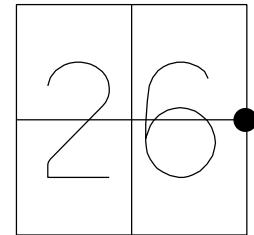

RECORD:
FD 5/8" IPIN
SET P.K./WASHER
10/1/92
FD P.K./WASHER
6/30/08, DCH
SET MAG/WASHER
9/29/08
FD MAG NAIL
REF A3
6/16/16, JFO
UNCOVERED
9/12/17, JMR
REF 3A
12/11/23, JAM
FD TONE. DID NOT
UNCOVER. PAINTED
8/7/24, JAM

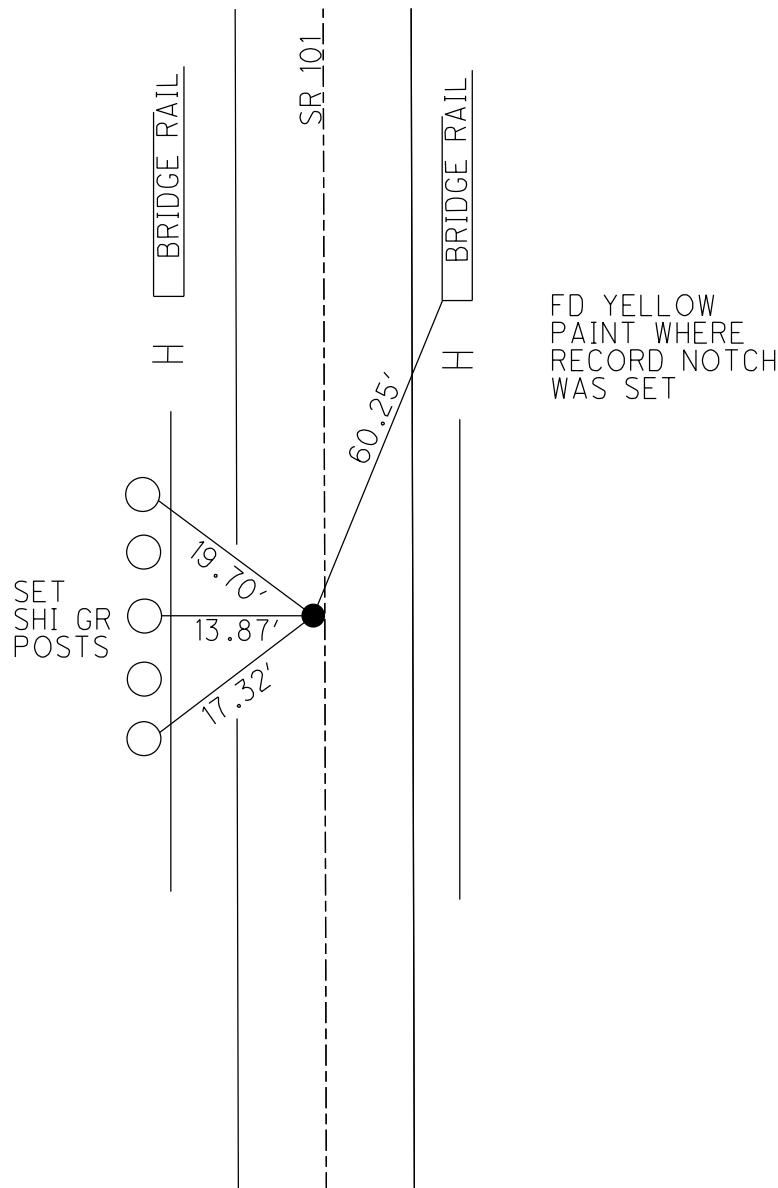


O.D.O.T. DISTRICT 2 SURVEY OFFICE (USE ONLY)


PERSONNEL _____ REFERENCE NO. 3 A SHEET 6 OF 11
NOTES HOMAN DATE 6/30/08 ROUTE SR 101
H.C. ROUSOS WEATHER CLOUDY/RAIN COUNTY SANDUSKY
R.C. HOMAN TEMP. 70° TOWNSHIP GREEN CREEK
SECTION 26
T 4 N R 16 E

TYPE MONUMENT PK/WASHER
ON SURFACE - ~~BELOW~~ ON
LEFT - ℄ PAV'T - ~~RIGHT~~ 1.5'
- TO - EDGE PAVEMENT
S.L.M. 87+04

GRID: NORTHING: 587349.999 EASTING: 1837917.242

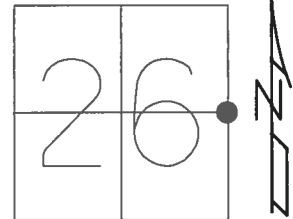

RECORD:
FD 5/8" IPIN
SET P.K./WASHER
10/1/92
FD P.K./WASHER
6/30/08, DCH
SET MAG/WASHER
9/29/08
FD MAG NAIL
REFA3
6/16/16, JFO
UNCOVERED
9/12/17, JMR

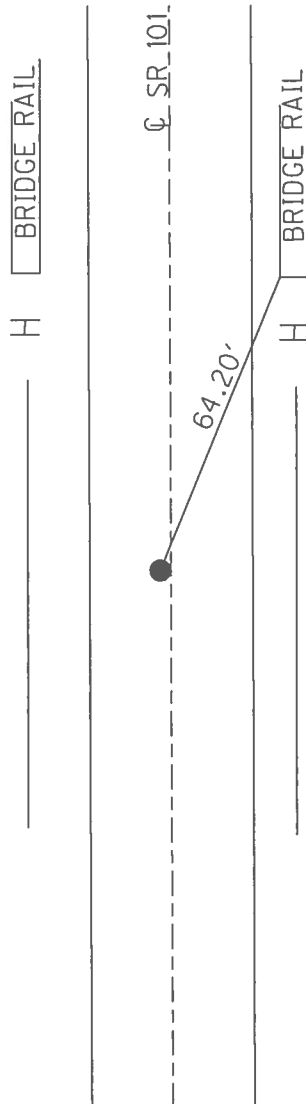


FD YELLOW
PAINT WHERE
RECORD NOTCH
WAS SET

O.D.O.T. DISTRICT 2 SURVEY OFFICE (USE ONLY)

PERSONNEL _____ REFERENCE NO. 3 A SHEET 6 OF 10
 NOTES HOMAN DATE 6-30-2008 ROUTE SR 101
 H.C. ROUSOS WEATHER CLOUDY/RAIN COUNTY SANDUSKY
 R.C. HOMAN TEMP. 70° TOWNSHIP GREEN CREEK
 _____ SECTION 24, 25
 _____ T 4 N R 16 E

TYPE MONUMENT PK/WASHER
 ON SURFACE - ~~BELOW~~ ON
 LEFT - ℄ PAV'T - ~~RIGHT~~ 1.5'
 _____ TO _____ EDGE PAVEMENT
 S.L.M. 87+04


GRID: NORTHING: 587349.716 EASTING: 1837917.212

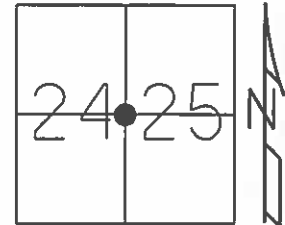

RECORD:
FD 5/8" IPIN

SET P.K./WASHER
10/1/92

SET MAG/WASHER
9/29/08

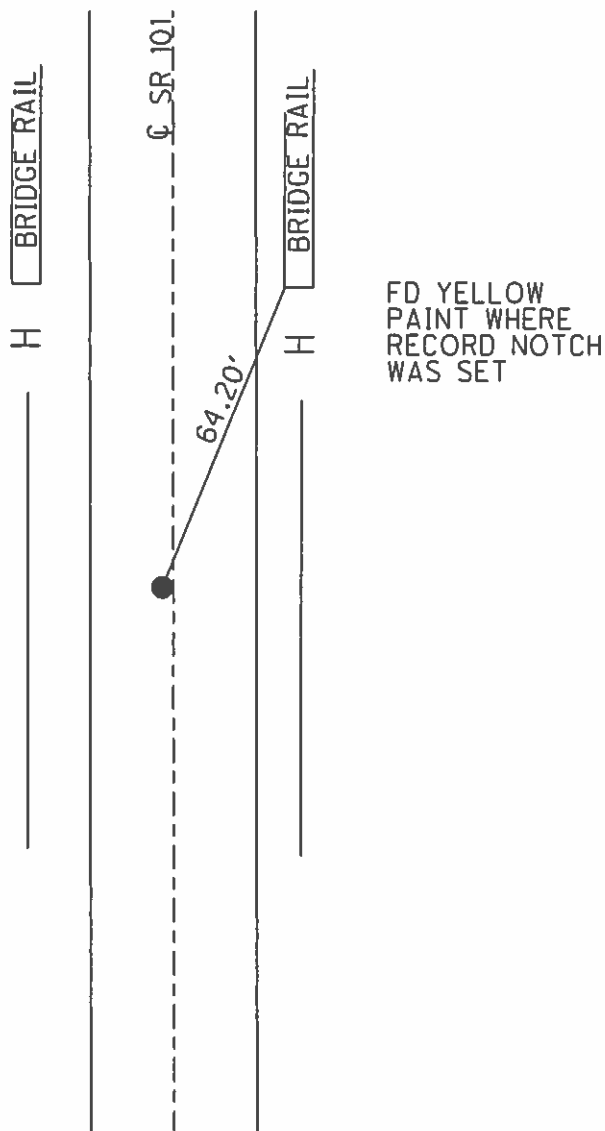

O.D.O.T. DISTRICT 2 SURVEY OFFICE

PERSONNEL

REFERENCE NO. #3A

SHEET 6 OF 10

NOTES Cheney

H.C. RIPPLE

R.C. BARBOUR

DATE 10-1-92

WEATHER SUNNY

TEMP. 70°

ROUTE SR#101

COUNTY SANDUSKY

TOWNSHIP GREEN CREEK

SECTION 24E25

T4 N R 16 E

TYPE MONUMENT 5/8" I. ROD

~~ON SURFACE~~ BELOW 2"


LEFT- & PAV'T. - RIGHT 1.0'

TO EDGE PAVEMENT


S.L.M. 87+04

Re-Set
PK/WASHER
10-1-92

3A

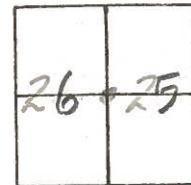

Notch (Both Sides)
1ST STEEL G.R. POST

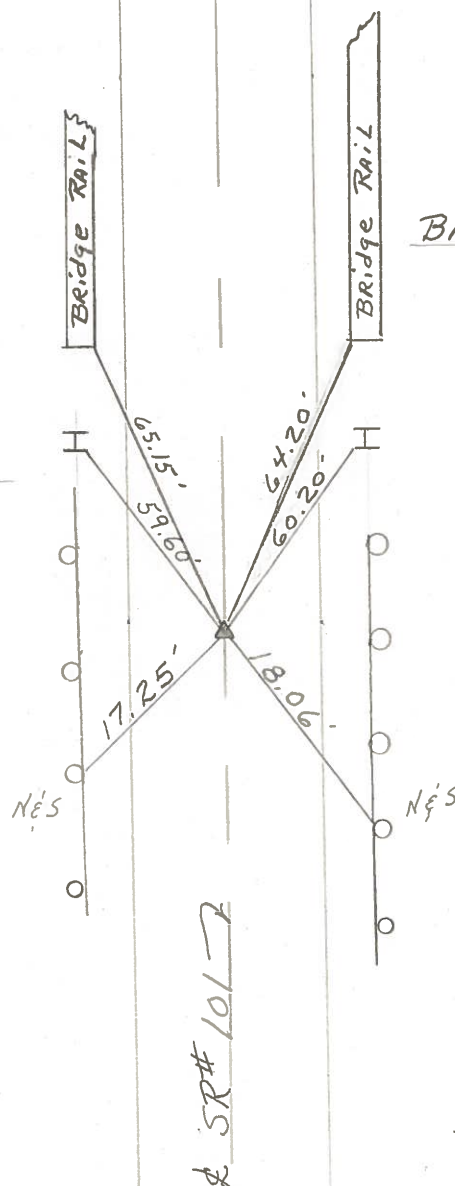

Q.D.O.T. DISTRICT 2 SURVEY OFFICE

SHEET 6 OF 10

County Sandusky S.R. #101

Township Green Creek

Section E 1/4 Post Sec. 24 - W 1/4 Post Sec. 25

T4N, R16E

Personnel Cronin

Ripple

Geyman


Barbour

#3-A

Date 11/14/83

Weather sunny - windy

Temp. 42°

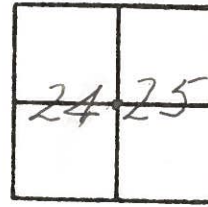

Ed 5/8 rod 2" below
surface and 10' Lt.
of E of Pkmt

