

O.D.O.T. DISTRICT 2 SURVEY OFFICE (USE ONLY)

PERSONNEL

REFERENCE NO. 4A

SHEET 8 OF 11

NOTES MILLER
H.C. MILLER
R.C. BARRIERE

DATE 8/7/24
WEATHER SUNNY
TEMP. 70

ROUTE SR 101
COUNTY SANDUSKY
TOWNSHIP GREEN CREEK
SECTION 26

BARRIERE, ASTON, PRESTON-COLVIN
DWG BY MILLER PID 114849

T 4 N R 16 E

TYPE MONUMENT MAG NAIL

~~ON SURFACE~~ - BELOW 0.5"

OFFSET CL PAVEMENT 1.5' ~~LT~~ : RT

- TO - EDGE PAVEMENT

STATION: 91+87.7

HORZ.DATUM: NAD83 2011


GEOID: NAD88 2018

GRID: NORTHING: 587831.251

EASTING: 1837921.509


LDP: NORTHING: 284079.906

EASTING: 198375.728

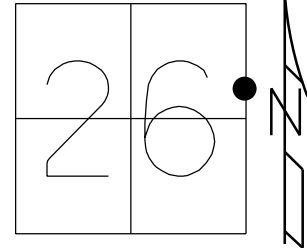

RECORD:
FD P.K./WASHER
7/1/08, DCH
SET MAG/WASHER
9/29/08
FD MAG/WASHER
REFA4
6/16/16, JFO
UNCOVERED
9/12/17, JMR
FD MAG NAIL
REF4A
12/11/23, JAM
FD TONE DID NOT
UNCOVER. PAINTED
8/7/24, JAM

NOTE: ORIGIN OF POINTS UNKNOWN
MAY OR MAY NOT BE ON CL OF
SR 101 &/OR CL SEC. LINE

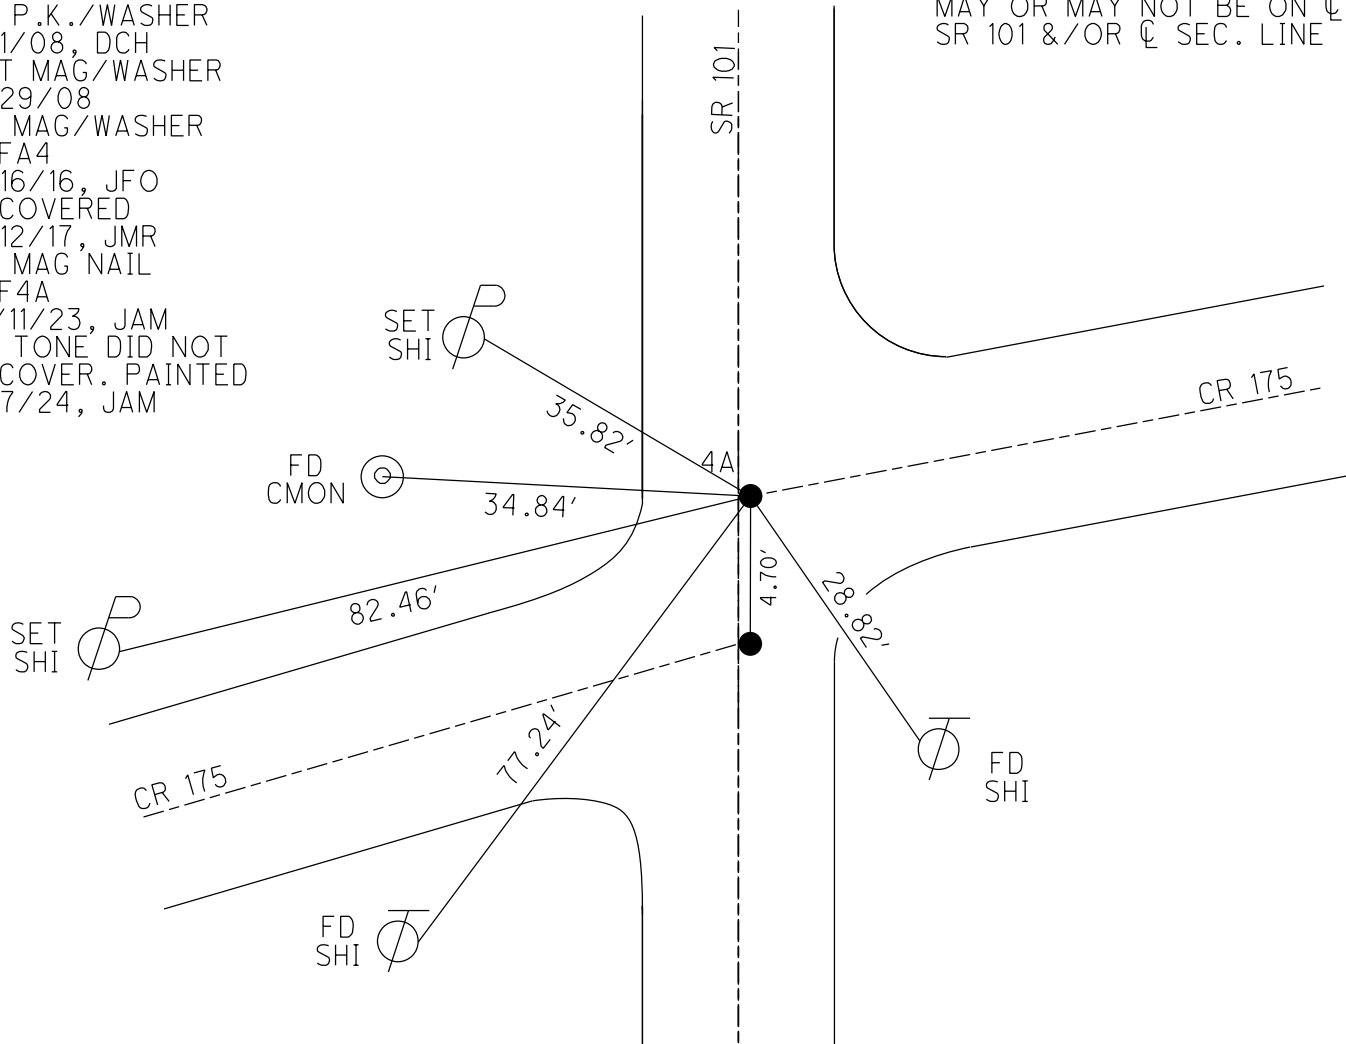


O.D.O.T. DISTRICT 2 SURVEY OFFICE (USE ONLY)

PERSONNEL _____ REFERENCE NO. 4 A SHEET 8 OF 11
 NOTES HOMAN DATE 7/1/08 ROUTE SR 101
 H.C. ROUSOS WEATHER SUNNY COUNTY SANDUSKY
 R.C. HOMAN TEMP. 70° TOWNSHIP GREEN CREEK
 SECTION 26
 T 4 N R 16 E


TYPE MONUMENT PK/WASHER
 ON SURFACE - ~~BELOW~~ ON
~~LEFT~~ - ℄ PAV'T - RIGHT 1.5'
- TO - EDGE PAVEMENT
 S.L.M. 91+87.7

GRID: NORTHING: 587831.251 EASTING: 1837921.509

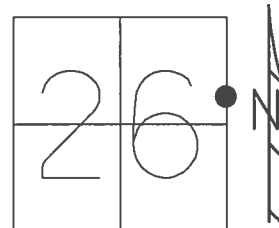

RECORD:
 FD P.K./WASHER
 7/1/08, DCH
 SET MAG/WASHER
 9/29/08
 FD MAG/WASHER
 REFA4
 6/16/16, JFO
 UNCOVERED
 9/12/17, JMR

NOTE: ORIGIN OF POINTS UNKNOWN
 MAY OR MAY NOT BE ON ℄ OF
 SR 101 &/OR ℄ SEC. LINE

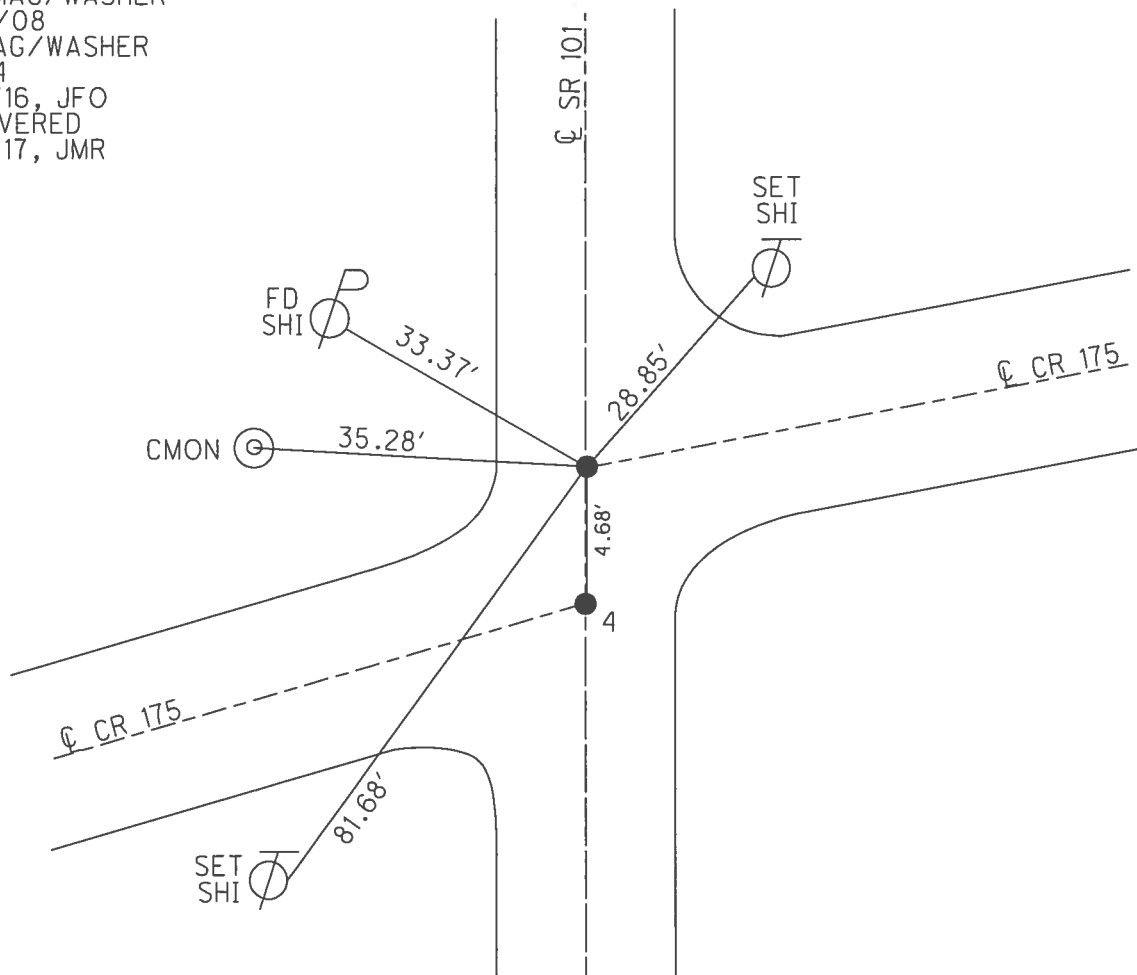

O.D.O.T. DISTRICT 2 SURVEY OFFICE (USE ONLY)

PERSONNEL

REFERENCE NO.

4 A

SHEET

8 OF 10

NOTES

HOMAN

DATE

7-1-2008

ROUTE

SR 101

H.C.

ROUSOS

WEATHER

SUNNY

COUNTY

SANDUSKY

R.C.

HOMAN

TEMP.

70°

TOWNSHIP

GREEN CREEK

SECTION

24, 25

T 4 N R 16 E

TYPE MONUMENT

PK/WASHER

ON SURFACE - ~~BELOW~~

ON


~~LEFT~~ - CL PAV'T - RIGHT

1.5'

- TO - EDGE PAVEMENT

S.L.M. 91+87.7


GRID: NORTHING: 587831.400 EASTING: 1837921.485

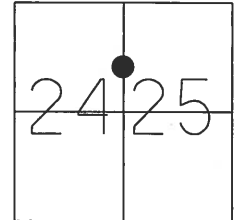

RECORD:

NOTE: ORIGIN OF POINTS UNKNOWN
MAY OR MAY NOT BE ON CL OF
SR 101 &/OR CL SEC. LINE

RESET MAG/WASHER
9/29/2008

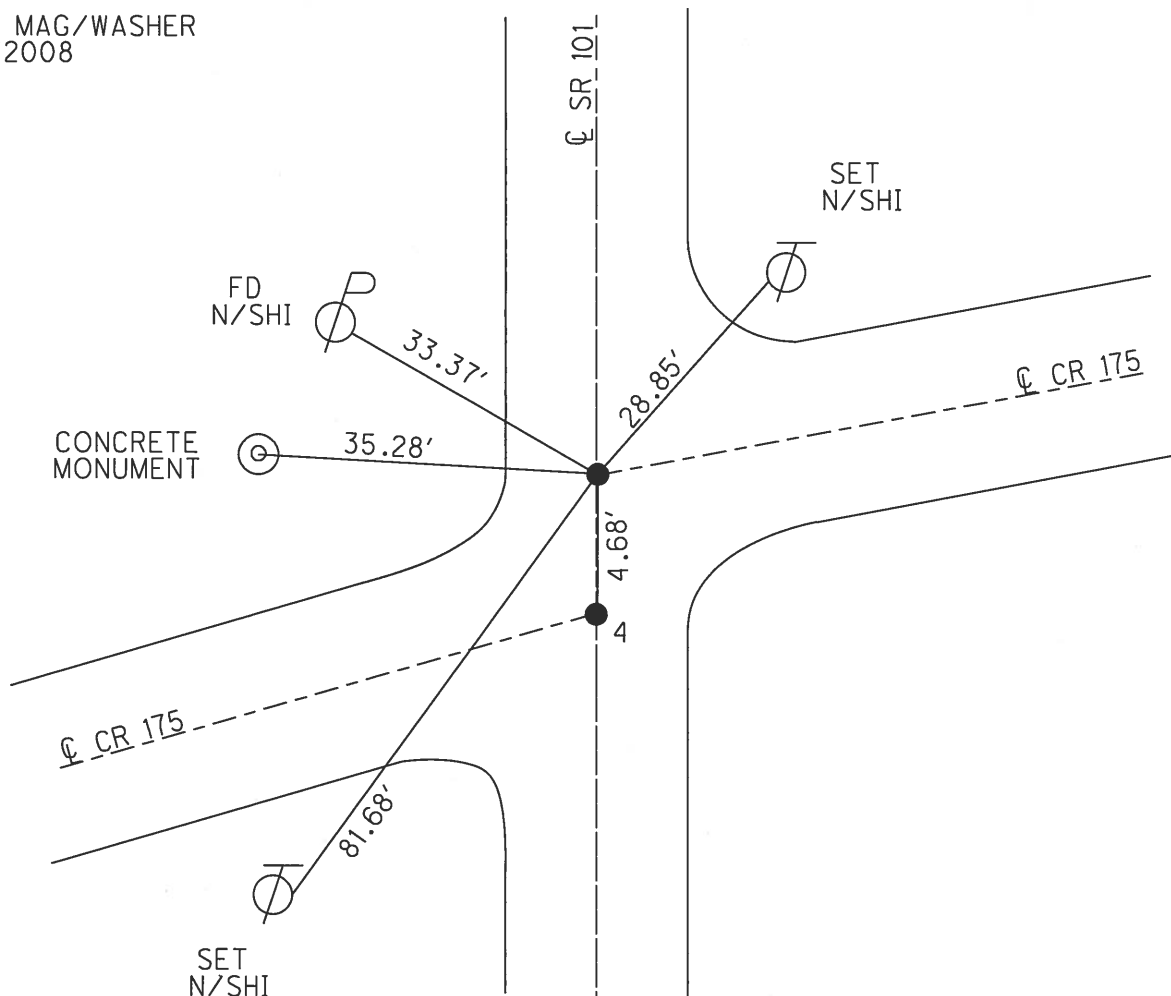


O.D.O.T. DISTRICT 2 SURVEY OFFICE (USE ONLY)

PERSONNEL	REFERENCE NO.	<u>4</u>	SHEET	<u>7</u>	OF	<u>10</u>
NOTES	<u>HOMAN</u>	DATE	<u>7-1-2008</u>	ROUTE	<u>SR 101</u>	
H.C.	<u>ROUSOS</u>	WEATHER	<u>SUNNY</u>	COUNTY	<u>SANDUSKY</u>	
R.C.	<u>HOMAN</u>	TEMP.	<u>70° F</u>	TOWNSHIP	<u>GREEN CREEK</u>	
				SECTION	<u>24, 25</u>	
				T <u>4</u> N	R <u>16</u> E	

TYPE MONUMENT PK/WASHER
ON SURFACE - ~~BELOW~~ ON
~~LEFT~~ - CL PAV'T - RIGHT 1.0'
- TO - EDGE PAVEMENT
S.L.M. 91+83

GRID: NORTHING: 587826+771 EASTING: 1837921.417

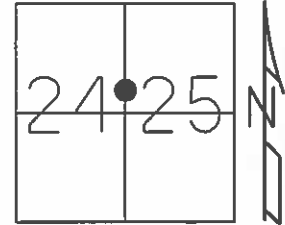


RECORD:

NOTE: ORIGIN OF POINTS UNKNOWN
MAY OR MAY NOT BE ON CL OF
SR 101 &/OR CL SEC. LINE

FD. RR SPK 1"± BELOW SURFACE
SET PK/WASHER ON SURFACE
1' RT CL OF PAV'T 11/14/1983

RESET MAG/WASHER
9/29/2008

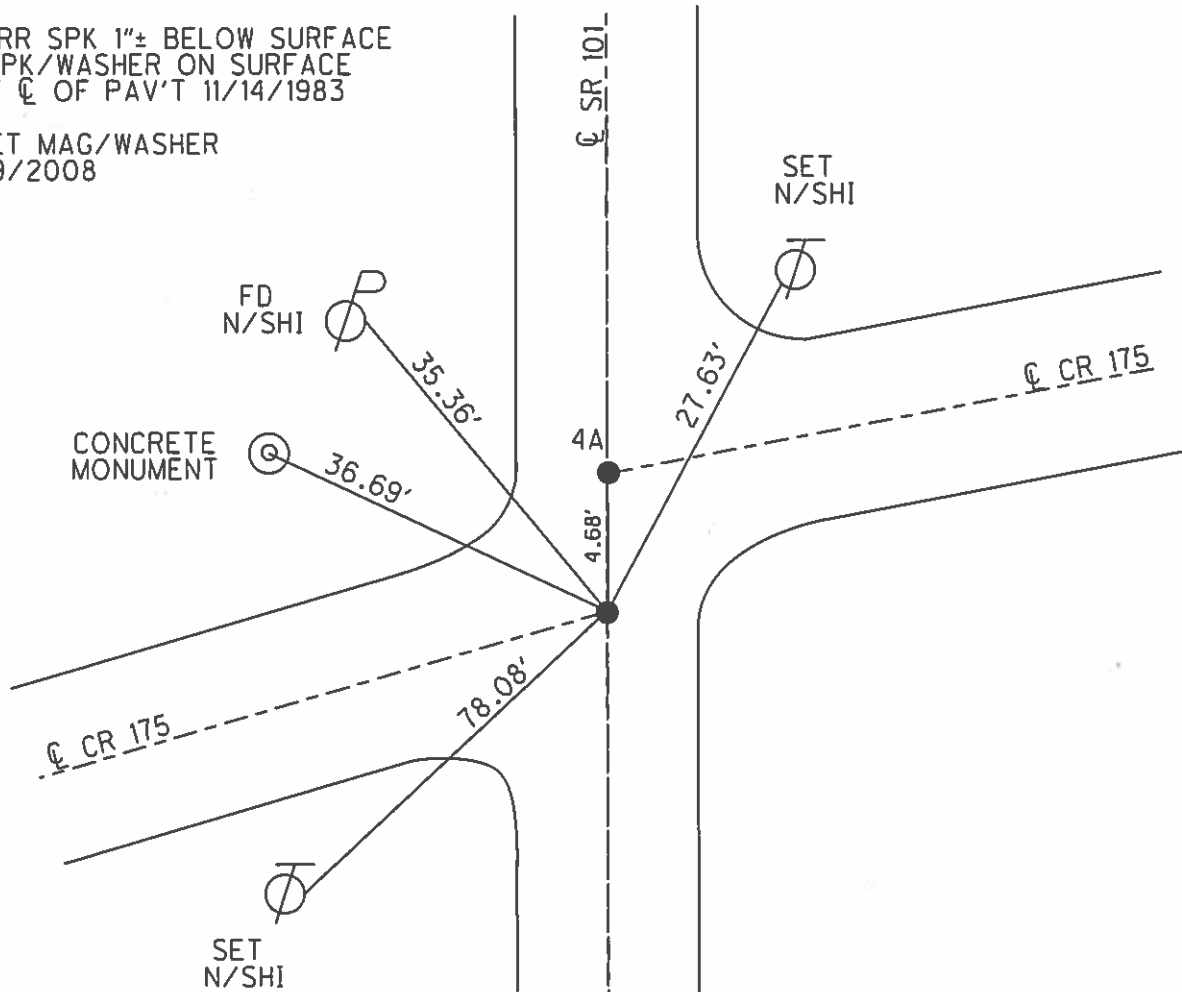

O.D.O.T. DISTRICT 2 SURVEY OFFICE

PERSONNEL

REFERENCE NO. #4

SHEET 7 OF 10

NOTES Cheney

H.C. RIPPLE

R.C. BARBOUR

DATE 10-1-92

WEATHER _____

TEMP. _____

ROUTE SR#101

COUNTY SANDUSKY

TOWNSHIP GREEN CREEK

SECTION 24 & 25

T 4 N R 16 E

"A"

"B"


TYPE MONUMENT P.K./washer P.K./washer

ON SURFACE - BELOW yes yes

~~LEFT~~ - 1.0' RIGHT 1.5'

TO EDGE PAVEMENT


S.L.M. 91+83 TO SOUTH POINT "A"

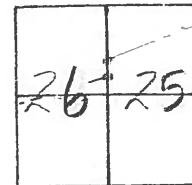

Note: Origin of points unknown
MAY OR MAYNOT be on E of SR#101
E or Sec. Line

Fd. RR. Spk. 1" + below surface
Set P.K. & washer on surface
1.5 RT. & Pavm't. 11-14-83
Record

Re-Set P.K./washer at
Both Points 10-1-92

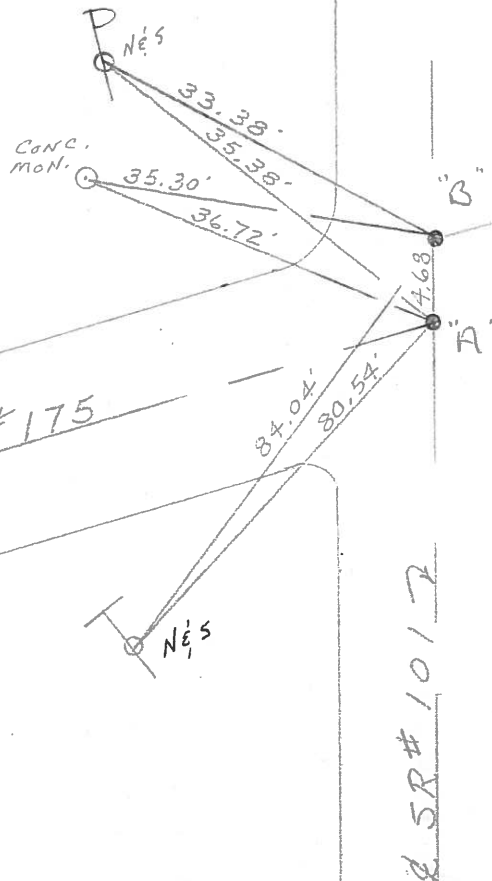

Co. Rd. #175

Fd. RR. Spk. 1" +
below surface
Set P.K. & washer on
surface 1.5 RT. & Pavm't.
Record 11-14-83

(4)

QD.O.T. DISTRICT 2 SURVEY OFFICE

SHEET 7 OF 10

County Sandusky S.R. # 101

Township Green Creek

Section 24 & 25

T1N, R16E

Personnel Cronin

Ripple

Geyman


Barbour

#4

Date 11/14/82

Weather sunny - windy


Temp. 42°

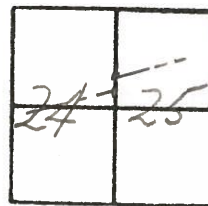

Note: Origin of points unknown
May or May not be on E of S.R. #101
E or Section Line



Fd. R.R. spike 1" below surface. Set
P.K. & washer on surface. 1 Rt. & Point.

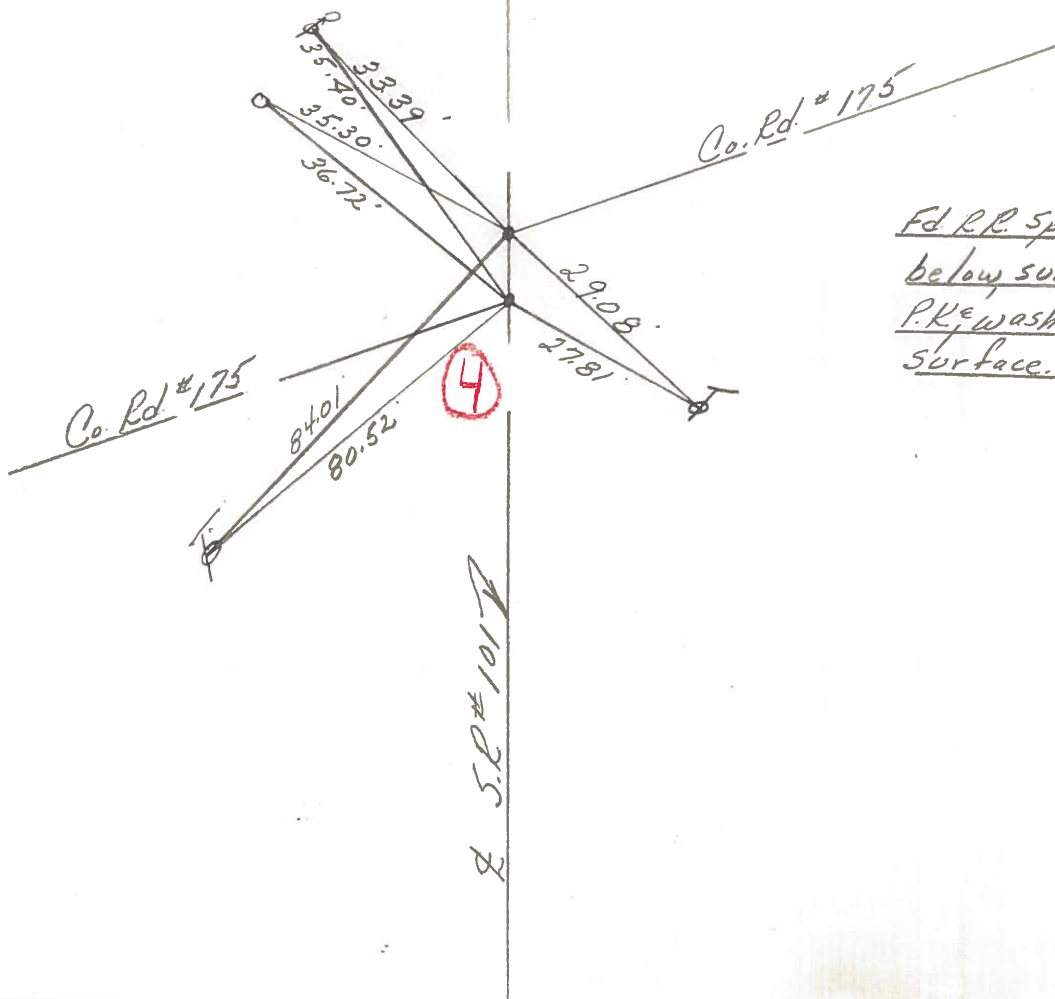

Fd R.R. Spike 1" below surface. Set
P.K. & washer on surface. 1.5 Rt. & Point.

PERSONNEL	TITLE	PERSONNEL	TITLE
Schneider			
Mosser			
Barbour			
Potts			

COUNTY Sandusky DATE Feb. 29, 1968

S. R. # 101 WEATHER _____

SEC. Sen. San. Co. Line North TEMP. _____

DESCRIPTION Ties for Contro Points JOB NO. _____

