


O.D.O.T. DISTRICT 2 SURVEY OFFICE (USE ONLY)

PERSONNEL	REFERENCE NO.	<u>1 A</u>	SHEET	<u>2</u>	OF	<u>22</u>
NOTES	<u>MILLER</u>	DATE	<u>9/3/24</u>	ROUTE	<u>SR 300</u>	
H.C.	<u>MILLER</u>	WEATHER	<u>SUNNY</u>	COUNTY	<u>SANDUSKY</u>	
R.C.	<u>BARRIERE</u>	TEMP.	<u>56°</u>	TOWNSHIP	<u>MADISON</u>	
				SECTION	<u>35</u>	
				T	<u>5</u>	N
				R	<u>13</u>	E

TYPE MONUMENT MAG/WASHER
ON SURFACE - ~~BELOW~~ ON
LEFT - ~~C PAV'T~~ - RIGHT 5.0'
4.2' TO LT EDGE PAVEMENT
S.L.M. 13+21

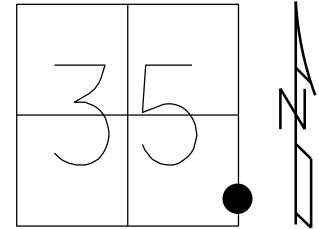

GRID: NORTHING: 612406.556 EASTING: 1743122.051

NOTE: POINT IS BELIEVED TO
BE 1.09' E. OF C. OF R/W. SEE
PREVIOUS REF. TIE
DATED 11/5/73

RE-SET P.K./WASHER
9/16/94, MC

FD P.K./WASHER
5/10/00 KPM


GPS AND TIED
1-7-11 JMH

SET MAG/WASHER
GPS, FINREF A1
6/3/13, SDC

FD MAG/WASHER
REF1A
9/3/24, JAM

FD MAG/WASHER
10/3/24, JAM

FD WHITE PLASTIC
FENCE POST.
NOTCH, 1' UP

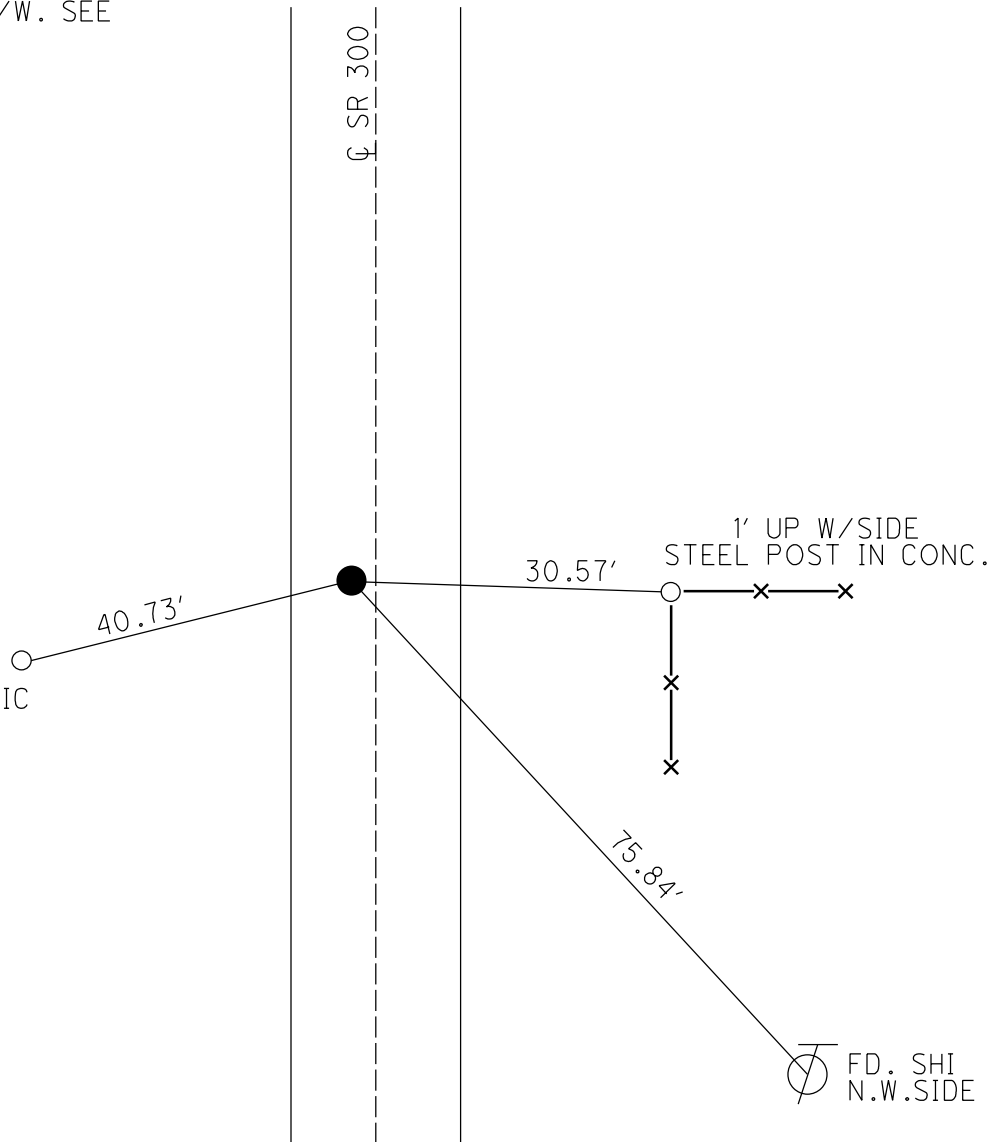

O.D.O.T. DISTRICT 2 SURVEY OFFICE (USE ONLY)

PERSONNEL

REFERENCE NO. 1 A

SHEET 2 OF 22

NOTES RHOADES

DATE 4/16/13

ROUTE SR 300

H.C. CODER

WEATHER RAIN

COUNTY SANDUSKY

R.C. RHOADES

TEMP. 51°

TOWNSHIP MADISON

SECTION 35

T 5 N R 13 E

TYPE MONUMENT P.K./WASHER


ON SURFACE - ~~BELOW~~ ON

LEFT - ~~C PAV'T~~ - RIGHT 5.5'

4.2' TO LT EDGE PAVEMENT

S.L.M. 13+21

Grid: Northing: 612406.556 Easting: 1743122.051

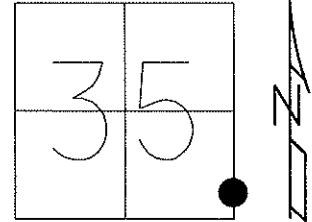


NOTE: POINT IS BELIEVED TO
BE 1.09' E. OF C. OF R/W. SEE
PREVIOUS REF. TIE
DATED 11/5/73

RE-SET P.K./WASHER
9/16/94, MC

FD P.K./WASHER
5/10/00 KPM

GPS AND TIED
1-7-11 JMH

SET MAG/WASHER
GPS, FINREFA1
6/3/13, SDC

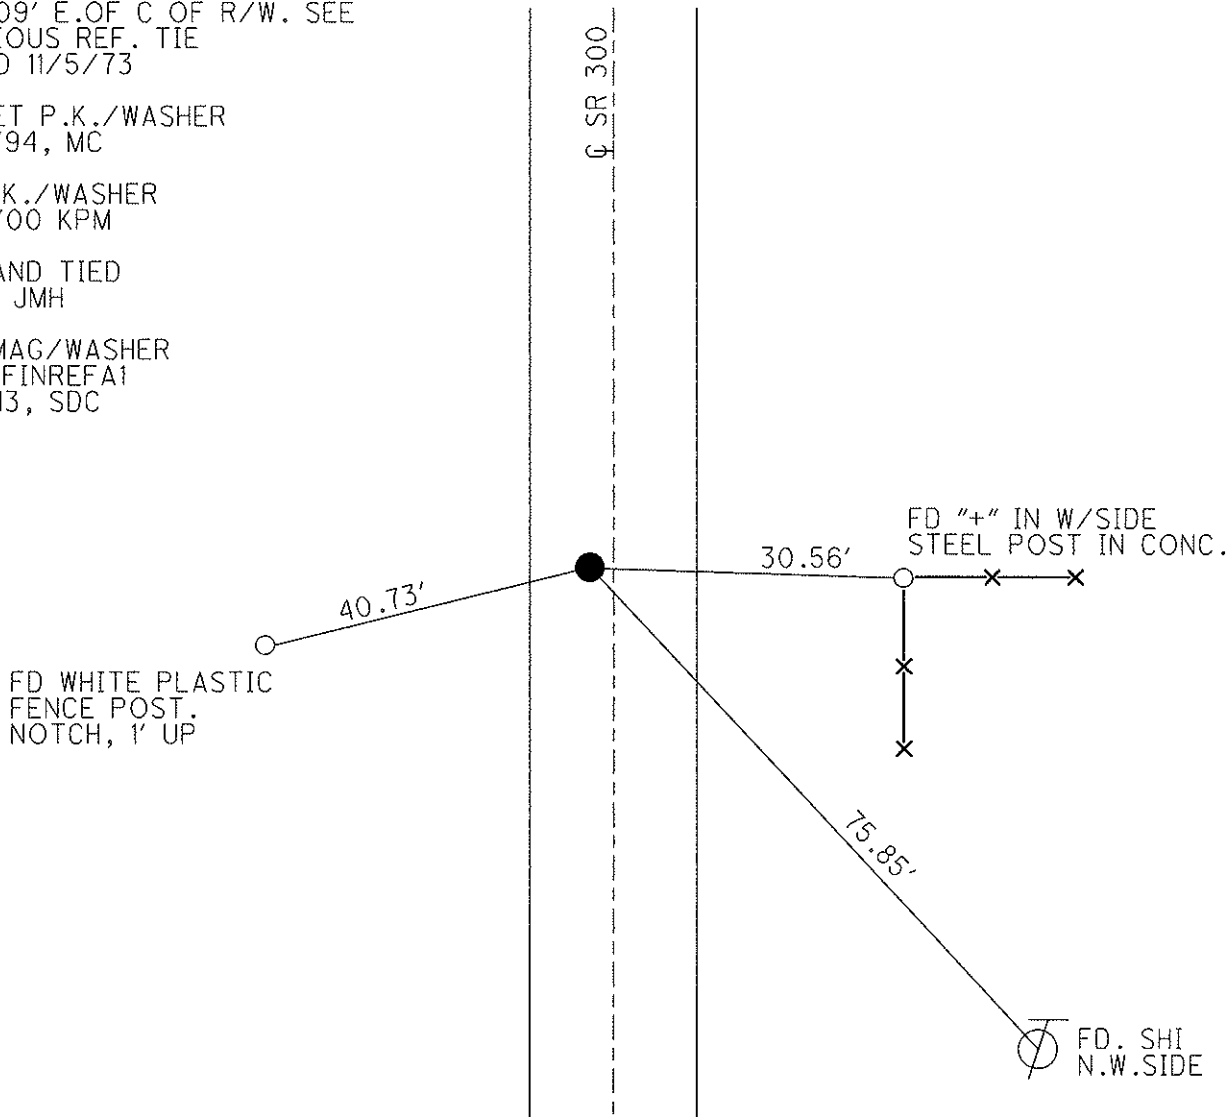

O.D.O.T. DISTRICT 2 SURVEY OFFICE

PERSONNEL

REFERENCE NO. 1-A

SHEET 1 OF 15

NOTES LOEHRKE

H.C. CANTERBURY

R.C. HERMILLER

VOGEL

DATE 7/19/94

WEATHER FAIR

TEMP. + 85°

ROUTE S.R. #300

COUNTY Sandusky

TOWNSHIP Madison

SECTION 26

T S N R 13 E


TYPE MONUMENT PK NAIL/WASHER

ON SURFACE - BELOW ON SURFACE

LEFT- & PAV'T. - RIGHT 5.3' LT. &


4.2' TO LT. EDGE PAVEMENT

S.L.M. 13+21

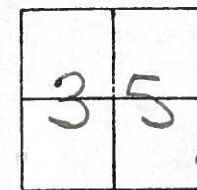

NOTE: Point is belived to be 1.09' E.
of & of R/W, see previous
Ref. Tie dated 11/5/73

Re-set PK/washer
9-16-94 M.C.

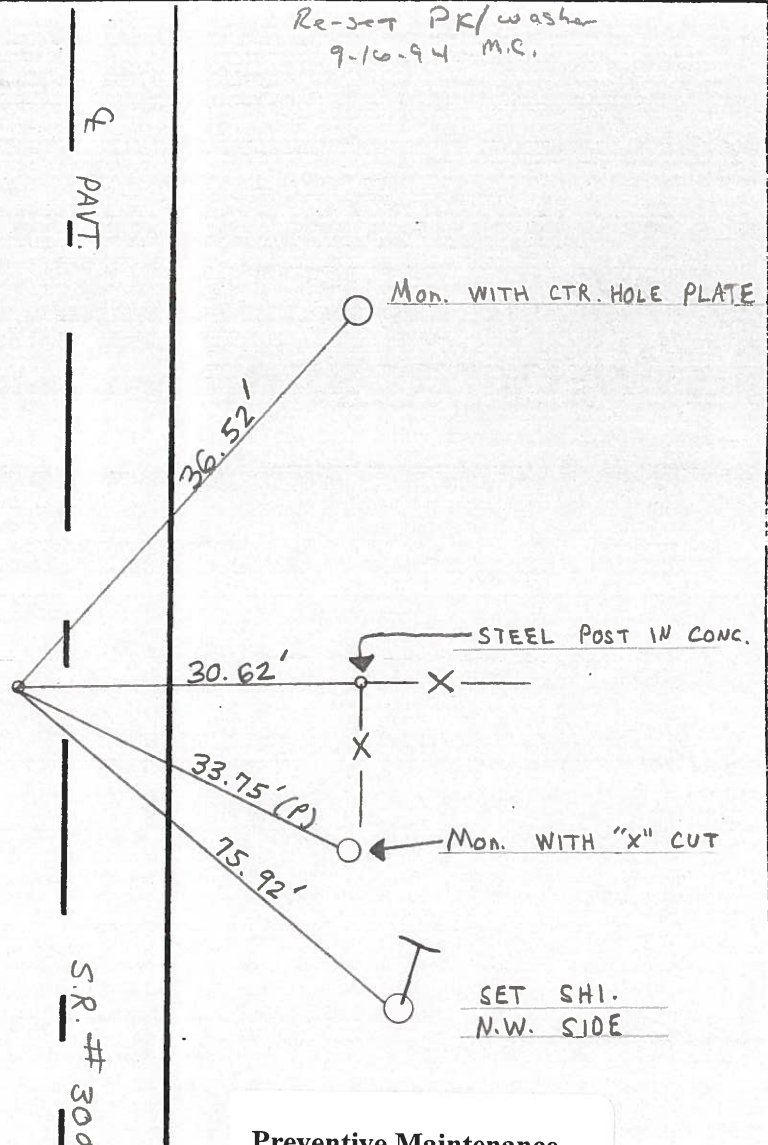

Preventive Maintenance
Microsurfaced 2000
Existing Point Uncovered
Date 5-10-2000

PERSONNEL TITLE PERSONNEL TITLE

Cronin

Ash

Ripple

COUNTY Sandusky

DATE Drawn 11/5/73

S. R. # 300

WEATHER

SEC. U.S. #6 to U.S. #20

TEMP.

DESCRIPTION Ties for Control Points

JOB NO.

LEFT

CENTER LINE

R/W


RIGHT

Madison Turp.

Note: This point was set on a private survey in the southwesterly portion of Section #36. It was set on a straight line from the U.W. corner of Sec. 36 to the S.W. corner of Sec. #36. Ed. stone at W $\frac{1}{4}$ post of Sec. 36, 2.43' to the west of said straight line

Ed. P.K. nail atop P.K. spike

①A

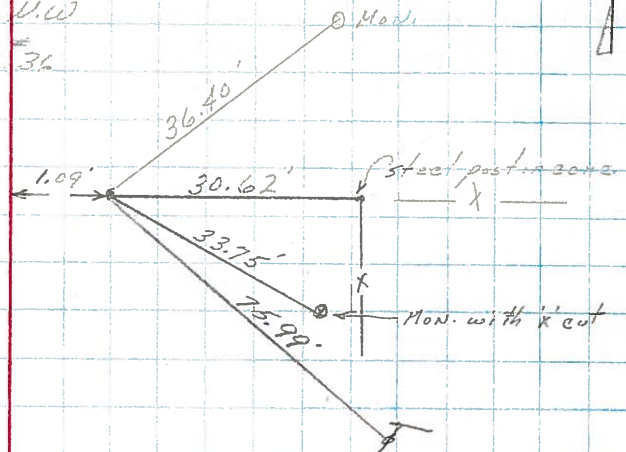

①

x cut in curb

36.94'

Turp. Line P

SEC. 35

SEC. 36

41.80'

x cut in curb

U.S. 6

46.14'

69.17'

90.54'

cone. man

0+00

Found P.K. nail on surface. Iron bolt should be below

②

PERSONNEL	TITLE	PERSONNEL	TITLE	COUNTY	DATE
Schneider		Potts		San	4 7 08
Mosser				S. R.	30
Barbour				SEC.	0.0
Redding				TEMP.	6

DESCRIPTION Ties for Control Point JOB NO. _____

