


O.D.O.T. DISTRICT 2 SURVEY OFFICE (USE ONLY)

PERSONNEL _____ REFERENCE NO. 2 SHEET 3 OF 22
NOTES MILLER DATE 9/3/24 ROUTE SR 300
H.C. MILLER WEATHER SUNNY COUNTY SANDUSKY
R.C. BARRIERE TEMP. 57° TOWNSHIP MADISON

SECTION 35
T 5 N R 13 E

TYPE MONUMENT MAG/WASHER
ON SURFACE - ~~BELOW~~ ON
LEFT - ~~C PAV'T - RIGHT~~ 7.5'
2.5' TO LT EDGE PAVEMENT
S.L.M. 26+41

GRID: NORTHING: 613724.450 EASTING: 1743126.853

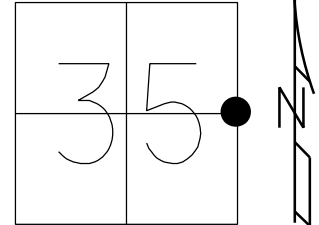

RECORD: 7/27/73
WEST-1 POST SEC. 36 FD STONE
WITH DRILL HOLE 19" BELOW
SURFACE. 10X10X14" SANDSTONE
SET 1" X 18" IRON PIPE ON
TOP OF STONE TO SURFACE.

RESET P.K./WASHER
9/16/94, MC

FD P.K./WASHER
5/10/00 KPM

GPS & TIED
1-7-11 JMH

SET MAG/WASHER
GPS, FINREF2
6/6/13, SDC

FD MAG/WASHER
REF2
9/3/24, JAM

FD MAG/WASHER UPRIGHT TRACK RAIL
10/3/24, JAM FD. CHISEL MARK 2.6'
UP FROM GROUND



20.68'

SR 300

57.58'



FD SHI W/SIDE
30" TREE

23.80'

MB

USED W/SIDE FACE
M. BOX 1.5' UP
RES #355

89.76'




FD SHI
N/W SIDE

O.D.O.T. DISTRICT 2 SURVEY OFFICE (USE ONLY)

PERSONNEL	REFERENCE NO. <u>2</u>	SHEET <u>3</u> OF <u>22</u>
NOTES <u>RHOADES</u>	DATE <u>4/16/13</u>	ROUTE <u>SR 300</u>
H.C. <u>CODER</u>	WEATHER <u>RAIN</u>	COUNTY <u>SANDUSKY</u>
R.C. <u>RHOADES</u>	TEMP. <u>51°</u>	TOWNSHIP <u>MADISON</u>
		SECTION <u>35</u>
		T <u>5</u> N R <u>13</u> E

TYPE MONUMENT P.K./WASHER
 ON SURFACE - ~~BELOW~~ ON
 LEFT - ~~C PAV'T~~ - RIGHT 7.5'
2.5' TO LT EDGE PAVEMENT
 S.L.M. 26+41

Grid: Northing: 613724.450 Easting: 1743126.853

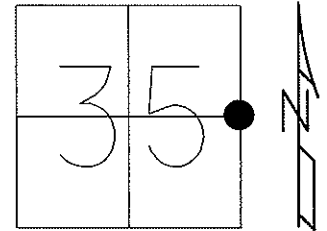


RECORD: 7/27/73
 WEST-1 POST SEC. 36 FD STONE
 WITH DRILL HOLE 19" BELOW
 SURFACE. 10X10X14" SANDSTONE
 SET 1" X 18" IRON PIPE ON
 TOP OF STONE TO SURFACE.

RESET P.K./WASHER
 9/16/94, MC

FD P.K./WASHER
 5/10/00 KPM

GPS & TIED
 1-7-11 JMH

SET MAG/WASHER
 GPS, FINREF2
 6/6/13, SDC

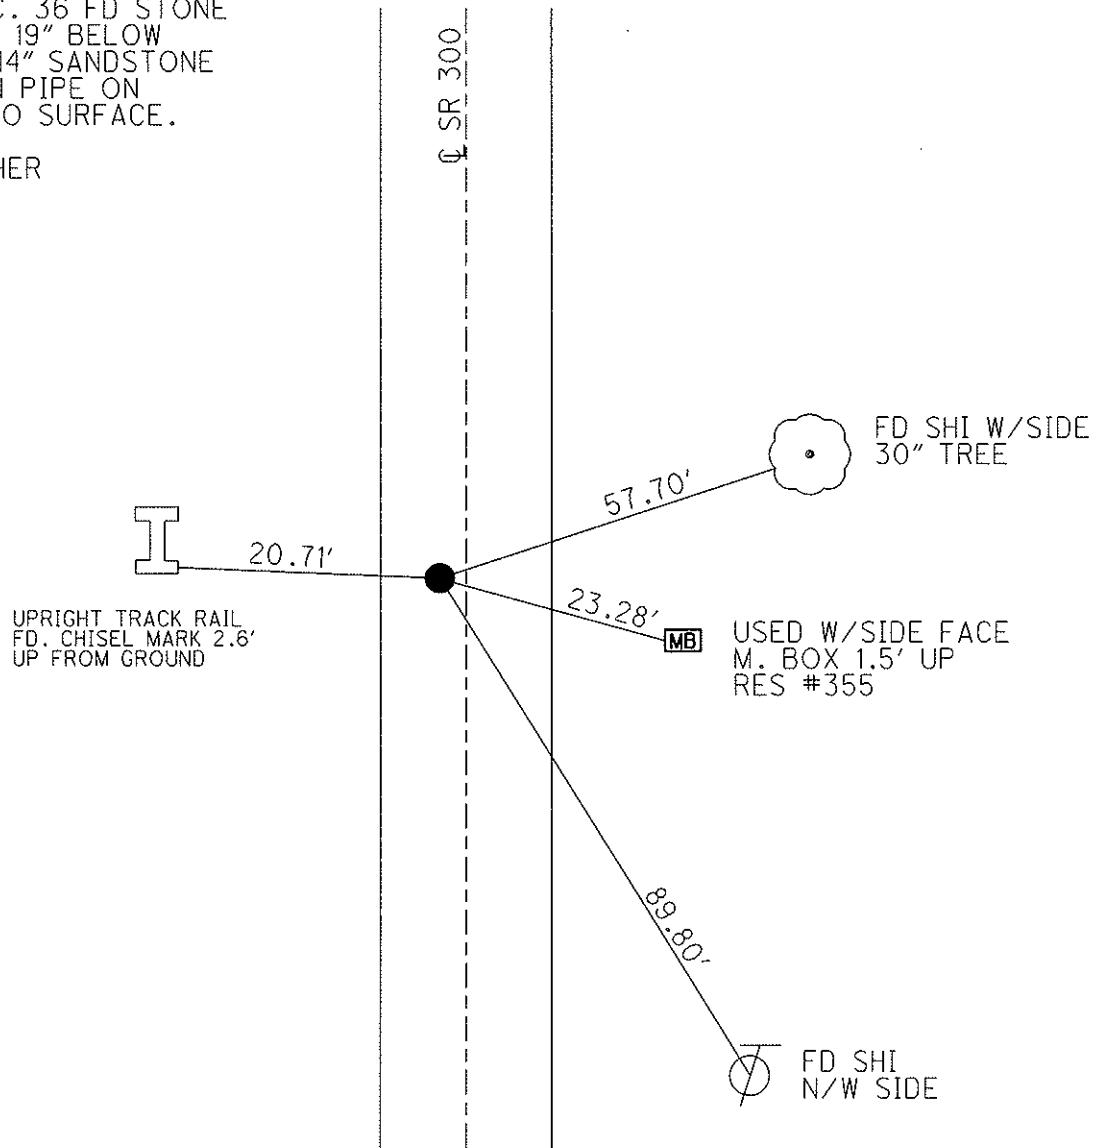

O.D.O.T. DISTRICT 2 SURVEY OFFICE

PERSONNEL

REFERENCE NO. 2

SHEET 2 OF 15

NOTES LOEHRKE

H.C. CANTERBURY

R.C. HERMILLER

VOGEL

DATE 7/19/94

WEATHER FAIR

TEMP. + 85°

ROUTE S.R. #300

COUNTY SANDUSKY

TOWNSHIP MADISON

SECTION 36-35

T. 5 N. R. 13 E


TYPE MONUMENT PK/WASHER

ON SURFACE - BELOW ON SURFACE

LEFT - E PAVT. - RIGHT 7.8' LT. E

2.3' TO LT. EDGE PAVEMENT

S.L.M. 26 + 41

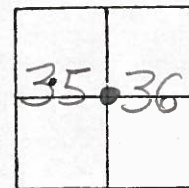


Record 7-27-73
WY. POST Sec. 36 Rd. STONE
WITH drill hole 19" below
surface.
10 x 10 x 14 Sandstone
set 1" x 18" iron pipe on
top of stone to surface.

Re-set P.K. / washer
9-16-94 ms.

UPRIGHT TRACK RAIL
CHISEL MARK 2.6'
UP FROM GROUND.

Preventive Maintenance
Microsurfaced 2000
Existing Point Uncovered
Date 5-10-2000

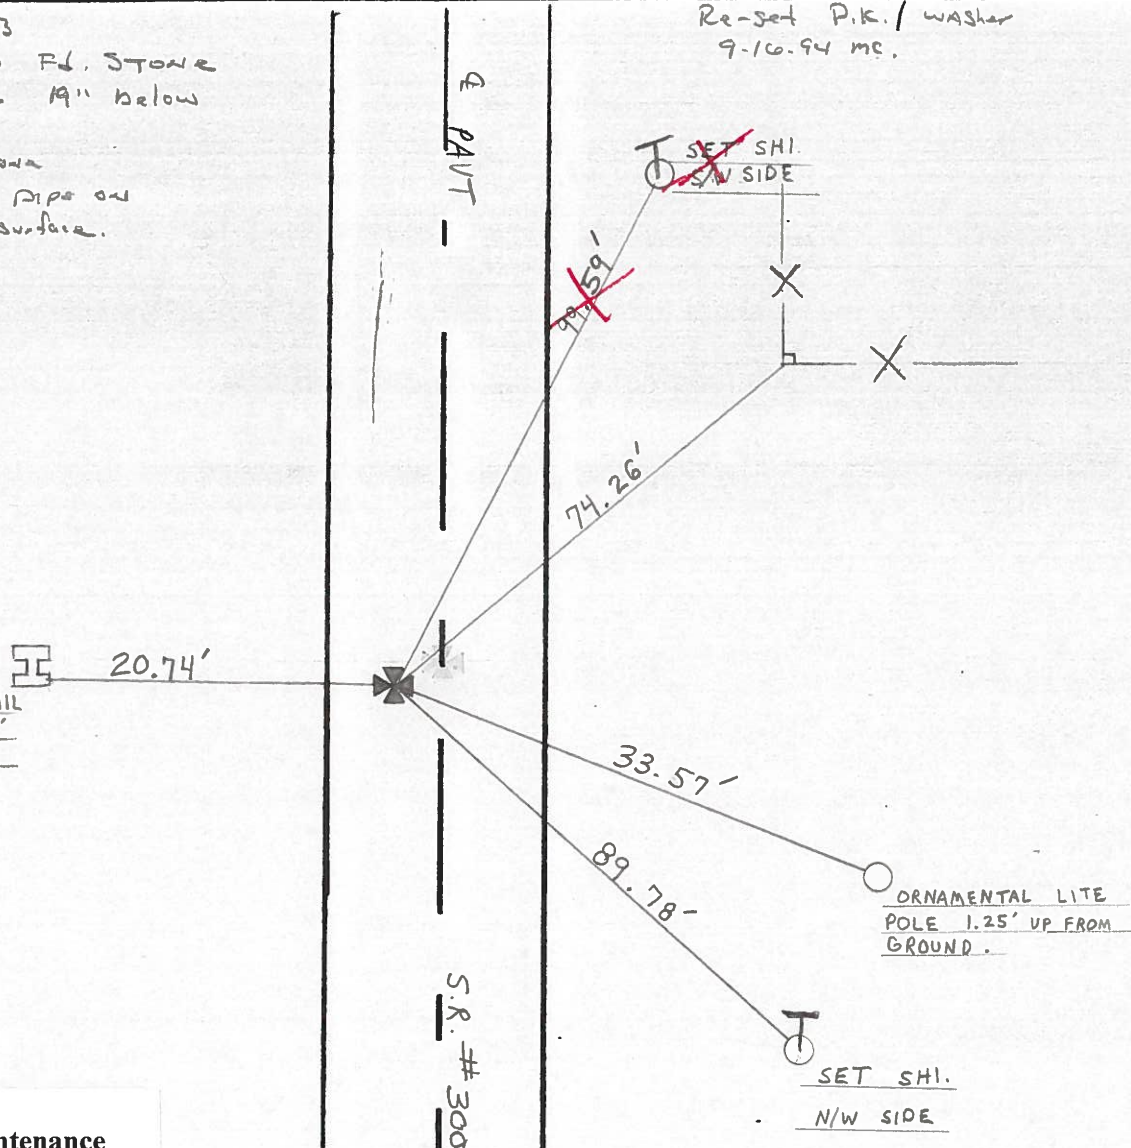

Resurveyed 1994

LD-5-(25M-2-59)

SHEET NO. 2 of 8

PERSONNEL	TITLE	PERSONNEL	TITLE	COUNTY	DATE	WEATHER	TEMP.
Cronin				Sandusky	Drawn 11/5/73		
Ash				# 300			
Ripple				U.S. #6 to U.S. #20			

DESCRIPTION Tics for Control Points JOB NO. _____

