

O.D.O.T. DISTRICT 2 SURVEY OFFICE (USE ONLY)

PERSONNEL

REFERENCE NO. 3

SHEET 4 OF 22

NOTES

MILLER

DATE

9/3/24

ROUTE

SR 300

H.C.

MILLER

WEATHER

SUNNY

COUNTY

SANDUSKY

R.C.

BARRIERE

TEMP.

57°

TOWNSHIP

MADISON

SECTION

25

T 5 N R 13 E

TYPE MONUMENT MAG/WASHER


ON SURFACE - ~~BELOW~~ ON

~~LEFT~~ - Q PAV'T - ~~RIGHT~~ ON

- TO - EDGE PAVEMENT

S.L.M. 52+93 1.0' SOUTH OF Q T.R.55

GRID: NORTHING: 616370.533 EASTING: 1743143.846

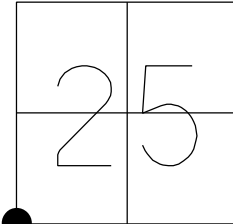

RESET P.K./WASHER
9/16/94, MC


FD P.K./WASHER
5/10/00 KPM

GPS & TIED
1-7-11 JMH

SET MAG/WASHER
GPS, FINREF3
6/3/13, SDC

FD MAG/WASHER
REF3
9/3/24, JAM

FD MAG/WASHER
10/3/24, JAM

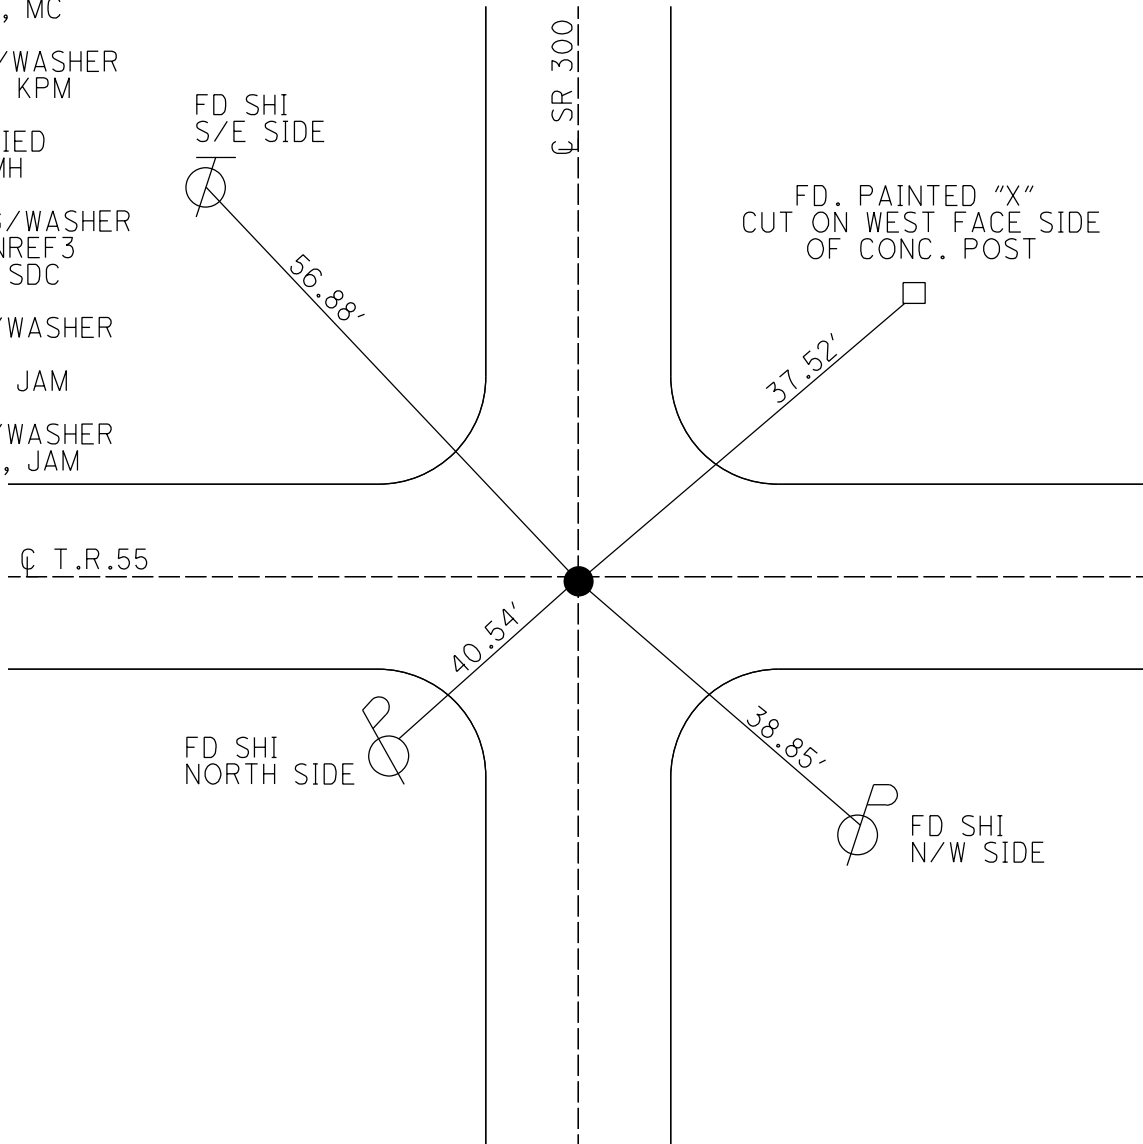

O.D.O.T. DISTRICT 2 SURVEY OFFICE (USE ONLY)

PERSONNEL _____

REFERENCE NO. 3

SHEET 4 OF 22

NOTES RHOADES

DATE 4/16/13

ROUTE SR 300

H.C. CODER

WEATHER RAIN

COUNTY SANDUSKY

R.C. RHOADES

TEMP. 51°

TOWNSHIP MADISON

SECTION 25

T 5 N R 13 E

TYPE MONUMENT P.K./WASHER


ON SURFACE - ~~BELOW~~ ON

~~LEFT~~ - Q PAV'T - ~~RIGHT~~ ON

- TO - EDGE PAVEMENT

S.L.M. 52+93 1.0' SOUTH OF Q T.R.55

Grid: Northing: 616370.533 Easting: 1743143.846

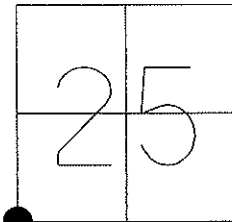


RESET P.K./WASHER
9/16/94, MC

FD P.K./WASHER
5/10/00 KPM

GPS & TIED
1-7-11 JMH

SET MAG/WASHER
GPS, FINREF3
6/3/13, SDC

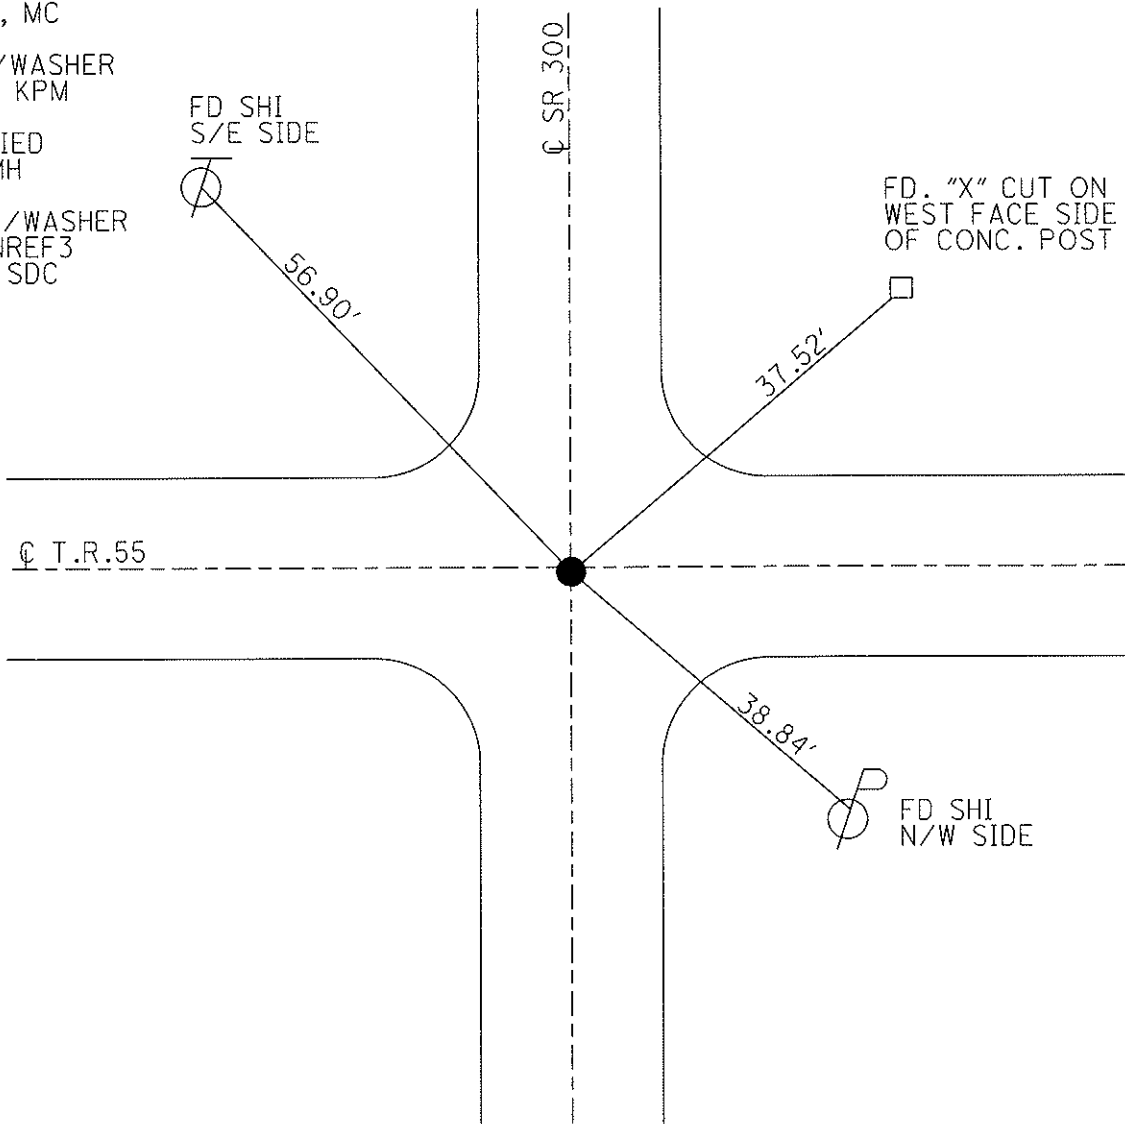

O.D.O.T. DISTRICT 2 SURVEY OFFICE

PERSONNEL

REFERENCE NO. 3

SHEET 3 OF 15

NOTES LOEHRKE

H.C. CANTERBURY

R.C. HERMILLER

VOGEL

DATE 7/19/94

WEATHER FAIR

TEMP. + 85°

ROUTE S.R. # 300

COUNTY SANDUSKY

TOWNSHIP MADISON

SECTION 35

T S N R 13 E

TYPE MONUMENT PK/WASHER

ON SURFACE - BELOW ON SURFACE

LEFT - Q PAV'T. - RIGHT ON Q


TO EDGE PAVEMENT 1.0' South of Q T.R. 55

S.L.M. 52 + 93

26	25
35	36



Re-set PK/washer 9-16-94 m.c.

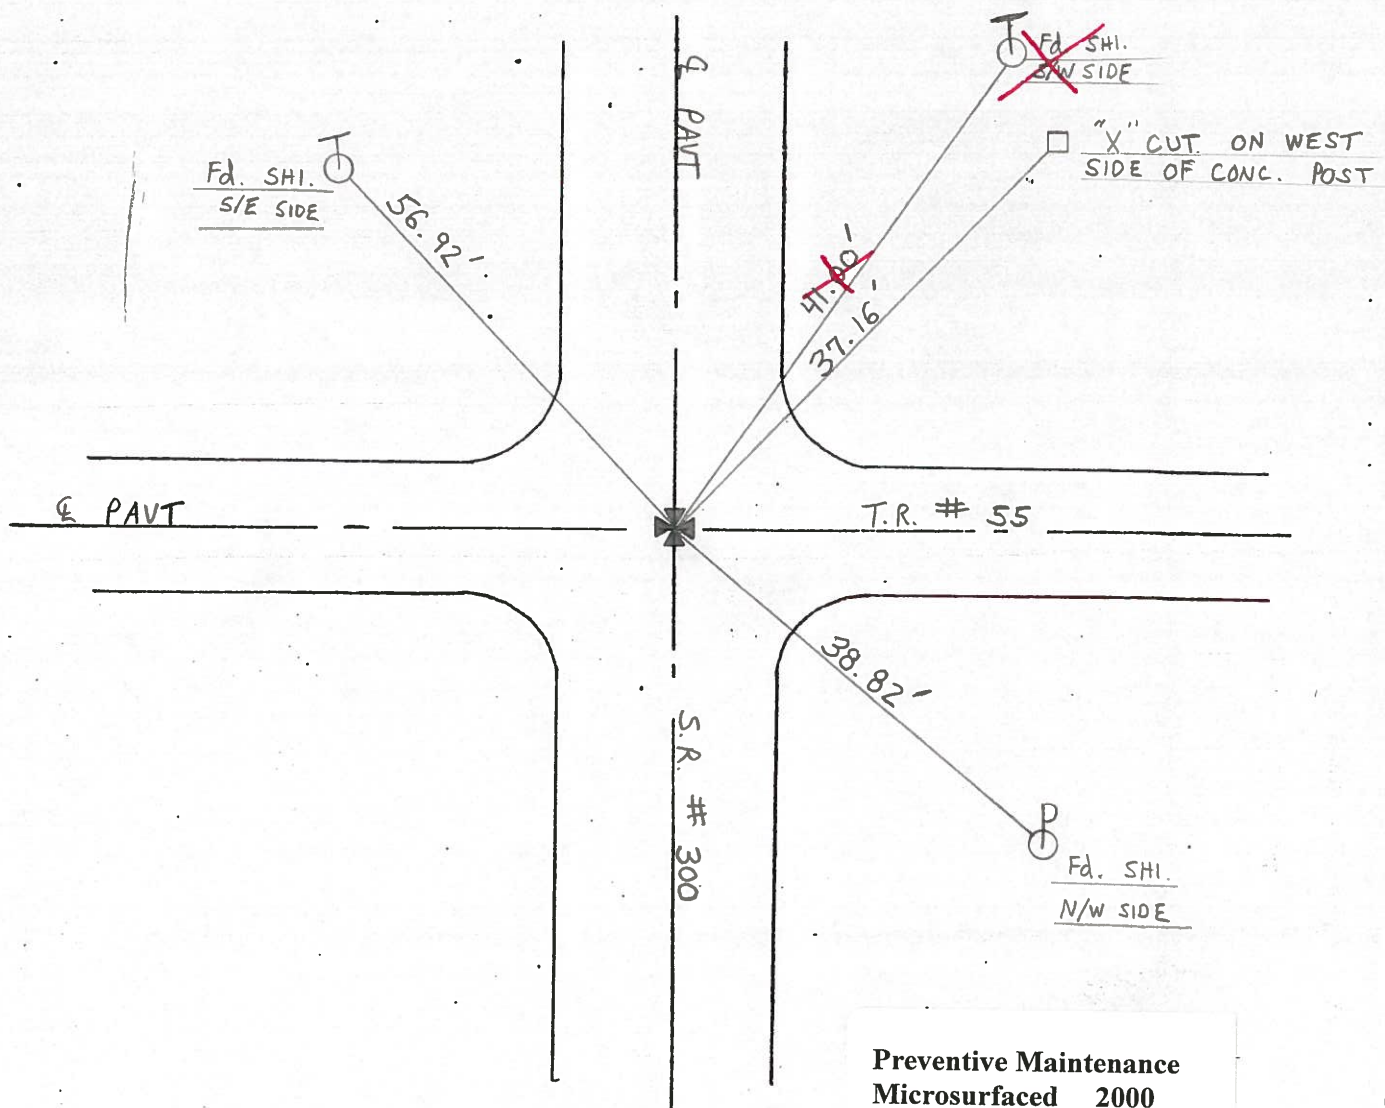

Preventive Maintenance
Microsurfaced 2000
Existing Point Uncovered
Date 5-10-2000

PERSONNEL TITLE PERSONNEL TITLE

Cronin
Ash
Ripple

COUNTY Sandusky

DATE Drawn 11/5/73

S. R. # 300


WEATHER

SEC. U.S. #6 to U.S. #20

TEMP.

DESCRIPTION Ties for Control Points

JOB NO.

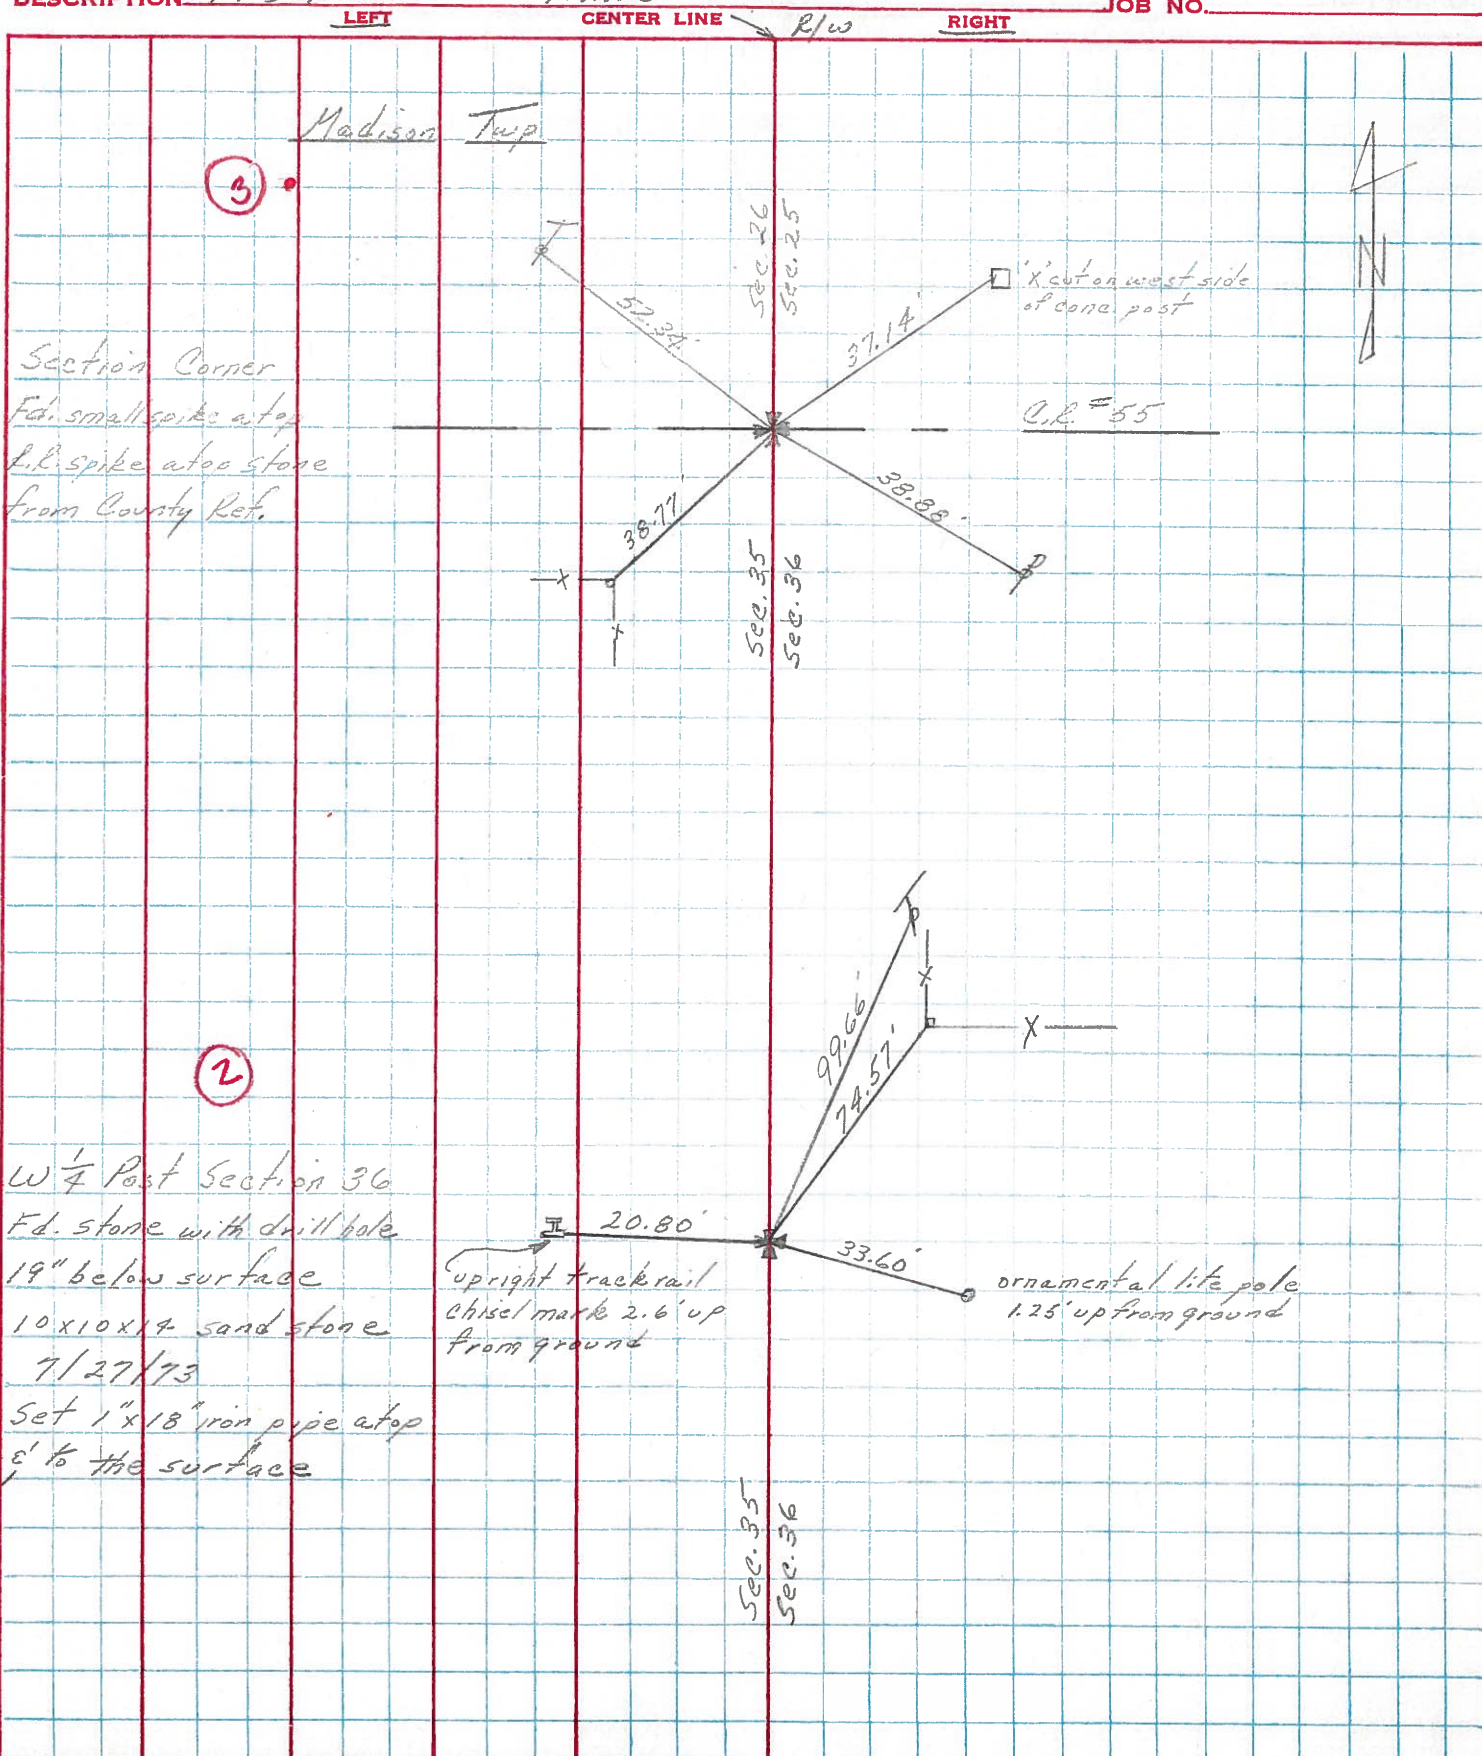

PERSONNEL	TITLE	PERSONNEL	TITLE	COUNTY	DATE	WEATHER	TEMP.
Schneider		Potts		Sandusky	4-17-68	cloudy	65°
Mosser				S. R. 300			
Barbour				SEC. 0.00			
Redding							

DESCRIPTION Ties for Control Points JOB NO. _____

