

O.D.O.T. DISTRICT 2 SURVEY OFFICE (USE ONLY)

PERSONNEL

REFERENCE NO. 6

SHEET 22 OF 33

NOTES MILLER
H.C. MILLER
R.C. BARRIERE

DATE 9/3/24
WEATHER SUNNY
TEMP. 70°

ROUTE SR 412
COUNTY SANDUSKY
TOWNSHIP RILEY
SECTION 28
T 5 N R 16 E

DWG BY PRESTON-COLVIN PID PAVING TRAIN

TYPE MONUMENT MAG/WASHER

ON SURFACE - BELOW ON

OFFSET Q PAVEMENT ON LT : RT
9' TO RT EDGE PAVEMENT

STATION: 145+10.60

HORIZ.DATUM: NAD83 (2011)


GEOID: 18

GRID: NORTHING: 618757.593

EASTING: 1823006.085

LDP: NORTHING: 314905.1623

EASTING: 183246.6206

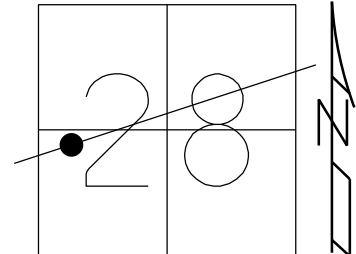

RECORD: 10-11-1984
109+29.60 (S.H. 281 SEC. T. BR.)
1932 SET PK & WASHER ATOP
GALVINIZED BOLT ATOP I. PIN

SET P.K./WASHER
8/2/93, JLR

FD P.K./WASHER
REF16
12/11/12, JMR

SET MAG/WASHER
NEWREF6
7/1/15, DCH

FD MAG/WASHER
REF6
9/3/24, JAM


FD MAG/WASHER
10/3/24, JAM

RESET SAWCUT
@ FND. "X" CUT

SET SHI
8" MAPLE

SET SHI
12" OAK

FND. SHI

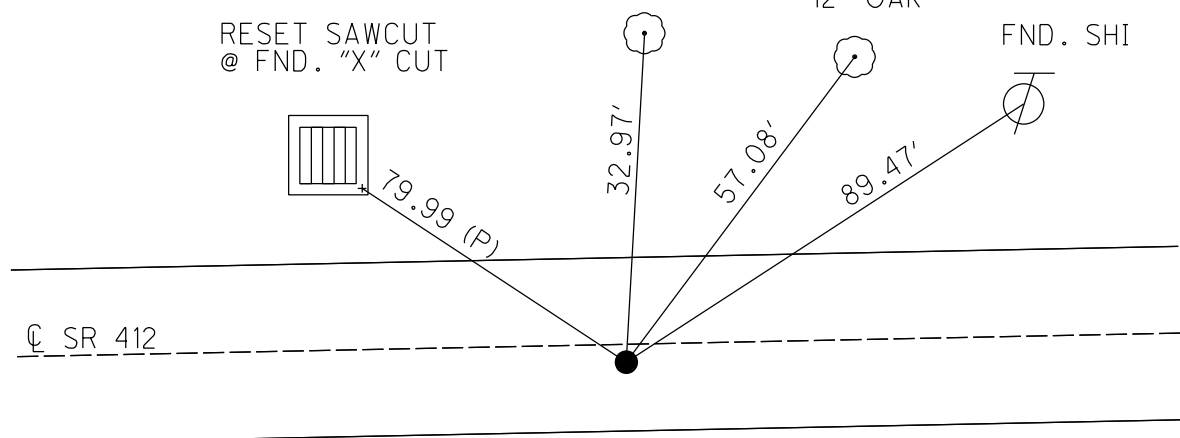


O.D.O.T. DISTRICT 2 SURVEY OFFICE (USE ONLY)

PERSONNEL _____ REFERENCE NO. 6 SHEET 22 OF 33
 NOTES HOMAN DATE 10-09-2014 ROUTE SR 412
 H.C. WESTFALL WEATHER PARTLY SUNNY COUNTY SANDUSKY
 R.C. RHOADES TEMP. 55° TOWNSHIP RILEY
 LEU SECTION 28
 T 5 N R 16 E

TYPE MONUMENT P.K./WASHER
 ON SURFACE - ~~BELOW~~ ON
~~LEFT - C~~ PAV'T - ~~RIGHT~~ ON
9' TO RT EDGE PAVEMENT
 S.L.M. 145+10.60

Grid: Northing: 618757.593 Easting: 1823006.085

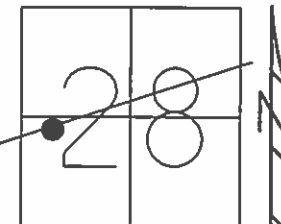


RECORD: 10-11-1984
 109+29.60 (S.H. 281 SEC. T. BR.)
 1932 SET PK & WASHER ATOP
 GALVINIZED BOLT ATOP I. PIN

SET P.K./WASHER
 8/2/93, JLR

FD P.K./WASHER
 REF16
 12/11/12, JMR

SET MAG/WASHER
 NEWREF6
 7/1/15, DCH

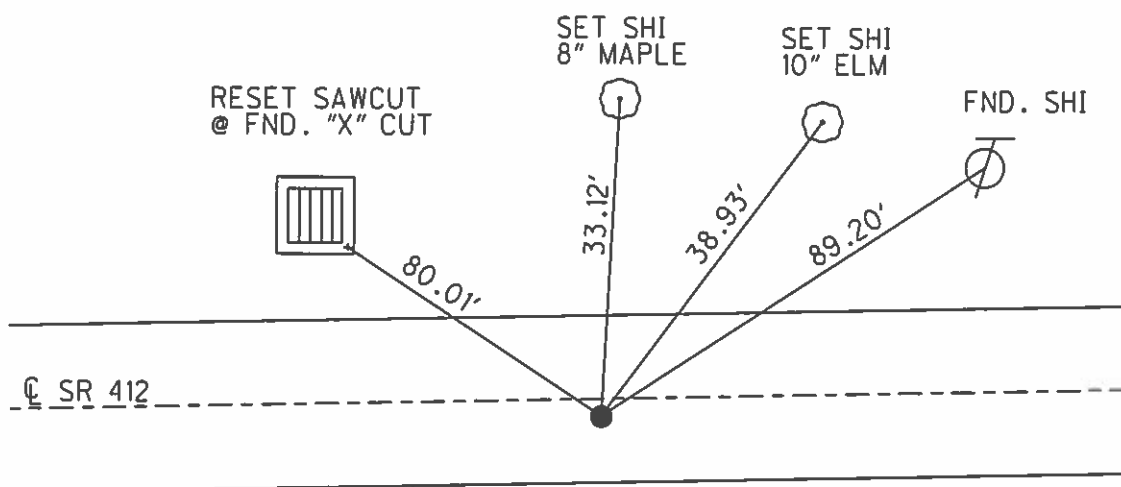

O.D.O.T. DISTRICT 2 SURVEY OFFICE

PERSONNEL

REFERENCE NO. 6

SHEET 15 OF 21

NOTES CHENEY

H.C. RIPPLE

R.C. BARBOUR

GEYMAN

DATE 4-28-93

WEATHER PART SUNNY

TEMP. 55°

ROUTE SR#412

COUNTY SANDUSKY

TOWNSHIP RILEY

SECTION 28

T. 5 N R. 16 E


TYPE MONUMENT Fd. P.K. & WASHER

ON SURFACE - ~~BELOW~~ ON

LEFT - ~~C~~ PAV'T. - RIGHT 1'

9' TO RT. EDGE PAVEMENT

S.L.M. 144+20

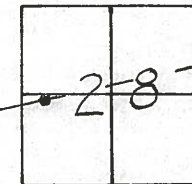

Record: 10-11-84


109+29.60 (SH. 231 Sec T. BR.)

1932 Set PK & WASHER ATOP

GALVANIZED BOLT ATOP I. PIN.

NOTE: 8-2-93

Set P.K. & WASHER JLR.

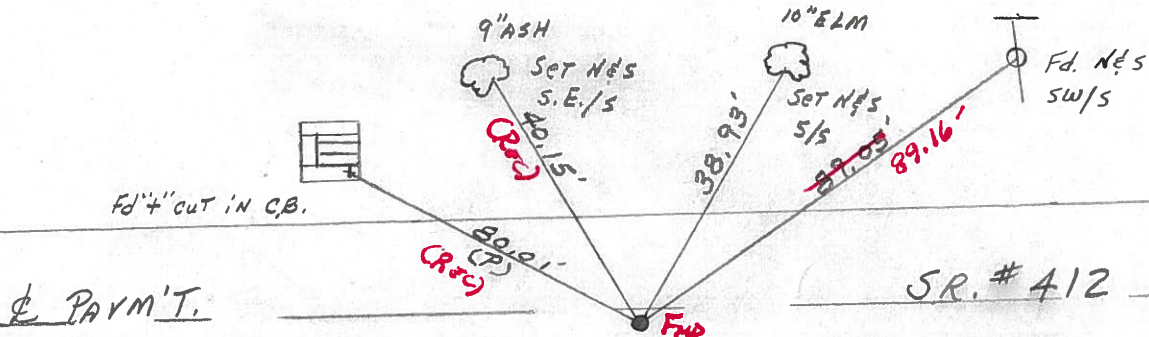

Preventive Maintenance
Microsurfaced 2000
Existing Point Uncovered
Date 7-24-2000

County Sandusky S.R. #412

Township Riley

Section 28

T5N, R16E

Personnel Cronin

Barbour

Ripple


Geyman

Date 10/11/87


Weather sunny

Temp. 65°

(6)

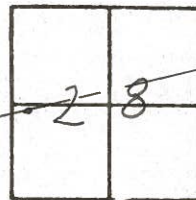

109+29.60 (S.H. 281 Sec T1 Br.)
(1932) set P.K. & washer atop
galvanized bolt atop I. pin

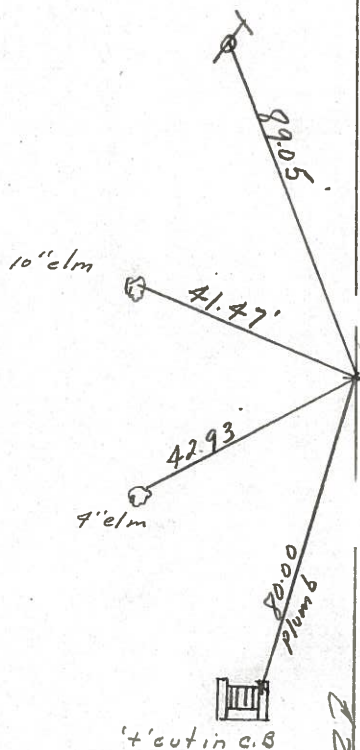

S.S.R. #4127

COUNTY Sandusky

Tied 2/4/75
DATE Drawn 1/30/75

Cronin	Schneider
Ash	Mosser
Ripple	Barbour S.L
Geyman S.L	

S. R. [#] 412


WEATHER overcast

SEC.

TEMP. 30°

DESCRIPTION Ties for Control Points

JOB NO. _____

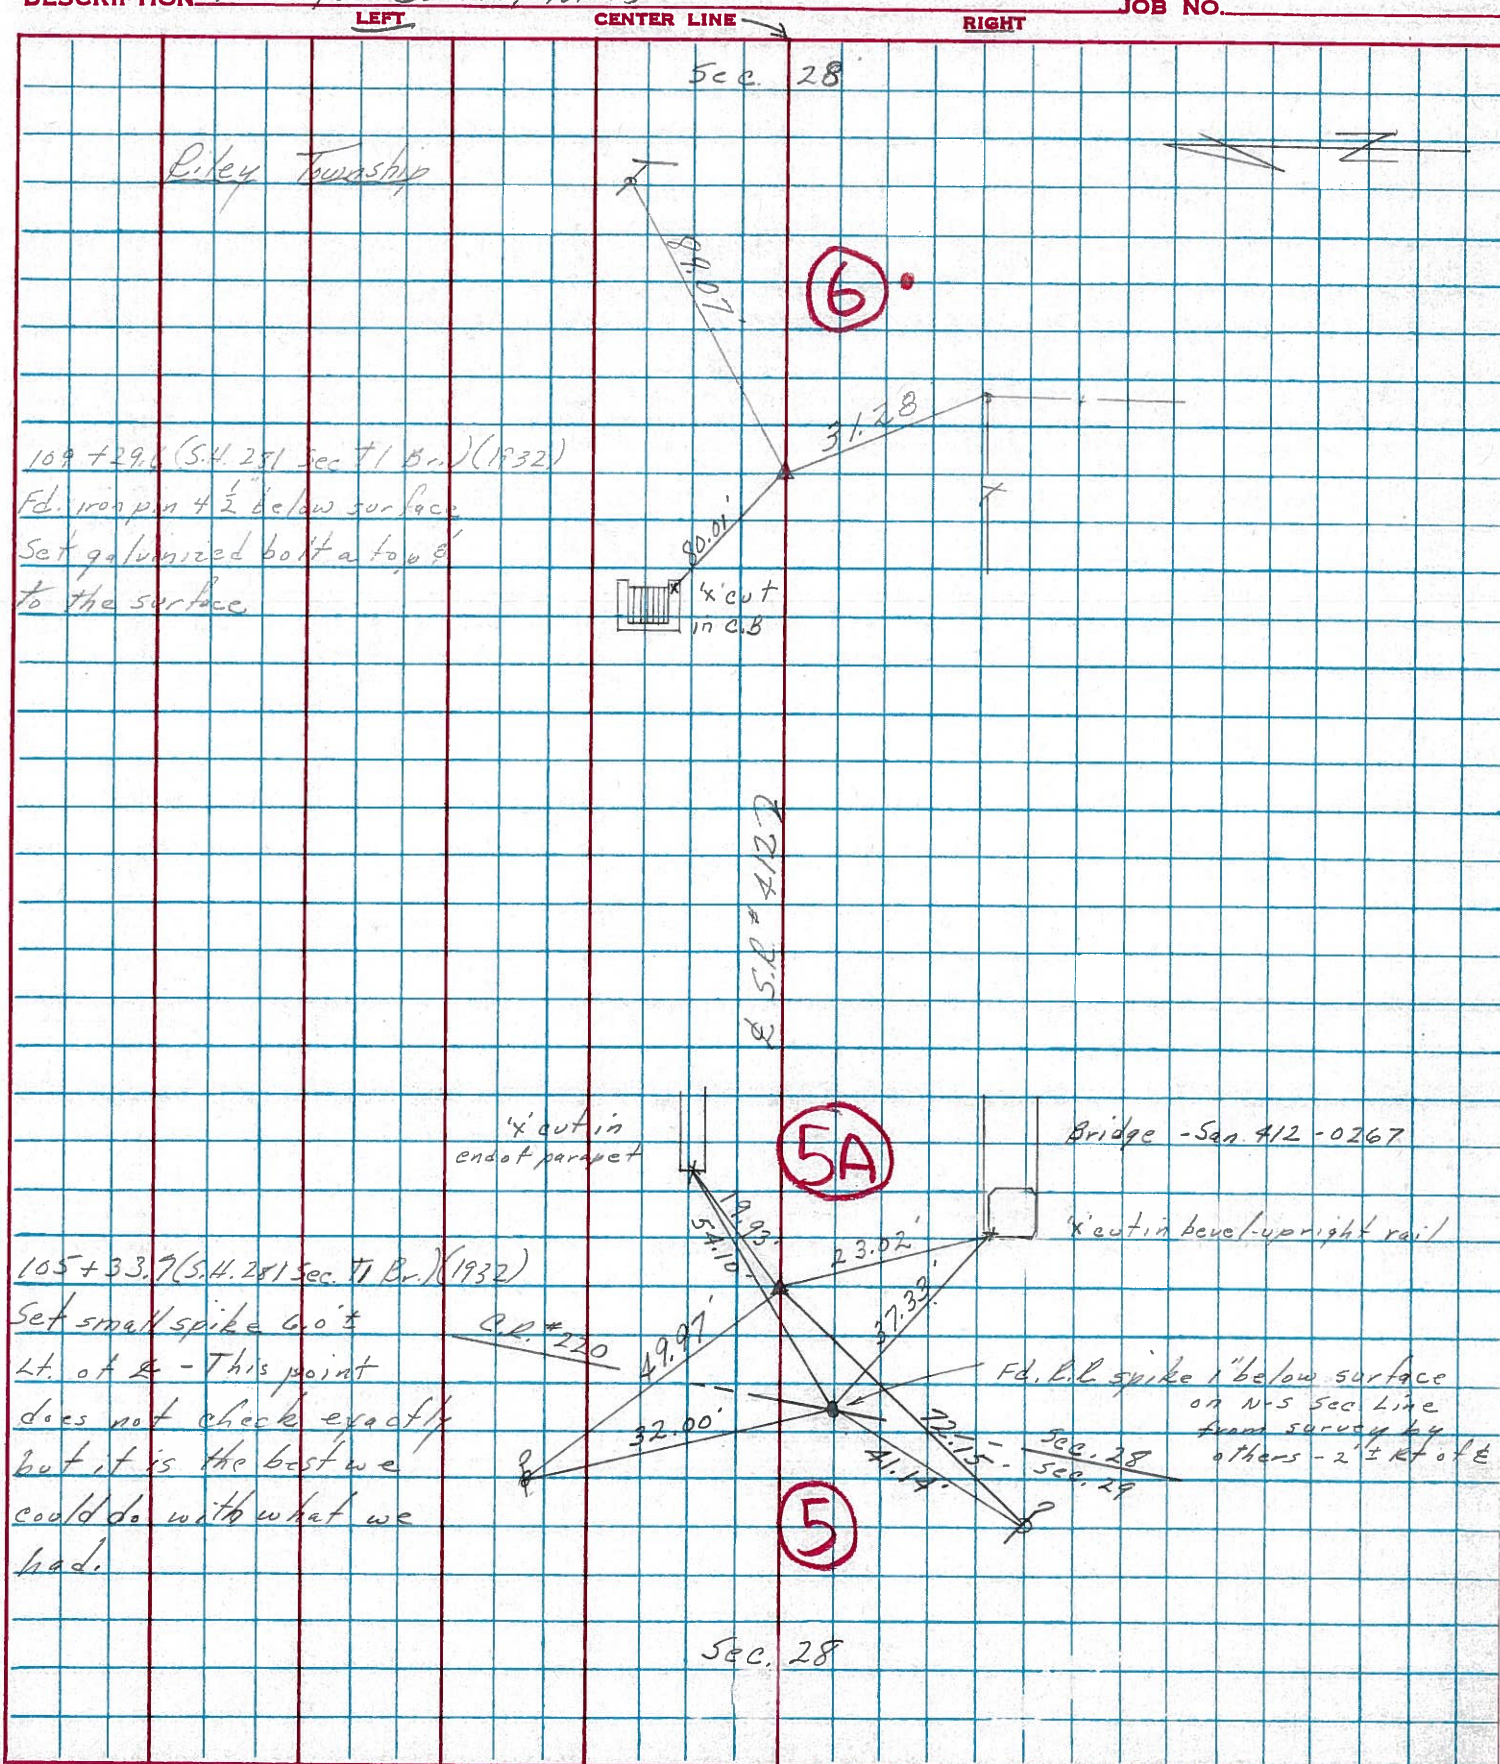

PERSONNEL	TITLE	PERSONNEL	TITLE	COUNTY	DATE	WEATHER	TEMP.
Schneider		Potts		Sandusky	Jan 1968		
Mosser				S. R. 41.2			
Barbour				SEC. N.E. of Fremont			
Redding							

DESCRIPTION Ties for Control Points JOB NO. _____

