

O.D.O.T. DISTRICT 2 SURVEY OFFICE (USE ONLY)

PERSONNEL

REFERENCE NO. 7

SHEET 25 OF 33

NOTES MILLER
H.C. MILLER
R.C. BARRIERE

DATE 9/3/24
WEATHER SUNNY
TEMP. 65°

ROUTE SR 412
COUNTY SANDUSKY
TOWNSHIP RILEY
SECTION 28

DWG BY PRESTON-COLVIN PID PAVING TRAIN

T 5 N R 16 E

TYPE MONUMENT MAG/SHANK

ON SURFACE - ~~BELOW~~ ON

OFFSET $\varnothing$ PAVEMENT 3.5' ~~LT~~ : RT

6.5' TO LT EDGE PAVEMENT

STATION: 181+05.26

HORIZ.DATUM: NAD83 (2011)


GEOID: 18

GRID: NORTHING: 619358.120

EASTING: 1827902.789

LDP: NORTHING: 315539.5217

EASTING: 188139.4004

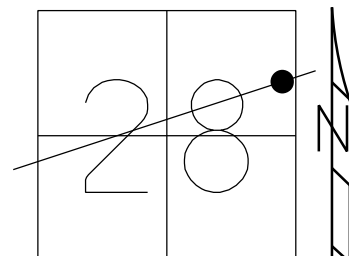

RECORD: 10-11-1984

P.I.
SET P.K./WASHER
ATOP IPIN, ATOP IPIPE
3.5' LT OF $\varnothing$


SET P.K./WASHER
8/2/93, JLR

FD P.K.NAIL
REF19
12/11/12, JMR

SET MAG/WASHER
NEWREF7
7/1/15, DCH

FD MAG SHANK
REF7
9/3/24, JAM

FD MAG SHANK
10/3/24, JAM

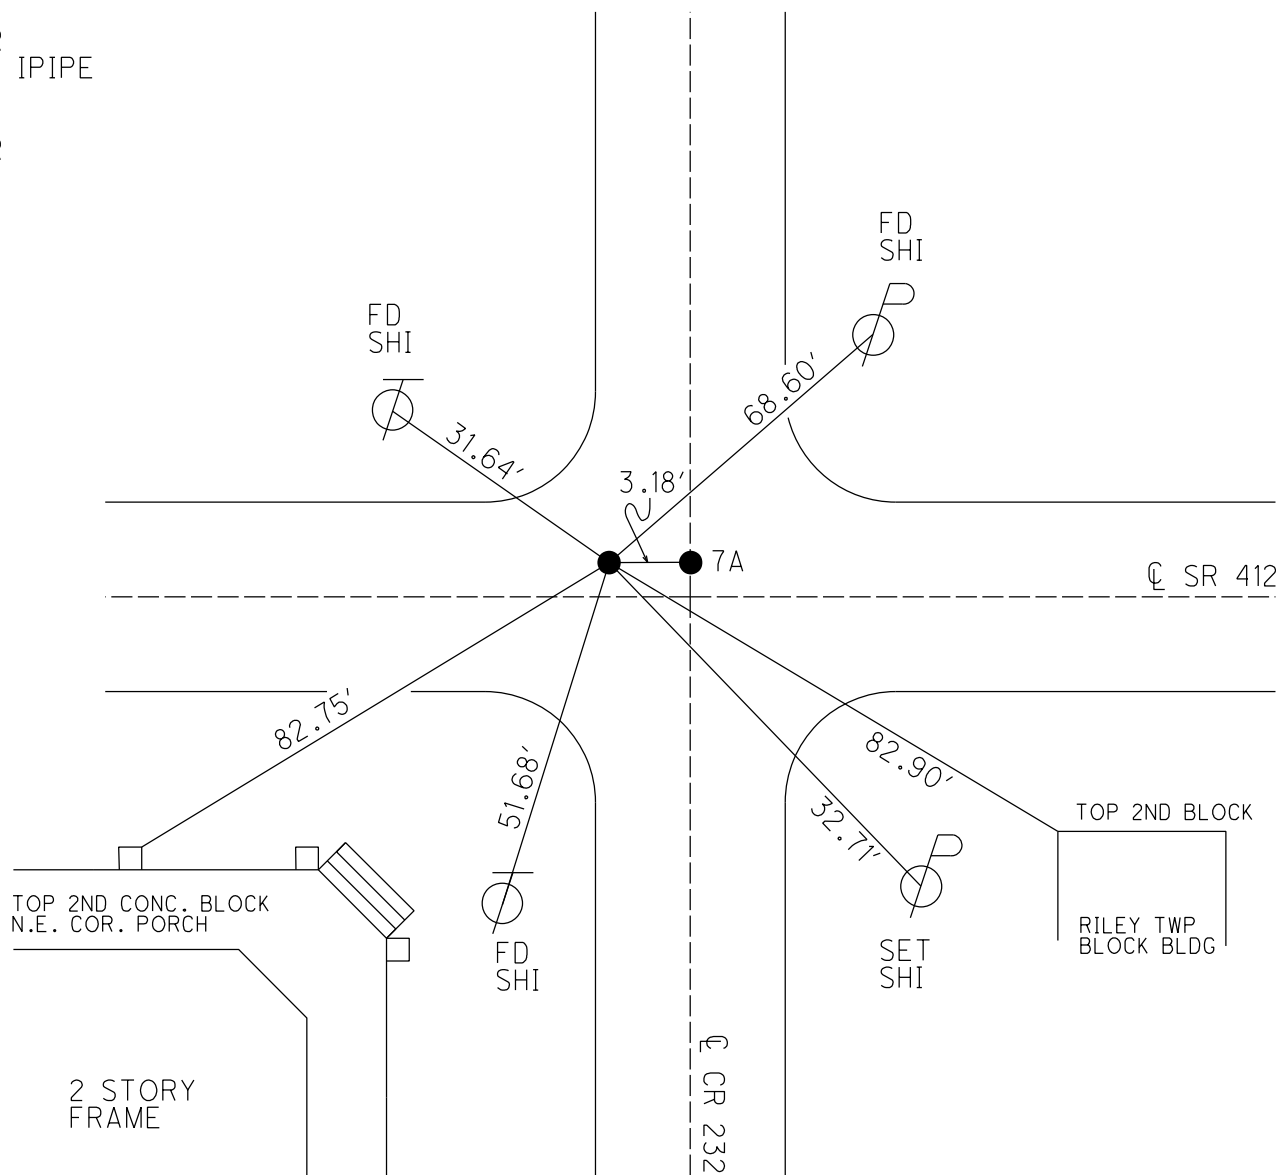

O.D.O.T. DISTRICT 2 SURVEY OFFICE (USE ONLY)

PERSONNEL

REFERENCE NO. 7

SHEET 25 OF 33

NOTES HOMAN

DATE 10-09-2014

ROUTE SR 412

H.C. LEU

WEATHER PARTLY SUNNY

COUNTY SANDUSKY

R.C. RHOADES

TEMP. 55°

TOWNSHIP RILEY

WESTFALL

SECTION 28

T 5 N R 16 E

TYPE MONUMENT P.K./WASHER


ON SURFACE - ~~BELOW~~ ON

LEFT - CL PAV'T - ~~RIGHT~~ 3.5'

6.5' TO LT EDGE PAVEMENT

S.L.M. 194+43.99

Grid: Northing: 619358.120 Easting: 1827902.789

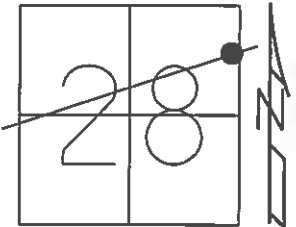

RECORD: 10-11-1984

P.I.

SET P.K./WASHER

ATOP IPIN, ATOP IPIPE

3.5' LT OF CL

SET P.K./WASHER

8/2/93, JLR

FD P.K.NAIL


REF19

12/11/12, JMR

SET MAG/WASHER

NEWREF7

7/1/15, DCH

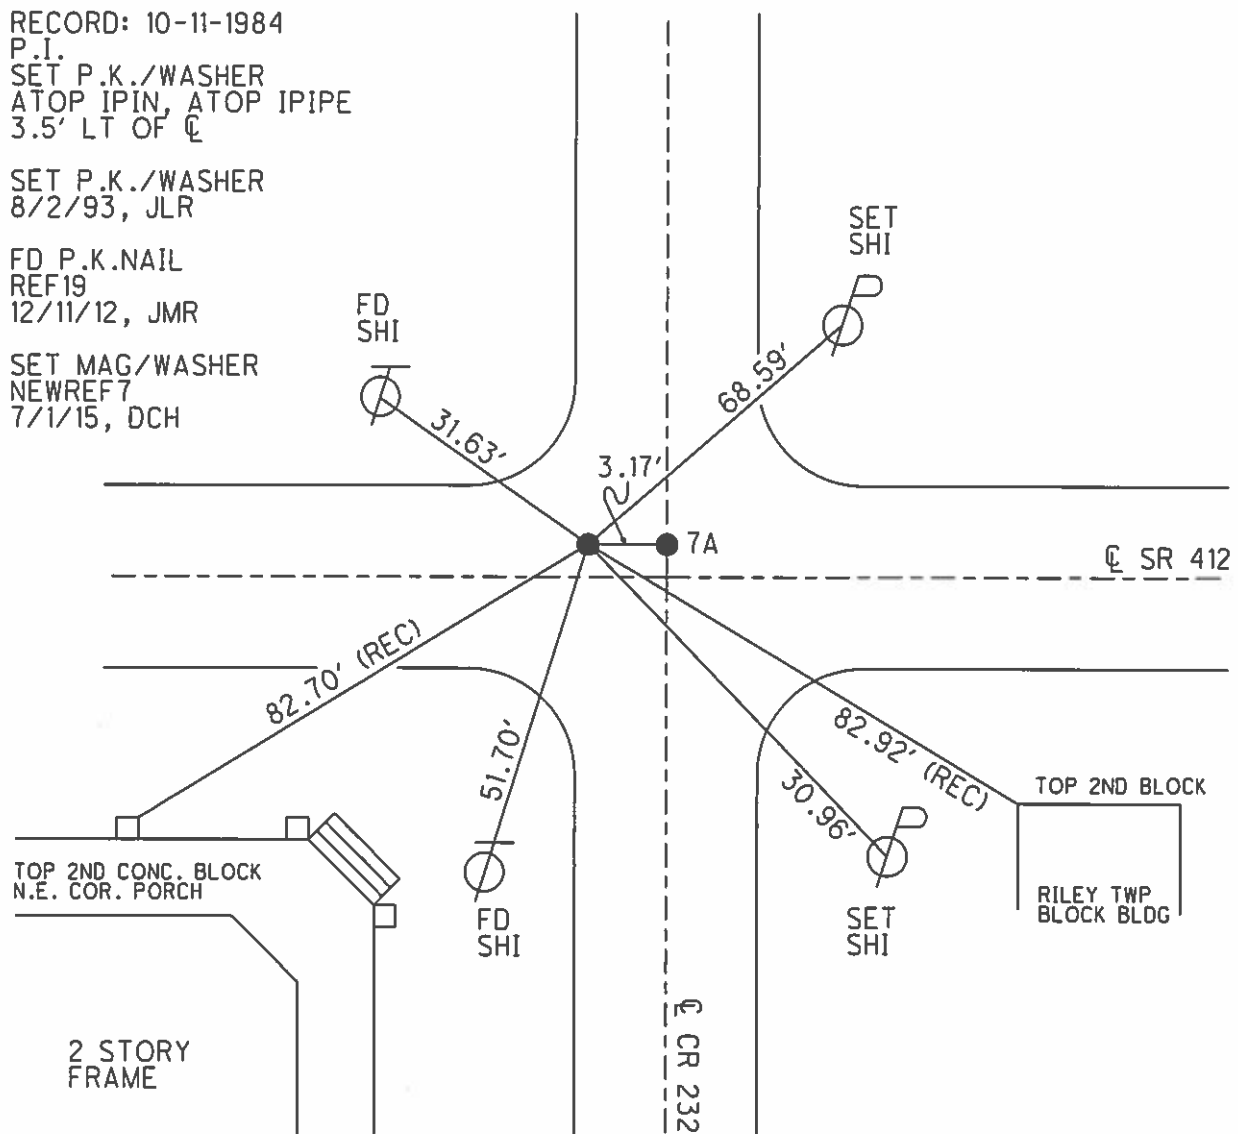

O.D.O.T. DISTRICT 2 SURVEY OFFICE

PERSONNEL

REFERENCE NO. # 7

SHEET 17 OF 21

NOTES CHENEY

H.C. RIPPLE

R.C. BARBOUR

GEYMAN

DATE 4-28-93

WEATHER PART SUNNY

TEMP. 55°

ROUTE SR#412

COUNTY SANDUSKY

TOWNSHIP RILEY

SECTION 28

T5 NR 16 E


TYPE MONUMENT Fd. P.K.'s & WASHERS

ON SURFACE - ~~BELOW~~ ON

LEFT - C PAV'T. - ~~RIGHT~~ 3.5' ±

6.5' TO LT. EDGE PAVEMENT

S.L.M. P.I. 193+51⁺ Sec. Line Point 193+54⁺

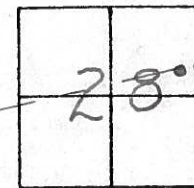

Record: 10-11-84

ON SEC. LINE SET P.K. & WASHER

A Top RR Spk. FROM County

REFERENCES APPEARS TO BE ON

BACK TANG OF SR#4/2 PRODUCED
EASTWARD 35' + 15' OF 15' OF 15'

EASTERLY 3.3 - 21.04 & 04 FARM'T.
PT


F.L.
SAT PK Eulachon 1 T. 2

Set P.A. & WASHER A Top
IRON ROD A Top IRON PIPE

3.5' ± LT, & PAVM'T,

NOTE: SET P.K. & WASHERS
ON BOTH POINTS 8-2-93

J.L.R.

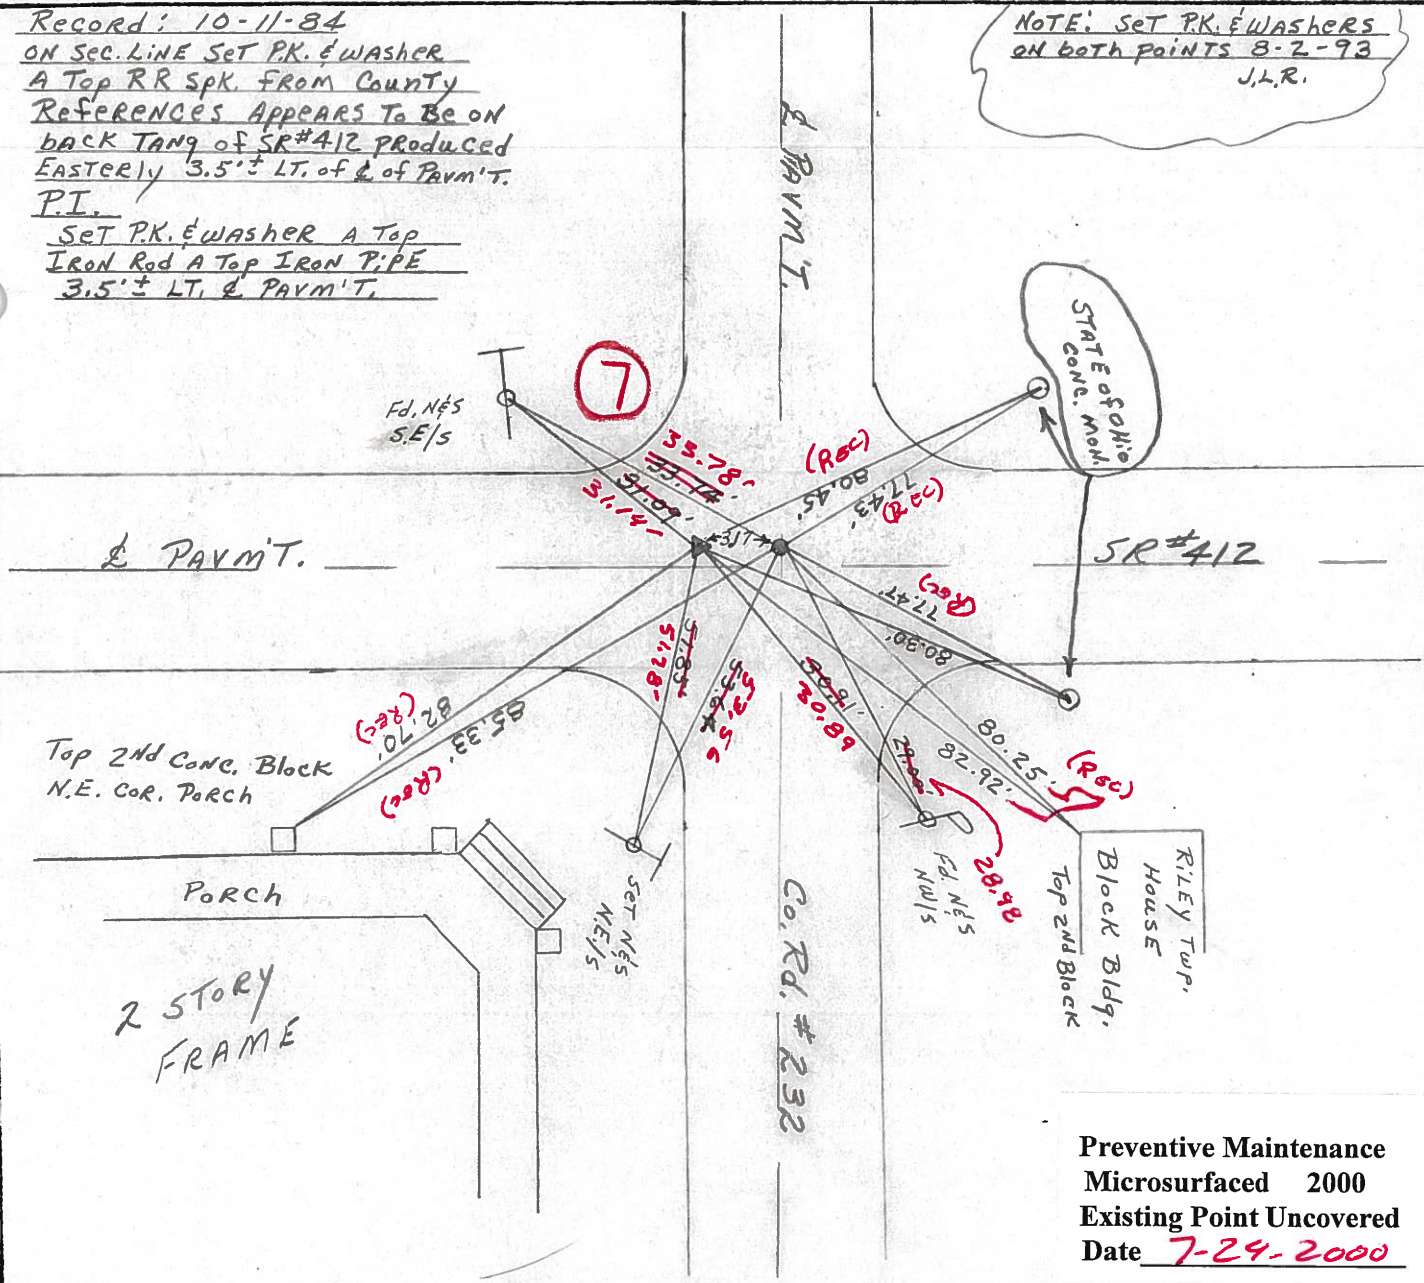

Preventive Maintenance
Microsurfaced 2000
Existing Point Uncovered
Date 7-24-2000

Q.D.O.T. DISTRICT 2 SURVEY OFFICE

SHEET 13 OF

County Sandusky S.R. # 412

Township Riley

Section 28

T⁵N, R¹⁶E

Personnel Cronin

Ripple

Geyman


Barbour

7

Date 10/11/84

Weather Sunny


Temp. 65°

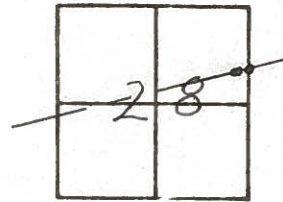

ON Sec. Line set P.K.'
washer at top R.R. spike
from County References
Appears to be on back
Tang. of S.R. #412, produced
easterly 2.5' Lt. of Pavement.

P.I.
Set P.K.' washer at top
iron rod at top iron
pipe 2.5' Lt. of Pavement

C.R. #232

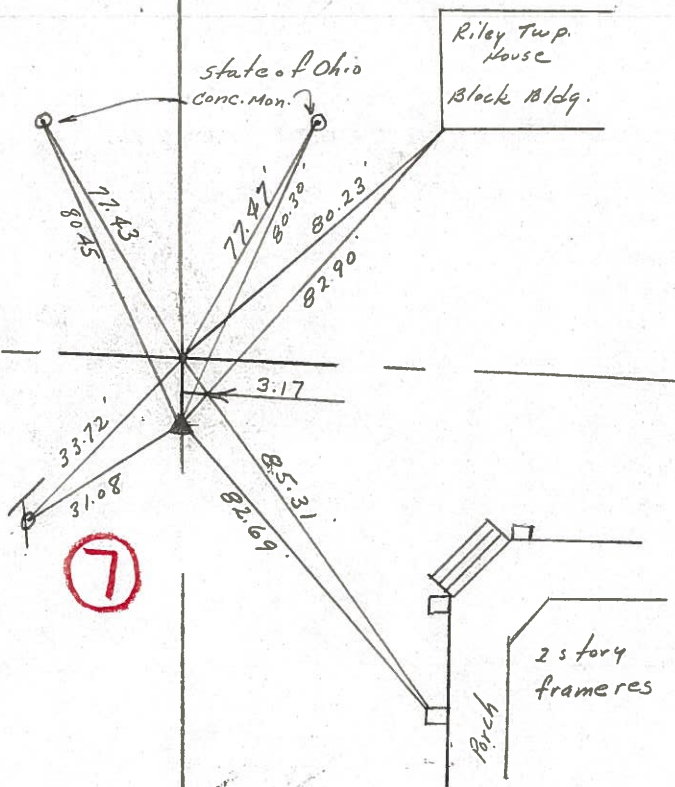

S.R. # 412

Tied 2/4/75

DATE Drawn 1/30/75

PERSONNEL	TITLE	PERSONNEL	TITLE
Cronin		Schneider	
Asb		Mosser	
Ripple		Barbour S.L.	
Geyman S.L.			

COUNTY Sandusky

S. R. # 412


WEATHER overcast

SEC.

TEMP. 30°

DESCRIPTION Ties for Control Points

JOB NO.

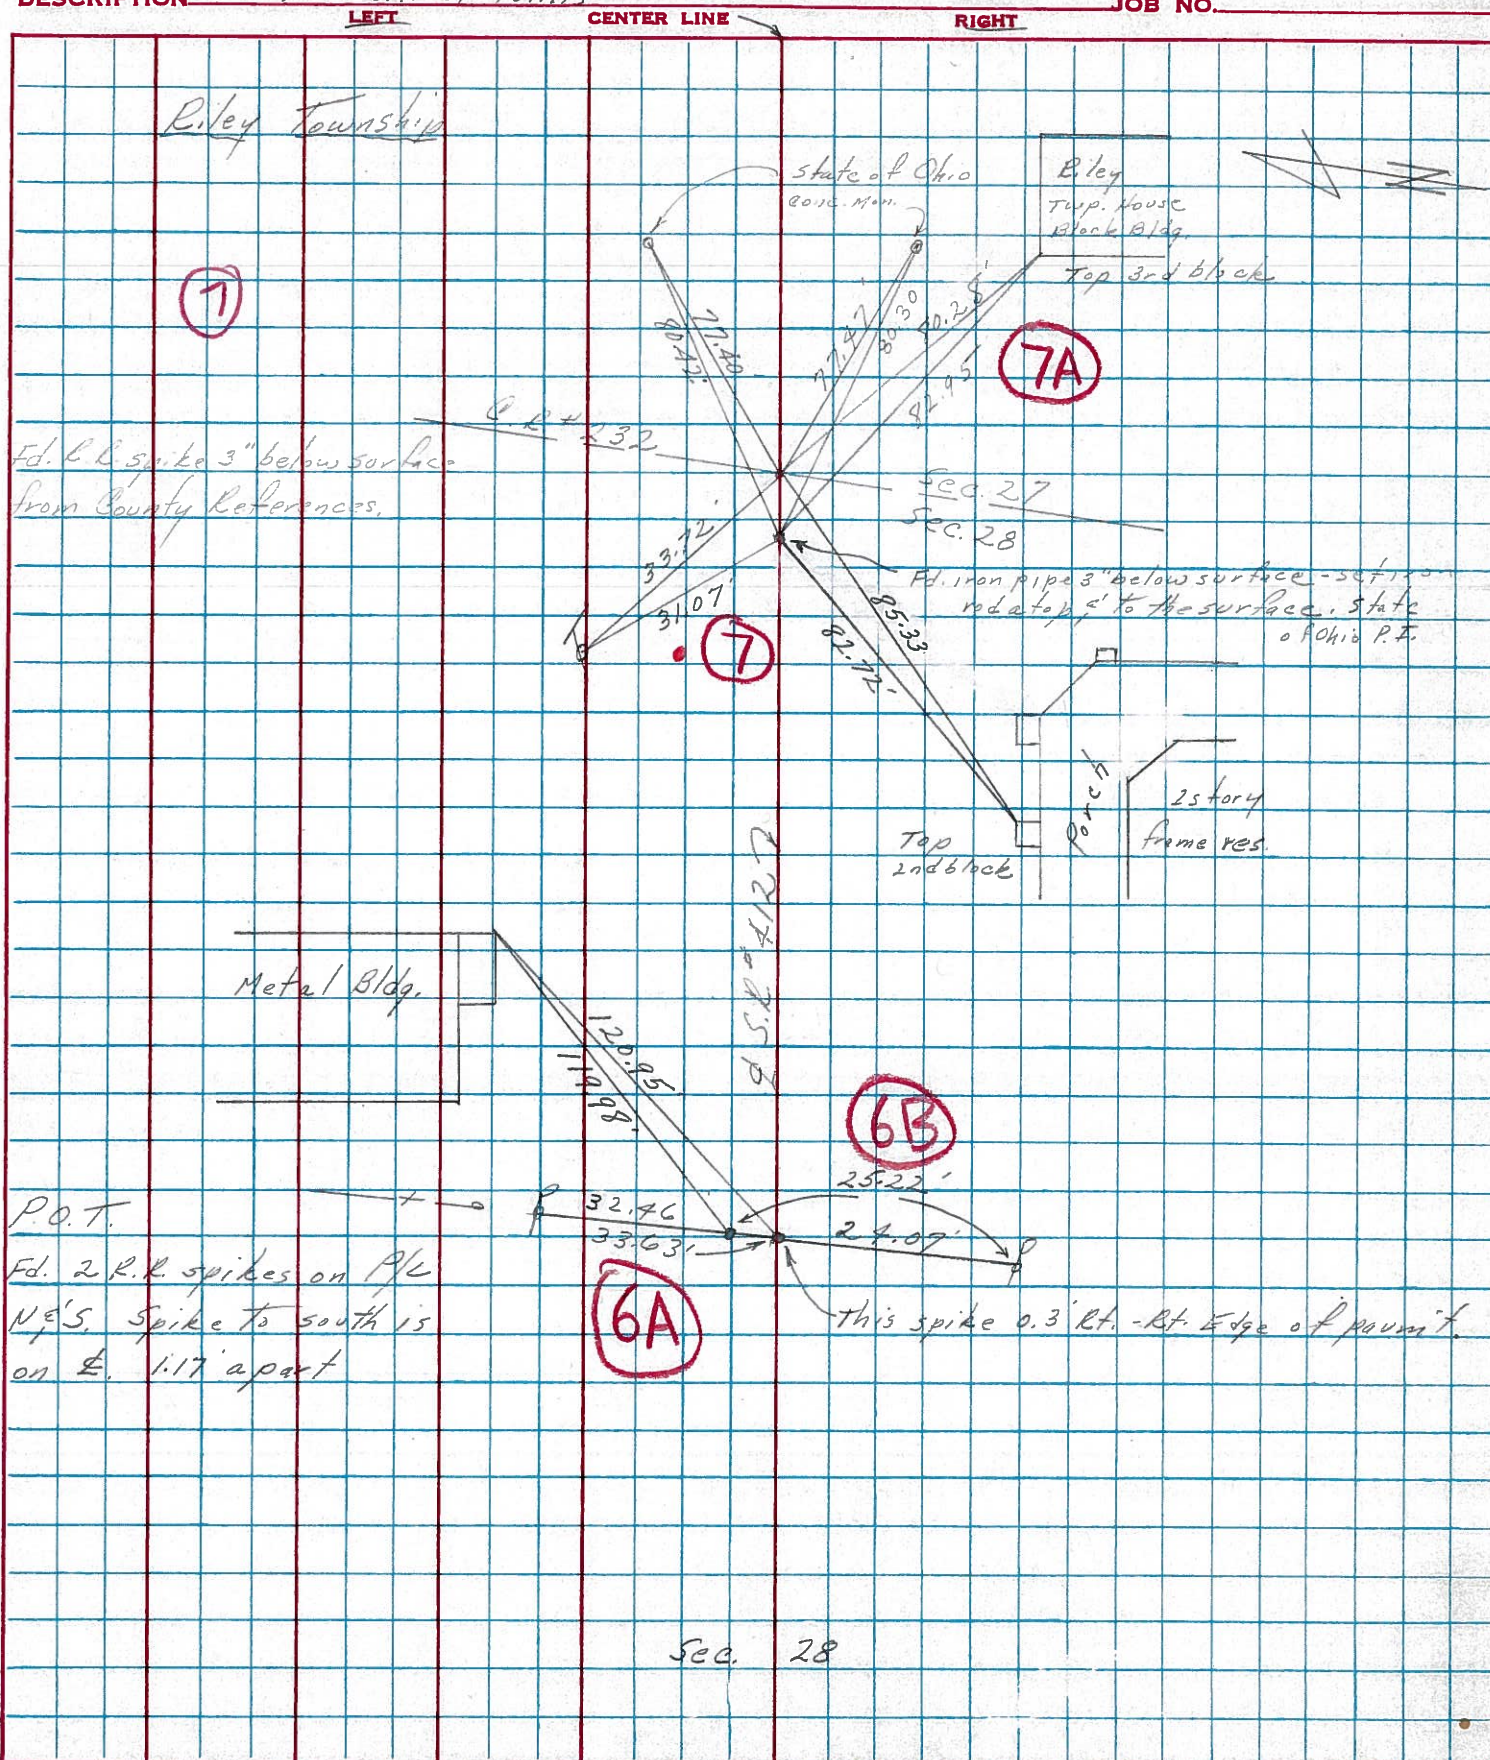

PERSONNEL	TITLE	PERSONNEL	TITLE
Schneider		Potts	
Mosser			
Barbour			
Redding			

DESCRIPTION Ties for Control ints

COUNTY Sandusky DATE Jan. 1968

S. R. 412 WEATHER _____

SEC. N. E. of Fremont TEMP. _____

JOB NO. _____

