

O.D.O.T. DISTRICT 2 SURVEY OFFICE (USE ONLY)

PERSONNEL

REFERENCE NO. 13A

SHEET 14 OF 17

NOTES PRESTON-COLVIN DATE 9/3/24

H.C. NEISE WEATHER SUNNY

R.C. PRESTON-COLVIN TEMP. 60°

ROUTE SR 510

COUNTY SANDUSKY

TOWNSHIP RILEY

SECTION 23

DWG BY PRESTON-COLVIN PID PAVING TRAIN

T 5 N R 16 E

TYPE MONUMENT MAG/SHANK

ON SURFACE - ~~BELOW~~ ON

OFFSET 0.6" ~~LT~~ : RT

8.5' TO LT EDGE PAVEMENT

STATION: 239+28

HORZ.DATUM: NAD83 (2011)


GEOID: 18

GRID: NORTHING:

EASTING:

LDP: NORTHING:

EASTING:

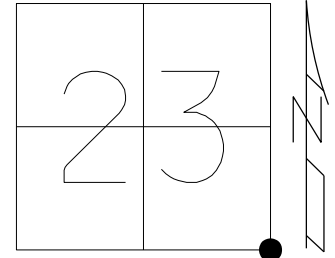

FD PART OF
THE "+" PAINT
PAVING TRAIN
WENT THROUGH
HERE 10/3/24, JAM

