

O.D.O.T. DISTRICT 2 SURVEY OFFICE (USE ONLY)

PERSONNEL

REFERENCE NO. 14

SHEET 15 OF 18

NOTES RHOADES

DATE 5/25/21

ROUTE SR 510

H.C. NIESH

WEATHER CLOUDY

COUNTY SANDUSKY

R.C. RHOADES

TEMP. 86°

TOWNSHIP RILEY

SECTION 23

DWG BY RHOADES

PID PAVTRAIN

T 5 N R 16 E

TYPE MONUMENT 1/2" IPIN

~~ON SURFACE~~ - BELOW 3"

OFFSET Q PAVEMENT ON LT : RT

- TO - EDGE PAVEMENT


STATION: 265+10

HORZ.DATUM: NAD83 2011


GEOID: NAVD88 2018

GRID: NORTHING: 624367.526

EASTING: 1838551.137

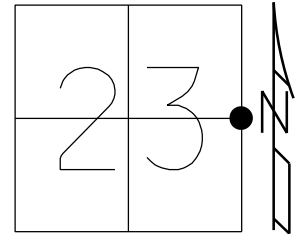

RECORD:
FD R.R.SPIKE
1971
SET MAG/WASHER
10/08/04, DCH
FD 1/2" IPIN
3" DOWN
REF14
5/25/21, TDN
1/20/23, JMR
FD HOLE
10/3/24, JAM

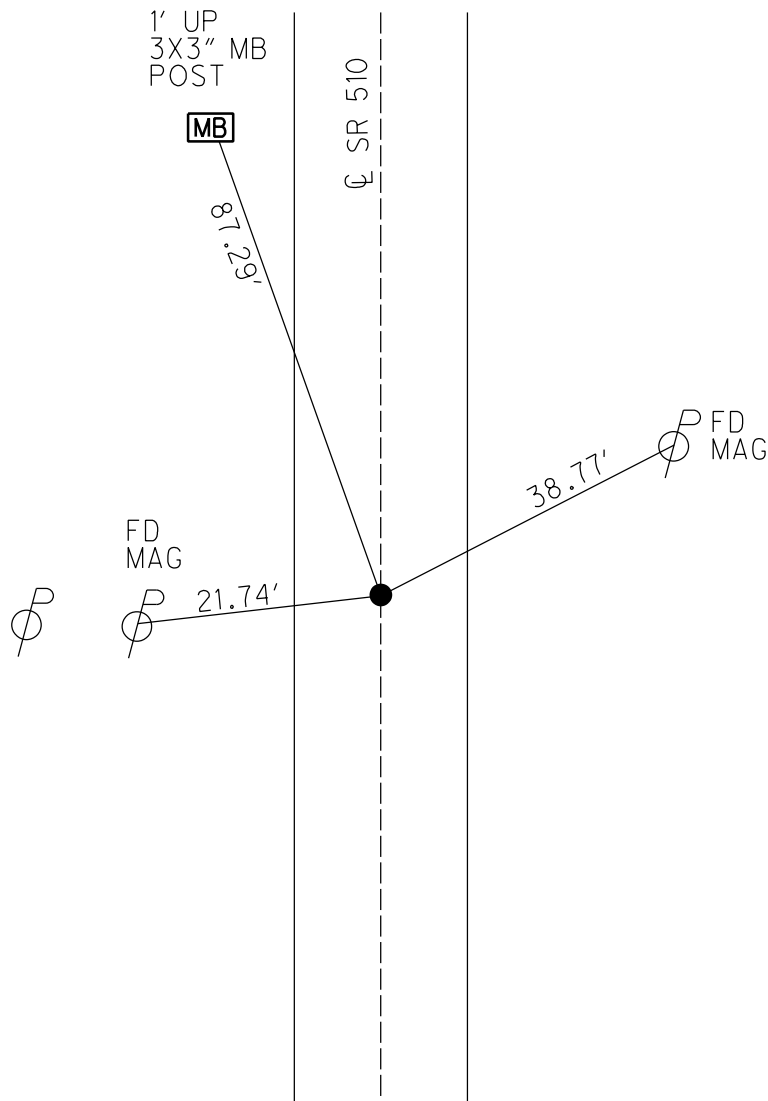

O.D.O.T. DISTRICT 2 SURVEY OFFICE (USE ONLY)

PERSONNEL

REFERENCE NO. 14

SHEET 15 OF 18

NOTES RHOADES

DATE 5/25/21

ROUTE SR 510

H.C. NIESH

WEATHER CLOUDY

COUNTY SANDUSKY

R.C. RHOADES

TEMP. 86°

TOWNSHIP RILEY

SECTION 23

DWG BY RHOADES PID PAVTRAIN

T 5 N R 16 E

TYPE MONUMENT 1/2" IPIN

~~ON SURFACE~~ - BELOW 3"

OFFSET Q PAVEMENT ON LT : RT

- TO - EDGE PAVEMENT


STATION: 265+10

HORIZ.DATUM: NAD83 2011


GEOID: NAVD88 2018

GRID: NORTHING: 624367.526

EASTING: 1838551.137

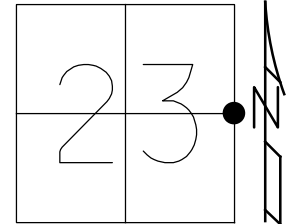

RECORD:
FD R.R.SPIKE
1971
SET MAG/WASHER
10/08/04, DCH
FD 1/2" IPIN
3" DOWN
REF14
5/25/21, TDN
1/20/23, JMR

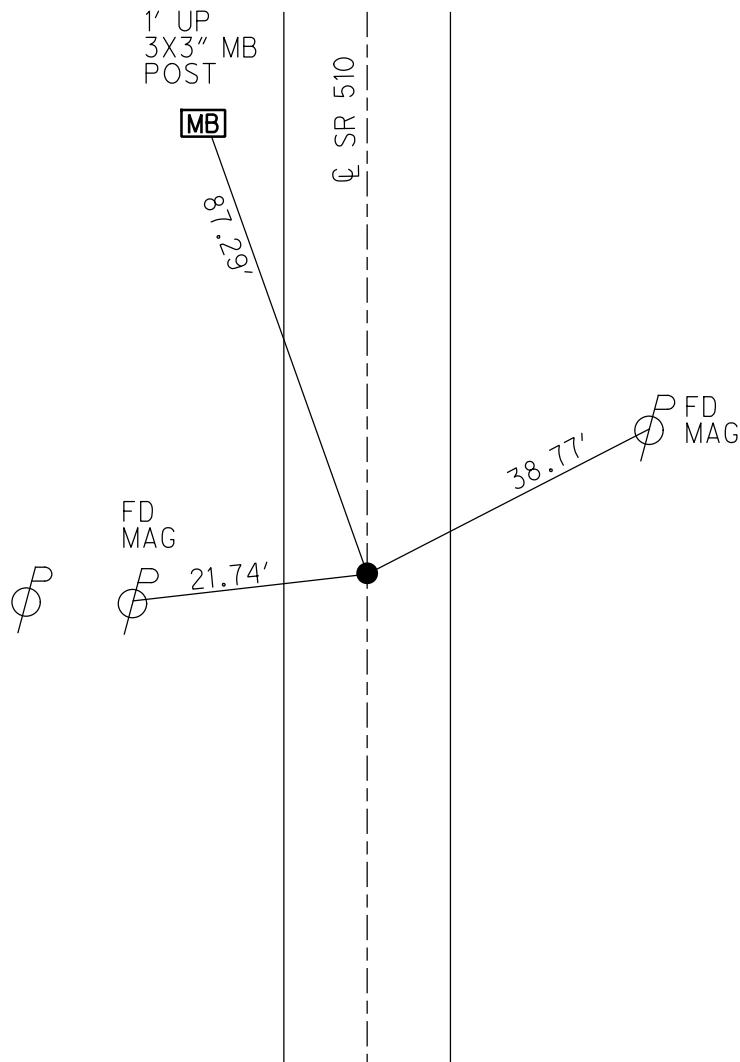

O.D.O.T. DISTRICT 2 SURVEY OFFICE (USE ONLY)

PERSONNEL

REFERENCE NO. 14

SHEET 15 OF 18

NOTES RHOADES

DATE 5/25/21

ROUTE SR 510

H.C. NIESH

WEATHER CLOUDY

COUNTY SANDUSKY

R.C. RHOADES

TEMP. 86°

TOWNSHIP RILEY

SECTION 23

DWG BY RHOADES

PID PAVTRAIN

T 5 N R 16 E

TYPE MONUMENT 1/2" IPIN

~~ON SURFACE~~ - BELOW 3"

OFFSET Q PAVEMENT ON LT : RT

- TO - EDGE PAVEMENT


STATION: 265+10

HORIZ.DATUM: NAD83 2011

GEOID: NAVD88 2018

GRID: NORTHING: 624367.526

EASTING: 1838551.137

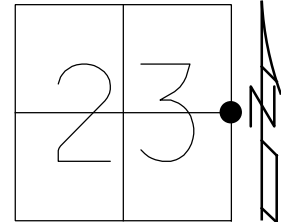

RECORD:
FD R.R.SPIKE
1971
SET MAG/WASHER
10/08/04, DCH
FD 1/2" IPIN
3" DOWN
REF14
5/25/21, TDN

