

O.D.O.T. DISTRICT 2 SURVEY OFFICE (USE ONLY)

PERSONNEL

REFERENCE NO. 8 B

SHEET 10 OF 11

NOTES CRONIN DATE 4/14/82
 H.C. RIPPLE WEATHER SUNNY
 R.C. GEYMAN TEMP. 42°
MOSSER/BARBOUR

ROUTE SR 523
 COUNTY SANDUSKY
 TOWNSHIP RICE
 SECTION 25

DWG BY NIESE PID _____

T 6 N R 15 E

TYPE MONUMENT IPIN

~~ON SURFACE~~ - BELOW 6"


OFFSET \odot PAVEMENT _____ LT : RT

_____ TO _____ EDGE PAVEMENT


STATION: 168+26.83

HORZ. DATUM: _____ GEOID: _____

GRID: NORTHING: _____ EASTING: _____

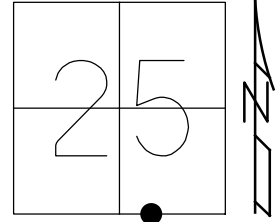

RECORD: P.O.T.
 STA 168+26.83
 FD IPIN
 6" BELOW
 SAME REF AS FOR
 STA 160+26.83
 4/14/82, CRONIN
 D.N.F.
 POINT IS 800'
 EAST OF REF8
 1993

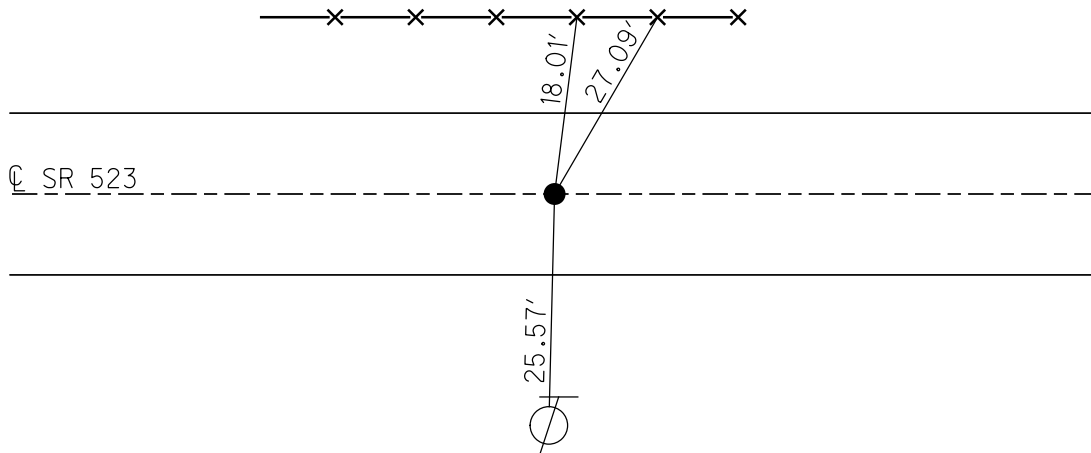

County Sandusky S.R. # 523

Date 1/14/82

Township Rice

Weather Sunny

Section 25

Temp. 45°

T. 6N, R. 15E




Personnel Cronin

Ripple


Geyman

Mosser

Barbour

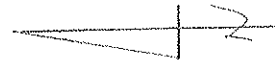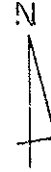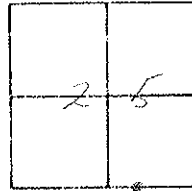

P.O.T.
168+26.83
Ed. T. Rod 6" below surface
Same Ref. as for Sta. 160+26.83

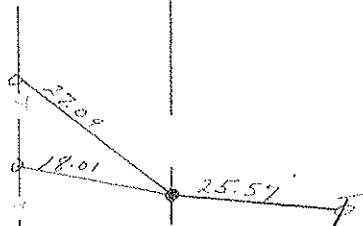

& R/W S.R. = 5237

NOTE: THIS POINT
 IS 800' EAST OF
 POINT #8
 BUT WAS NOT LOCATED
 IN 1993