


O.D.O.T. DISTRICT 2 SURVEY OFFICE (USE ONLY)

PERSONNEL	REFERENCE NO.	24AA	SHEET	8	OF	18
NOTES	NIESE	DATE	4/03/25	ROUTE	SR 590	
H.C.	NIESE	WEATHER	BREEZEY	COUNTY	SANDUSKY	
R.C.	PRESTON-COLVIN	TEMP.	60°	TOWNSHIP	WASHINGTON	
	-----			SECTION	2	
				T	5	N
				R	14	E

TYPE MONUMENT MAG/WASHER
ON SURFACE - ~~BELOW~~ ON
LEFT - ~~C~~ PAV'T - RIGHT 0.80'
----- TO ----- EDGE PAVEMENT
S.L.M. 638+38.8
GRID: NORTHING: 640088.316 EASTING: 1770828.892

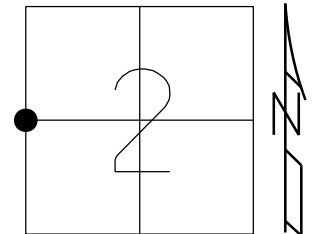

FD 1/2" IPIN
REF 24AA
10/11/23, TDN
FD 1/2" IPIN
4/03/25, TDN
SET MAG/W
NEW REF 24AA
7/24/25, TDN

