

O.D.O.T. DISTRICT 2 SURVEY OFFICE (USE ONLY)

PERSONNEL

REFERENCE NO. 9

SHEET 4 OF 48

NOTES AUBLE

DATE 9/1/21

ROUTE SR 18

H.C. NIESE

WEATHER WINDY

COUNTY SENECA

R.C. AUBLE

TEMP. 72°

TOWNSHIP LOUDON

SECTION 16

DWG BY RHOADES

PID PVTRAIN

T 2 N R 13 E

TYPE MONUMENT P.K./WASHER

ON SURFACE - ~~BELOW~~ ON

OFFSET ¢ PAVEMENT 4.3' ± : RT

7.0' TO RT EDGE PAVEMENT


STATION: 162+24.55

HORZ.DATUM: NAD83(2011)


GEOID: 2012A

GRID: NORTHING: 536169.245

EASTING: 1726773.474

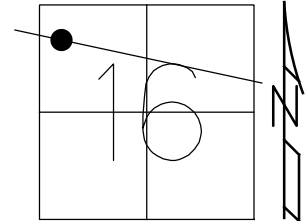

RECORD: P.T.
STA.162+24.55
FD P.K./SHINER
ATOP R.R. SPIKE
FD P.K.NAIL
7/10/97, JFO
SET P.K./WASHER
10/22/97, TR
FD P.K./WASHER
REF9
4/22/19
8/19/19
2/15/22, JFO
2/10/23, JMR

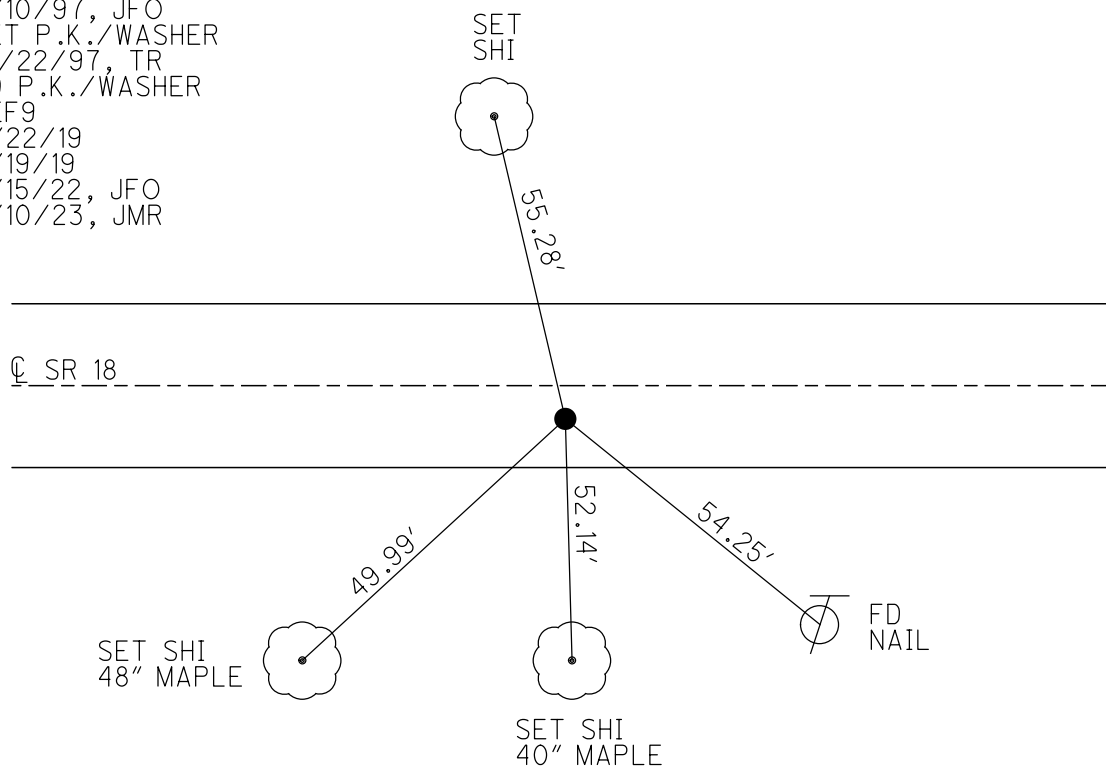

O.D.O.T. DISTRICT 2 SURVEY OFFICE (USE ONLY)

PERSONNEL

REFERENCE NO. 9

SHEET 4 OF 48

NOTES AUBLE

DATE 9/1/21

ROUTE SR 18

H.C. NIESE

WEATHER WINDY

COUNTY SENECA

R.C. AUBLE

TEMP. 72°

TOWNSHIP LOUDON

DWG BY RHOADES

PID PVTRAIN

SECTION 16

T 2 N R 13 E

TYPE MONUMENT P.K./WASHER

ON SURFACE - ~~BELOW~~ ON

OFFSET CL PAVEMENT 4.3' ~~LT~~ : RT

7.0' TO RT EDGE PAVEMENT


STATION: 162+24.55

HORZ.DATUM: NAD83(2011)


GEOID: 2012A

GRID: NORTHING: 536169.245

EASTING: 1726773.474

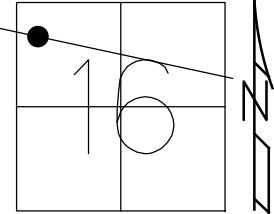

RECORD: P.T.
STA.162+24.55
FD P.K./SHINER
ATOP R.R. SPIKE
FD P.K.NAIL
7/10/97, JFO
SET P.K./WASHER
10/22/97, TR
FD P.K./WASHER
REF9
4/22/19
8/19/19
2/15/22, JFO

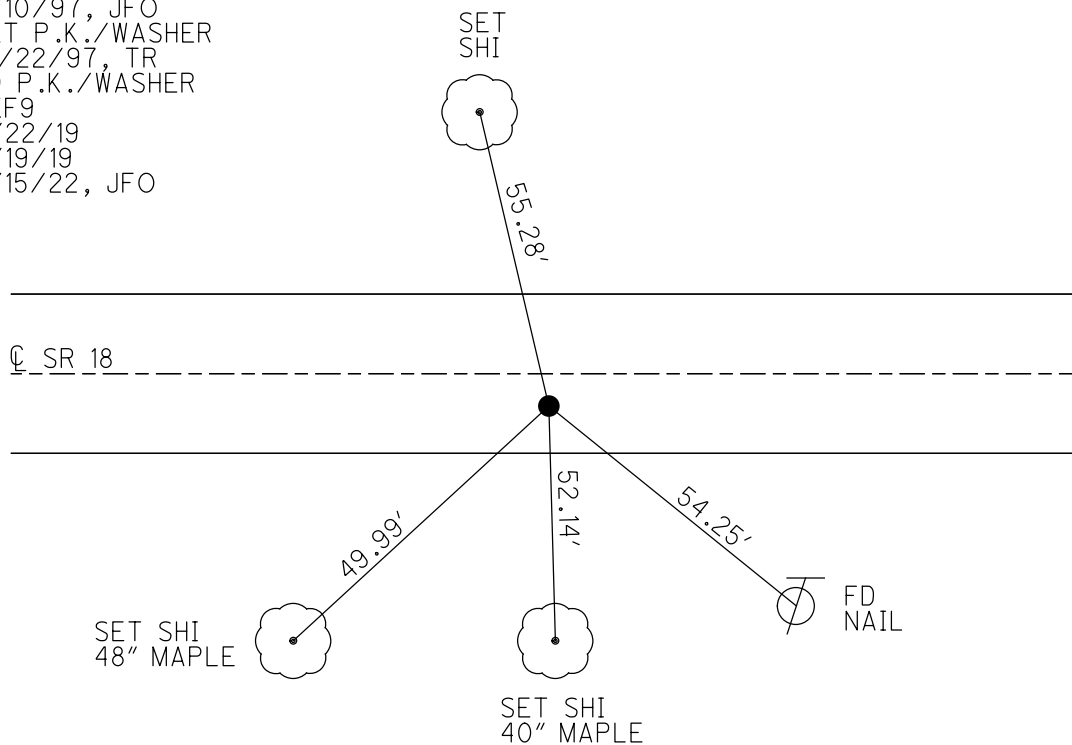

O.D.O.T. DISTRICT 2 SURVEY OFFICE (USE ONLY)

PERSONNEL

REFERENCE NO. 9

SHEET 4 OF 48

NOTES BARNHISEL

DATE 7/10/97

ROUTE SR 18

H.C. CANTERBURY

WEATHER SUNNY

COUNTY SENECA

R.C. WEAVER

TEMP. 75°

TOWNSHIP LOUDON

ROUSOS

SECTION 16

DWG BY NIESE

PID NO PID

T 2 N R 13 E

TYPE MONUMENT P.K.NAIL

ON SURFACE - ~~BELOW~~ ON

OFFSET CL PAVEMENT 4.7' ~~LT~~ : RT

7.0' TO RT EDGE PAVEMENT


STATION: 162+24.55

HORIZ.DATUM: NAD83(2011)


GEOID: 2012A

GRID: NORTHING: 536169.245

EASTING: 1726773.474

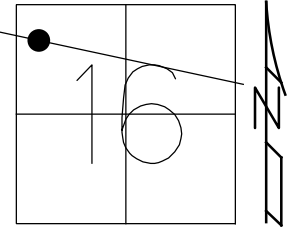

RECORD: P.T.
STA.162+24.55
FD P.K./SHINER
ATOP R.R. SPIKE
FD P.K.NAIL
7/10/97, JFO
SET P.K./WASHER
10/22/97, TR
FD P.K./WASHER
REF9
4/22/19
8/19/19, JFO

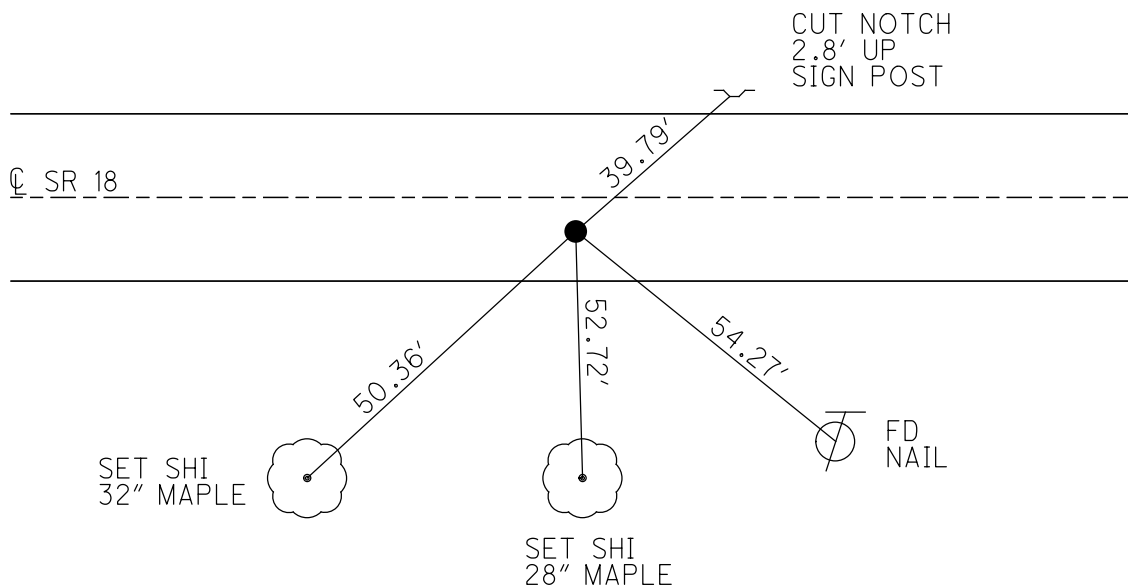

O.D.O.T. DISTRICT 2 SURVEY OFFICE

PERSONNEL

REFERENCE NO. 9

SHEET 9 OF 22

NOTES BAR WASHED

H.C. CANTERBURY

R.C. WEAVER

ROUSO

DRAWN BY ROUSO

DATE 7-10-97

WEATHER SHAWY

TEMP. +75°

ROUTE 18

COUNTY SENECA

TOWNSHIP LOUDBON

SECTION 16

T2 N R13 E


TYPE MONUMENT PK SHINER (END PK)

ON SURFACE - BELOW SURFACE

LEFT - 6 PAV'T. - RIGHT 4.7'

7.0' TO RT EDGE PAVEMENT

S.L.M. 5.321.6 SLK

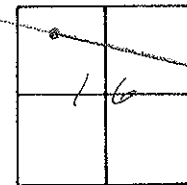

RESET PK WASHED

10-22-97


TR

P.T. SURVEY

162+24.55

PK SHINER ATOP

R.R. SPIKE

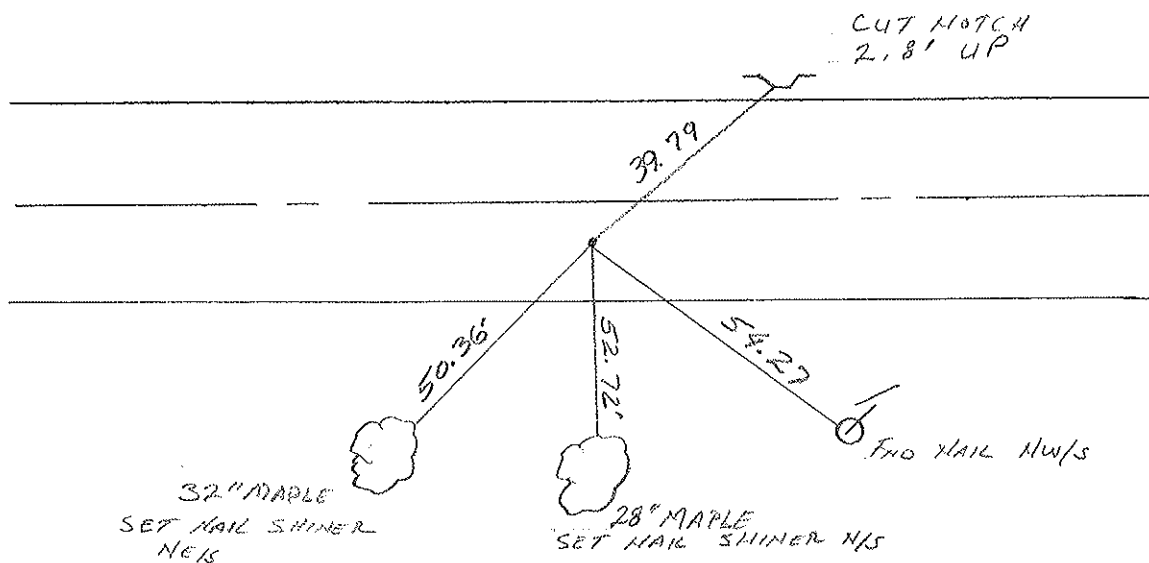

O.D.O.T. DISTRICT 2 SURVEY OFFICE

PERSONNEL

REFERENCE NO. 9

SHEET 9 OF

NOTES CRONIN (DRAW)

H.C. RIPPLE

R.C. BARBOUR (MEAS.)

GEYMAN

DATE 11/12/87

WEATHER OVERCAST

TEMP. 39°

ROUTE #18

COUNTY SENECA

TOWNSHIP LOUDON

SECTION 16

T 2 N R 13 E


TYPE MONUMENT P.K. & SHINER

ON SURFACE - BELOW

LEFT - & PAV'T. - RIGHT 3.8' RT. ±

TO EDGE PAVEMENT

S.L.M.

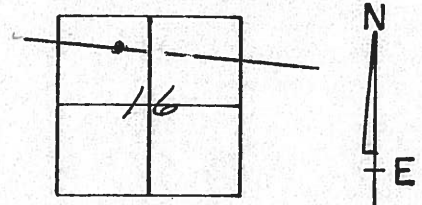


P.T. SURVEY

162 + 24.55

P.K. & SHINER ATOP

R.R SPIKE

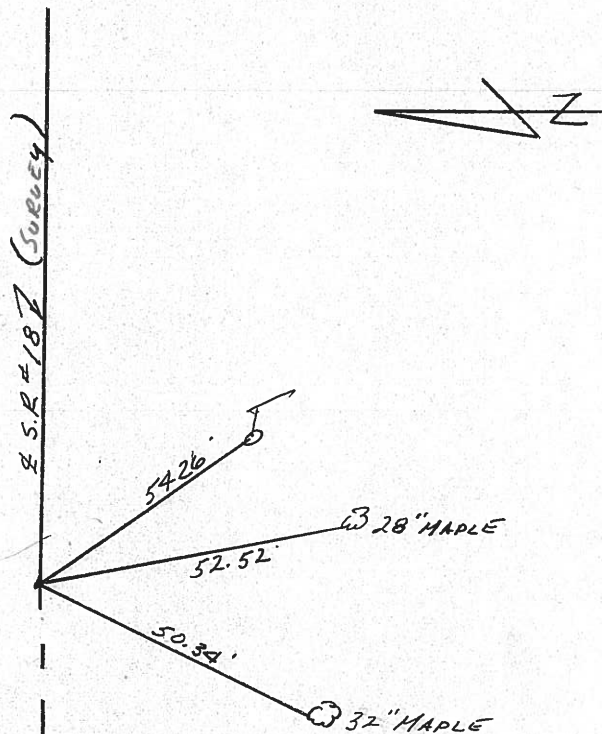


PERSONNEL	TITLE	PERSONNEL	TITLE
Schneider			
Mosser			
Barbour			
Potts			

COUNTY Seneca DATE 10-16-68

S. R. 18 WEATHER Fair - Windy

SEC. Eastoria to Bascom TEMP. 78°

DESCRIPTION Ties for Control Points JOB NO. _____

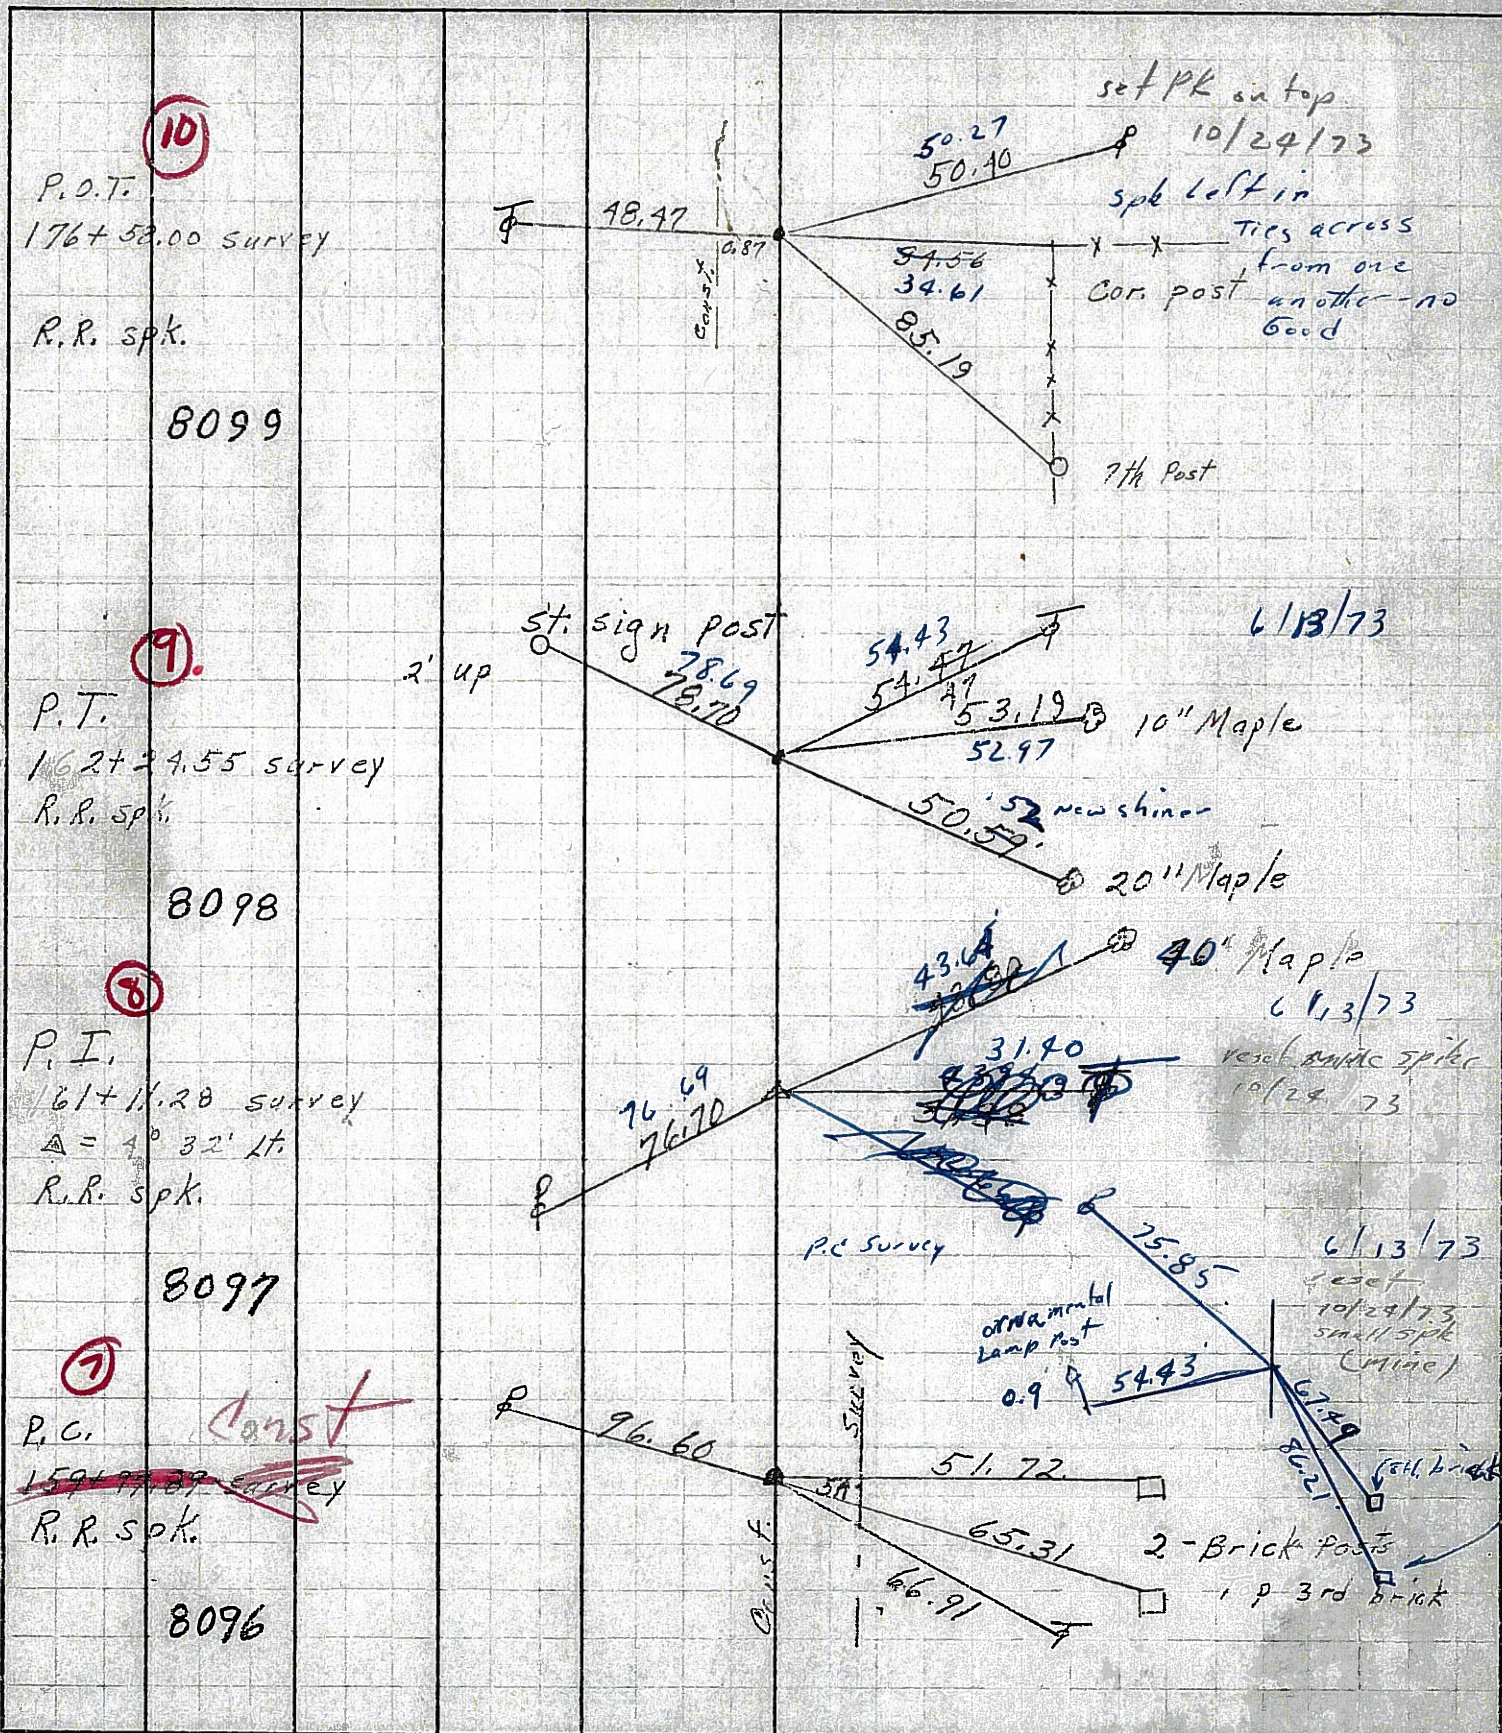

PERSONNEL TITLE PERSONNEL TITLE

Schneider

COUNTY Seneca

DATE 10-16-68

Mossler

S. R. 18

WEATHER Fair-Windy

Barbour

SEC. Fostoria to Bascom

TEMP 78°

Potts

DESCRIPTION

Ties for Control Points

LEFT

CENTER LINE

RIGHT

JOB NO.


10

P.O.T.

176+58.00 survey

R.R. spk.

8099

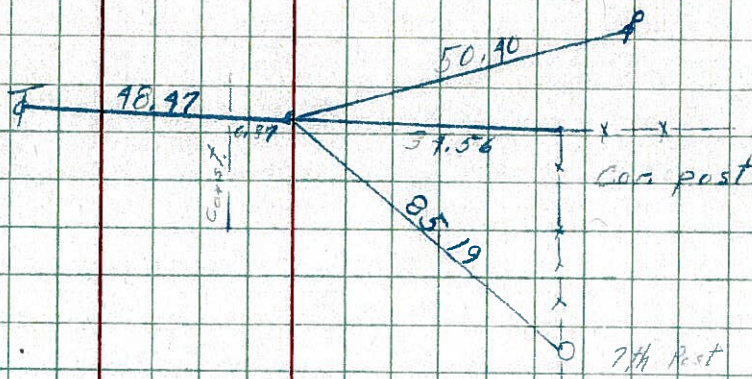


9

P.T.

162+39.55 survey

R.R. spk.

8098

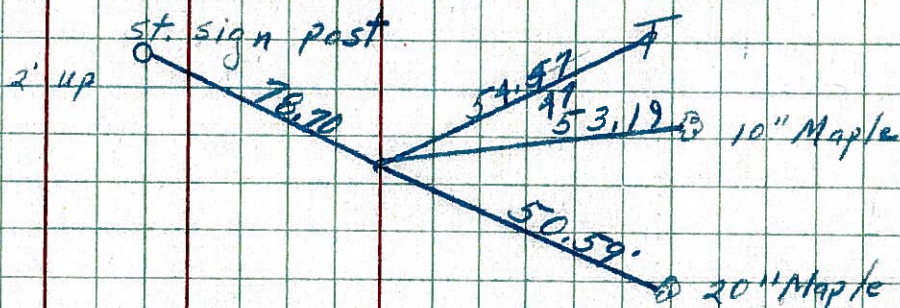

8


P.I.

161+11.26 survey

 $\Delta = 4^\circ 32' 11''$

R.R. spk.

8097

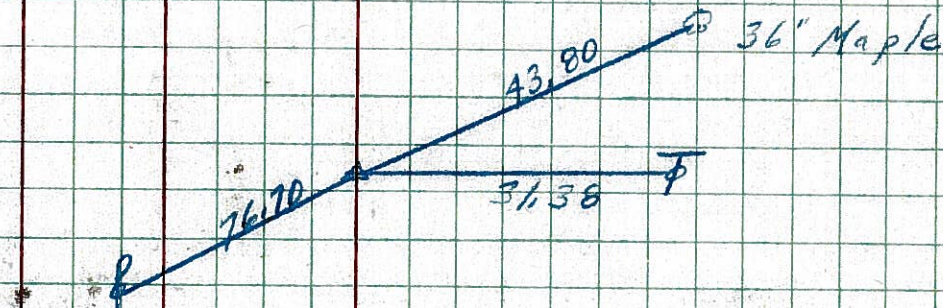


7

P.C.

159+77.89 survey

R.R. spk.

8096

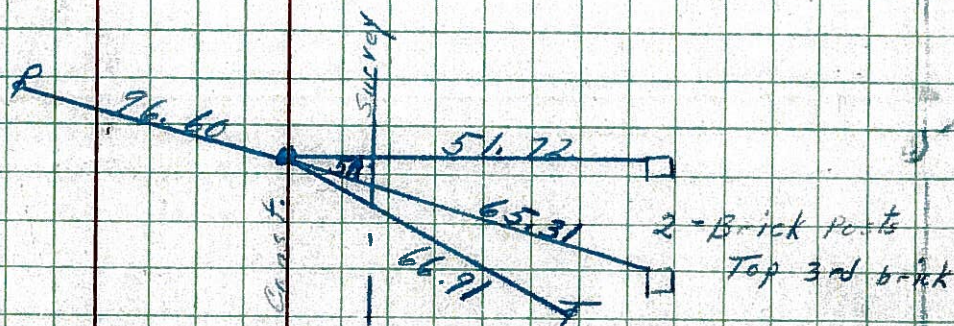

PERSONNEL TITLE PERSONNEL TITLE

Schneider

COUNTY Seneca

DATE 10-16-68

Mosser

S. R. 18

WEATHER Fair-Windy

Barbour

SEC. Fostoria to Bascom

TEMP. 78°

Potts

DESCRIPTION

Ties for Control Points

LEFT

CENTER LINE

RIGHT


JOB NO.

P.O.T.

176+58.00 Survey

R.R. spk.

3059

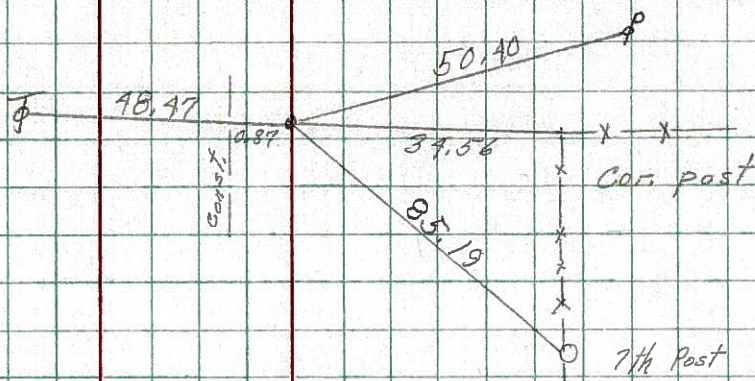


P.T.

162+24.55 survey

R.R. spk.

3078

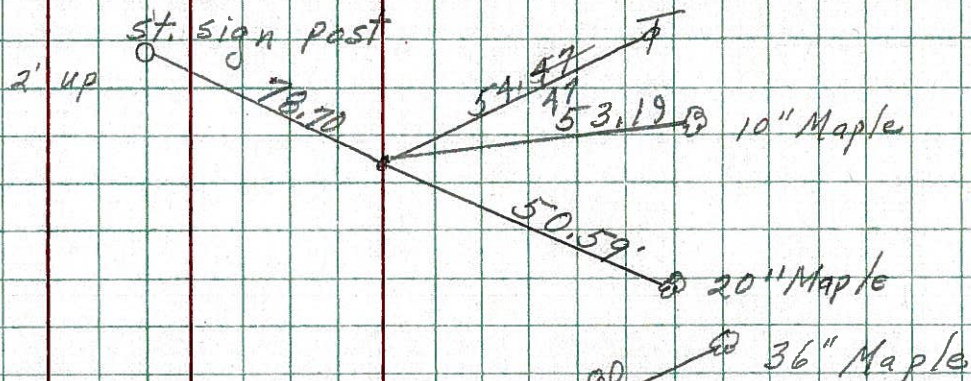


P.I.

161+11.28 survey

 $\Delta = 4^\circ 32' 11''$

R.R. spk.

3077

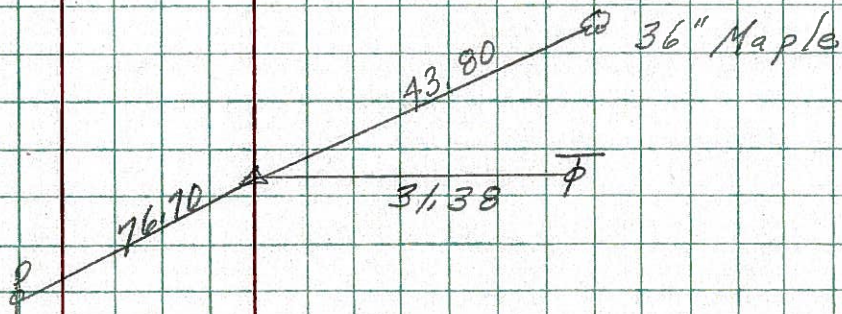


P.C.

159+92.89 survey

R.R. spk.

3076

CONST.

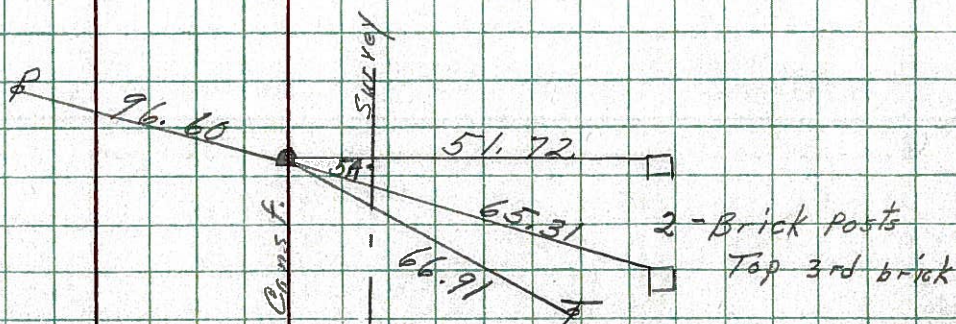

PERSONNEL	TITLE	PERSONNEL	TITLE
1	2	3	4
5	6	7	8
9	10	11	12
13	14	15	16
17	18	19	20
21	22	23	24
25	26	27	28
29	30	31	32
33	34	35	36
37	38	39	40
41	42	43	44
45	46	47	48
49	50	51	52
53	54	55	56
57	58	59	60
61	62	63	64
65	66	67	68
69	70	71	72
73	74	75	76
77	78	79	80
81	82	83	84
85	86	87	88
89	90	91	92
93	94	95	96
97	98	99	100

COUNTY Sentec

DATE Dec. 3, '58

Fish
Gromin
Leemaster

624r

John K.

#18 Factoria - Bescano Rd. WEATHER Cloudy

SEC. 50518-(1.77-8.60)

TEMP. 35°

DESCRIPTION Control Point/ lies - E survey & correct.

LEFT

CENTER LINE SUPPLY

RIGHT

JOB NO