

O.D.O.T. DISTRICT 2 SURVEY OFFICE (USE ONLY)

PERSONNEL

REFERENCE NO. 13

SHEET OF

NOTES MILLER DATE 8/5/24

H.C. NIESE WEATHER SUNNY

R.C. PRESTON-COLVIN TEMP. 80°

ASTON

DWG BY BARRIERE PID 92371

ROUTE SR 18

COUNTY SENECA

TOWNSHIP LOUDON

SECTION 16

T 2 N R 13 E

TYPE MONUMENT MAG NAIL/WASHER

ON SURFACE - BELOW ON

OFFSET $\odot$ PAVEMENT 1' RT LT : RT

 TO EDGE PAVEMENT

STATION: 203+17.80

HORIZ.DATUM: NAD83 (2011)


GEOID: 18

GRID: NORTHING: 535880.492


EASTING: 1730855.427

LDP: NORTHING:

EASTING:

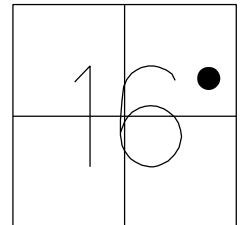

RECORD: P.I.
 $\Delta=02^{\circ}41'$ LT
STA.203+17.80
FD MINE SPIKE
4" BELOW
7/11/97, TMR
SET P.K./WASHER
11/6/97, MB
FD P.K.SHANK
REF13
4/22/19, JFO
SET MAG/WASHER
8/19/19, JFO
FD MAG/WASHER
9/1/21, DSA
2/15/22, JFO
2/10/23, JMR
10/6/23, DSA
SET MAG/WASHER
8/5/24, TDN

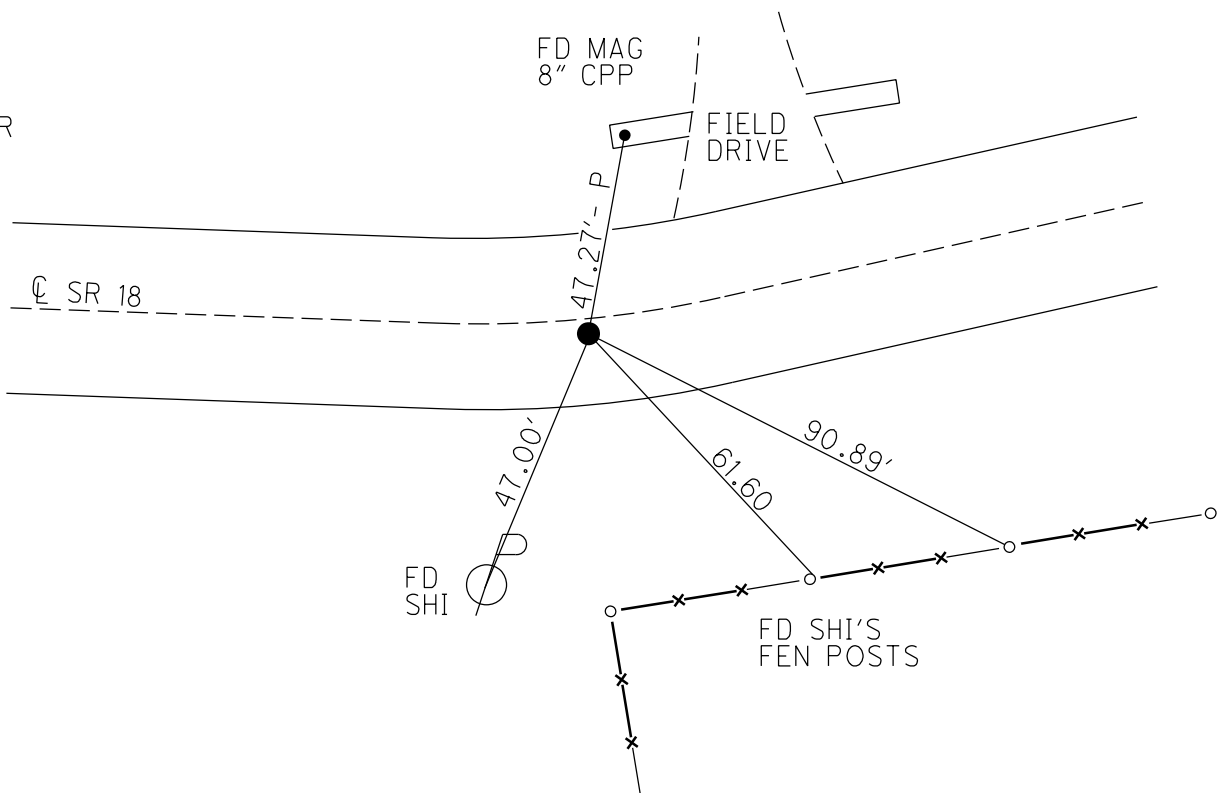

O.D.O.T. DISTRICT 2 SURVEY OFFICE (USE ONLY)

PERSONNEL

REFERENCE NO. 13

SHEET 8 OF 48

NOTES AUBLE

DATE 9/1/21

ROUTE SR 18

H.C. NIESE

WEATHER WINDY

COUNTY SENECA

R.C. AUBLE

TEMP. 72°

TOWNSHIP LOUDON

SECTION 16

DWG BY RHOADES PID PVTRAIN

T 2 N R 13 E

TYPE MONUMENT MAG/WASHER

ON SURFACE - ~~BELOW~~ ON

OFFSET CL PAVEMENT 1.0' ~~LT~~ : RT

9.9' TO RT EDGE PAVEMENT


STATION: 203+17.80

HORZ.DATUM: NAD83 2011


GEOID: NAVD88 2012A

GRID: NORTHING: 535880.549

EASTING: 1730855.391

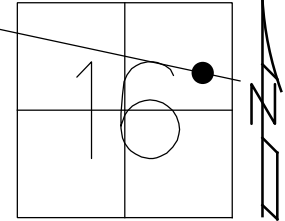

RECORD: P.I.
 $\Delta=02^{\circ}41'$ LT
STA.203+17.80
FD MINE SPIKE
4" BELOW
7/11/97, TMR
SET P.K./WASHER
11/6/97, MB
FD P.K.SHANK
REF13
4/22/19, JFO
SET MAG/WASHER
8/19/19, JFO
FD MAG/WASHER
9/1/21, DSA
2/15/22, JFO
2/10/23, JMR
10/6/23, DSA

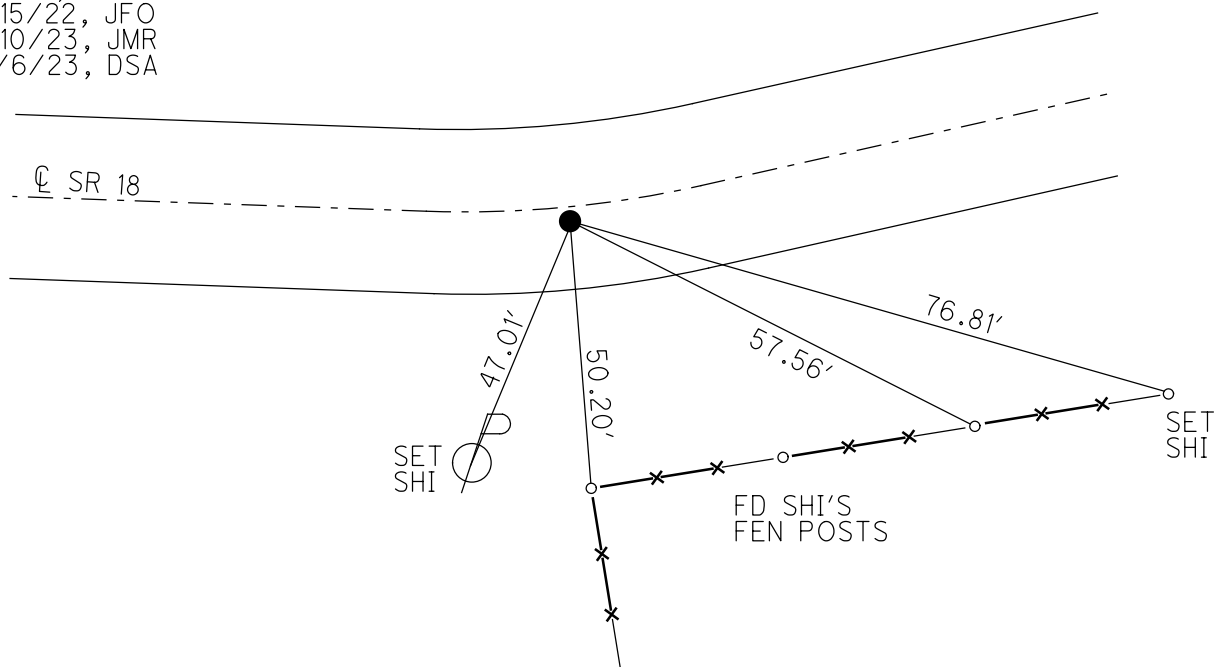

O.D.O.T. DISTRICT 2 SURVEY OFFICE (USE ONLY)

PERSONNEL

REFERENCE NO. 13

SHEET 8 OF 48

NOTES AUBLE

DATE 9/1/21

ROUTE SR 18

H.C. NIESE

WEATHER WINDY

COUNTY SENECA

R.C. AUBLE

TEMP. 72°

TOWNSHIP LOUDON

SECTION 16

DWG BY RHOADES

PID PVTRAIN

T 2 N R 13 E

TYPE MONUMENT MAG/WASHER

ON SURFACE - ~~BELOW~~ ON

OFFSET CL PAVEMENT 1.0' ~~LT~~ : RT

9.9' TO RT EDGE PAVEMENT


STATION: 203+17.80

HORIZ.DATUM: NAD83(2011)


GEOID: 2012A

GRID: NORTHING: 535880.549

EASTING: 1730855.391

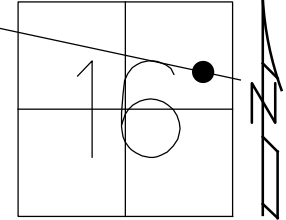

RECORD: P.I.
 $\Delta=02^{\circ}41'$ LT
STA.203+17.80
FD MINE SPIKE
4" BELOW
7/11/97, TMR
SET P.K./WASHER
11/6/97, MB
FD P.K.SHANK
REF13
4/22/19, JFO
SET MAG/WASHER
8/19/19, JFO
FD MAG/WASHER
9/1/21, DSA
2/15/22, JFO
2/10/23, JMR

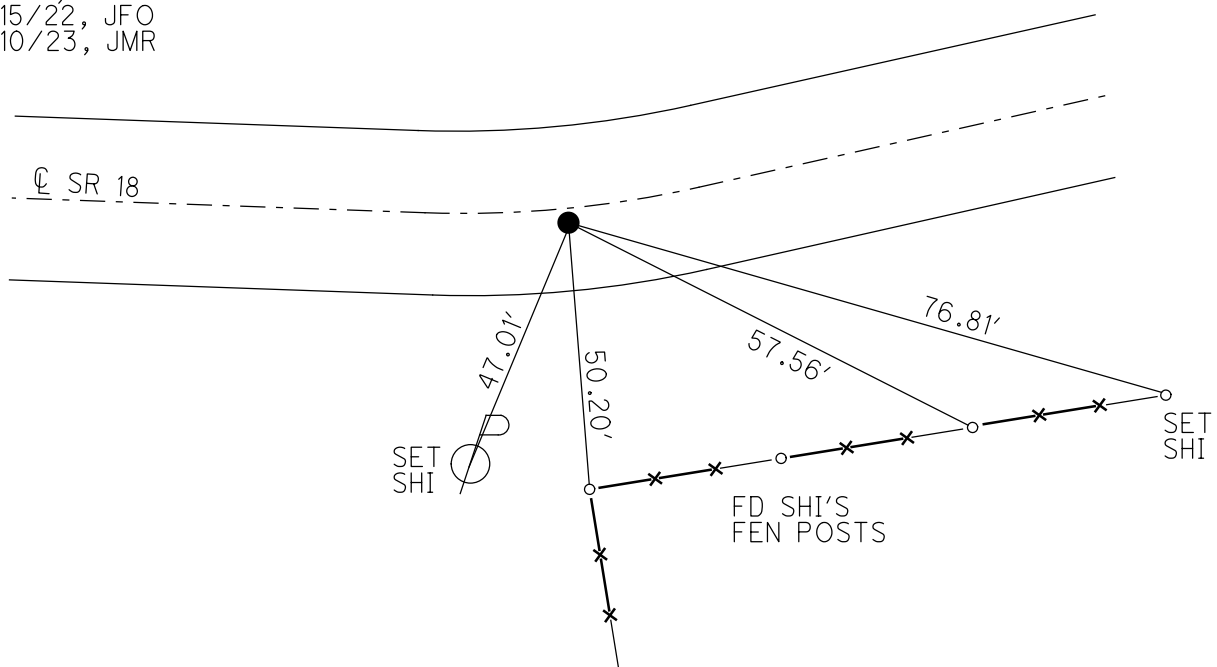

O.D.O.T. DISTRICT 2 SURVEY OFFICE (USE ONLY)

PERSONNEL

REFERENCE NO. 13

SHEET 8 OF 48

NOTES RHOADES

DATE 8/19/19

ROUTE SR 18

H.C. O'DONNELL

WEATHER SUNNY

COUNTY SENECA

R.C. AUBLE

TEMP. 70°

TOWNSHIP LOUDON

SECTION 16

DWG BY NIESE PID NO PID

T 2 N R 13 E

TYPE MONUMENT MAG/WASHER

ON SURFACE - ~~BELOW~~ ON

OFFSET CL PAVEMENT 1.0' ~~LT~~ : RT

9.9' TO RT EDGE PAVEMENT


STATION: 203+17.80

HORIZ.DATUM: NAD83(2011)


GEOID: 2012A

GRID: NORTHING: 535880.549

EASTING: 1730855.391

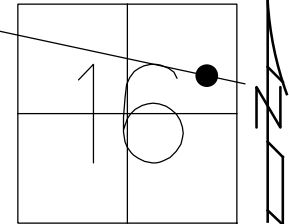

RECORD: P.I.
 $\Delta=02^{\circ}41'$ LT
STA. 203+17.80
FD MINE SPIKE
4" BELOW
7/11/97, TMR
SET P.K./WASHER
11/6/97, MB
FD P.K. SHANK
REF13
4/22/19, JFO

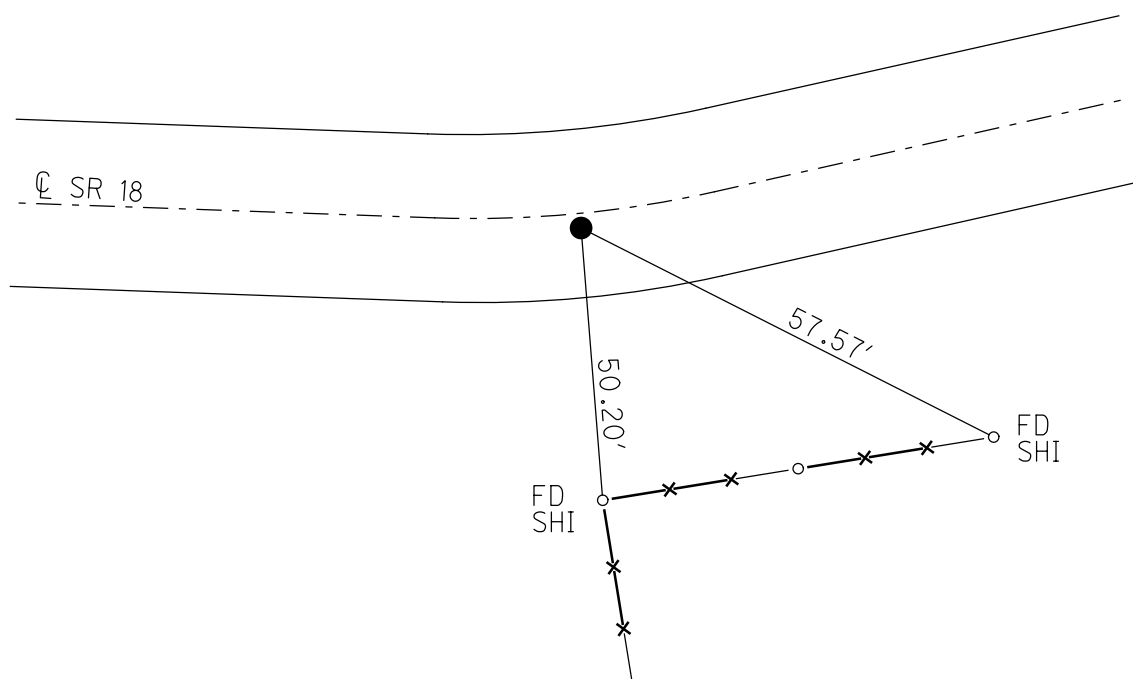

O.D.O.T. DISTRICT 2 SURVEY OFFICE

PERSONNEL

REFERENCE NO. 13

SHEET 13 OF 22

NOTES BARN HSEL

H.C. CANTERBURY

R.C. WEAVER

AT ROUSOS

DRAWN BY ROUSOS

DATE 7-11-97

WEATHER SUNNY

TEMP. +15°

ROUTE 18

COUNTY SENECA

TOWNSHIP LOUISIANA

SECTION 16

T2 N R 13 E


TYPE MONUMENT MINE SPIKE

ON SURFACE - BELOW 4" BELOW

LEFT-CL PAV'T. - RIGHT 1.5' RT


9.9' TO RT EDGE PAVEMENT

S.L.M. 6+569.8

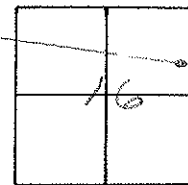

RESET PK. WASHER
11-6-97
MB

RE SURVEY
 $\Delta = 02^\circ 41' 67''$
203+17.80

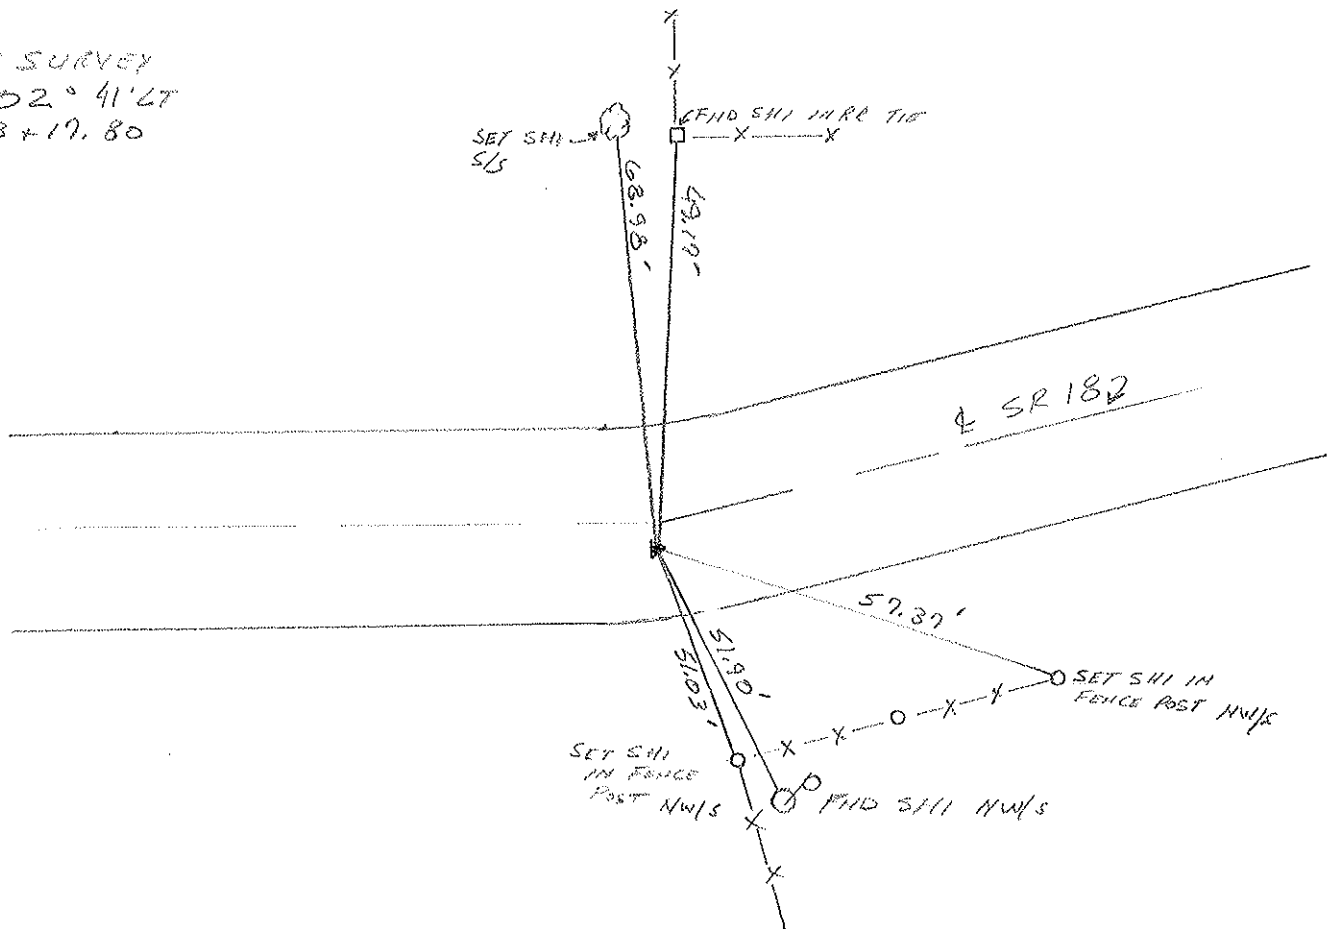

O.D.O.T. DISTRICT 2 SURVEY OFFICE

PERSONNEL

NOTES CROWIN (DRAW)

H.C. RIPPLE

R.C. BARBOUR MEAS

GEYMAN

REFERENCE NO. 13

DRAWN 1/19/90

DATE 11/12/87

WEATHER SUNNY

TEMP. 50°

SHEET 13 OF

ROUTE #18

COUNTY SENECA

TOWNSHIP LOUDBON

SECTION 16

T. 2 N R. 13 E


TYPE MONUMENT NINE SPIKE

ON SURFACE - BELOW 2" ±


LEFT - CL PAV'T. - RIGHT 1.5' ±

 TO EDGE PAVEMENT

S.L.M.

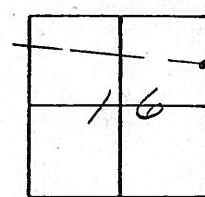

P.I. SURVEY
 $\Delta = 02^{\circ} 41' 24''$
20.3 ± 17.80

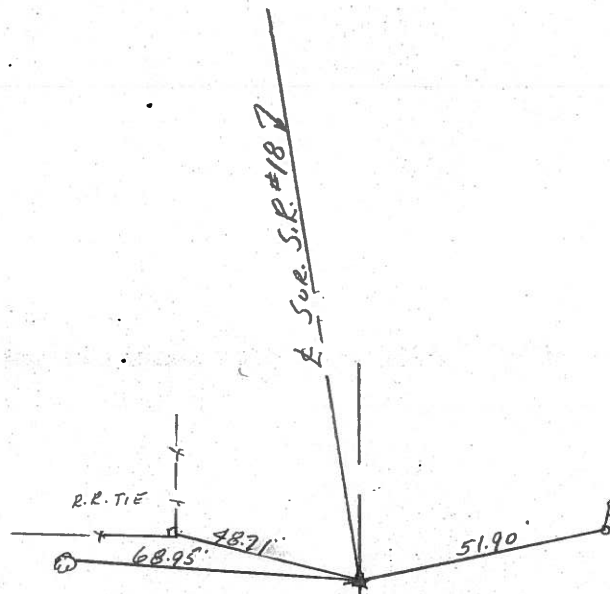

TITLE


10-16-68

Fair - wind.

TEMP. 80°

Ties for Control Points

JOB NO

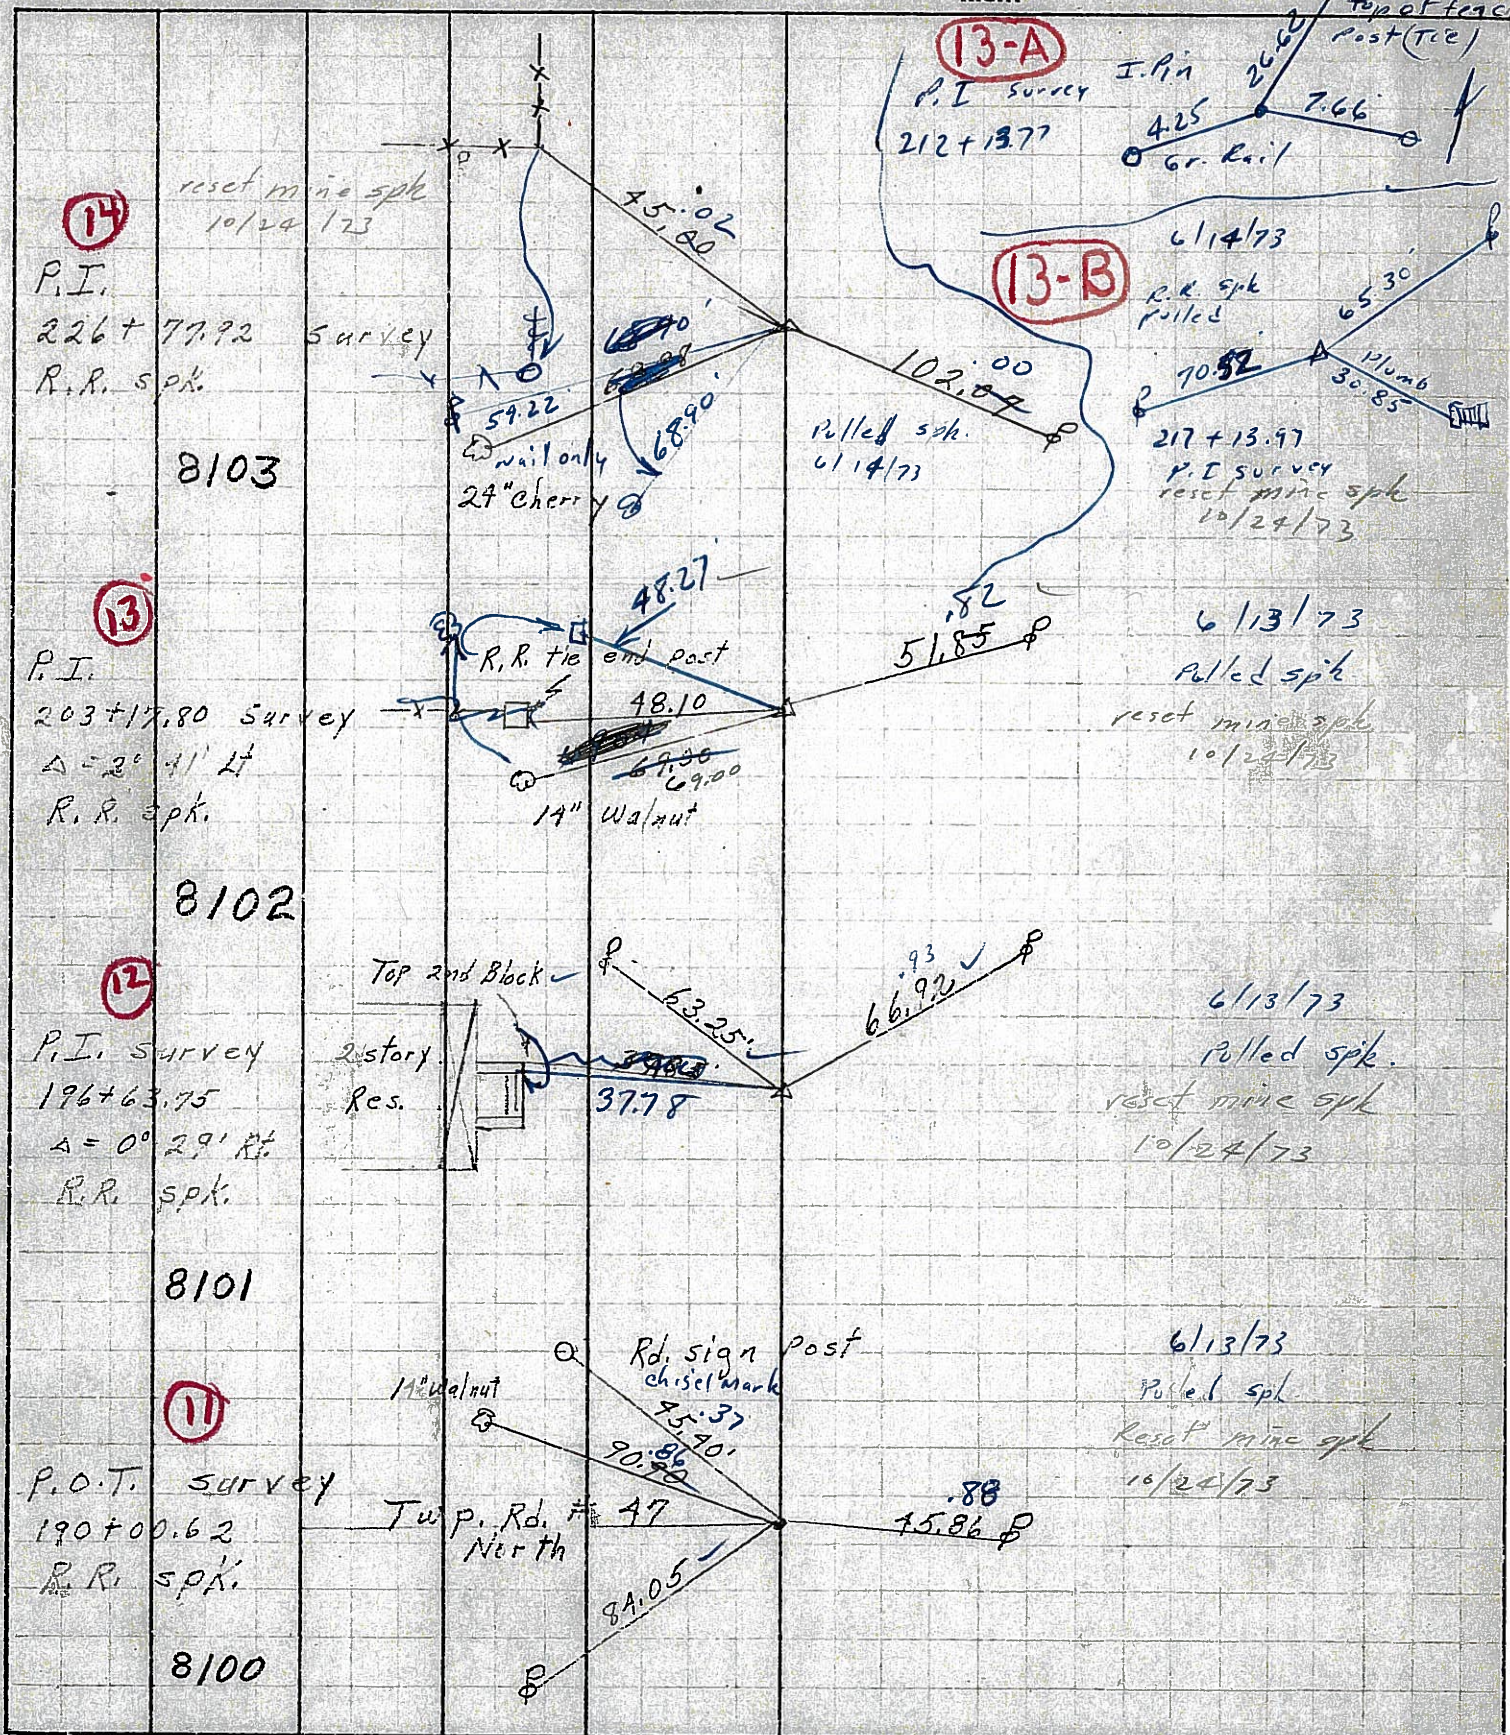

PERSONNEL TITLE PERSONNEL TITLE

COUNTY Seneca

DATE

10-16-68

Schneider

Mosser

Barbour

Potts

S. R. 18

WEATHER Fair - windy

SEC. Fostoria to Bascom

TEMP.

80°

DESCRIPTION Ties for Control Points

LEFT

CENTER LINE

RIGHT

JOB NO.

14

P.I.

226 + 77.92 Survey

R.R. spk.

8103

24" Cherry

13

P.I.

203 + 12.80 Survey

 $\Delta = 2^\circ 41' 14''$

R.R. spk.

8102

R.R. tie end post

48.10

69.00

14" Walnut

12

P.I. Survey

196 + 63.75

 $\Delta = 0^\circ 29' 14''$

R.R. spk.

8101

Top 2nd Block

2 story

Res.

11

P.C.T. Survey

190 + 00.62

R.R. spk.

8100

14" Walnut

Rd. sign post

75.70

90.90

Twp. Rd. # 47

North

84.05

15.86

PERSONNEL TITLE PERSONNEL TITLE

Schneider

COUNTY Seneca

DATE 10-16-68

Mosser

S. R. 18

WEATHER Fair - windy

Barbour

SEC. Fostoria to Bascom

TEMP. 80°

Potts


DESCRIPTION Ties for Control Points

JOB NO.

LEFT

CENTER LINE

RIGHT

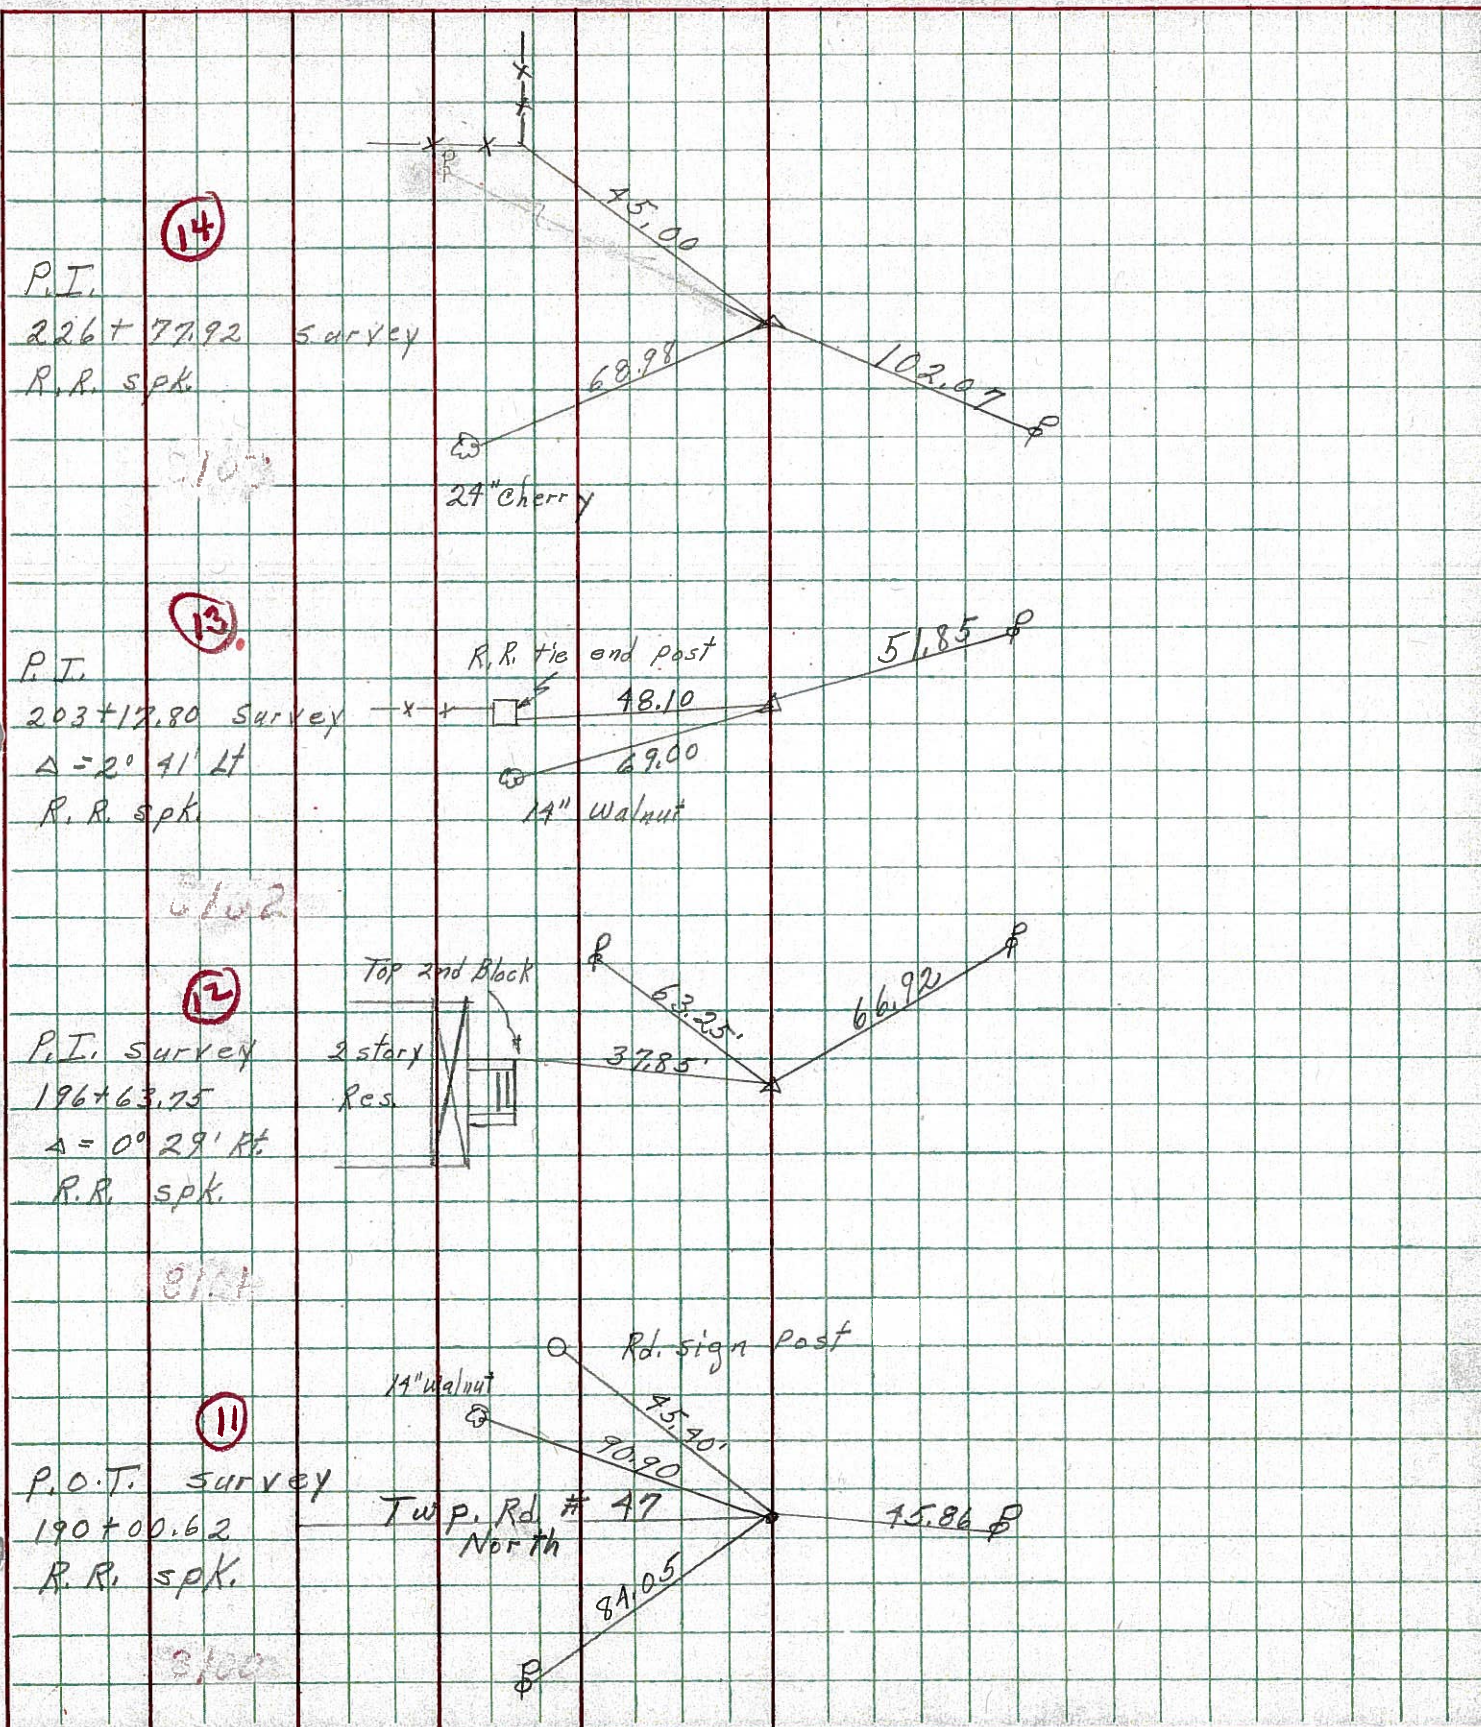

PERSONNEL	TITLE	PERSONNEL	TITLE
1	2	3	4
5	6	7	8
9	10	11	12
13	14	15	16
17	18	19	20
21	22	23	24
25	26	27	28
29	30	31	32
33	34	35	36
37	38	39	40
41	42	43	44
45	46	47	48
49	50	51	52
53	54	55	56
57	58	59	60
61	62	63	64
65	66	67	68
69	70	71	72
73	74	75	76
77	78	79	80
81	82	83	84
85	86	87	88
89	90	91	92
93	94	95	96
97	98	99	100

1754

Comins

Leinster

624r

John K.

COUNTY SCHOOL

DATE Dec. 18, '58

S. R. F18 Fostoria - Bascom Rd. WEATHER Cloudy

SEC. Siem.-18 (1.79-8.60) TEMP. 20°

DESCRIPTION	
Control Point Ties - & Survey & Const.	

LEFT

CENTER LINE Survey

RIGHT

JOB NO.

