

O.D.O.T. DISTRICT 2 SURVEY OFFICE (USE ONLY)

PERSONNEL _____

REFERENCE NO. 55 A

SHEET 14 OF 14

NOTES LOEHRKE DATE 6/17/94
 H.C. CANTERBURY WEATHER HOT
 R.C. HERMILLER TEMP. 94°

ROUTE SR 19
 COUNTY SENECA
 TOWNSHIP SCIPIO
 SECTION 22

DWG BY NIESE PID _____

T 2 N R 16 E

TYPE MONUMENT HARROW TOOTH

~~ON SURFACE~~ - BELOW 6"


OFFSET \odot PAVEMENT 2.05' ~~LT~~ : RT

- TO - EDGE PAVEMENT


STATION: 478+88

HORZ. DATUM: _____ GEOID: _____

GRID: NORTHING: _____ EASTING: _____

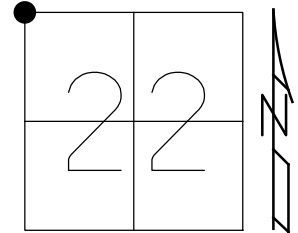

RECORD:
 FD HARROW TOOTH
 6" DOWN
 ORIGIN UNKNOWN
 8/7/85, CRONIN
 SET P.K./WASHER
 8/9/94, CAL

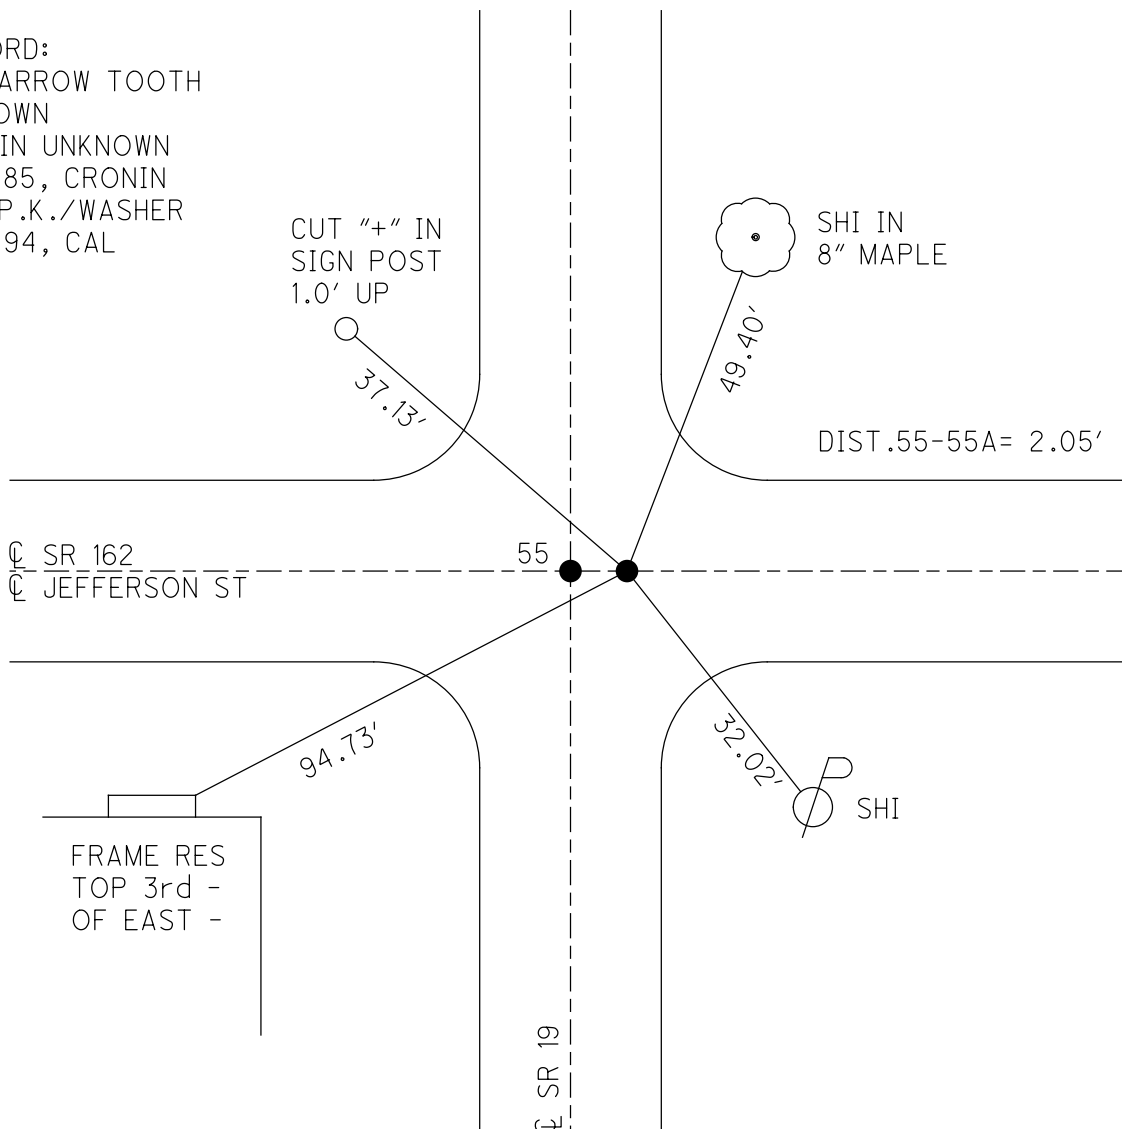

O.D.O.T. DISTRICT 2 SURVEY OFFICE

PERSONNEL

REFERENCE NO. 55

SHEET 12 OF 26

NOTES LOEHRKE

H.C. CANTERBURY

DATE 6-17-94

ROUTE S.R. 19

R.C. HEMILLER

WEATHER Hot

COUNTY SENECA

TEMP. +94

TOWNSHIP Scipio


SECTION 15

T. 2 N. R. 16 E.

TYPE MONUMENT R.R. Spike

Set P.K. / weather
@ both points
8-9-94 C.A.M.

~~ON SURFACE~~ - BELOW 2" Below

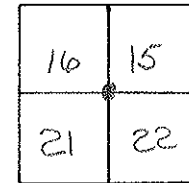


~~LEFT - & PAV'T. - RIGHT~~ "A"

TO EDGE PAVEMENT

S.L.M. 478+88

RECORD P.I. Pt. A
Sta 26+46.70
 $\Delta = 01^{\circ} - 30' \text{ Rt}$
Stone is $\pm 16''$ Below
Surface.

RECORD Pt. B ORIGINAL UNKNOWN
Fd. Harrow tooth 6" below the
surface ∓ 2.05 Ft. of stone
8/7/85 ground

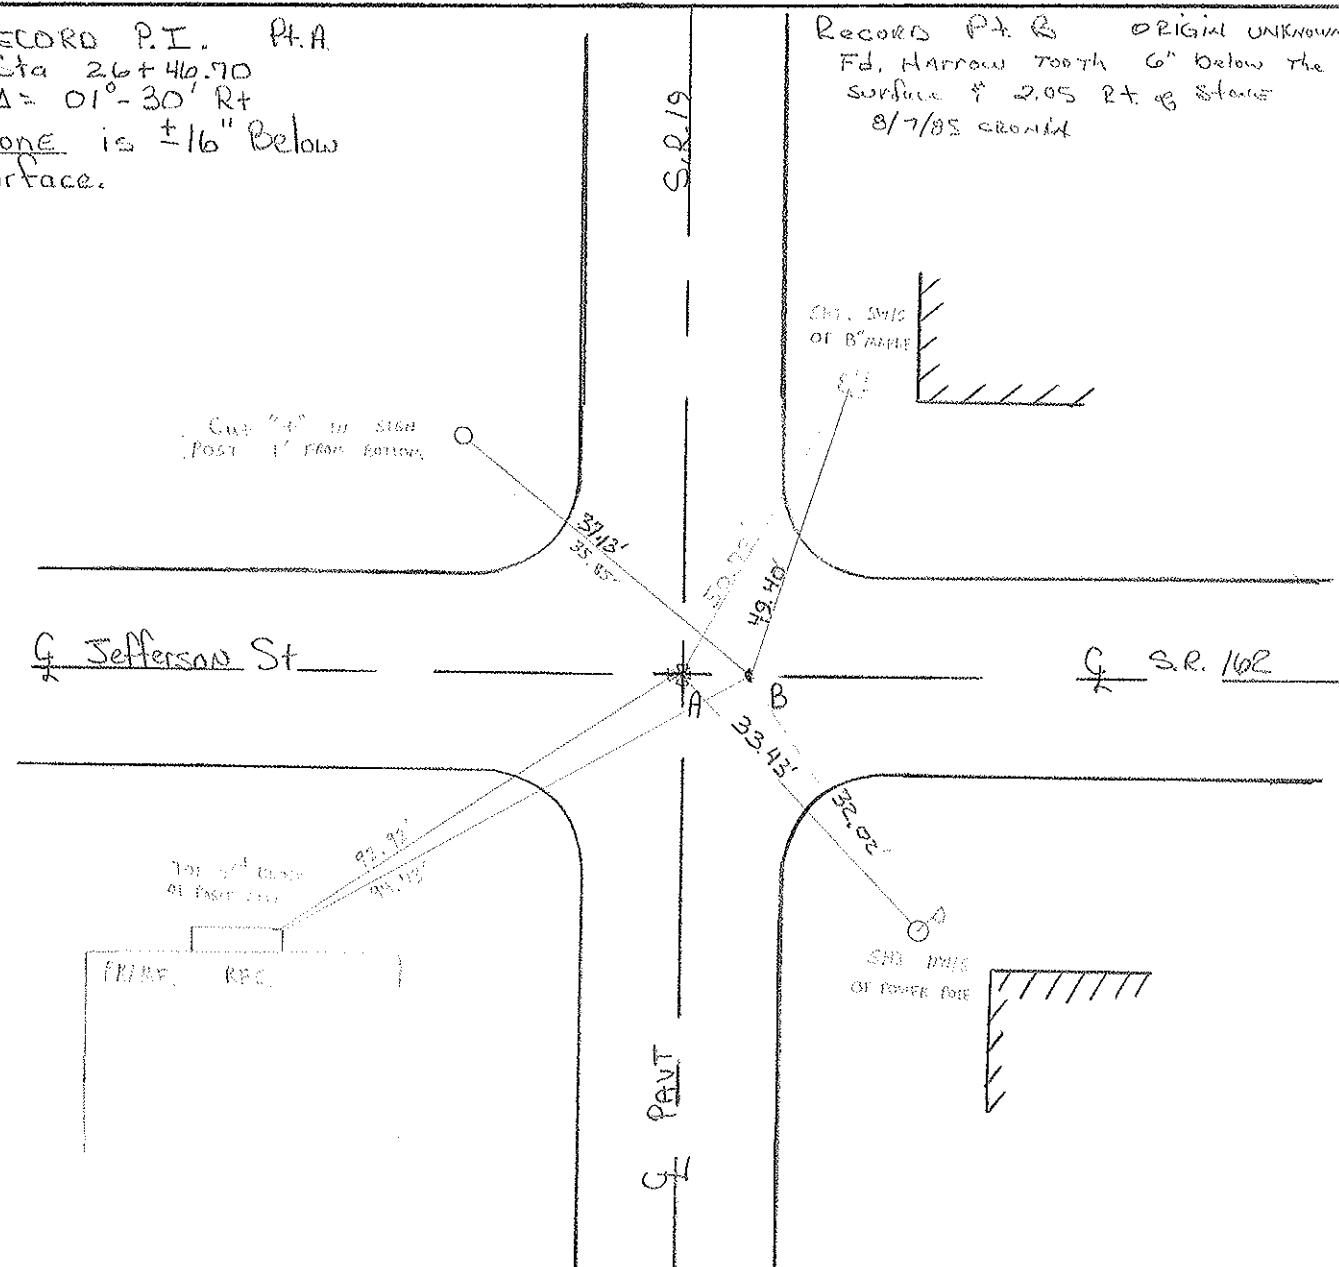

Q.D.O.T. DISTRICT 2 SURVEY OFFICE

SHEET _____ OF _____

County Seneca S.R. #19

Date 8/17/85
Drawn 11/14/84

Township Scipio

Weather cloudy

Section 15, 16, 21, 22

Temp. 74°

T2N, R16E

Personnel CRONIN
RIPPLE
GEYMAN
BARBOUR

16	15
21	22



#55

(55)




P.I. $\Delta = 01^{\circ}30' R$

20 + 46.70


Set P.K. & WASHER ATOP STONE

14" \pm Below surface

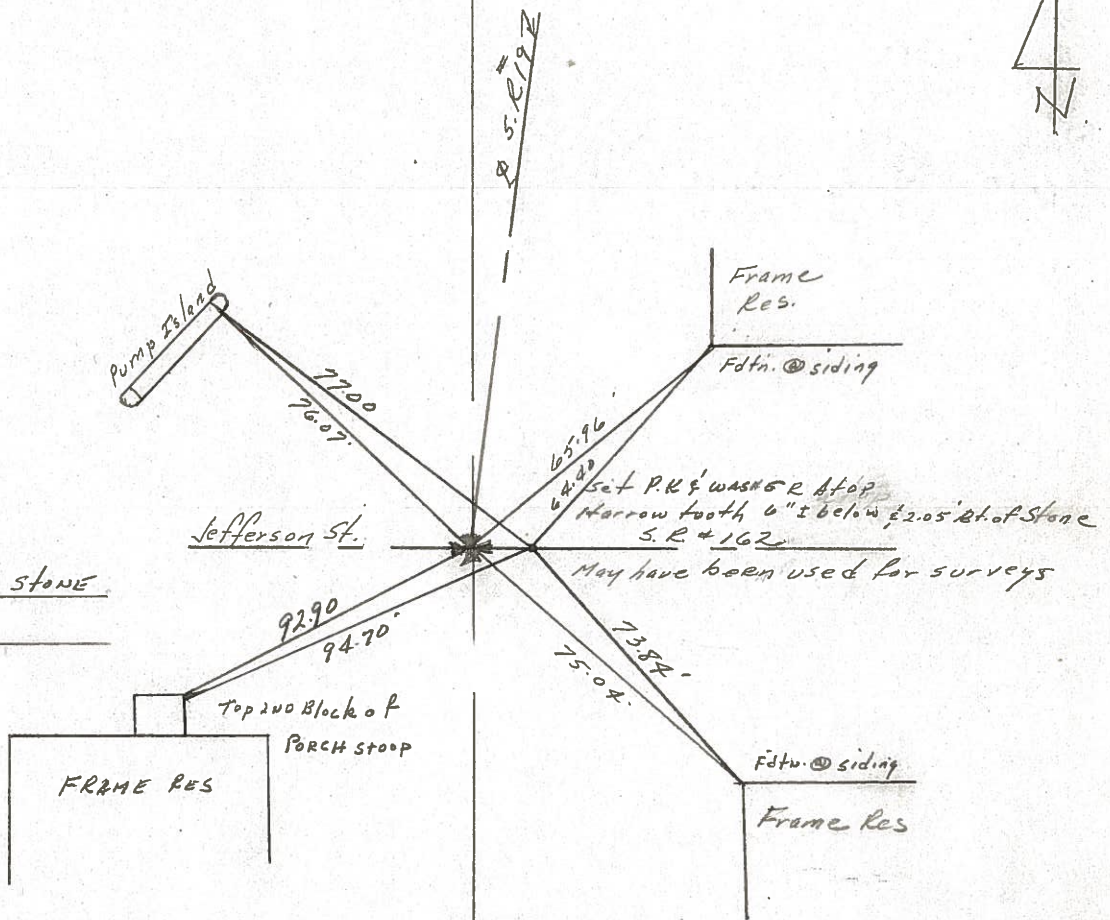

PERSONNEL	TITLE	PERSONNEL	TITLE	COUNTY	DATE	WEATHER	TEMP.
Ash				Seneca	drawn 10/13/72		
Cronin				#19			
Ripple							
Anderson		Vinson		SEC. F			

DESCRIPTION Ties for Control Points - Republic JOB NO. _____

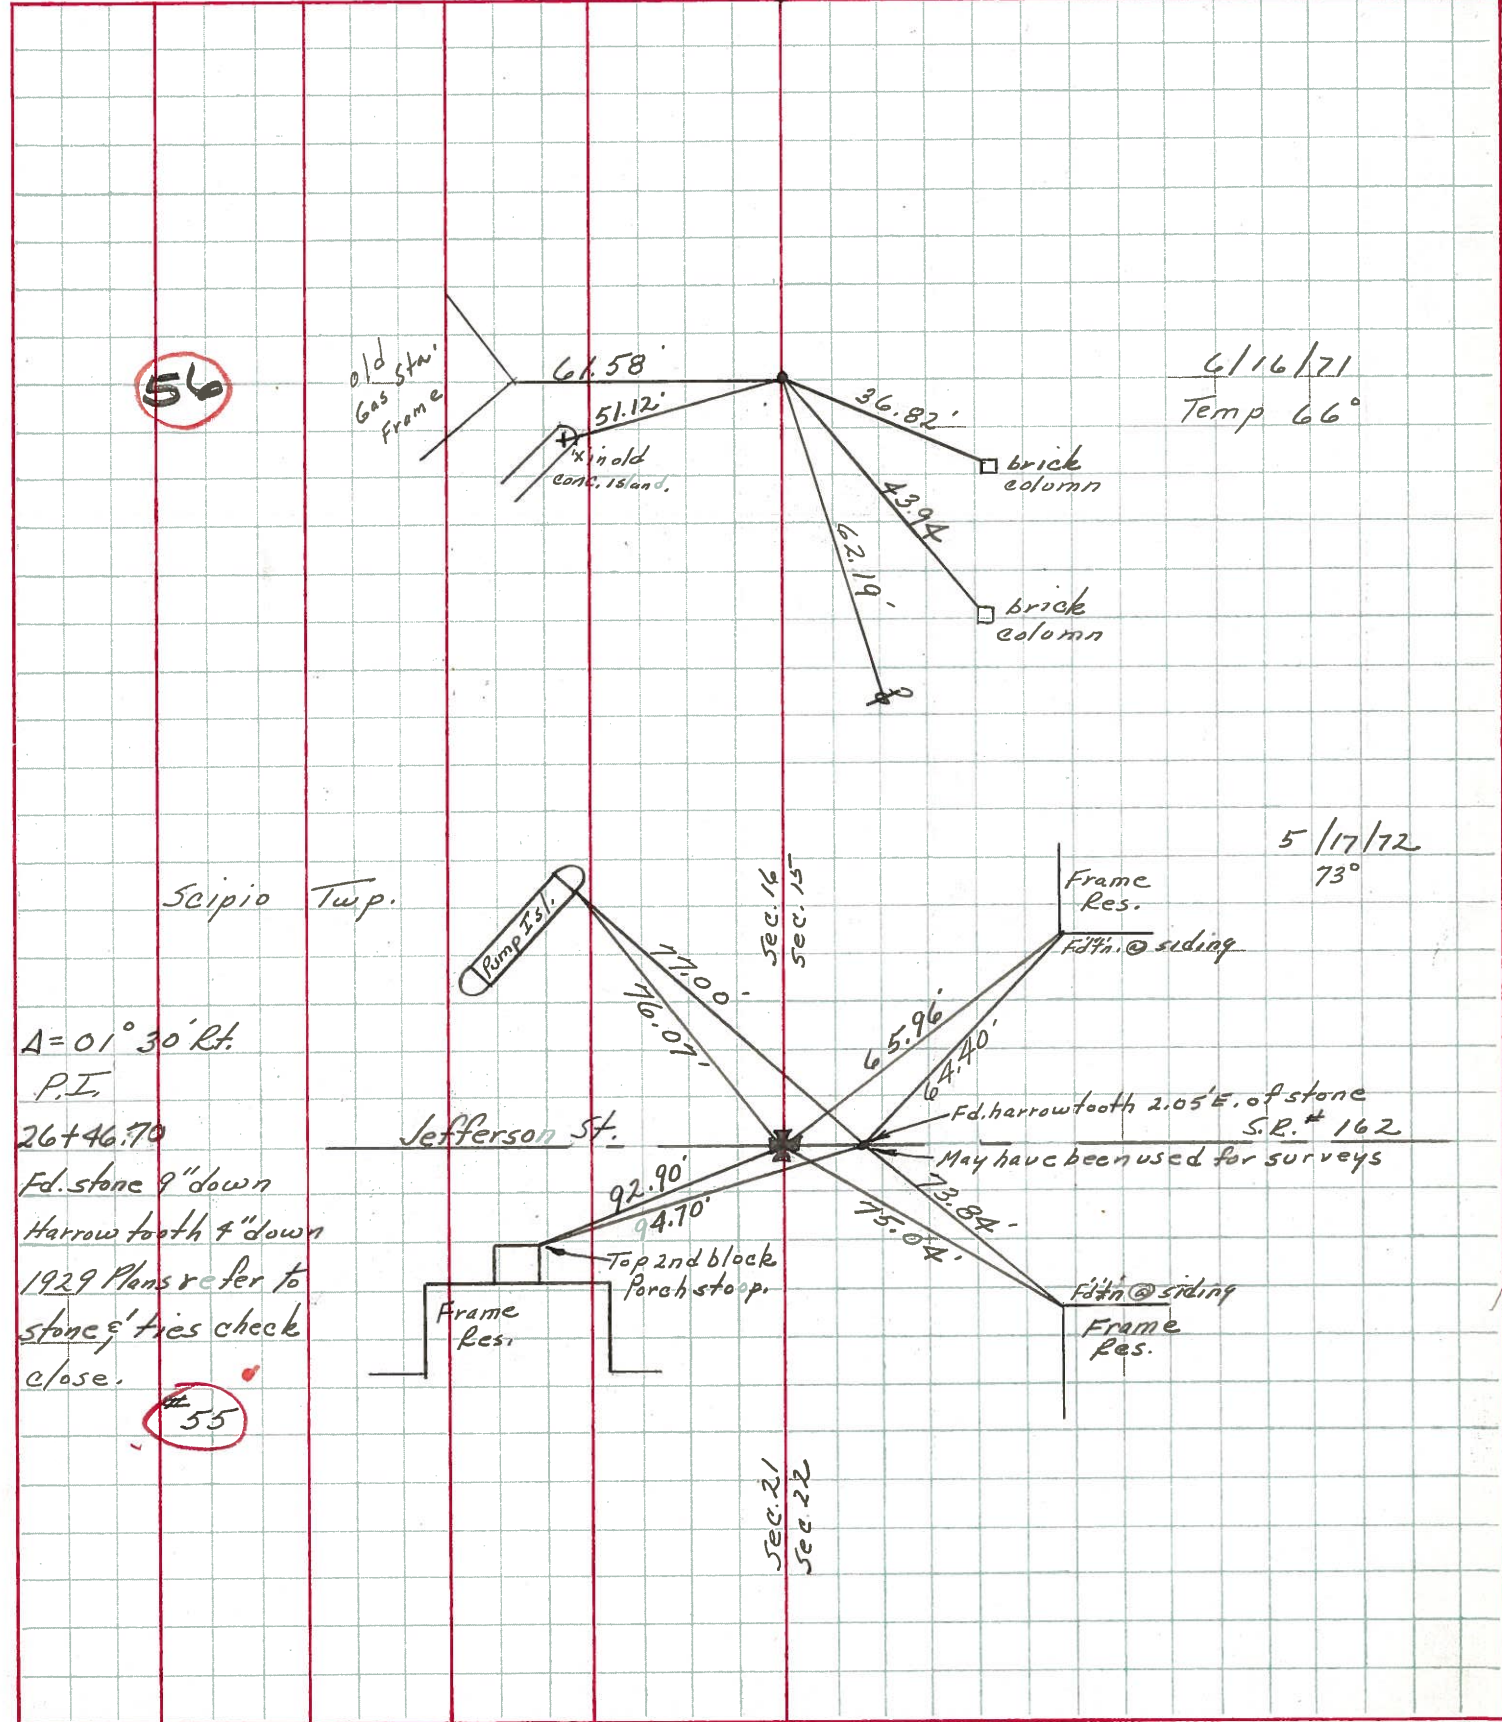

56

6/16/71
Temp 66°

Scipio Twp.

5/17/72
73°

A = 01° 30' Rt.
P.I.

26+46.70
 Fd. stone 9" down
 Harrowtooth 4" down
 1929 Plans refer to
 stone & ties check
 close.

55

Sec. 21
Sec. 22

PERSONNEL TITLE PERSONNEL TITLE

MOSSEK

COUNTY Seneca

DATE 8-4-69

BARBOUR

S. R. 19

WEATHER HOT

POTTS

SEC. US 224-NORTH

TEMP. 80°

DESCRIPTION

LEFT

CENTER LINE

RIGHT

JOB NO.

