



O.D.O.T. DISTRICT 2 SURVEY OFFICE (USE ONLY)

PERSONNEL _____ REFERENCE NO. 5 SHEET 5 OF 22
 NOTES O'DONNELL DATE 5/11/21 ROUTE US 23
 H.C. AUBLE WEATHER SUNNY COUNTY SENECA
 R.C. NIESE TEMP. 45° TOWNSHIP BIG SPRING
 DWG BY RHOADES PID 85264 SECTION 32
 T 1 N R 13 E

TYPE MONUMENT sm.r.r.spike
 ON ~~SURFACE~~ - BELOW 3.5"
 OFFSET \varnothing PAVEMENT 1.4' LT : ~~RT~~
10.1' TO lt EDGE PAVEMENT
 STATION: 54+60.69

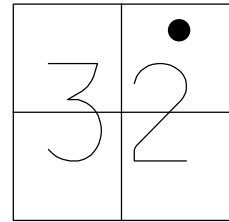

HORIZ.DATUM: NAD83 2011 GEOID: NAVD88 2012A
 GRID: NORTHING: 489286.302 EASTING: 1723687.120

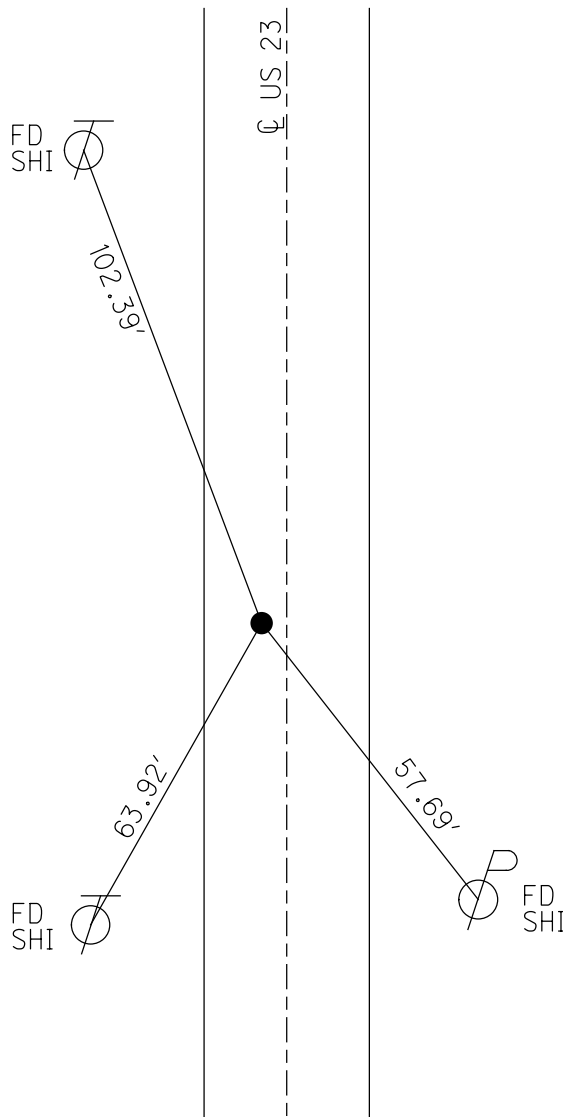

RECORD: P.I.
 STA. 54+60.69
 $\Delta = 0^\circ 52' RT$
 FD R.R.SPIKE
 7/19/89, CL
 SET P.K./WASHER
 10/31/89, SWH
 FD P.K.SHANK
 9/01/09
 FD SM.R.R.SPIKE
 3 1/2" DOWN
 REF5
 4/15/19
 8/16/19
 5/11/21, JFO
 SET MAG/WASHER
 12/10/21, DSA

O.D.O.T. DISTRICT 2 SURVEY OFFICE (USE ONLY)

PERSONNEL _____

REFERENCE NO. 5

SHEET 5 OF 22

NOTES ELKHECHEN

DATE 10/26/18

ROUTE US 23

H.C. LEU

WEATHER CLOUDY

COUNTY SENECA

R.C. ELKHECHEN

TEMP. 49°

TOWNSHIP BIG SPRING

SECTION 32

DWG BY NASON

PID PT-SEN19

T 1 N R 13 E

TYPE MONUMENT SM. R.R. SPIKE

ON ~~SURFACE~~ - BELOW 3.5"

OFFSET \odot PAVEMENT 1.4' LT : ~~RT~~

10.1' TO LT. EDGE PAVEMENT


STATION: 54+60.69

HORZ.DATUM: NAD83 (2011)

GEOID: 2012A

GRID: NORTHING: 489286.302

EASTING: 1723687.200

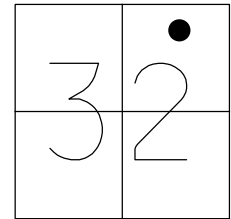

FD
SHI



102.55'

\odot US 23

RECORD: P.I.
STA. 54+60.69
FD R.R. SPIKE
7/19/89, CL
SET P.K./WASHER
10/31/89, SWH
FD P.K. SHANK
9/01/09
FD SM.R.R. SPIKE
REF5
3 1/2" DOWN
4/15/19, JFO
8/16/19, JFO

63.94'

57.77'

SET
SHI




SET
SHI

O.D.O.T. DISTRICT 2 SURVEY OFFICE (USE ONLY)


PERSONNEL _____ REFERENCE NO. 5 SHEET 5 OF 22
 NOTES LOEHRKE DATE 07-19-89 ROUTE US 23
 H.C. HOFFMAN WEATHER CLOUDY COUNTY SENECA
 R.C. BARNHISEL TEMP. +75 TOWNSHIP BIG SPRING
 _____ SECTION 32
 _____ T 1 N R 13 E

TYPE MONUMENT SM. R.R. SPIKE
 ON SURFACE - ~~BELOW~~ ON SURFACE
 LEFT - Q PAV'T - ~~RIGHT~~ 1.7
10.1' TO LT. EDGE PAVEMENT
 S.L.M. 54+72
 GRID: NORTHING: _____ EASTING: _____

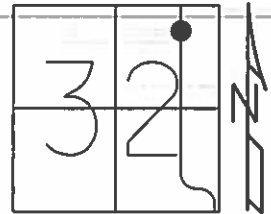

REC. P.I. STA. 54+60.69

RECORD
 10-31-89 SWH
 SET P.K./WASHER
 09-01-09
 FD. SHANK

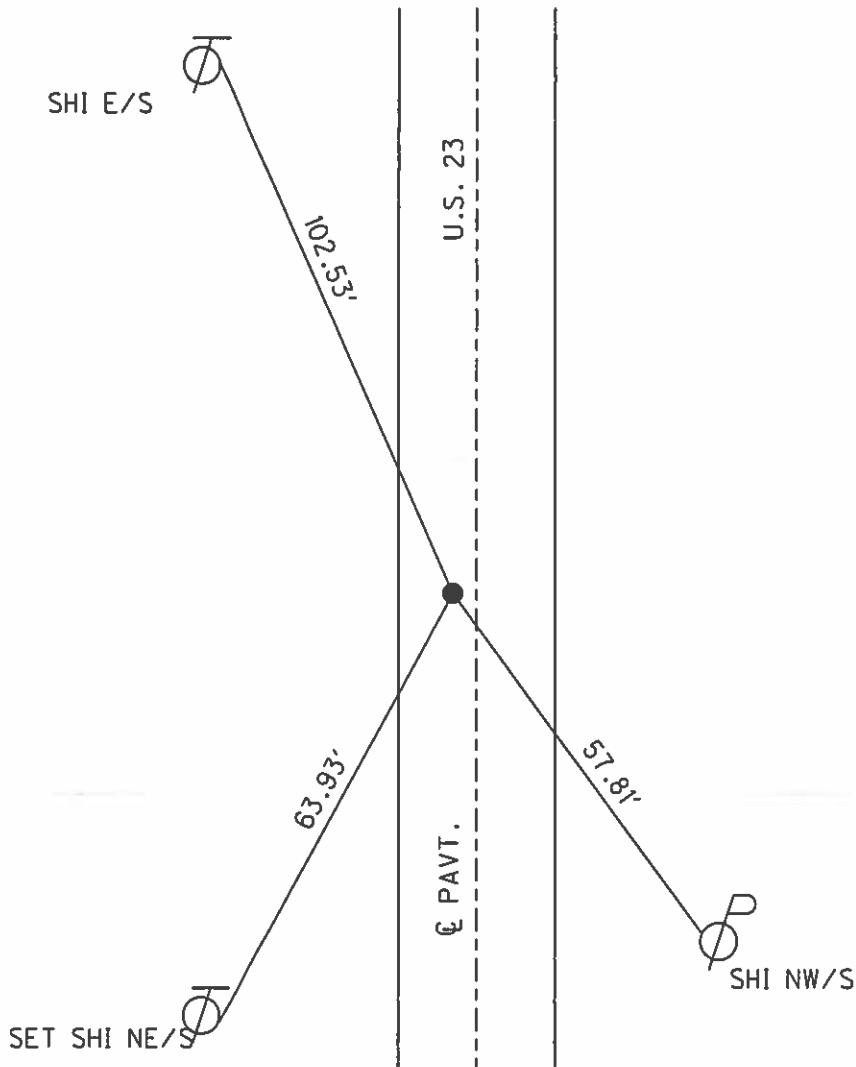

O.D.O.T. DISTRICT 2 SURVEY OFFICE

PERSONNEL _____

REFERENCE NO. 5

SHEET _____ OF _____

NOTES LOGHRICE

H.C. Hoffman

R.C. BARNHISEL

DATE 7-19-89

WEATHER CLOUDY

TEMP. +75

ROUTE U.S. 23

COUNTY SENECA

TOWNSHIP Big Spring

SECTION 32

T _____ R _____

TYPE MONUMENT 3m R.R. Spike


Set P.K./WASHER
10-31-89 SWH

ON SURFACE - BELOW Yes


LEFT - Q PAV'T. - RIGHT 1.7

10.1 TO LT EDGE PAVEMENT

S.L.M. 54+72

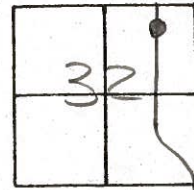

Rec. P.I. Sta
54+60.69

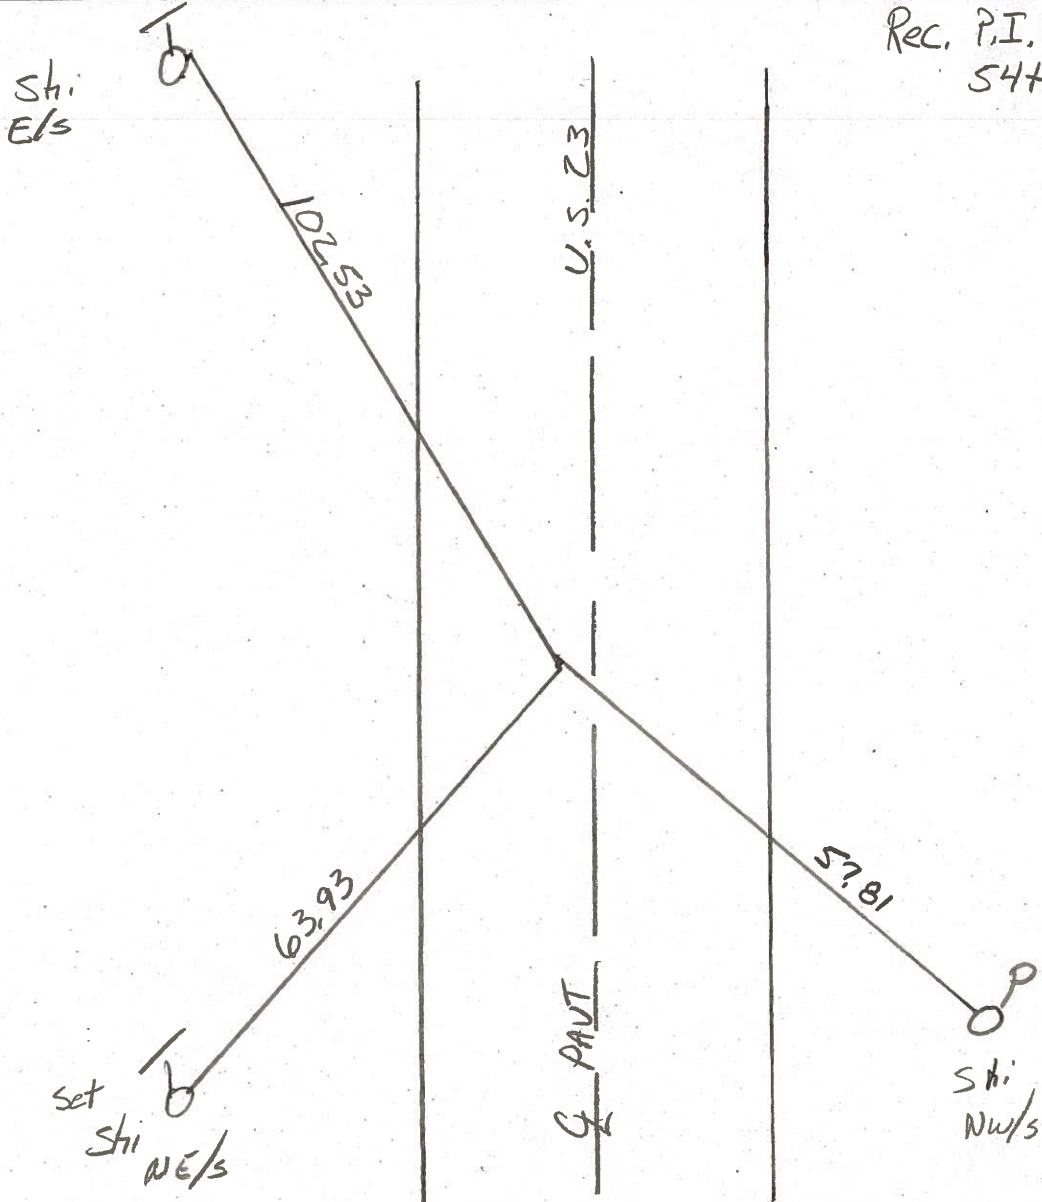

ODOT. DISTRICT 2 SURVEY OFFICE

SHEET

OF

County Seneca S.R. 4.5.23

Township Big Spring

Section 32

T N, R E


Personnel Hoffman
Householder

#5

Date 6-22-81

Weather cloudy

Temp. + 70°

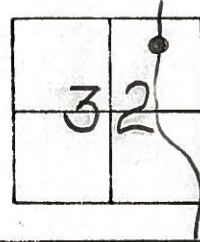

Fd. P.K. Nail/washer @ surface


10.7' to W. Edge PAUT.

13.4' to R. Edge PAUT.

PROJECT STA. ± 54+79

SET. SMALL R.R. SPK.

19-29-81 SWH

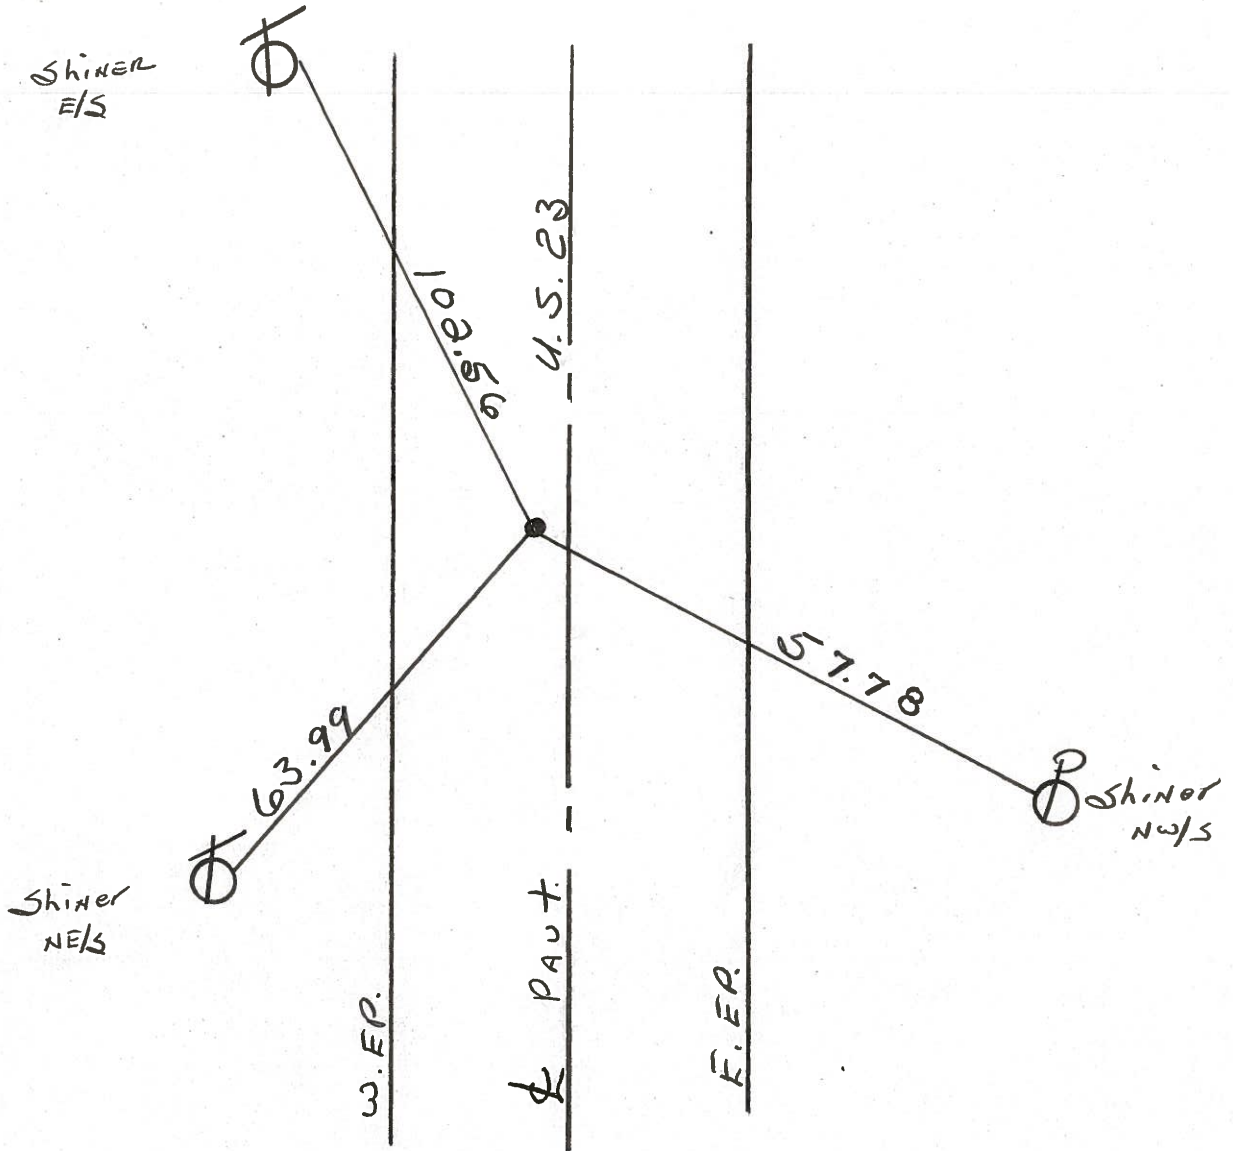

P. I. STA. 54+60.69 - Rec.

PERSONNEL	TITLE	PERSONNEL	TITLE	COUNTY	DATE	WEATHER	TEMP.
Schneider				Saroca	8-25-	Hot	90°
Mosser				S. R. U.S. 23			
Barbour				SEC. Wyandot Co Line N.			
Potts							

DESCRIPTION Ties for Control Points JOB NO. _____

